


DO NOT SCALE DRAWING

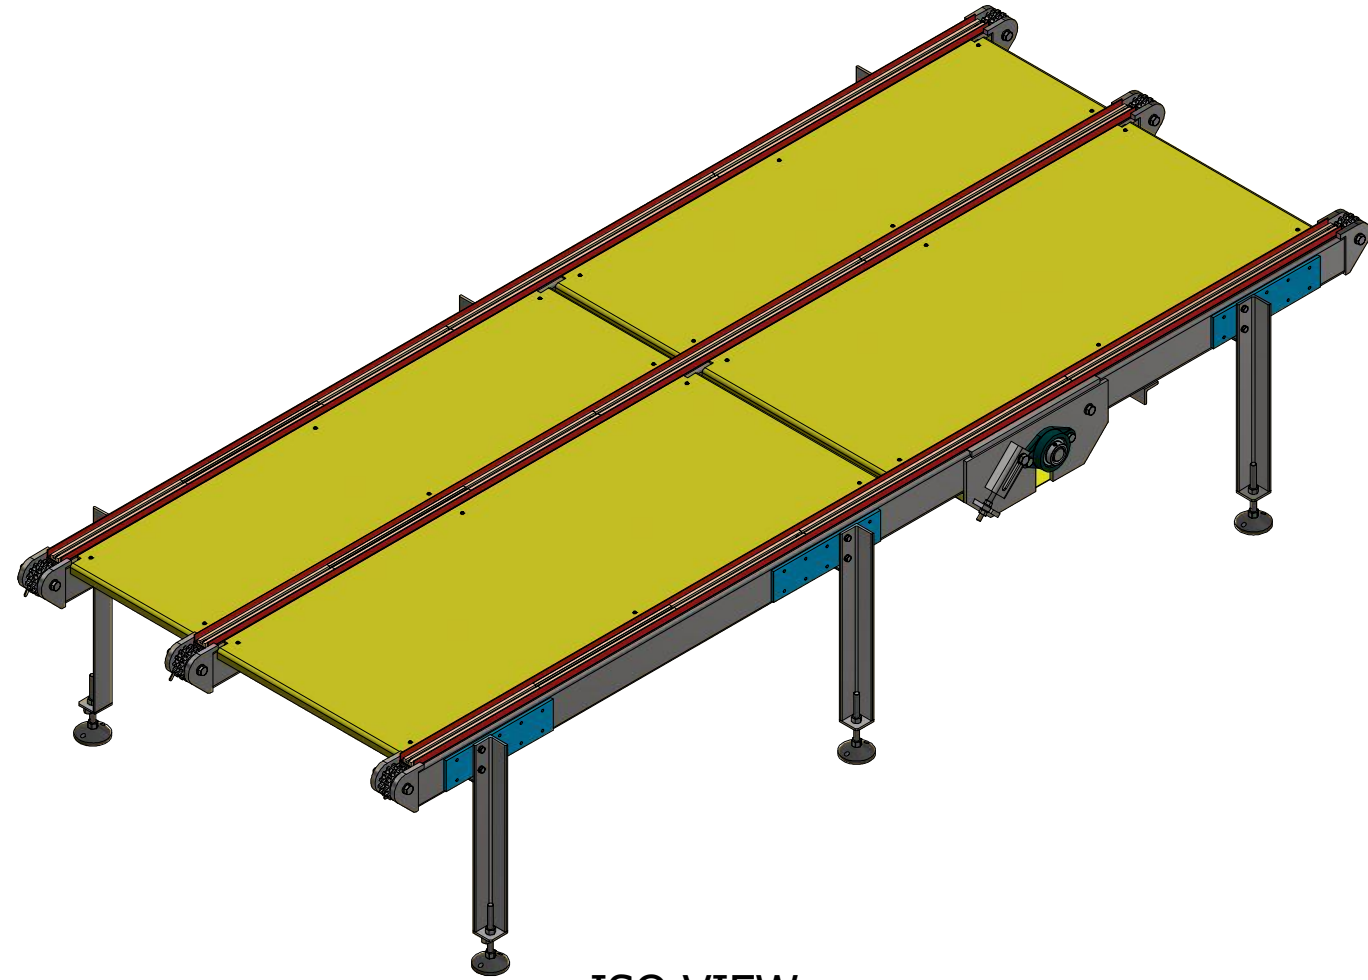

ISO VIEW  
SCALE 1:20

45	14 TOOTH DOUBLE ROW IDLER		BSC	12
44	KA67_DRN90S4	MOTOR & GEAR UNIT	SEW EURODRIVE	1
43	AS 1110 - M16 x 55	Steel, Mild	HEX HEAD BOLTS	6
42	LDK - FL210 & NSK UC210D1 & H2309	FL210 FLANGE/ BEARING & TAPER LOCK	BSC	3
41	AS 1110 - M12 x 25	Steel, Mild	HEX HEAD BOLT	6
40	AS 1968 - 1976 - 12	Steel, Mild	SPRING WASHER	7
38	LVR10016140B	ADJUSTABLE FOOT	RICHMOND CASTORS	6
37	AS 1111 - M16 x 140	Steel, Mild	HEX HEAD BOLT	3
36	AS 1237 - 12 mm	Steel, Mild	FLAT WASHER	6
35	AS 1112 - M12	Steel, Mild	HEX NUT	6
34	P1948-000-12	Steel, Mild	194801/22	1
33	AS 1285 - M16	Steel, Mild	NYLOCK NUT	6
32	AS 1110 - M8 x 12	Steel, Mild	HEX HEAD BOLT	6
31	AS 1968 - 1976 - 8	Steel, Mild	SPRING WASHER	6
30	ISO 10642 - M5x16	Steel, Mild	COUNTER SUNK SCREW	12
29	ISO 7380-1 - M5 x 12	Steel, Mild	BUTTON HEAD SCREW	24
28	ISO 7380-1 - M5 x 16	Steel, Mild	BUTTON HEAD SCREW	12
27	AS 1110 - M10 x 25	Steel, Mild	HEX HEAD BOLT	4
26	AS 1110 - M10 x 20	Steel, Mild	HEX HEAD BOLT	14
25	AS 1968 - 1976 - 10	Steel, Mild	SPRING WASHER	18
24	AS 1110 - M16 x 50	Steel, Mild	HEX HEAD BOLT	1
23	AS 1968 - 1976 - 16	Steel, Mild	SPRING WASHER	13
22	AS 1111 - M16 x 120	Steel, Mild	HEX HEAD BOLT	6
21	AS 1237 - 16 mm	Steel, Mild	FLAT WASHER	25
20	P1948-000-28	HDPE	194801/33	3
19	P1948-000-09	Steel, Mild	194801/19	6
18	21T DRIVE SPROCKET	12B2-21T 3/4" PITCH FENNER	194810	3
16	P1948-000-10	Steel, Mild	194801/20	6
15	W1948-000-07	WELDMENT	194801/9	1
14	W1948-000-08	WELDMENT	194801/10	1
13	W1948-000-09	WELDMENT	194801/11	1
12	P1948-000-24	HDPE	194801/31	3
11	AS 1112 - M16	Steel, Mild	HEX NUT	19
10	P1948-000-21	Aluminium TREADPLATE	194801/30	1
9	P1948-000-20	Aluminium TREADPLATE	194801/29	1
8	P1948-000-19	Aluminium TREADPLATE	194801/28	1
7	P1948-000-18	Aluminium TREADPLATE	194801/27	1
6	W1948-000-05	WELDMENT	194801/8	2
5	W1948-000-04	WELDMENT	194801/7	1
4	P1948-000-15	HDPE	194801/25	12
3	P1948-000-14	Steel, Mild	194801/24	1
2	P1948-000-11	Steel, Mild	194801/21	3
1	W1948-000-03	WELDMENT	194801/6	3
ITEM	PART NUMBER	DESCRIPTION	COMMENTS	ITEM QTY

A1948-000-01 - 2 REQ'D AS DRAWN


DRAWN BY ULTIMATE ENGINEERING PTY LTD Ph 8562 1511



1	27/04/2021	AS BUILT	DB
0	7/04/2021	APPROVED FOR MANUFACTURE	PB
REV	DATE	DESCRIPTION	APPRD
REVISION HISTORY			

THESE DRAWINGS ARE THE PROPERTY OF ULTIMATE ENGINEERING AND SHOULD NOT BE REPRODUCED OR COPIED IN ANY WAY WITHOUT WRITTEN PERMISSION FROM ULTIMATE ENGINEERING

PAINT TREATMENT:

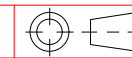

DIMENSION TOLERANCES	
DECIMAL	ANGULAR
X.X = ± .5 mm	X = ± 1°
X.XX = ± .25 mm	X.X = ± .5°
X.XXX = ± .125 mm	X.XX = ± .25°

MAXIMUM FINISHED SURFACE ROUGHNESS U.N.O. 1.6

PARENT ASSEMBLY

CUSTOMER:

RAB ENGINEERING

DRAWN: David Bilney

TITLE:

A1948-000-01  
CHAIN CONVEYORS

DESIGNED: David Bilney

DWG NO:

194801

DATE: 15/03/2021

JOB NO:





SCALE: 1 OF 34

SHEET A3

SHEET SIZE: A3

REV: 1

DO NOT SCALE DRAWING

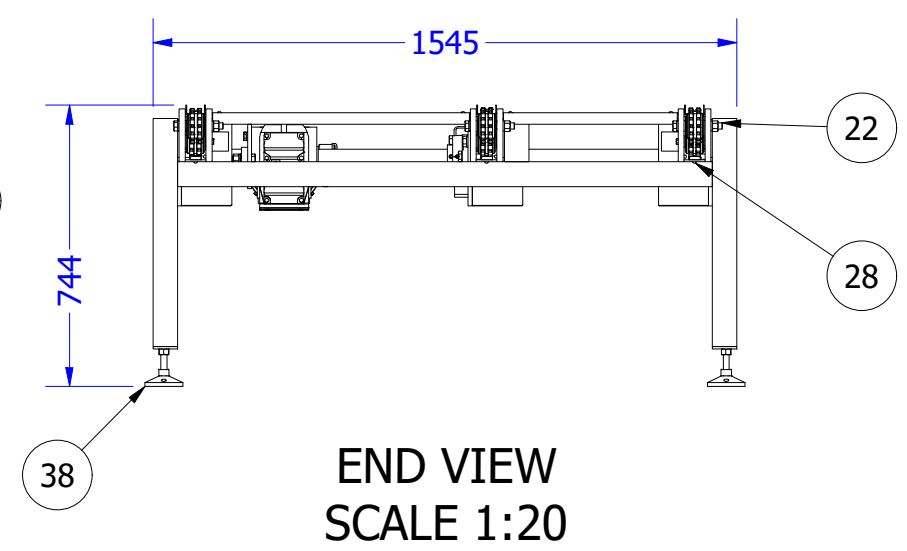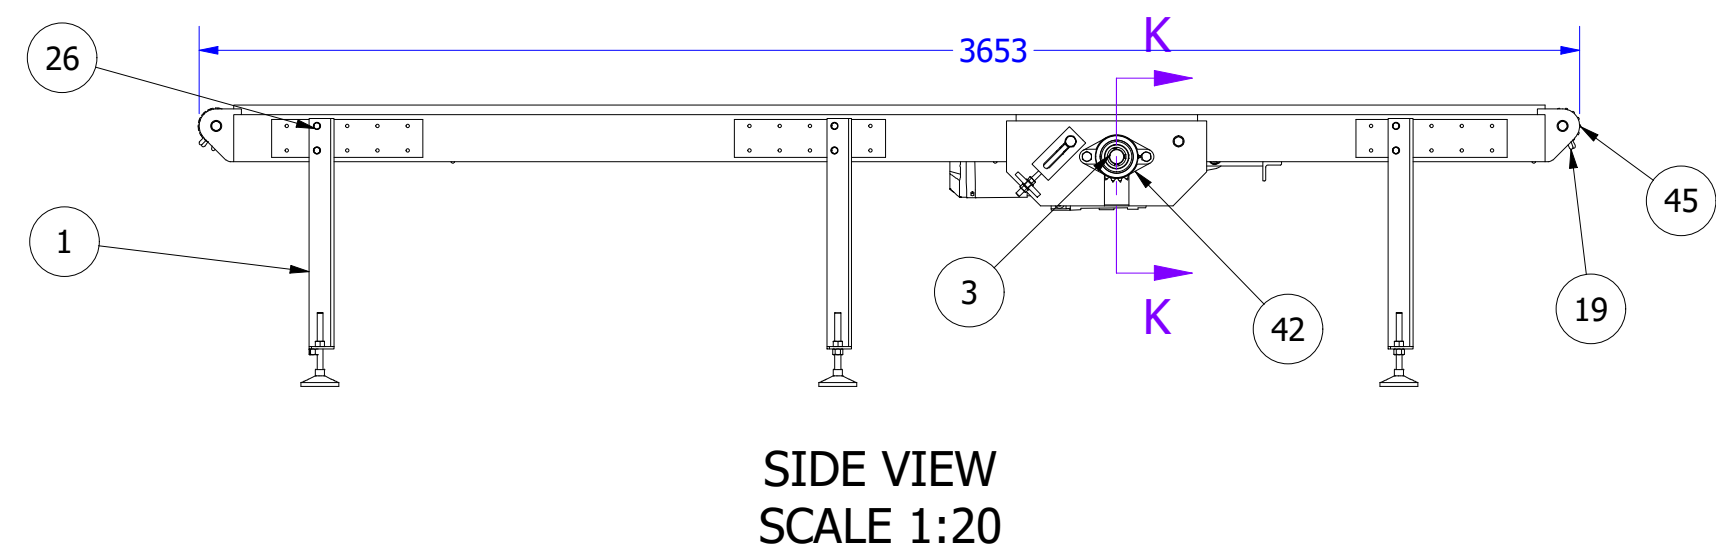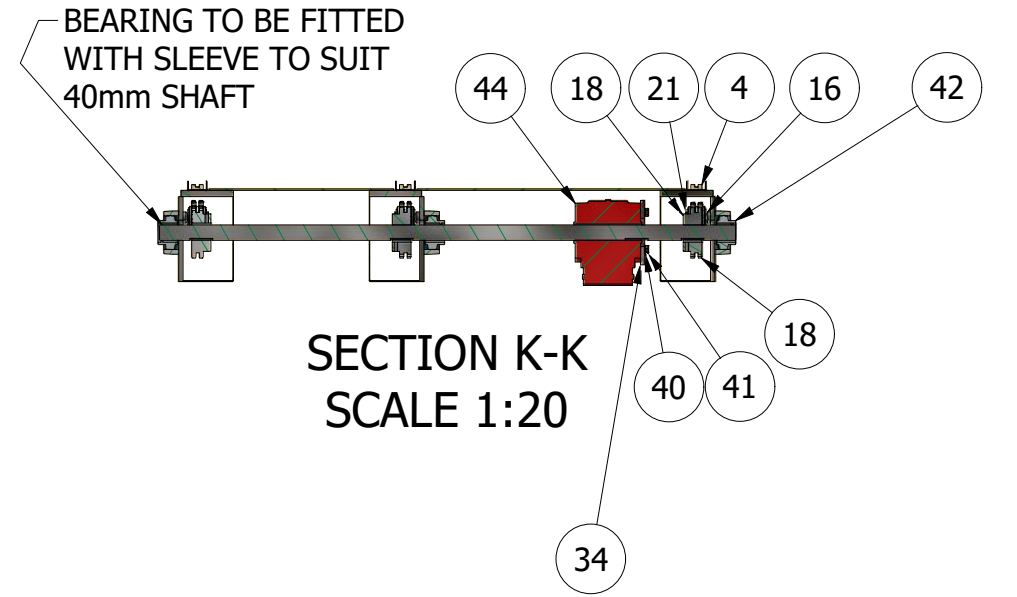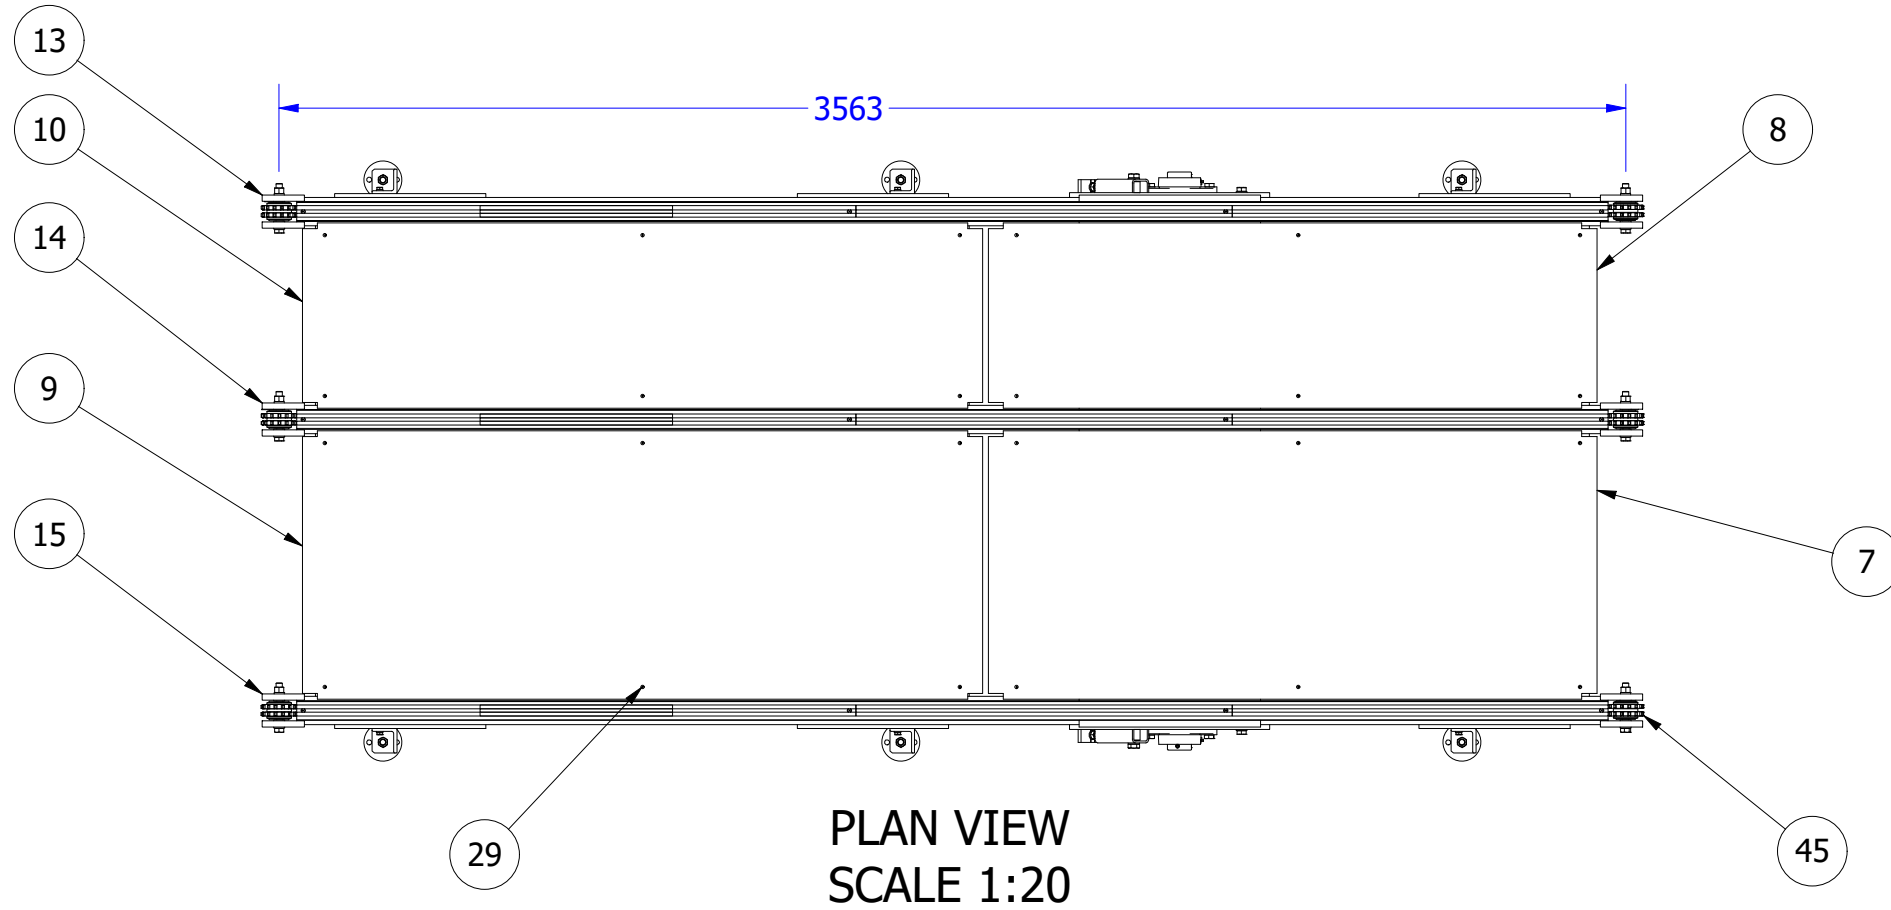

DRAWN BY ULTIMATE ENGINEERING PTY LTD Ph 8562 1511




THESE DRAWINGS ARE THE PROPERTY OF ULTIMATE ENGINEERING AND SHOULD NOT BE REPRODUCED OR COPIED IN ANY WAY WITHOUT WRITTEN PERMISSION FROM ULTIMATE ENGINEERING

PAINT TREATMENT:	
DIMENSION TOLERANCES DECIMAL                      ANGULAR X.X    = ± .5 mm            X    = ± 1° X.XX   = ± .25 mm        X.X   = ± .5° X.XXX   = ± .125 mm    X.XX   = ± .25°	
MAXIMUM FINISHED SURFACE ROUGHNESS U.N.O. 1.6 ✓	

PARENT ASSEMBLY	CUSTOMER: <b>RAB ENGINEERING</b>
DRAWN: David Bilney	TITLE: A1948-000-01 CHAIN CONVEYORS
DESIGNED: David Bilney	DWG NO: <b>194801</b>
DATE: 15/03/2021	JOB NO:
SCALE: Scale	SHEET 2 OF 34
SHEET SIZE: A3	REV: 1


DO NOT SCALE DRAWING

3	NTN 6304LLUNR	Steel, Mild	BEARING	2
2	P1948-000-29	Steel, Mild	194801/34	1
1	14T IDLER SPROCKET	Steel, Mild	12B2-14 3/4" PITCH	1
ITEM	PART NUMBER	MATERIAL	COMMENTS	ITEM QTY

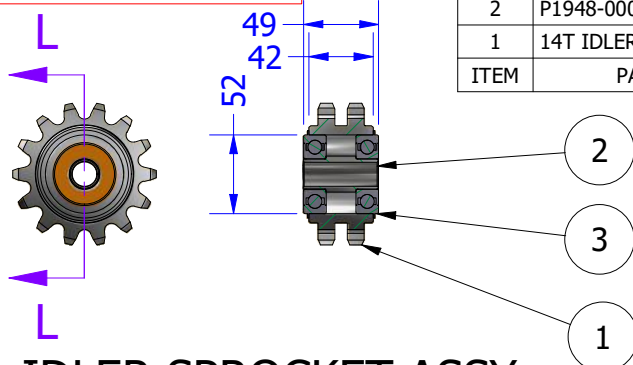

IDLER SPROCKET ASSY  
SCALE 1:5

DRILL AND TAP M5  
ON ASSEMBLY  
SAME APPLIES TO BOTTOM WEAR STRIP

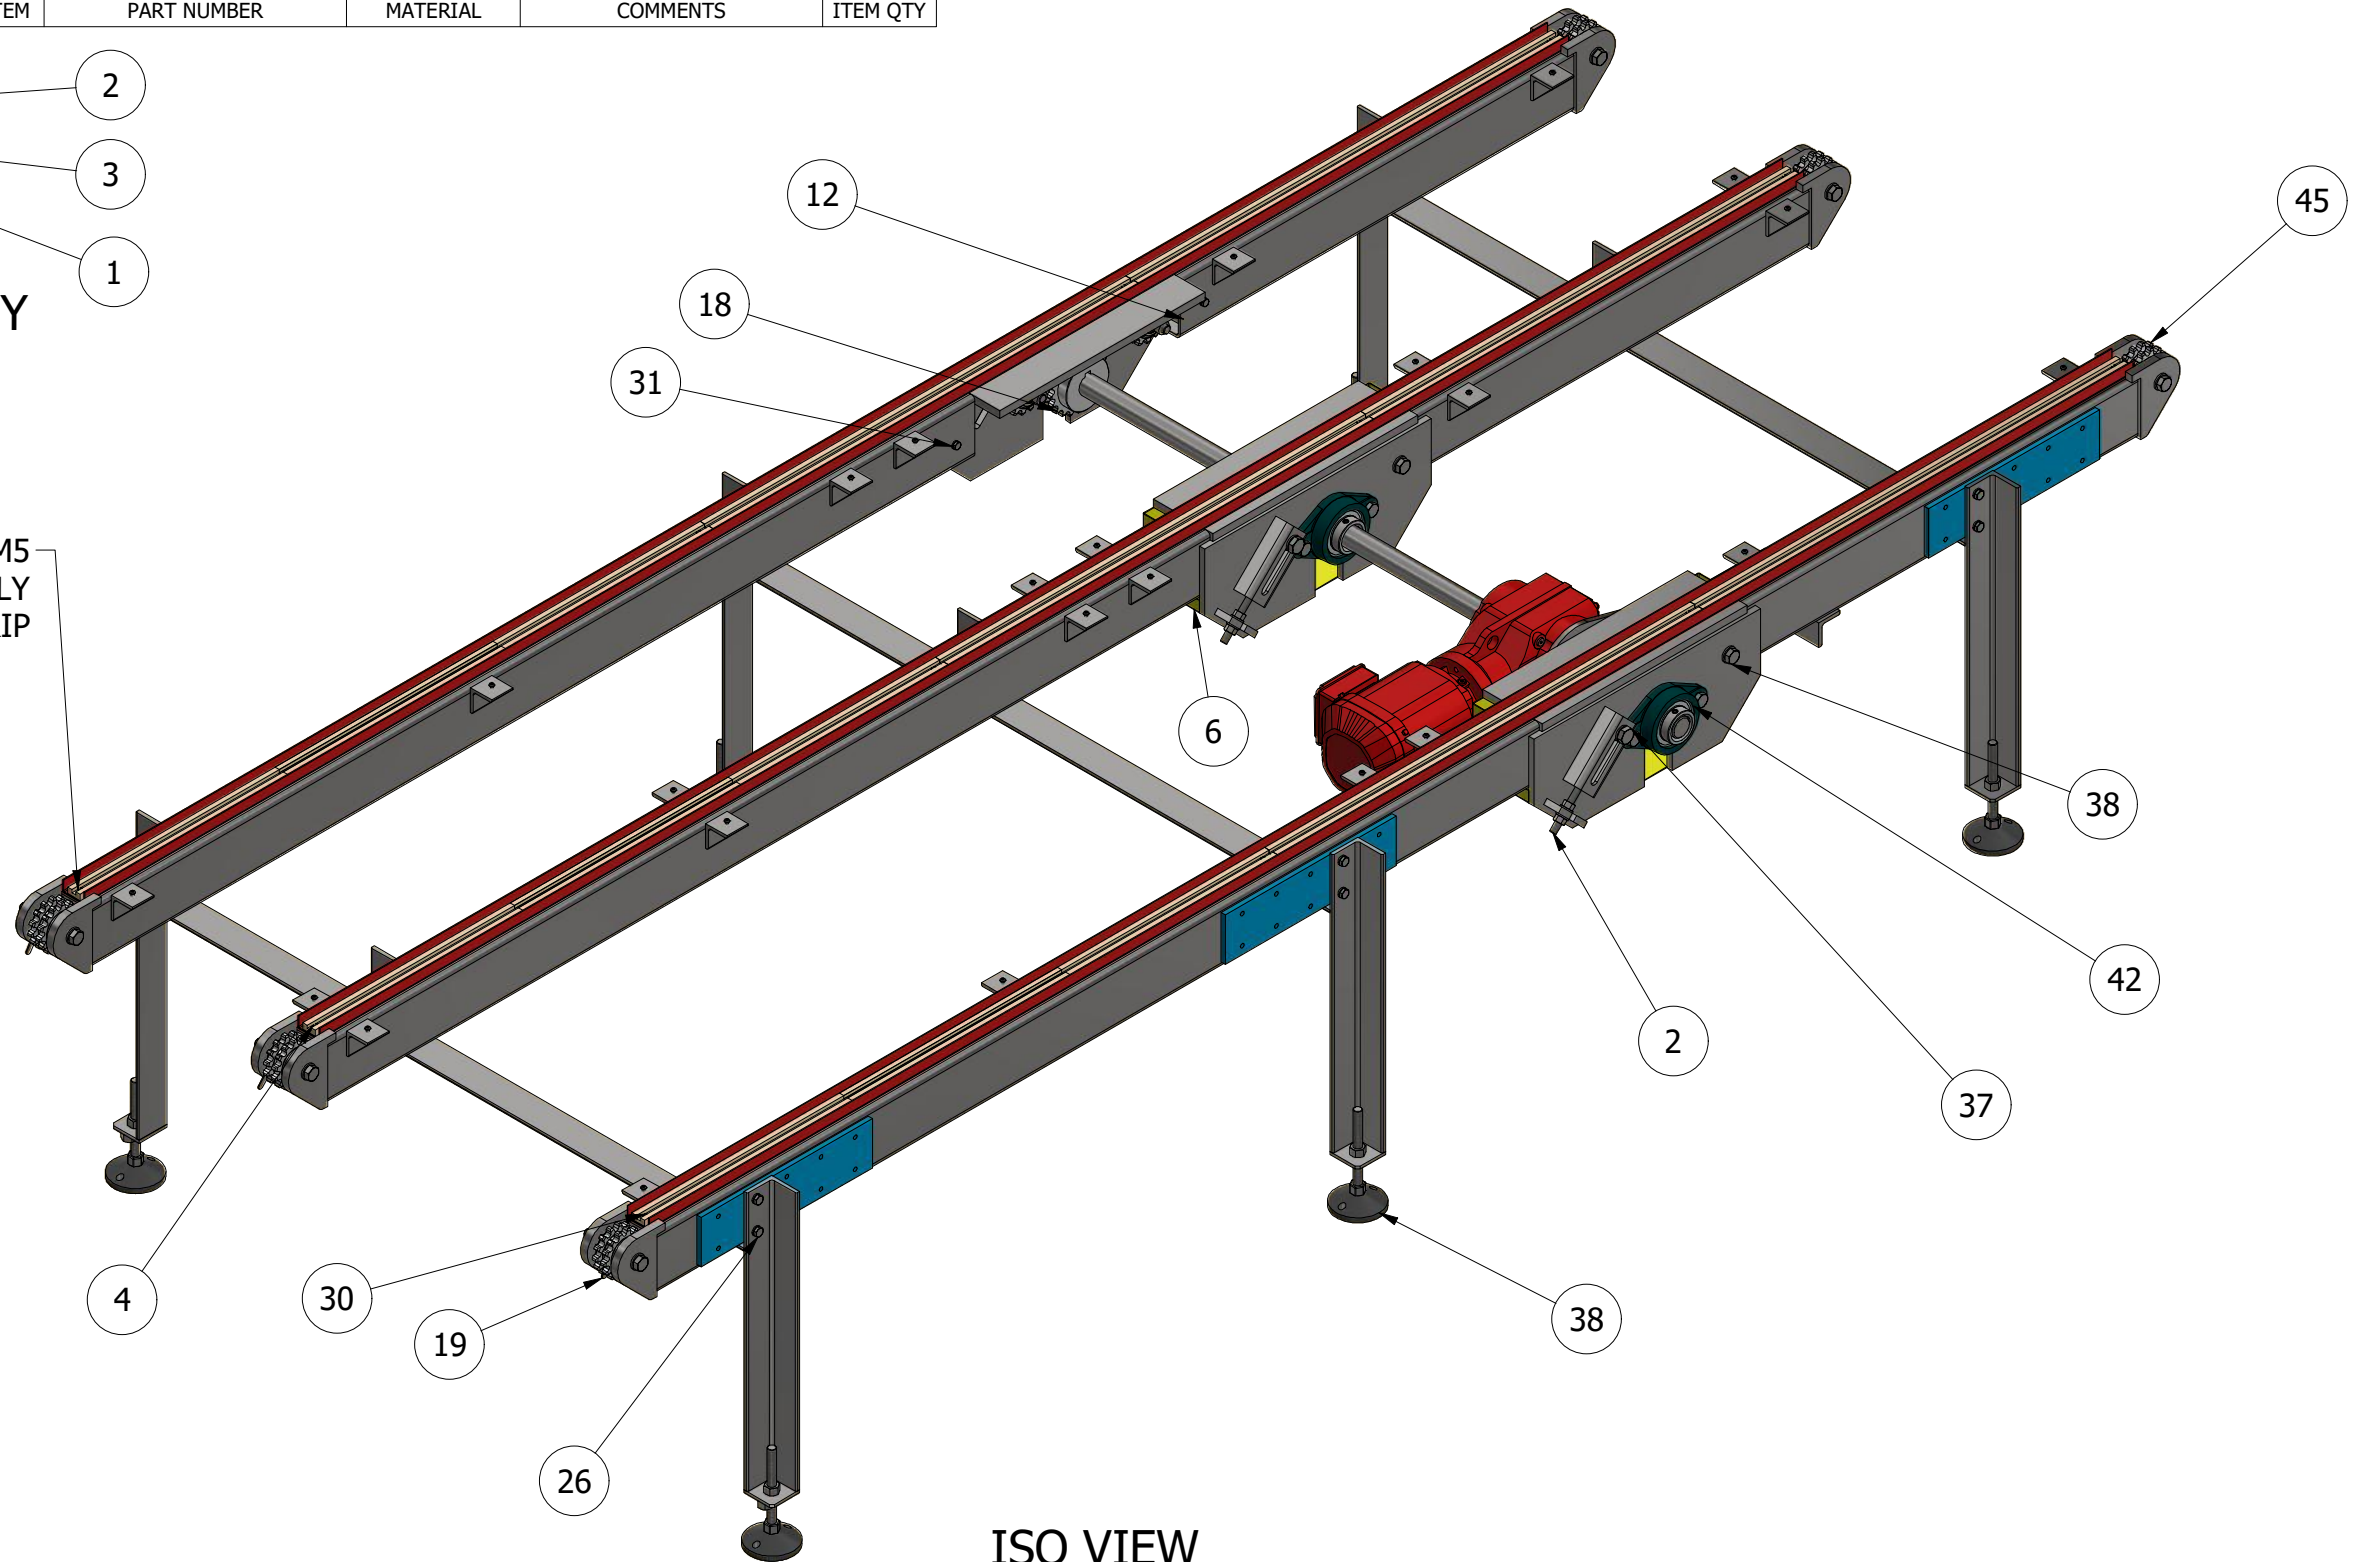


ISO VIEW  
TREADPLATE REMOVED  
SCALE 1:12.5

DRAWN BY ULTIMATE ENGINEERING PTY LTD Ph 8562 1511



THESE DRAWINGS ARE THE PROPERTY OF ULTIMATE ENGINEERING AND SHOULD NOT BE REPRODUCED OR COPIED IN ANY WAY WITHOUT WRITTEN PERMISSION FROM ULTIMATE ENGINEERING

PAINT TREATMENT:

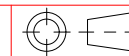

DIMENSION TOLERANCES	
DECIMAL	ANGULAR
X.X = ± .5 mm	X = ± 1°
X.XX = ± .25 mm	X.X = ± .5°
X.XXX = ± .125 mm	X.XX = ± .25°

MAXIMUM FINISHED SURFACE ROUGHNESS U.N.O. 1.6

PARENT ASSEMBLY

CUSTOMER:

**RAB ENGINEERING**

DRAWN: David Bilney

TITLE:

A1948-000-01  
CHAIN CONVEYORS

DESIGNED: David Bilney

DWG NO:

**194801**

DATE: 15/03/2021

JOB NO:

SCALE:  
Scale

SHEET  
3 OF 34

SHEET SIZE:  
A3


REV:  
1




DO NOT SCALE DRAWING

4	P1948-000-03	Steel, Mild	194801/14	1
3	P1948-000-05	Steel, Mild	194801/16	2
2	P1948-000-04	Steel, Mild	194801/15	1
1	P1948-000-01	Steel, Mild	194801/12	1
ITEM	PART NUMBER	MATERIAL	COMMENTS	ITEM QTY


W1948-000-01 - 2 REQ'D AS DRAWN

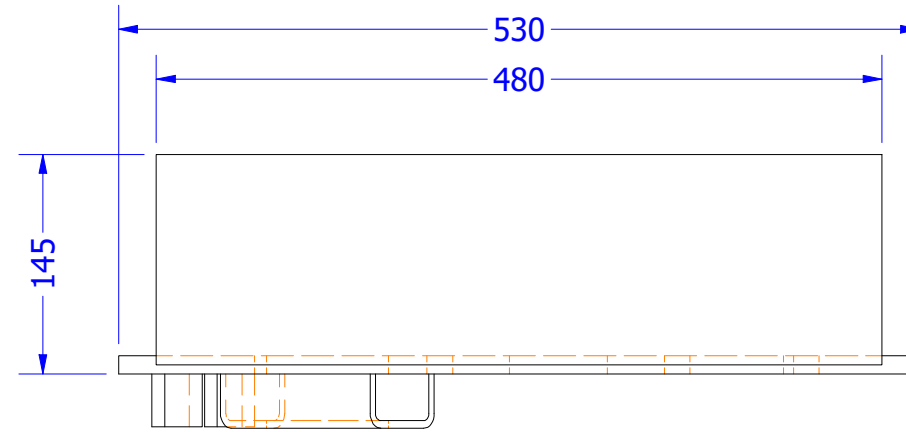


PLAN VIEW  
SCALE 1:5

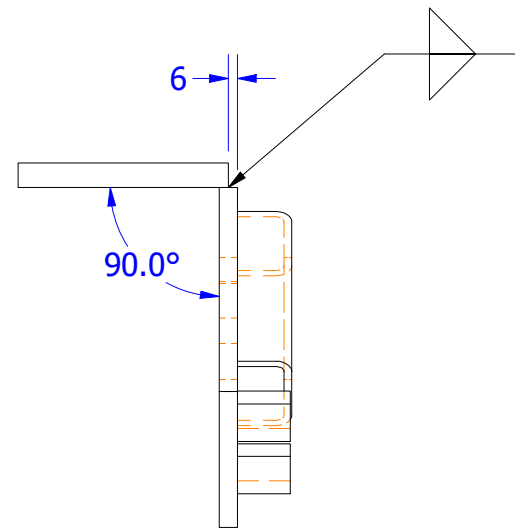

END VIEW  
SCALE 1:5

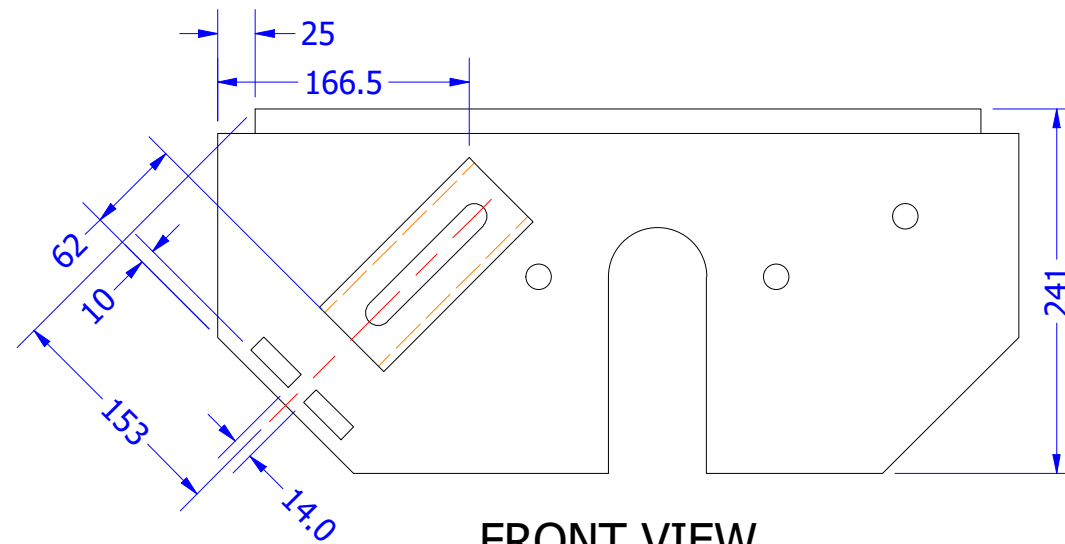

FRONT VIEW  
SCALE 1:5

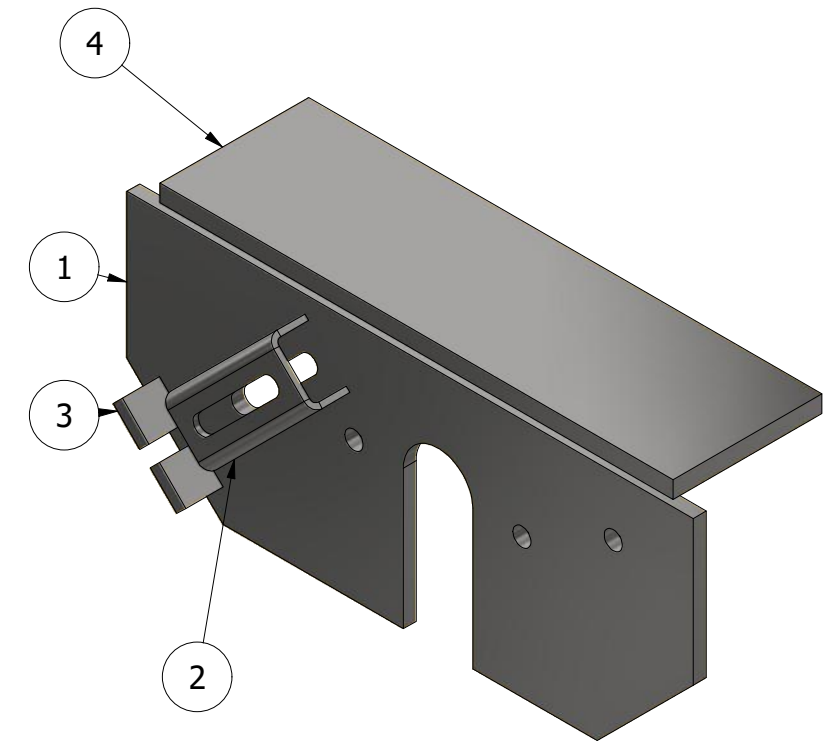

ISO VIEW  
SCALE 1:5

NOTES:

- ALL WELDING TO CONFORM TO AS1554-GP UNO
- ALL FILLET WELDS TO BE 6mm CONTINUOUS UNO
- ALL BUTT WELDS SHALL BE FULL STRENGTH, COMPLETE PENETRATION WELDS
- ALL FLAME CUT SURFACES SHALL BE UNIFORM & CLEAN BEFORE WELDING
- REMOVE ALL BURRS & SHARP EDGES
- NON DESTRUCTIVE TESTING:
  - A) ALL WELDS, 100% VISUAL SCAN TO AS1554 PART 1
- FINISH:
  - A) ALL STEELWORK TO BE PRIMED OR COLD GALV UNO

DRAWN BY ULTIMATE ENGINEERING PTY LTD Ph 8562 1511



THESE DRAWINGS ARE THE PROPERTY OF ULTIMATE ENGINEERING AND SHOULD NOT BE REPRODUCED OR COPIED IN ANY WAY WITHOUT WRITTEN PERMISSION FROM ULTIMATE ENGINEERING

PAINT TREATMENT:



DIMENSION TOLERANCES	
DECIMAL	ANGULAR
X.X = ± .5 mm	X = ± 1°
X.XX = ± .25 mm	X.X = ± .5°
X.XXX = ± .125 mm	X.XX = ± .25°

MAXIMUM FINISHED SURFACE ROUGHNESS U.N.O. 1.6

PARENT ASSEMBLY

CUSTOMER:

RAB ENGINEERING

DRAWN: David Bilney

TITLE:

W1948-000-01  
CHAIN CONVEYORS

DESIGNED: David Bilney

DWG NO:

194801/4

DATE: 15/03/2021

JOB NO:

SCALE:  
Scale

SHEET  
4 OF 34


SHEET SIZE:  
A3

REV:  
1


DO NOT SCALE DRAWING

4	P1948-000-03	Steel, Mild	194801/14	1
3	P1948-000-05	Steel, Mild	194801/16	2
2	P1948-000-04	Steel, Mild	194801/15	1
1	P1948-000-01	Steel, Mild	194801/12	1
ITEM	PART NUMBER	MATERIAL	COMMENTS	ITEM QTY


W1948-000-02 - 1 REQ'D AS DRAWN

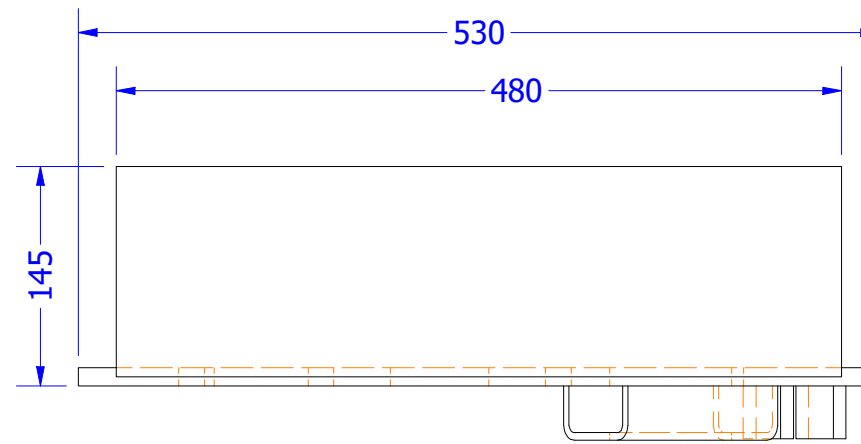


PLAN VIEW  
SCALE 1:5

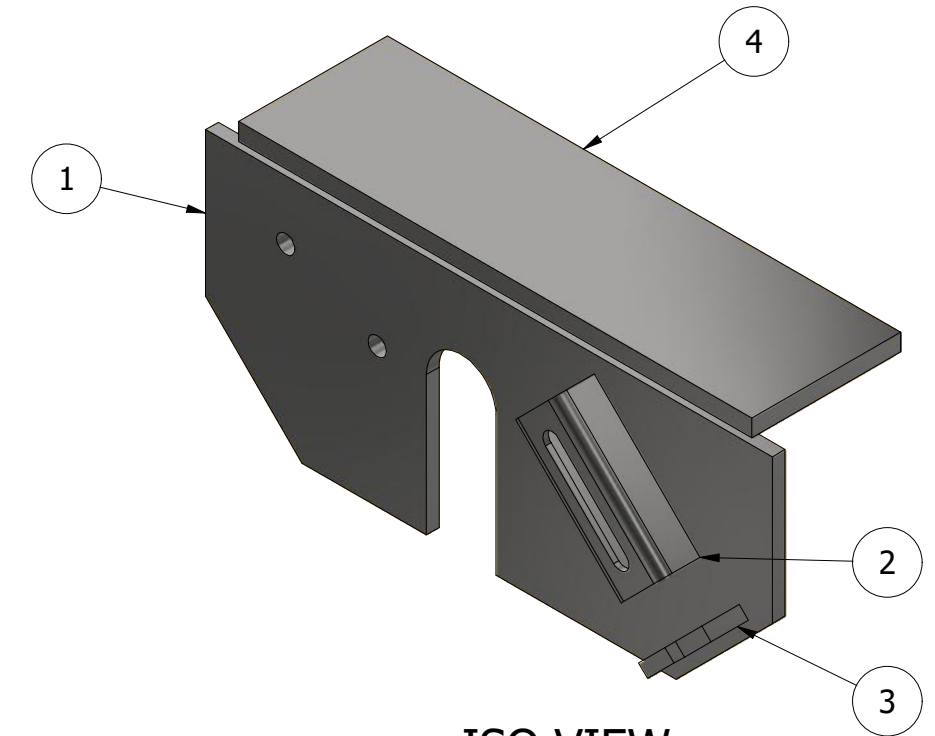

ISO VIEW  
SCALE 1:5

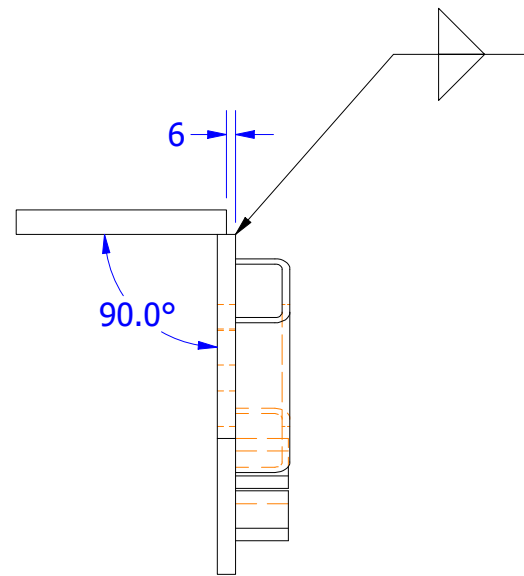

END VIEW  
SCALE 1:5

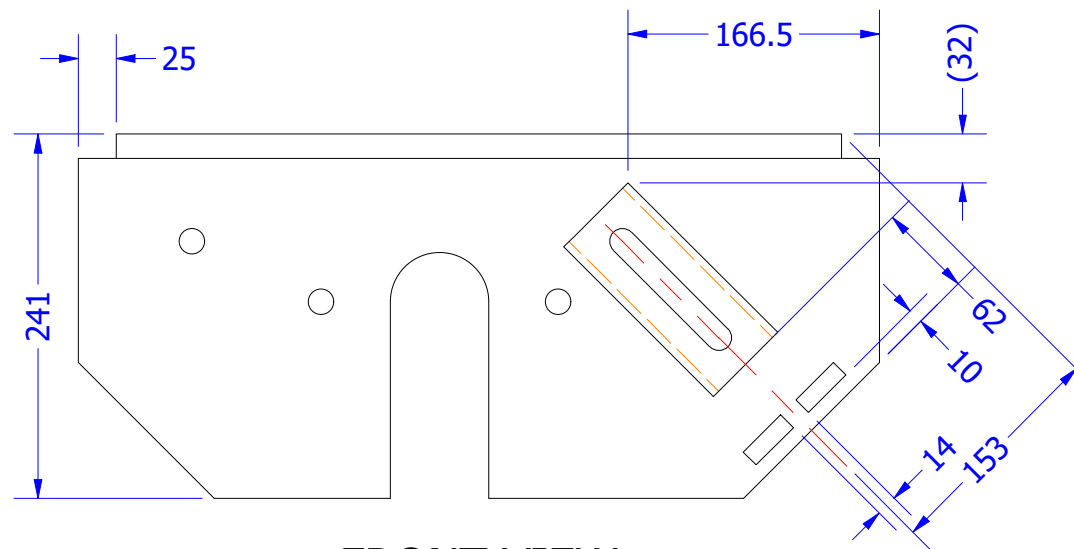

FRONT VIEW  
SCALE 1:5

NOTES:

- ALL WELDING TO CONFORM TO AS1554-GP UNO
- ALL FILLET WELDS TO BE 6mm CONTINUOUS UNO
- ALL BUTT WELDS SHALL BE FULL STRENGTH, COMPLETE PENETRATION WELDS
- ALL FLAME CUT SURFACES SHALL BE UNIFORM & CLEAN BEFORE WELDING
- REMOVE ALL BURRS & SHARP EDGES
- NON DESTRUCTIVE TESTING:  
A) ALL WELDS, 100% VISUAL SCAN TO AS1554 PART 1
- FINISH:  
A) ALL STEELWORK TO BE PRIMED OR COLD GALV UNO

DRAWN BY ULTIMATE ENGINEERING PTY LTD Ph 8562 1511




THESE DRAWINGS ARE THE PROPERTY OF ULTIMATE ENGINEERING AND SHOULD NOT BE REPRODUCED OR COPIED IN ANY WAY WITHOUT WRITTEN PERMISSION FROM ULTIMATE ENGINEERING

PAINT TREATMENT:

DIMENSION TOLERANCES	
DECIMAL	ANGULAR
X.X = ± .5 mm	X = ± 1°
X.XX = ± .25 mm	X.X = ± .5°
X.XXX = ± .125 mm	X.XX = ± .25°

MAXIMUM FINISHED SURFACE ROUGHNESS U.N.O. 1.6

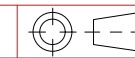

PARENT ASSEMBLY

CUSTOMER:

RAB ENGINEERING

DRAWN: David Bilney

TITLE:

W1948-000-02  
CHAIN CONVEYORS

DESIGNED: David Bilney

DWG NO:

194801/5

DATE: 15/03/2021

JOB NO:

SCALE:  
Scale

SHEET  
5 OF 34







SHEET SIZE:  
A3

REV:  
1

DO NOT SCALE DRAWING

6	65x8 EA @ 115	Steel, Mild	194801	1
5	AS 1112 - M16	Steel, Mild	HEX NUT	2
4	65x8 EA @ 1415	Steel, Mild		1
3	P1948-000-08	Steel, Mild	194801/18	2
2	65x8 EA @ 604	Steel, Mild		1
1	65x8 EA @ 604	Steel, Mild		1
ITEM	PART NUMBER	MATERIAL	COMMENTS	ITEM QTY

W1948-000-03 - 3 REQ'D AS DRAWN

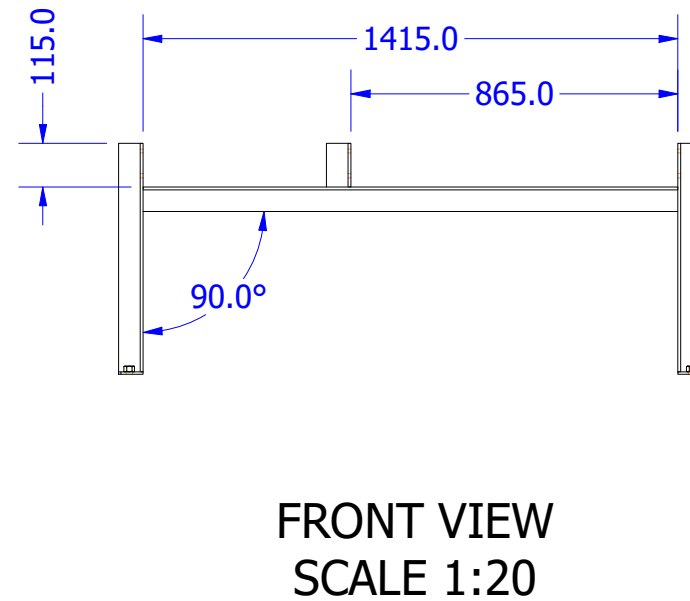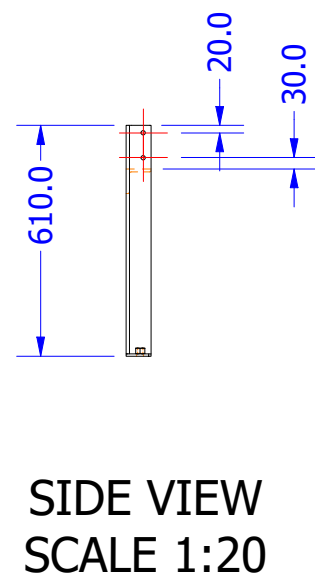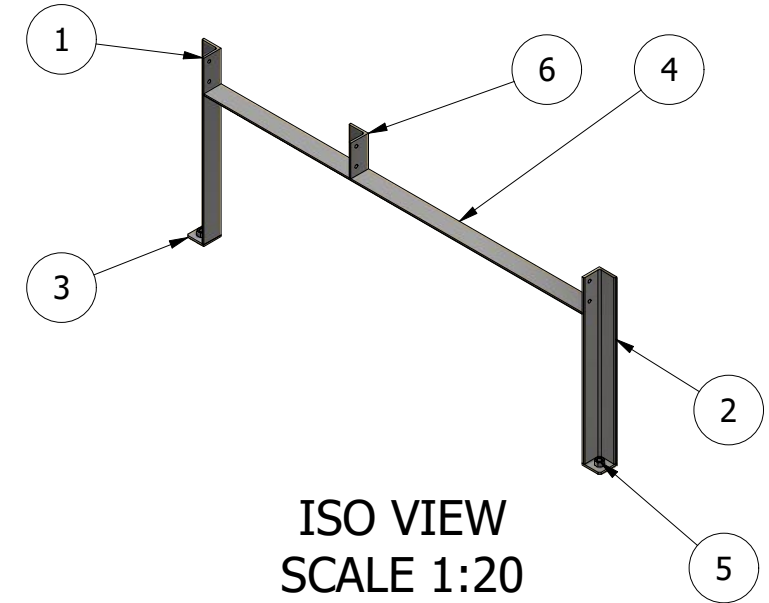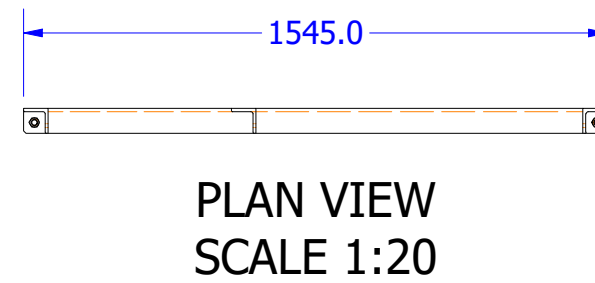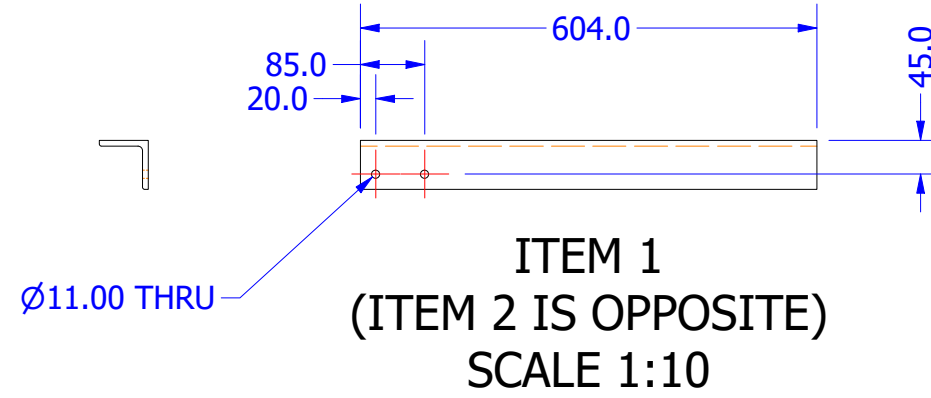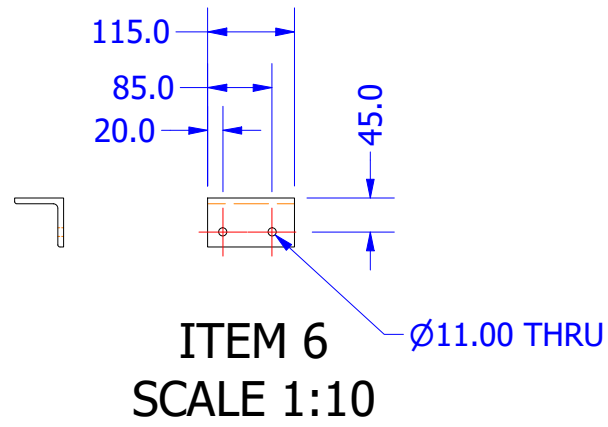

NOTES:


- ALL WELDING TO CONFORM TO AS1554-GP UNO
- ALL FILLET WELDS TO BE 6mm CONTINUOUS UNO
- ALL BUTT WELDS SHALL BE FULL STRENGTH, COMPLETE PENETRATION WELDS
- ALL FLAME CUT SURFACES SHALL BE UNIFORM & CLEAN BEFORE WELDING
- REMOVE ALL BURRS & SHARP EDGES
- NON DESTRUCTIVE TESTING:
  - ALL WELDS, 100% VISUAL SCAN TO AS1554 PART 1
  - ALL STEELWORK TO BE PRIMED OR COLD GALV UNO
- FINISH:

DRAWN BY ULTIMATE ENGINEERING PTY LTD Ph 8562 1511



THESE DRAWINGS ARE THE PROPERTY OF ULTIMATE ENGINEERING AND SHOULD NOT BE REPRODUCED OR COPIED IN ANY WAY WITHOUT WRITTEN PERMISSION FROM ULTIMATE ENGINEERING

PAINT TREATMENT: GREY

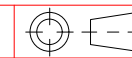

DIMENSION TOLERANCES  
 DECIMAL ANGULAR  
 X.X = ± .5 mm X = ± 1'  
 X.XX = ± .25 mm X.X = ± .5°  
 X.XXX = ± .125 mm X.XX = ± .25°  
 MAXIMUM FINISHED SURFACE ROUGHNESS U.N.O. 1.6

PARENT ASSEMBLY

CUSTOMER: **RAB ENGINEERING**

DRAWN: David Bilney

TITLE: W1948-000-03  
CHAIN CONVEYORS

DESIGNED: David Bilney

DWG NO: **194801/6**

DATE: 15/03/2021

JOB NO:






SCALE: Scale  
SHEET 6 OF 34

SHEET SIZE: A3  
REV: 1

DO NOT SCALE DRAWING

2	50x3 EA @ 50	Steel, Mild	194801	2
1	P1948-000-16	Steel, Mild	194801/26	1
ITEM	PART NUMBER	MATERIAL	COMMENTS	ITEM QTY

W1948-000-04 - 1 REQ'D AS DRAWN

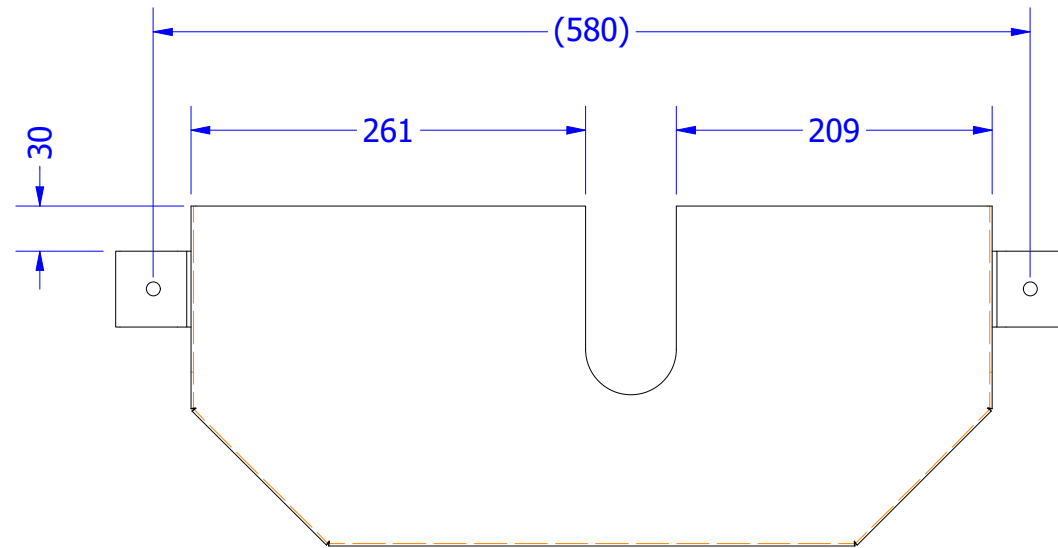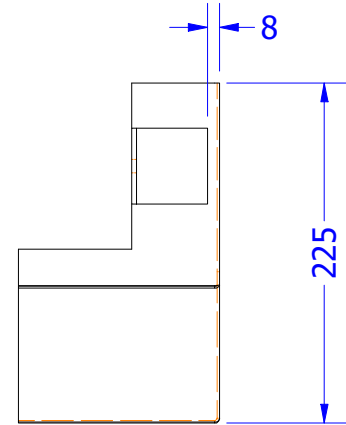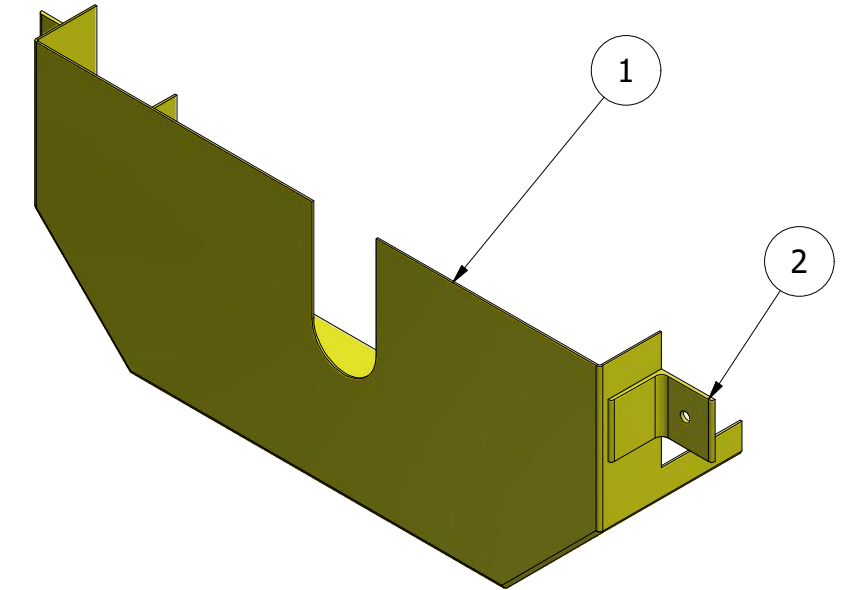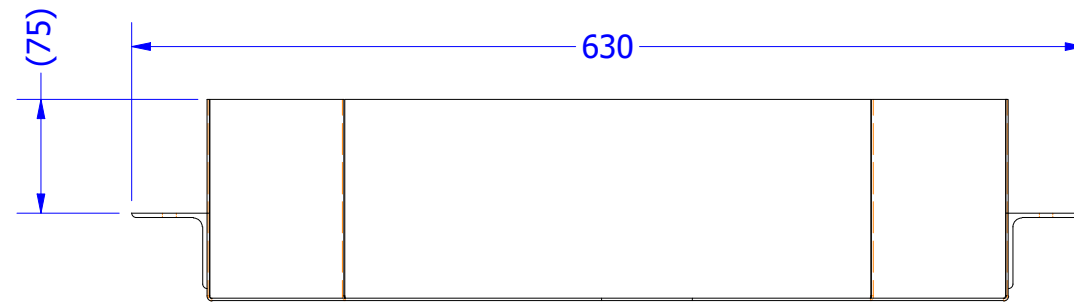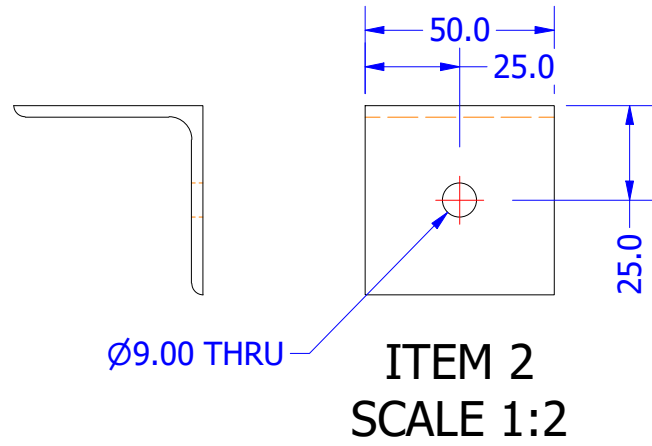

NOTES:


- ALL WELDING TO CONFORM TO AS1554-GP UNO
- ALL FILLET WELDS TO BE 6mm CONTINUOUS UNO
- ALL BUTT WELDS SHALL BE FULL STRENGTH, COMPLETE PENETRATION WELDS
- ALL FLAME CUT SURFACES SHALL BE UNIFORM & CLEAN BEFORE WELDING
- REMOVE ALL BURRS & SHARP EDGES
- NON DESTRUCTIVE TESTING:
  - ALL WELDS, 100% VISUAL SCAN TO AS1554 PART 1
- FINISH:
  - ALL STEELWORK TO BE PRIMED OR COLD GALV UNO

DRAWN BY ULTIMATE ENGINEERING PTY LTD Ph 8562 1511



THESE DRAWINGS ARE THE PROPERTY OF ULTIMATE ENGINEERING AND SHOULD NOT BE REPRODUCED OR COPIED IN ANY WAY WITHOUT WRITTEN PERMISSION FROM ULTIMATE ENGINEERING

PAINT TREATMENT: YELLOW

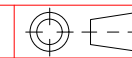

DIMENSION TOLERANCES	
DECIMAL	ANGULAR
X.X = ± .5 mm	X = ± 1°
X.XX = ± .25 mm	X.X = ± .5°
X.XXX = ± .125 mm	X.XX = ± .25°






MAXIMUM FINISHED SURFACE ROUGHNESS U.N.O. 1.6

PARENT ASSEMBLY	CUSTOMER: <b>RAB ENGINEERING</b>
DRAWN: David Bilney	TITLE: W1948-000-04 CHAIN CONVEYORS
DESIGNED: David Bilney	DWG NO: <b>194801/7</b>
DATE: 15/03/2021	JOB NO:
SCALE: Scale	SHEET 7 OF 34
SHEET SIZE: A3	REV: 1

DO NOT SCALE DRAWING

2	50x3 EA @ 50	Steel, Mild	194801	2
1	P1948-000-17	Steel, Mild	194801	1
ITEM	PART NUMBER	MATERIAL	COMMENTS	ITEM QTY

W1948-000-05 - 2 REQ'D AS DRAWN

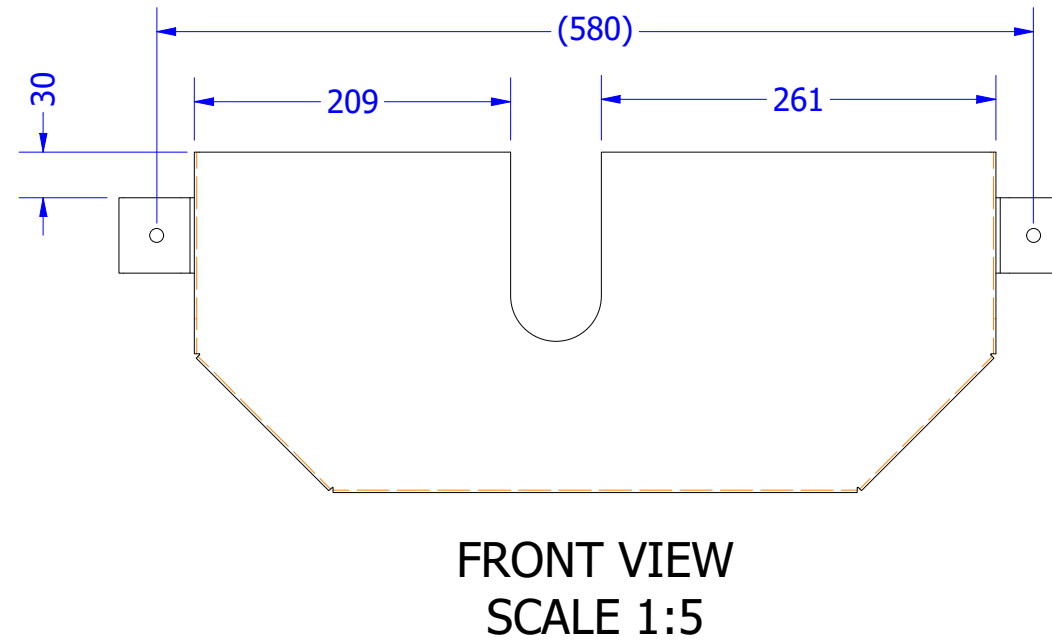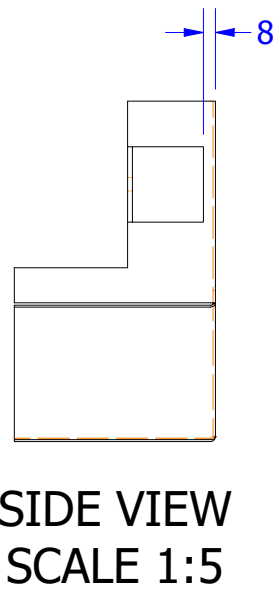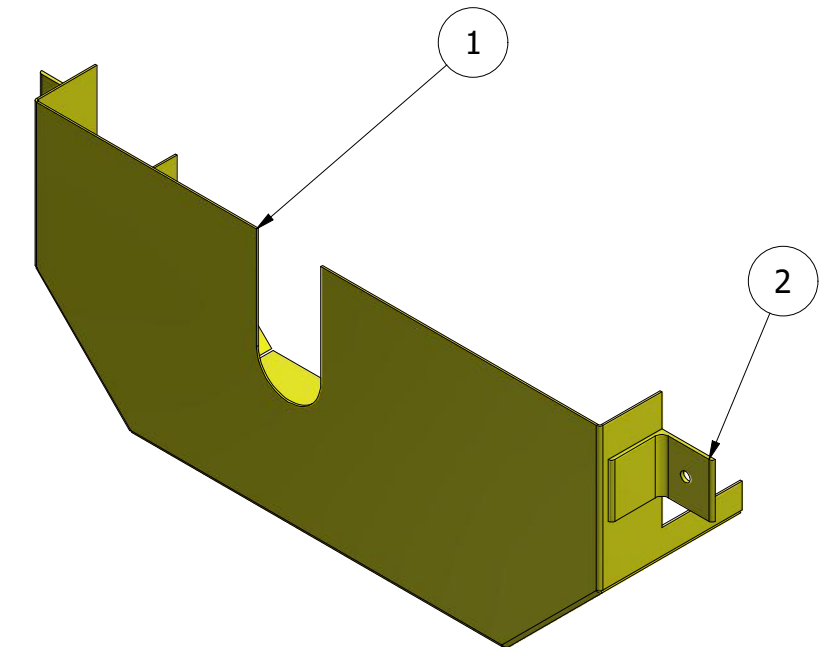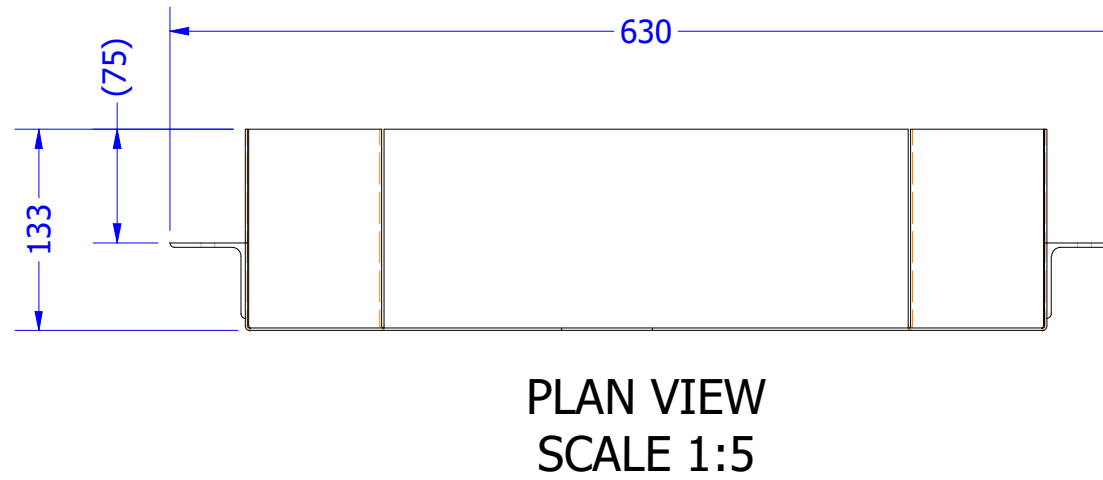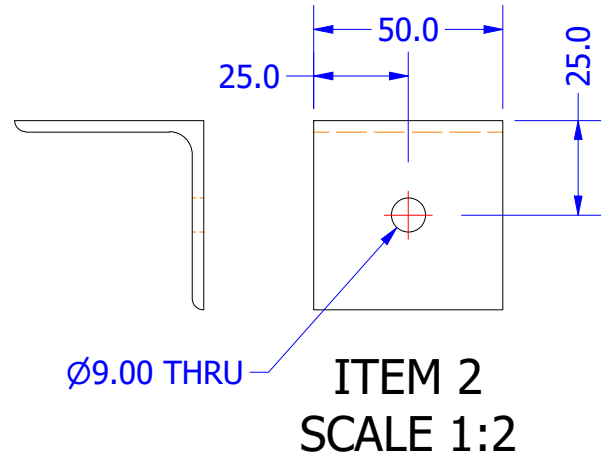


- NOTES:
- ALL WELDING TO CONFORM TO AS1554-GP UNO
  - ALL FILLET WELDS TO BE 6mm CONTINUOUS UNO
  - ALL BUTT WELDS SHALL BE FULL STRENGTH, COMPLETE PENETRATION WELDS
  - ALL FLAME CUT SURFACES SHALL BE UNIFORM & CLEAN BEFORE WELDING
  - REMOVE ALL BURRS & SHARP EDGES
  - NON DESTRUCTIVE TESTING:
    - A) ALL WELDS, 100% VISUAL SCAN TO AS1554 PART 1
  - FINISH:
    - A) ALL STEELWORK TO BE PRIMED OR COLD GALV UNO

DRAWN BY ULTIMATE ENGINEERING PTY LTD Ph 8562 1511



THESE DRAWINGS ARE THE PROPERTY OF ULTIMATE ENGINEERING AND SHOULD NOT BE REPRODUCED OR COPIED IN ANY WAY WITHOUT WRITTEN PERMISSION FROM ULTIMATE ENGINEERING

PAINT TREATMENT: YELLOW

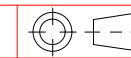


DIMENSION TOLERANCES	
DECIMAL	ANGULAR
X.X = ± .5 mm	X = ± 1°
X.XX = ± .25 mm	X.X = ± .5°
X.XXX = ± .125 mm	X.XX = ± .25°

MAXIMUM FINISHED SURFACE ROUGHNESS U.N.O. 1.6


PARENT ASSEMBLY	CUSTOMER: <b>RAB ENGINEERING</b>
DRAWN: David Bilney	TITLE: W1948-000-05 CHAIN CONVEYORS
DESIGNED: David Bilney	DWG NO: <b>194801/8</b>
DATE: 15/03/2021	JOB NO:
SCALE: Scale	SHEET: 8 OF 34
	SHEET SIZE: A3
	REV: 1




DO NOT SCALE DRAWING

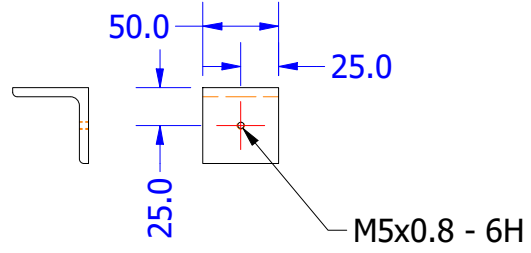


ITEM 6  
SCALE 1:5

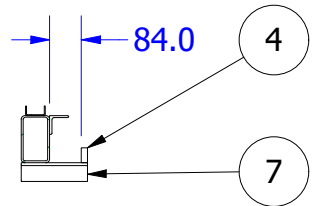


SECTION B-B  
SCALE 1:20

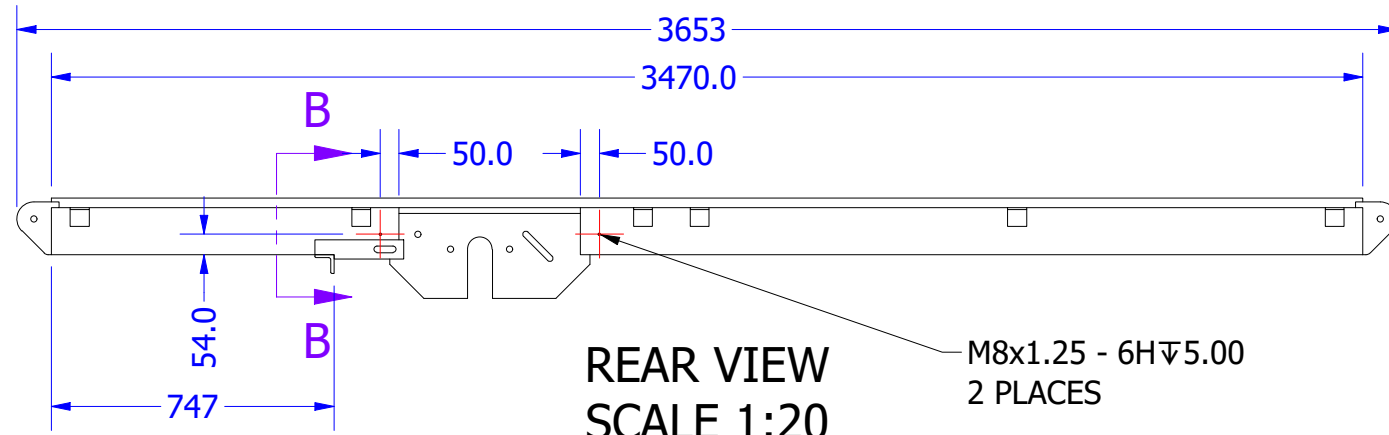

REAR VIEW  
SCALE 1:20

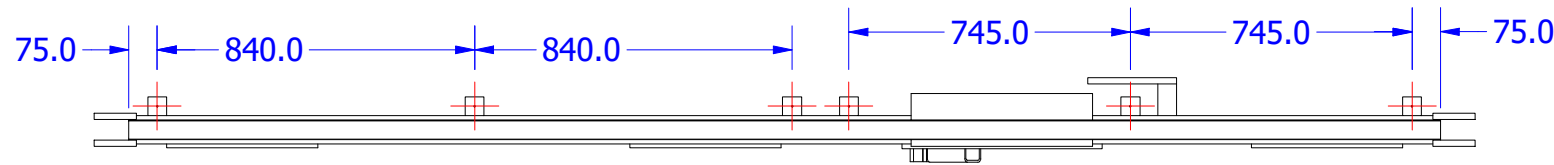


PLAN VIEW  
SCALE 1:20

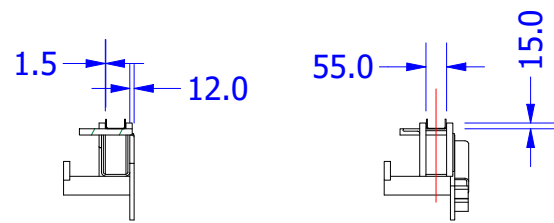


SECTION A-A  
SCALE 1:20

END VIEW  
SCALE 1:20

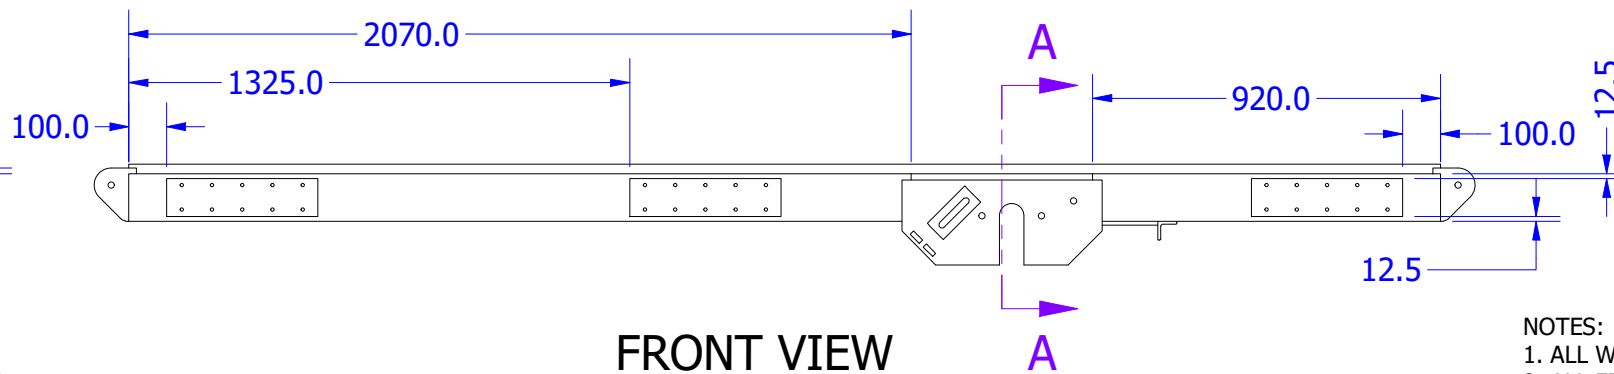

FRONT VIEW  
SCALE 1:20

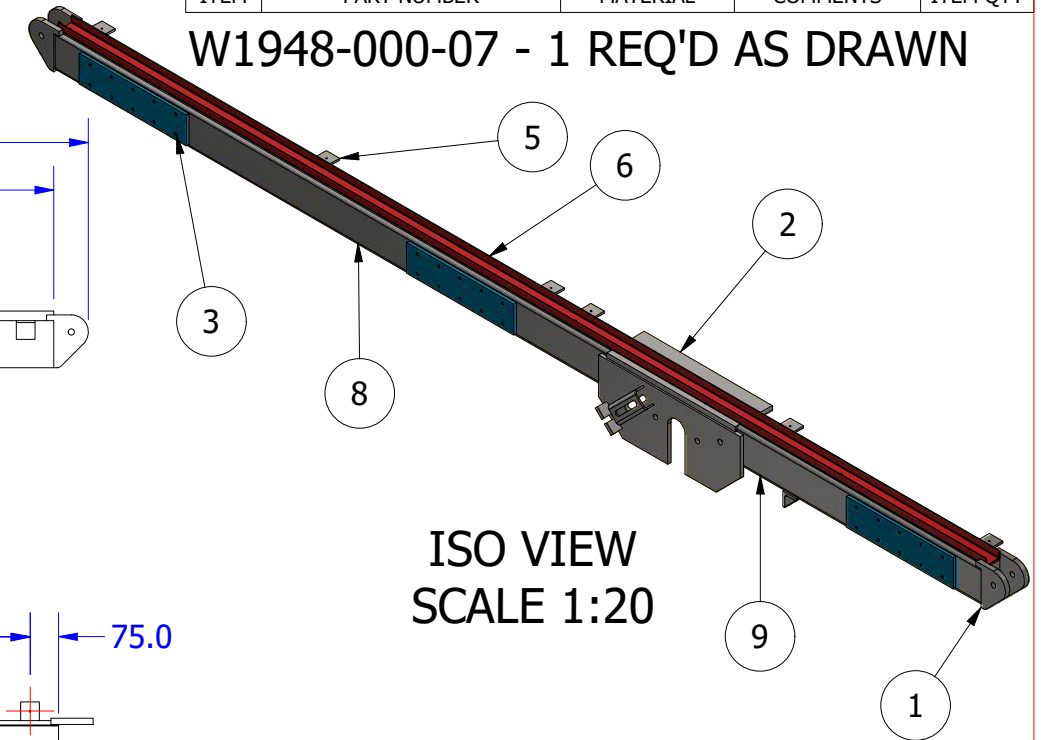

W1948-000-07 - 1 REQ'D AS DRAWN

ISO VIEW  
SCALE 1:20

ITEM	PART NUMBER	MATERIAL	COMMENTS	ITEM QTY
9	125x75x5.0 RHS @ 920	Steel, Mild		1
8	125x75x5.0 RHS @ 2070	Steel, Mild		1
7	50x8 EA @ 175	Steel, Mild	50x6 EA @ 175	1
6	P1948-000-27	Steel, Mild	194801/32	1
5	50x6 EA @ 50	Steel, Mild	50x6 EA @ 50	6
4	P1948-000-13	Steel, Mild	194801/23	1
3	P1948-000-06	Steel, Mild	194801/17	3
2	W1948-000-01	Weldment	194801/4	1
1	P1948-000-02	Steel, Mild	194801/13	4

M8x1.25 - 6H 5.00  
2 PLACES


- NOTES:
- ALL WELDING TO CONFORM TO AS1554-GP UNO
  - ALL FILLET WELDS TO BE 6mm CONTINUOUS UNO
  - ALL BUTT WELDS SHALL BE FULL STRENGTH, COMPLETE PENETRATION WELDS
  - ALL FLAME CUT SURFACES SHALL BE UNIFORM & CLEAN BEFORE WELDING
  - REMOVE ALL BURRS & SHARP EDGES
  - NON DESTRUCTIVE TESTING:
    - A) ALL WELDS, 100% VISUAL SCAN TO AS1554 PART 1
  - FINISH:
    - A) ALL STEELWORK TO BE PRIMED OR COLD GALV UNO

DRAWN BY ULTIMATE ENGINEERING PTY LTD Ph 8562 1511



THESE DRAWINGS ARE THE PROPERTY OF ULTIMATE ENGINEERING AND SHOULD NOT BE REPRODUCED OR COPIED IN ANY WAY WITHOUT WRITTEN PERMISSION FROM ULTIMATE ENGINEERING

PAINT TREATMENT: GREY

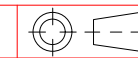

DIMENSION TOLERANCES	
DECIMAL	ANGULAR
X.X = ± .5 mm	X = ± 1°
X.XX = ± .25 mm	X.X = ± .5°
X.XXX = ± .125 mm	X.XX = ± .25°

MAXIMUM FINISHED SURFACE ROUGHNESS U.N.O. 1.6

PARENT ASSEMBLY

CUSTOMER:

**RAB ENGINEERING**

DRAWN: David Bilney

TITLE:

W1948-000-07  
CHAIN CONVEYORS

DESIGNED: David Bilney

DWG NO:

**194801/9**

DATE: 15/03/2021

JOB NO:

SCALE: Scale

SHEET 9 OF 34






SHEET SIZE: A3

REV: 1

DO NOT SCALE DRAWING

7	125x75x5.0 RHS @ 2070	Steel, Mild		1
6	125x75x5.0 RHS @ 920	Steel, Mild		1
5	P1948-000-27	Steel, Mild	194801/32	1
4	50x6 EA @ 50	Steel, Mild	REFER SHEET 9	12
3	P1948-000-06	Steel, Mild	194801/17	3
2	W1948-000-01	Weldment	194801/4	1
1	P1948-000-02	Steel, Mild	194801/13	4
ITEM	PART NUMBER	MATERIAL	COMMENTS	ITEM QTY

W1948-000-08 - 1 REQ'D AS DRAWN

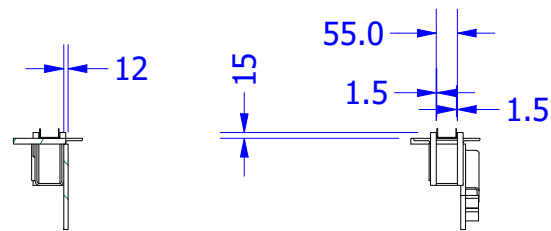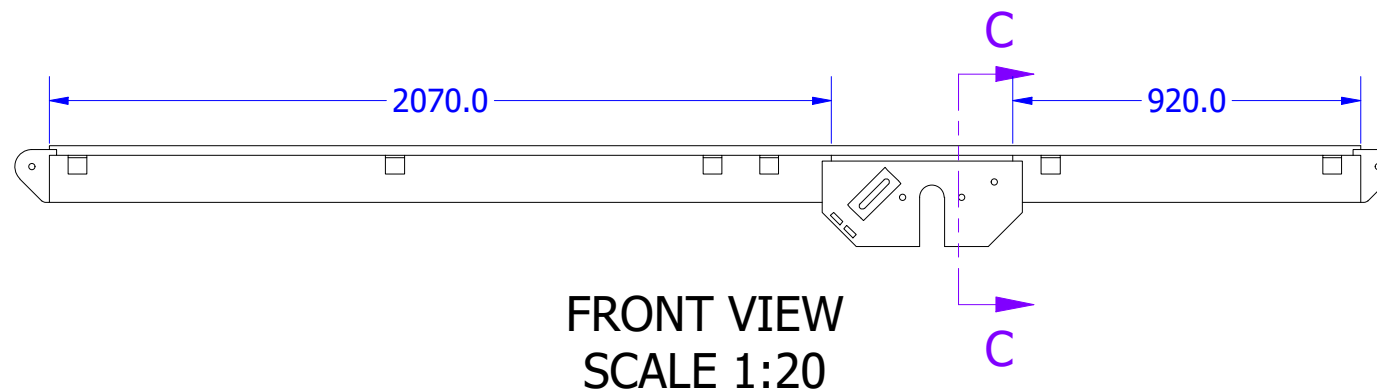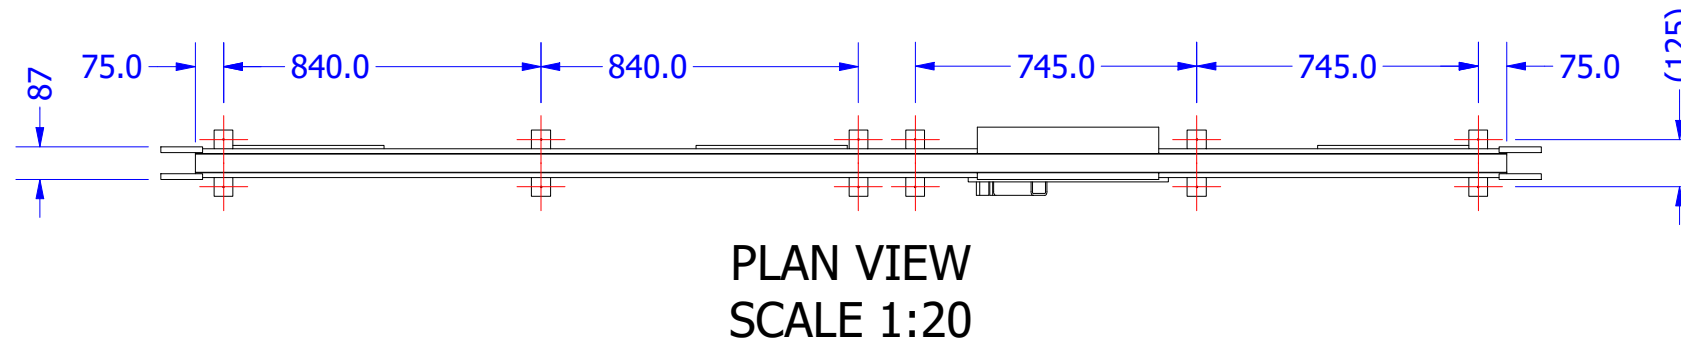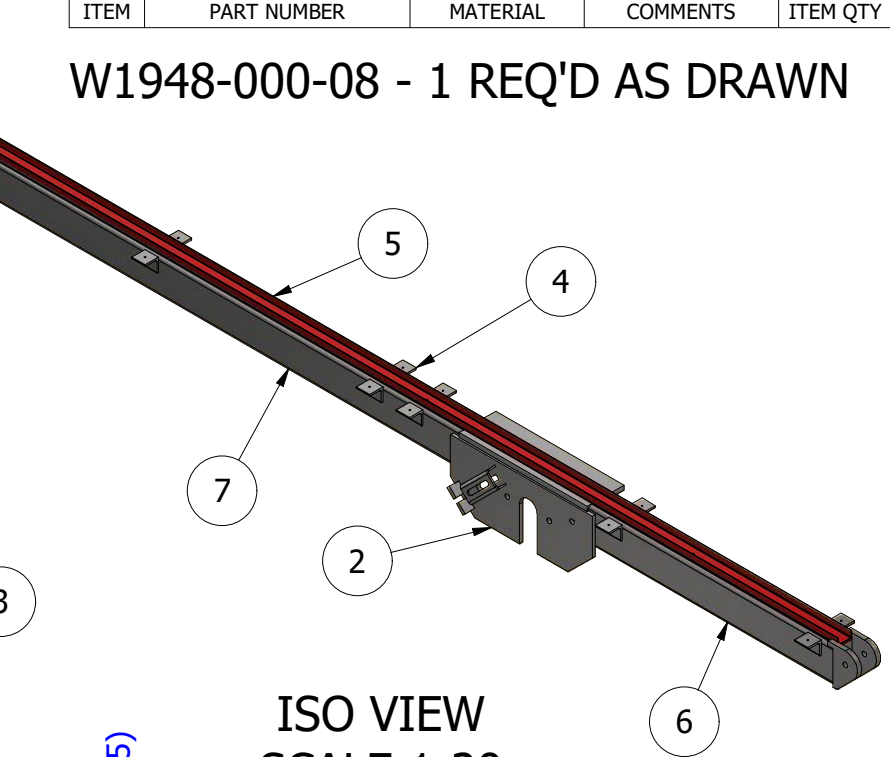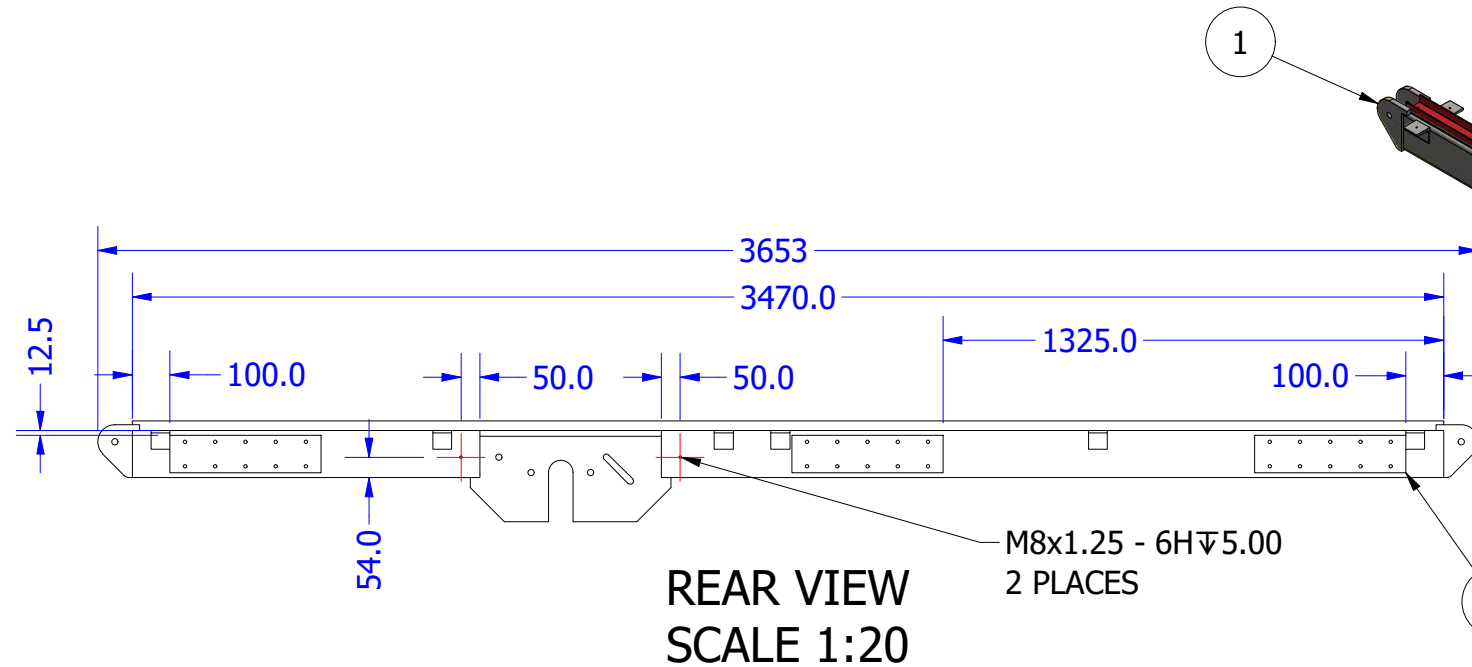

SECTION C-C  
SCALE 1:20

END VIEW  
SCALE 1:20

FRONT VIEW  
SCALE 1:20

NOTES:


- ALL WELDING TO CONFORM TO AS1554-GP UNO
- ALL FILLET WELDS TO BE 6mm CONTINUOUS UNO
- ALL BUTT WELDS SHALL BE FULL STRENGTH, COMPLETE PENETRATION WELDS
- ALL FLAME CUT SURFACES SHALL BE UNIFORM & CLEAN BEFORE WELDING
- REMOVE ALL BURRS & SHARP EDGES
- NON DESTRUCTIVE TESTING:
  - A) ALL WELDS, 100% VISUAL SCAN TO AS1554 PART 1
- FINISH:
  - A) ALL STEELWORK TO BE PRIMED OR COLD GALV UNO

DRAWN BY ULTIMATE ENGINEERING PTY LTD Ph 8562 1511



THESE DRAWINGS ARE THE PROPERTY OF ULTIMATE ENGINEERING AND SHOULD NOT BE REPRODUCED OR COPIED IN ANY WAY WITHOUT WRITTEN PERMISSION FROM ULTIMATE ENGINEERING

PAINT TREATMENT: GREY

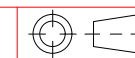

DIMENSION TOLERANCES  
 DECIMAL ANGULAR  
 X.X = ± .5 mm X = ± 1°  
 X.XX = ± .25 mm X.X = ± .5°  
 X.XXX = ± .125 mm X.XX = ± .25°  
 MAXIMUM FINISHED SURFACE ROUGHNESS U.N.O. 1.6

PARENT ASSEMBLY

CUSTOMER: **RAB ENGINEERING**

DRAWN: David Bilney

TITLE: W1948-000-08  
CHAIN CONVEYORS

DESIGNED: David Bilney

DWG NO: **194801/10**

DATE: 15/03/2021

JOB NO:


SCALE: 10 OF 34

SHEET SIZE: A3  
REV: 1


DO NOT SCALE DRAWING

7	125x75x5.0 RHS @ 2070	Steel, Mild		1
6	125x75x5.0 RHS @ 920	Steel, Mild		1
5	P1948-000-27	Steel, Mild	194801/32	1
4	50x6 EA @ 50	Steel, Mild	REFER SHEET 9	6
3	P1948-000-06	Steel, Mild	194801/17	3
2	W1948-000-02	Weldment	194801/5	1
1	P1948-000-02	Steel, Mild	194801/13	4
ITEM	PART NUMBER	MATERIAL	COMMENTS	ITEM QTY


W1948-000-09 - 1 REQ'D AS DRAWN

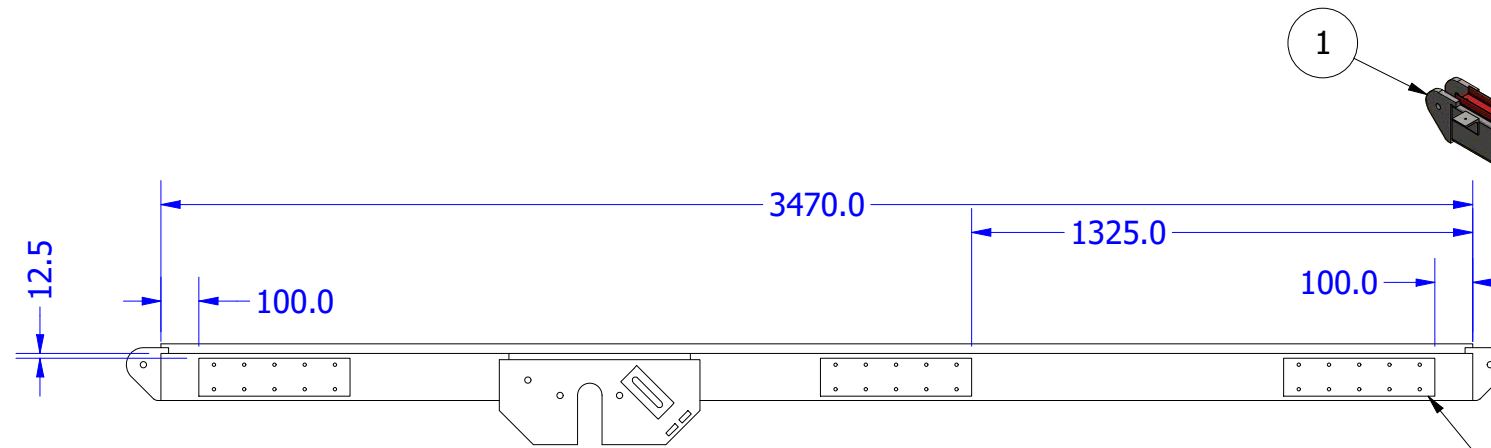


REAR VIEW  
SCALE 1:20

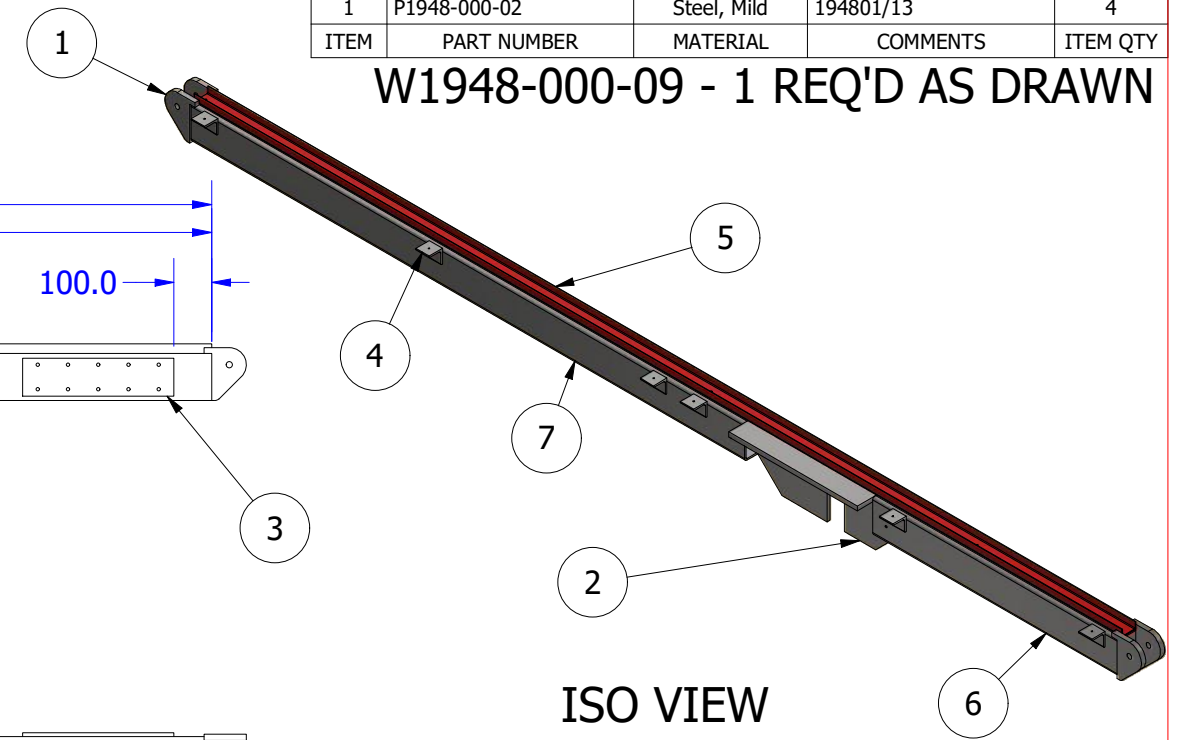


ISO VIEW  
SCALE 1:20

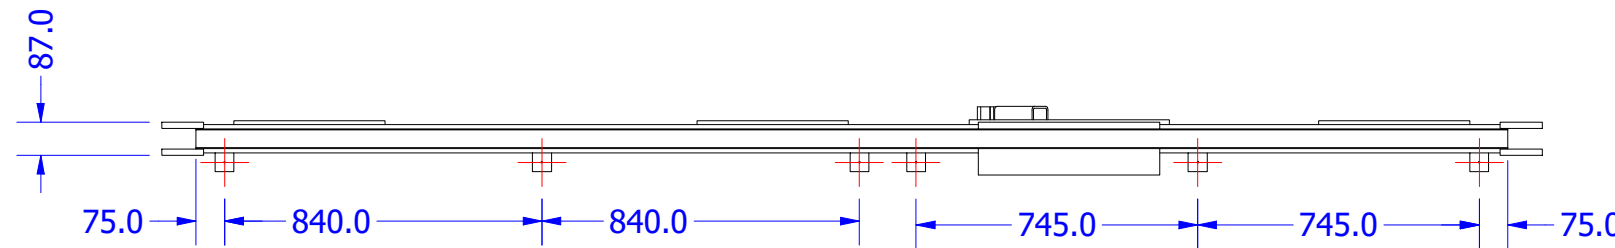


PLAN VIEW  
SCALE 1:20

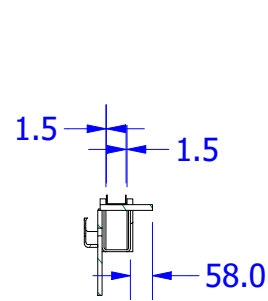

SECTION D-D  
SCALE 1:20

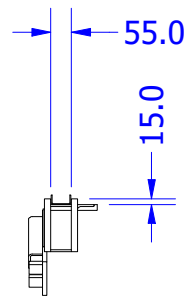

END VIEW  
SCALE 1:20

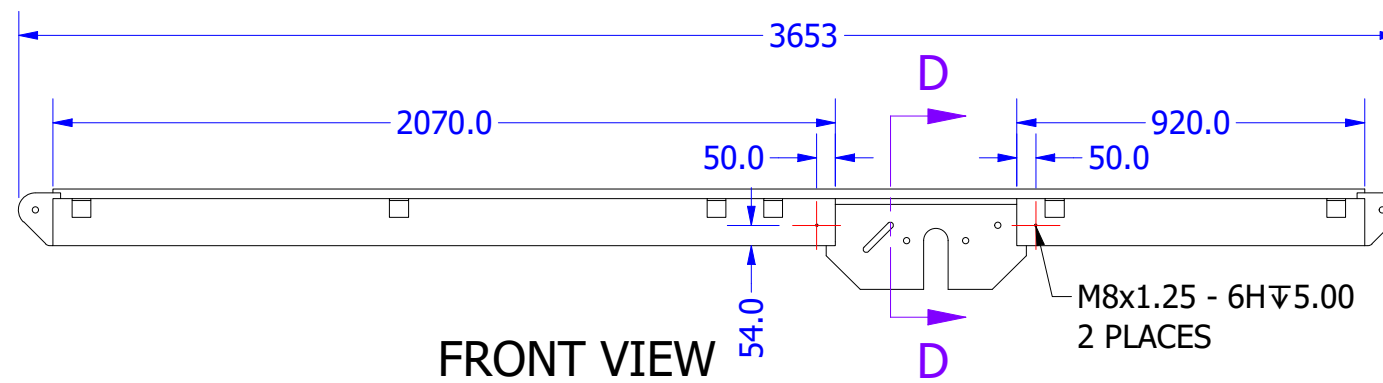

FRONT VIEW  
SCALE 1:20

NOTES:


- ALL WELDING TO CONFORM TO AS1554-GP UNO
- ALL FILLET WELDS TO BE 6mm CONTINUOUS UNO
- ALL BUTT WELDS SHALL BE FULL STRENGTH, COMPLETE PENETRATION WELDS
- ALL FLAME CUT SURFACES SHALL BE UNIFORM & CLEAN BEFORE WELDING
- REMOVE ALL BURRS & SHARP EDGES
- NON DESTRUCTIVE TESTING:
  - A) ALL WELDS, 100% VISUAL SCAN TO AS1554 PART 1
- FINISH:
  - A) ALL STEELWORK TO BE PRIMED OR COLD GALV UNO

DRAWN BY ULTIMATE ENGINEERING PTY LTD Ph 8562 1511



THESE DRAWINGS ARE THE PROPERTY OF ULTIMATE ENGINEERING AND SHOULD NOT BE REPRODUCED OR COPIED IN ANY WAY WITHOUT WRITTEN PERMISSION FROM ULTIMATE ENGINEERING

PAINT TREATMENT: GREY

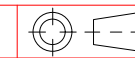

DIMENSION TOLERANCES	
DECIMAL	ANGULAR
X.X = ± .5 mm	X = ± 1°
X.XX = ± .25 mm	X.X = ± .5°
X.XXX = ± .125 mm	X.XX = ± .25°

MAXIMUM FINISHED SURFACE ROUGHNESS U.N.O. 1.6

PARENT ASSEMBLY

CUSTOMER:

RAB ENGINEERING

DRAWN: David Bilney

TITLE:

W1948-000-09  
CHAIN CONVEYORS

DESIGNED: David Bilney

DWG NO:

194801/11

DATE: 15/03/2021

JOB NO:

SCALE: Scale

SHEET 11 OF 34


SHEET SIZE: A3

REV: 1

DO NOT SCALE DRAWING

12mm PLATE @ 530 X 225	Steel, Mild	AS3678 - GR250
DESCRIPTION	MATERIAL	COMMENTS

P1948-000-01 - 3 REQ'D AS DRAWN

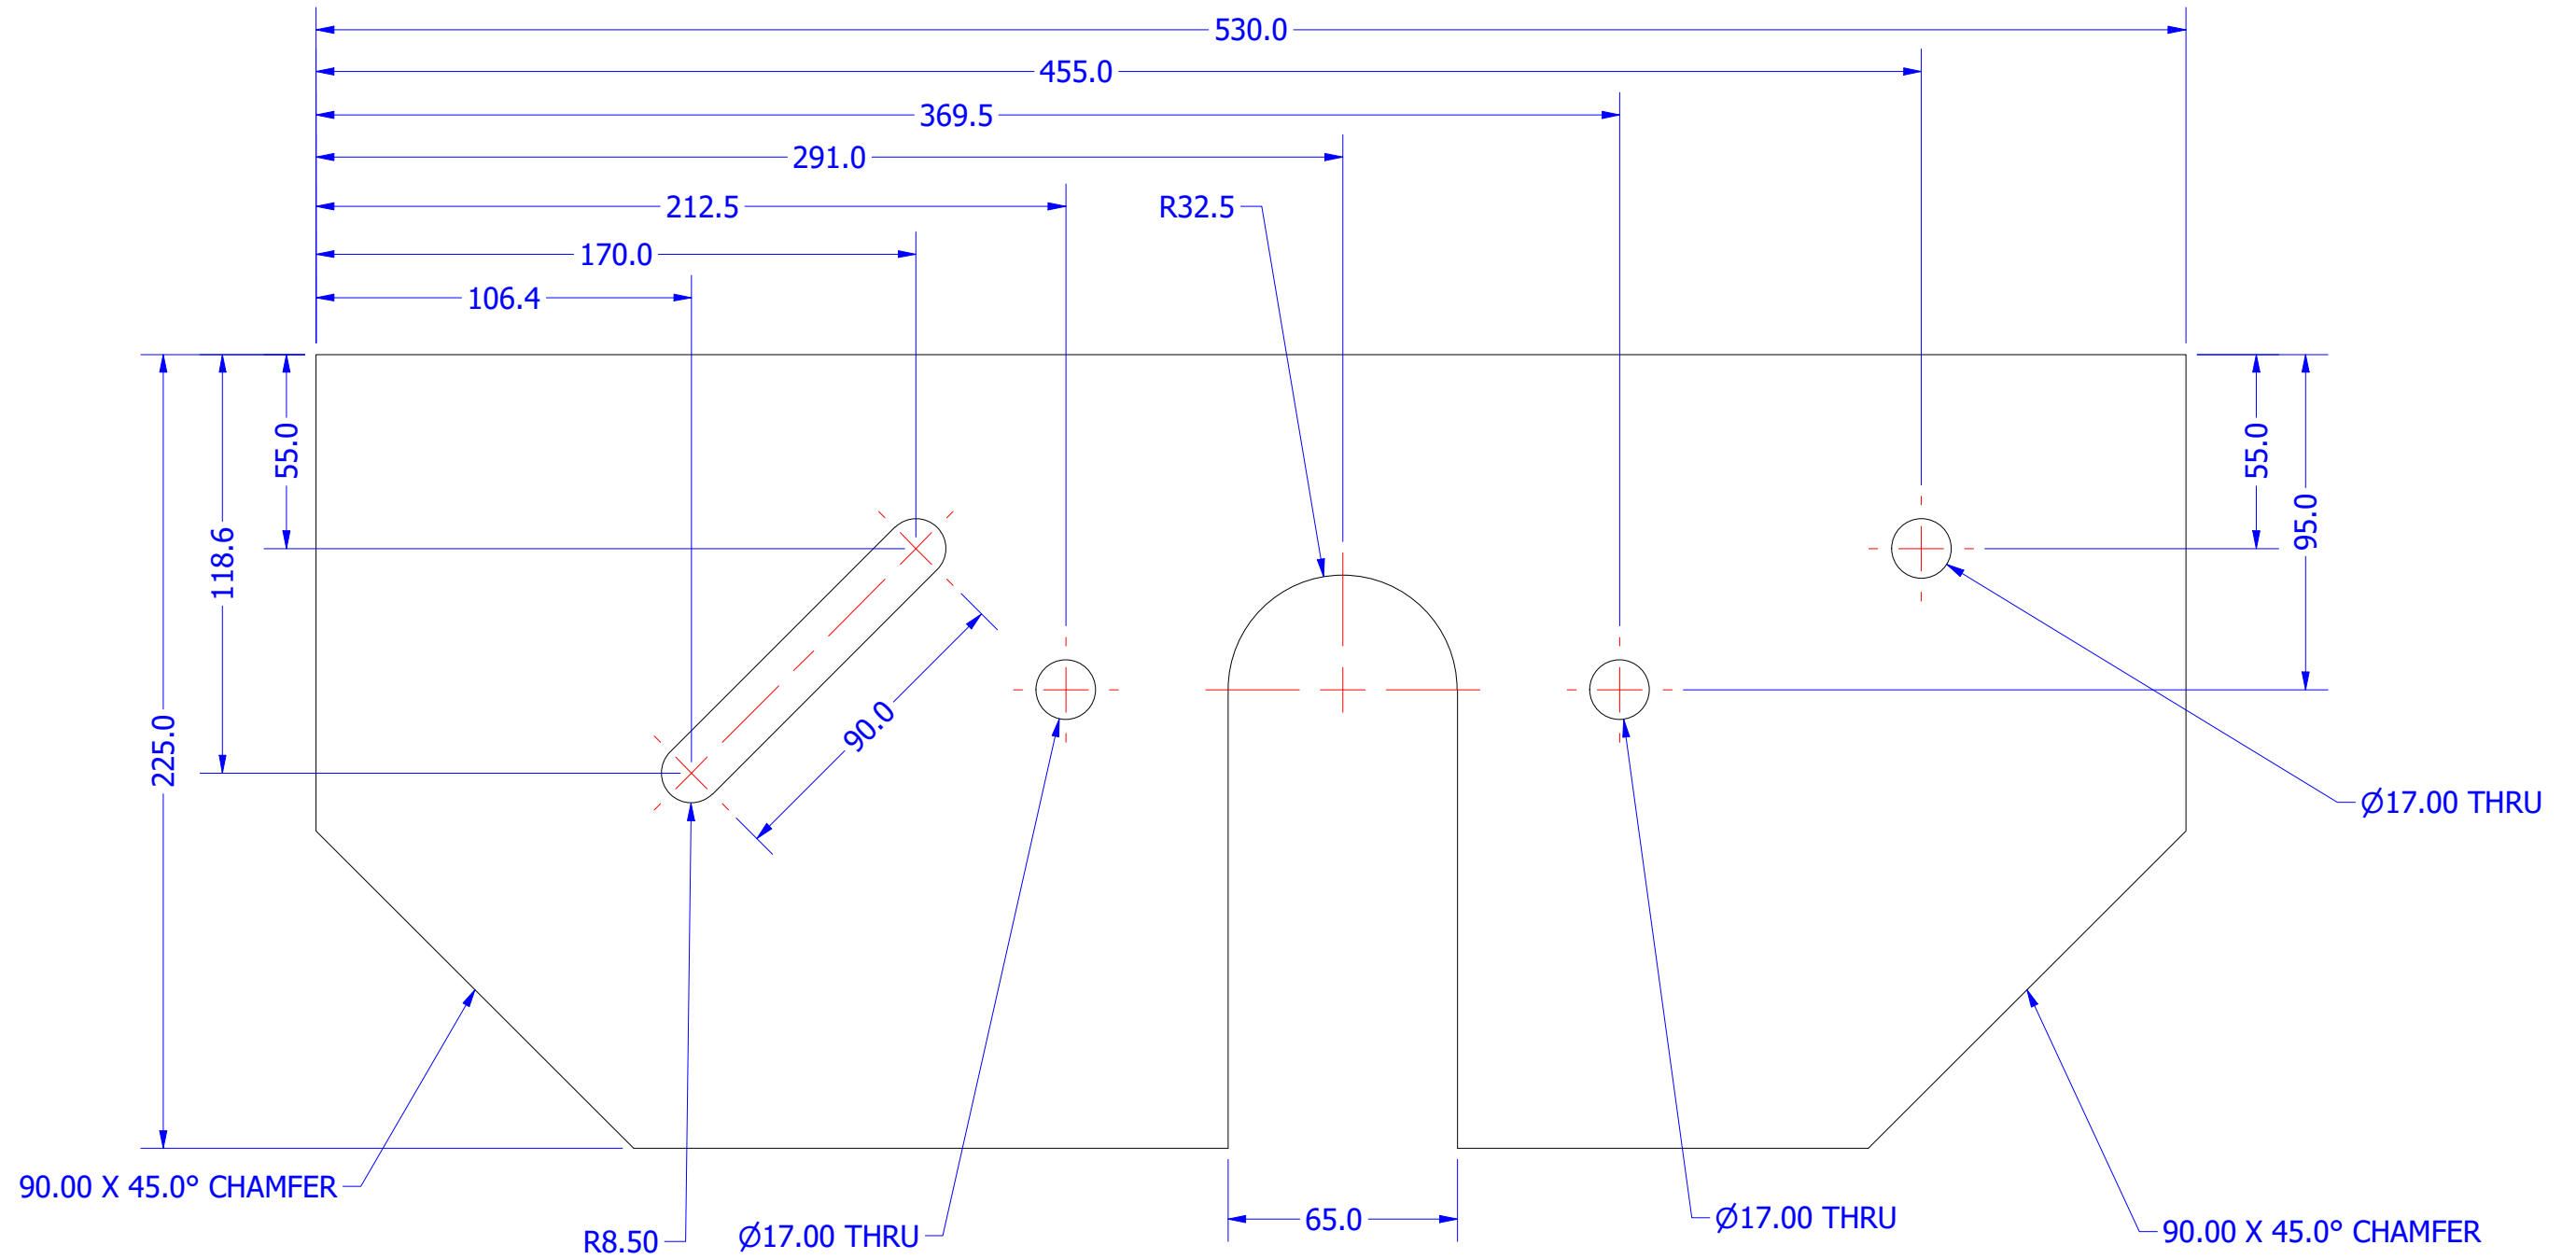


FRONT VIEW  
SCALE 1:2

REMOVE ALL BURRS & SHARP EDGES



THESE DRAWINGS ARE THE PROPERTY OF ULTIMATE ENGINEERING AND SHOULD NOT BE REPRODUCED OR COPIED IN ANY WAY WITHOUT WRITTEN PERMISSION FROM ULTIMATE ENGINEERING

PAINT TREATMENT:

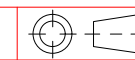

DIMENSION TOLERANCES	
DECIMAL	ANGULAR
X.X = ± .5 mm	X = ± 1°
X.XX = ± .25 mm	X.X = ± .5°
X.XXX = ± .125 mm	X.XX = ± .25°

MAXIMUM FINISHED SURFACE ROUGHNESS U.N.O. 1.6

PARENT ASSEMBLY

CUSTOMER: **RAB ENGINEERING**

DRAWN: David Bilney

TITLE: P1948-000-01  
CHAIN CONVEYORS

DESIGNED: David Bilney

DWG NO: **194801/12**

DATE: 15/03/2021

JOB NO:

SCALE: Scale  
SHEET 12 OF 34  
SHEET SIZE: A3  
REV: 1


DRAWN BY ULTIMATE ENGINEERING PTY LTD Ph 8562 1511



DO NOT SCALE DRAWING

16mm PLATE @ 140 X 111	Steel, Mild	AS3678 - GR250
DESCRIPTION	MATERIAL	COMMENTS

P1948-000-02 - 12 REQ'D AS DRAWN

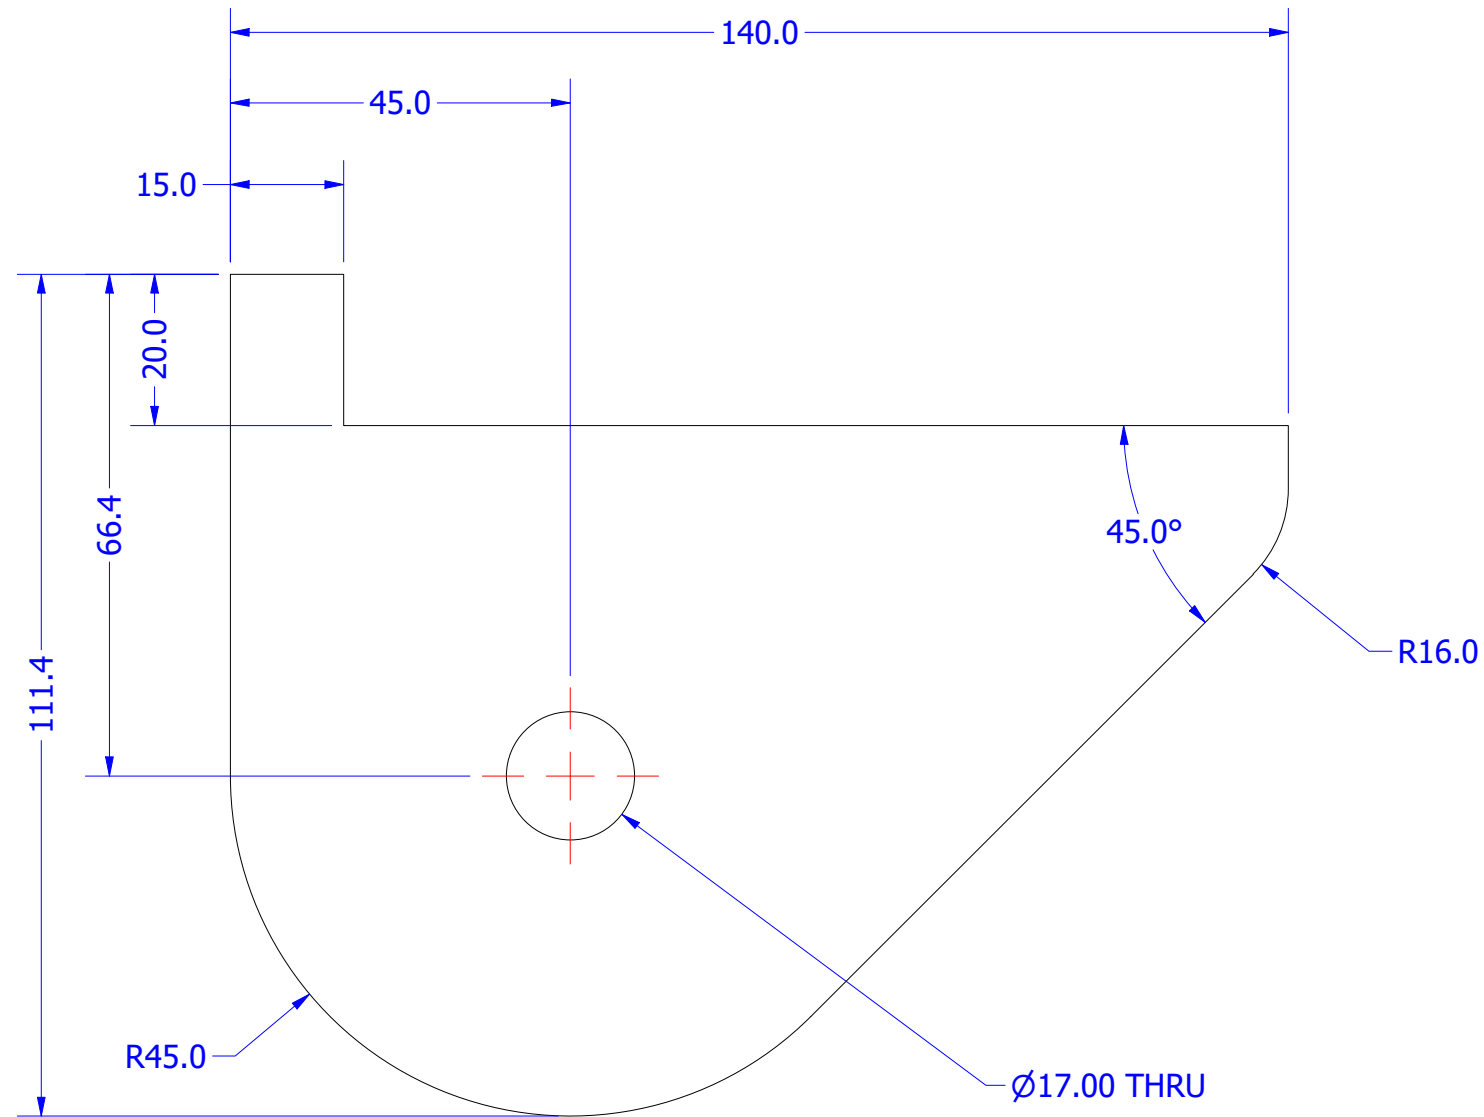


FRONT VIEW  
SCALE 1 : 1

REMOVE ALL BURRS & SHARP EDGES



THESE DRAWINGS ARE THE PROPERTY OF ULTIMATE ENGINEERING AND SHOULD NOT BE REPRODUCED OR COPIED IN ANY WAY WITHOUT WRITTEN PERMISSION FROM ULTIMATE ENGINEERING

PAINT TREATMENT:

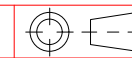

DIMENSION TOLERANCES	
DECIMAL	ANGULAR
X.X = ± .5 mm	X = ± 1°
X.XX = ± .25 mm	X.X = ± .5°
X.XXX = ± .125 mm	X.XX = ± .25°

MAXIMUM FINISHED SURFACE ROUGHNESS U.N.O. 1.6

PARENT ASSEMBLY

DRAWN: David Bilney

DESIGNED: David Bilney

DATE: 15/03/2021

CUSTOMER:

RAB ENGINEERING  
P1948-000-02  
CHAIN CONVEYORS

DWG NO: 194801/13

JOB NO:

SCALE: Scale 13 OF 34

SHEET SIZE: A3


REV: 1

DRAWN BY ULTIMATE ENGINEERING PTY LTD Ph 8562 1511

DO NOT SCALE DRAWING

16mm PLATE @ 480 X 139	Steel, Mild	AS3678 - GR250
DESCRIPTION	MATERIAL	COMMENTS

P1948-000-03 - 3 REQ'D AS DRAWN

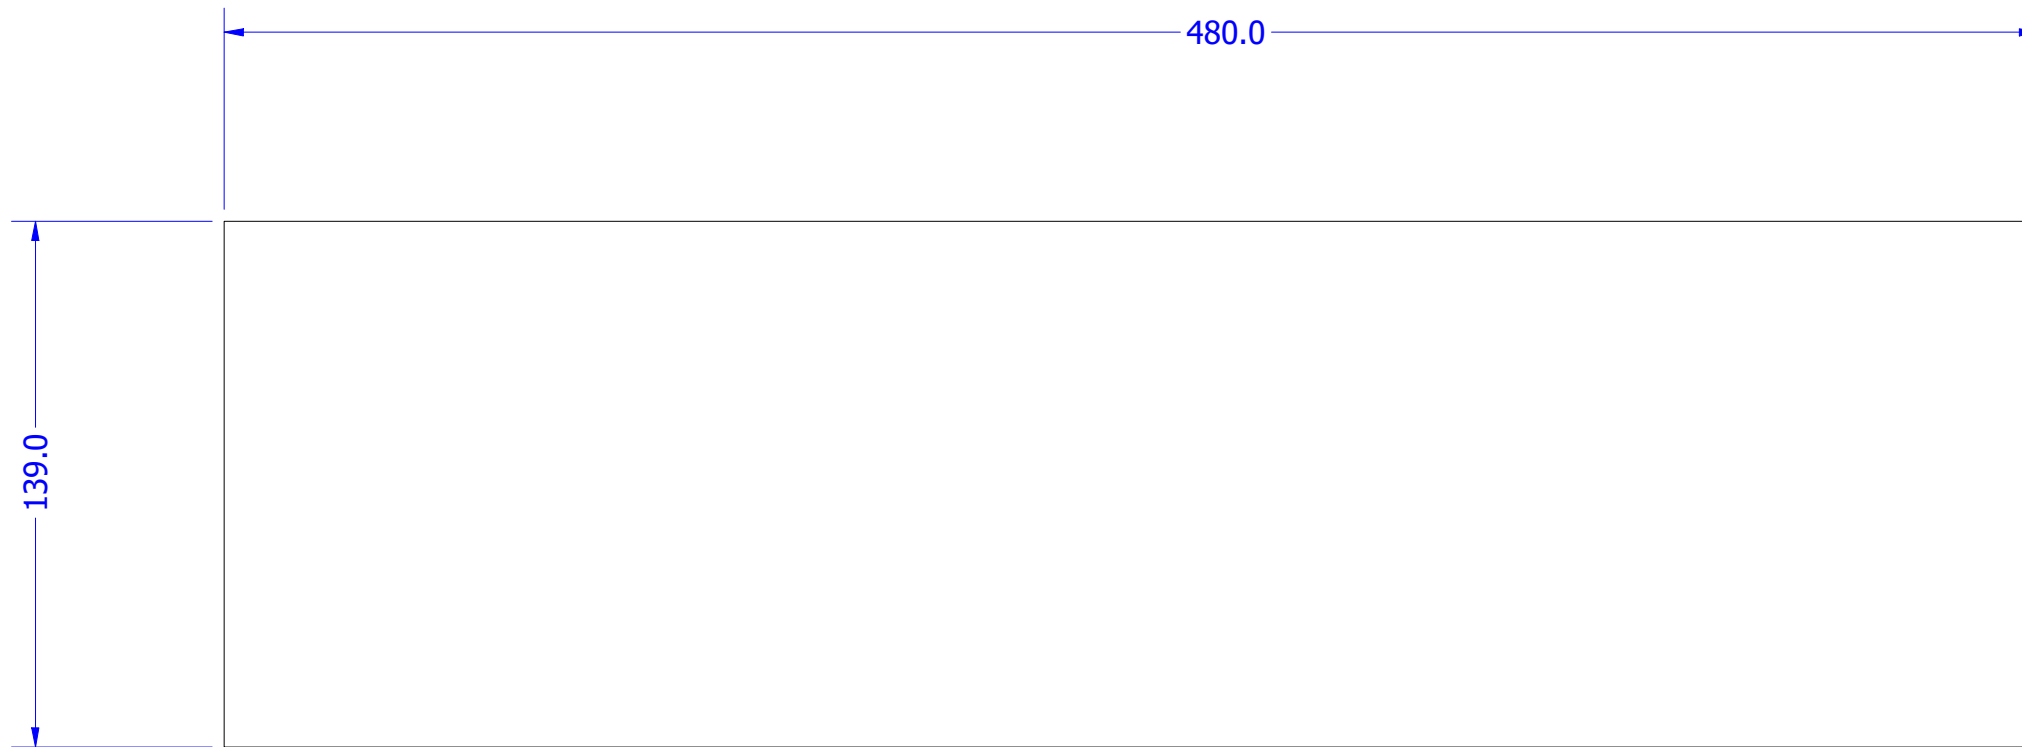


FRONT VIEW  
SCALE 1:2

REMOVE ALL BURRS & SHARP EDGES



THESE DRAWINGS ARE THE PROPERTY OF ULTIMATE ENGINEERING AND SHOULD NOT BE REPRODUCED OR COPIED IN ANY WAY WITHOUT WRITTEN PERMISSION FROM ULTIMATE ENGINEERING

PAINT TREATMENT:

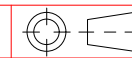

PARENT ASSEMBLY

CUSTOMER: **RAB ENGINEERING**

DIMENSION TOLERANCES	
DECIMAL	ANGULAR
X.X = ± .5 mm	X = ± 1°
X.XX = ± .25 mm	X.X = ± .5°
X.XXX = ± .125 mm	X.XX = ± .25°

MAXIMUM FINISHED SURFACE ROUGHNESS U.N.O. 1.6

DRAWN: David Bilney

TITLE: P1948-000-03  
CHAIN CONVEYORS

DESIGNED: David Bilney

DWG NO: **194801/14**

DATE: 15/03/2021


JOB NO:	SCALE: Scale	SHEET 14 OF 34	SHEET SIZE: A3	REV: 1
---------	--------------	----------------	----------------	--------

DRAWN BY ULTIMATE ENGINEERING PTY LTD Ph 8562 1511


DO NOT SCALE DRAWING

5mm PLATE @ 140 X 115	Steel, Mild	AS3678 - GR250
DESCRIPTION	MATERIAL	COMMENTS

P1948-000-04 - 3 REQ'D AS DRAWN

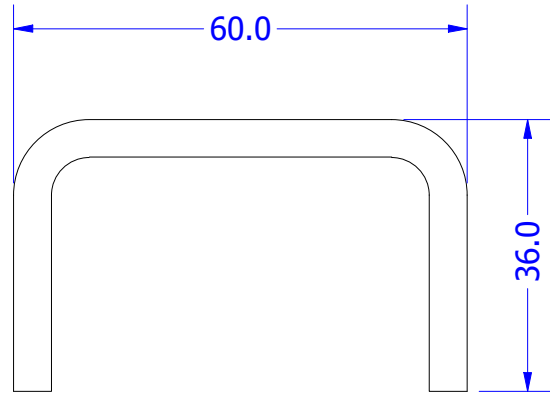

FOLDED VIEW  
SCALE 1 : 1

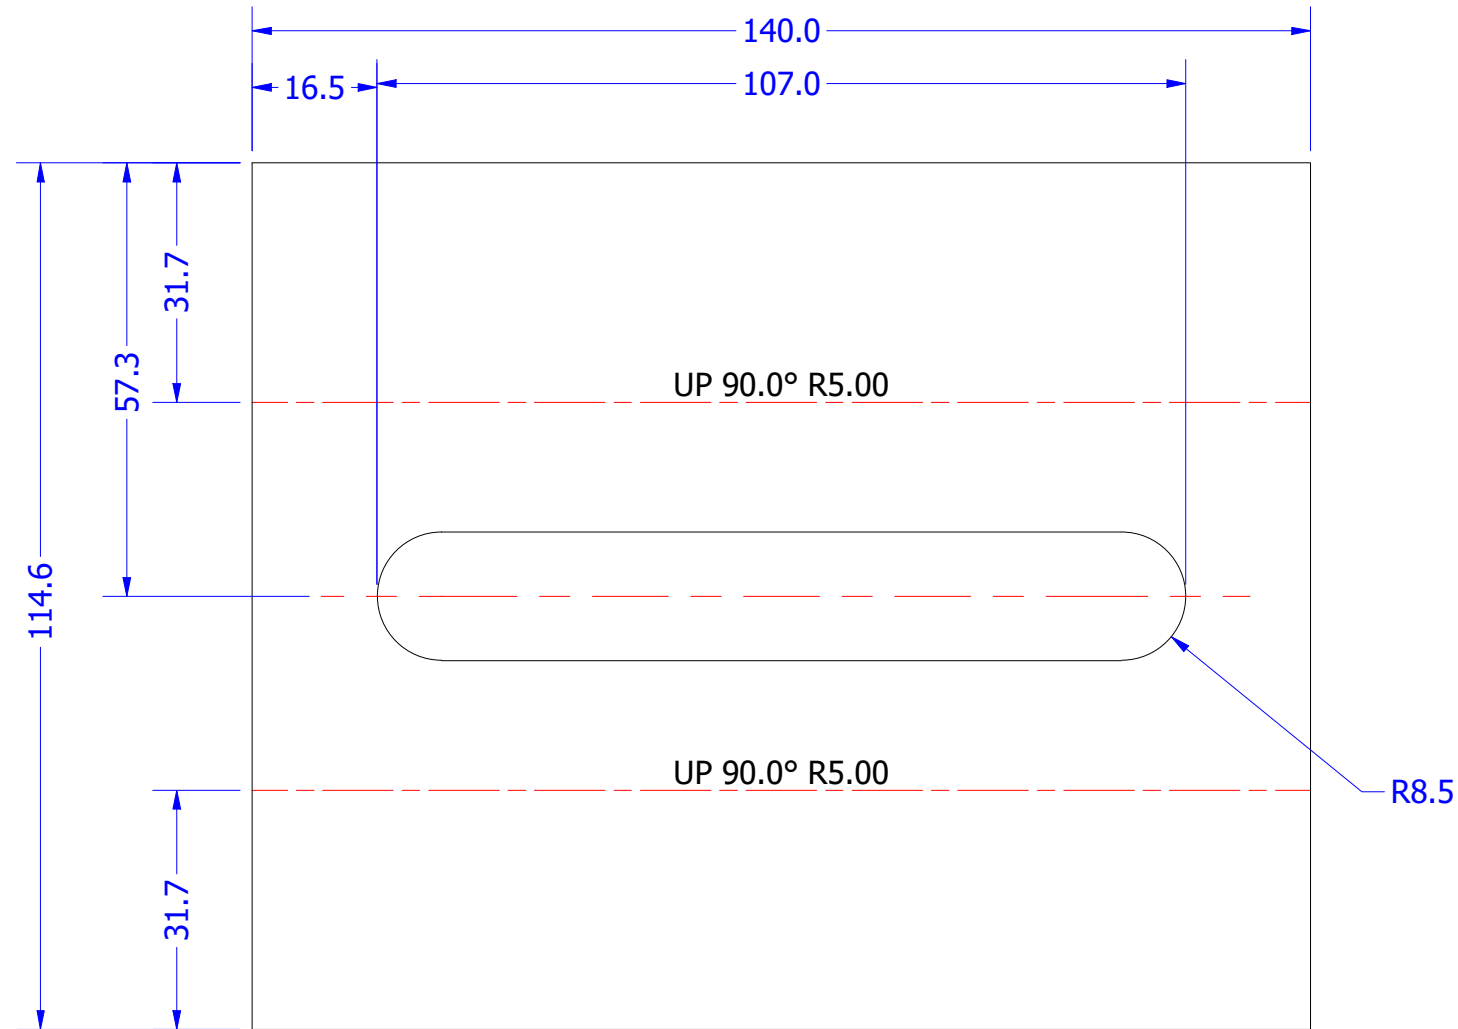


FLAT PATTERN  
SCALE 1 : 1

REMOVE ALL BURRS & SHARP EDGES



THESE DRAWINGS ARE THE PROPERTY OF ULTIMATE ENGINEERING AND SHOULD NOT BE REPRODUCED OR COPIED IN ANY WAY WITHOUT WRITTEN PERMISSION FROM ULTIMATE ENGINEERING

PAINT TREATMENT:

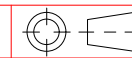

DIMENSION TOLERANCES	
DECIMAL	ANGULAR
X.X = ± .5 mm	X = ± 1°
X.XX = ± .25 mm	X.X = ± .5°
X.XXX = ± .125 mm	X.XX = ± .25°

MAXIMUM FINISHED SURFACE ROUGHNESS U.N.O. 1.6

PARENT ASSEMBLY

CUSTOMER: **RAB ENGINEERING**

DRAWN: David Bilney

TITLE: P1948-000-04  
CHAIN CONVEYORS

DESIGNED: David Bilney

DWG NO: **194801/15**

DATE: 15/03/2021

JOB NO:

SCALE: Scale  
SHEET 15 OF 34


SHEET SIZE: A3

REV: 1

DO NOT SCALE DRAWING

12mm PLATE @ 35 X 35	Steel, Mild	AS3678 - GR250
DESCRIPTION	MATERIAL	COMMENTS

P1948-000-05 - 6 REQ'D AS DRAWN

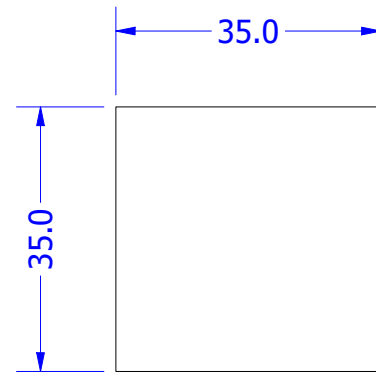

FRONT VIEW  
SCALE 1 : 1


REMOVE ALL BURRS & SHARP EDGES

DRAWN BY ULTIMATE ENGINEERING PTY LTD Ph 8562 1511



THESE DRAWINGS ARE THE PROPERTY OF ULTIMATE ENGINEERING AND SHOULD NOT BE REPRODUCED OR COPIED IN ANY WAY WITHOUT WRITTEN PERMISSION FROM ULTIMATE ENGINEERING

PAINT TREATMENT:

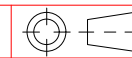

PARENT ASSEMBLY

CUSTOMER: **RAB ENGINEERING**

DIMENSION TOLERANCES	
DECIMAL	ANGULAR
X.X = ± .5 mm	X = ± 1°
X.XX = ± .25 mm	X.X = ± .5°
X.XXX = ± .125 mm	X.XX = ± .25°

MAXIMUM FINISHED SURFACE ROUGHNESS U.N.O. 1.6

DRAWN: David Bilney

TITLE: P1948-000-05  
CHAIN CONVEYORS

DESIGNED: David Bilney

DWG NO: **194801/16**

DATE: 15/03/2021

JOB NO:

SCALE: Scale 16 OF 34

SHEET SIZE: A3


REV: 1



DO NOT SCALE DRAWING

100x10 FMS @ 400mm	Steel, Mild	AS3679 - GR300
DESCRIPTION	MATERIAL	COMMENTS

P1948-000-06 - 9 REQ'D AS DRAWN

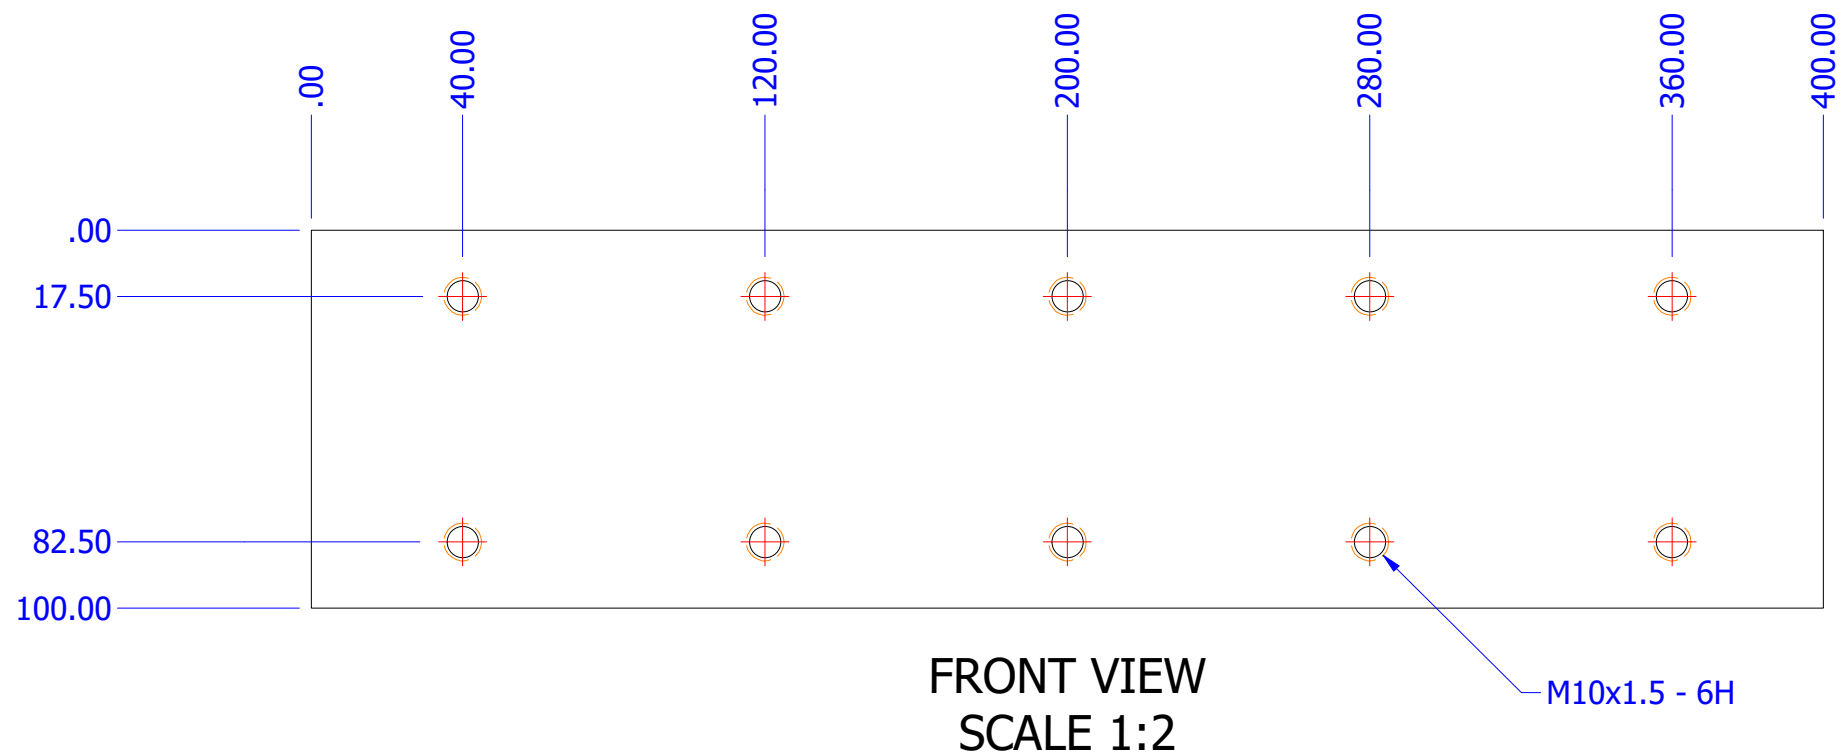


REMOVE ALL BURRS & SHARP EDGES



THESE DRAWINGS ARE THE PROPERTY OF ULTIMATE ENGINEERING AND SHOULD NOT BE REPRODUCED OR COPIED IN ANY WAY WITHOUT WRITTEN PERMISSION FROM ULTIMATE ENGINEERING

PAINT TREATMENT:

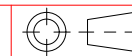

DIMENSION TOLERANCES	
DECIMAL	ANGULAR
X.X = ± .5 mm	X = ± 1°
X.XX = ± .25 mm	X.X = ± .5°
X.XXX = ± .125 mm	X.XX = ± .25°

MAXIMUM FINISHED SURFACE ROUGHNESS U.N.O. 1.6 ✓

PARENT ASSEMBLY

DRAWN: David Bilney

DESIGNED: David Bilney

DATE: 15/03/2021

CUSTOMER:

RAB ENGINEERING

TITLE:

P1948-000-06  
CHAIN CONVEYORS

DWG NO:

194801/17

JOB NO:

SCALE:  
Scale

SHEET  
17 OF 34


SHEET SIZE:  
A3

REV:  
1

DO NOT SCALE DRAWING

6mm PLATE @ 65 X 65	Steel, Mild	AS3678 - GR250
DESCRIPTION	MATERIAL	COMMENTS

P1948-000-08 - 6 REQ'D AS DRAWN

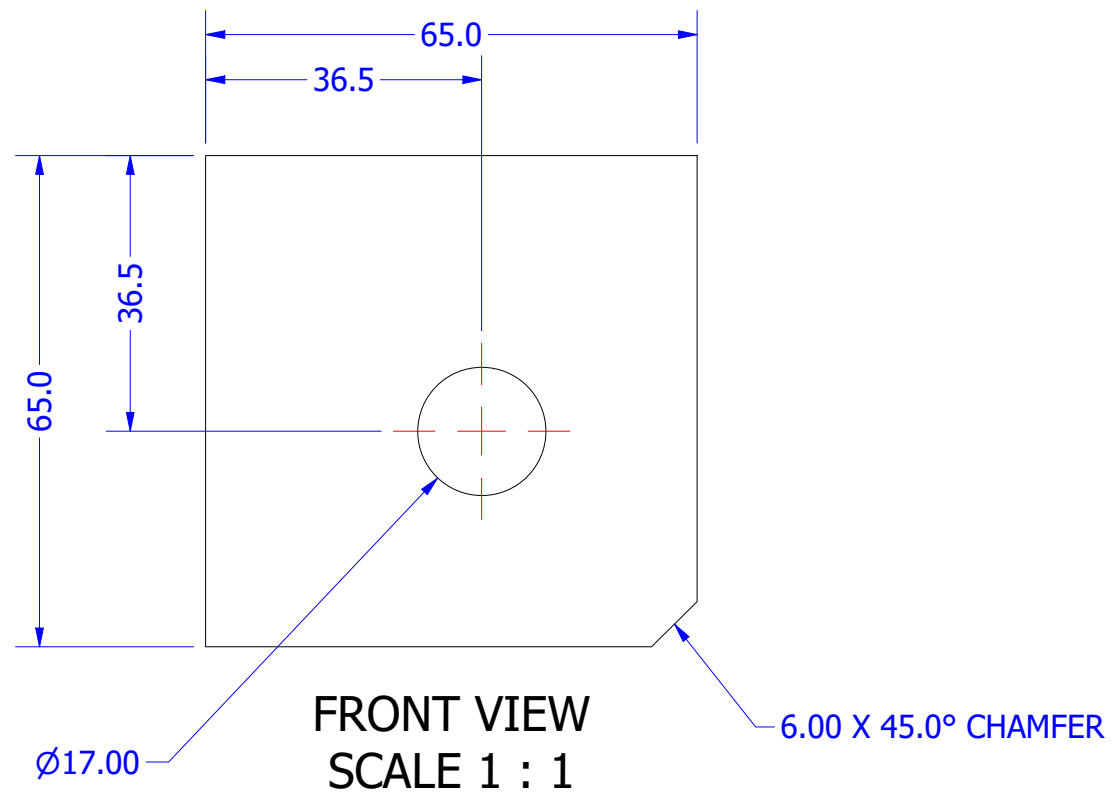


REMOVE ALL BURRS & SHARP EDGES



THESE DRAWINGS ARE THE PROPERTY OF ULTIMATE ENGINEERING AND SHOULD NOT BE REPRODUCED OR COPIED IN ANY WAY WITHOUT WRITTEN PERMISSION FROM ULTIMATE ENGINEERING

PAINT TREATMENT:

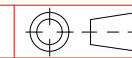

DIMENSION TOLERANCES	
DECIMAL	ANGULAR
X.X = ± .5 mm	X = ± 1°
X.XX = ± .25 mm	X.X = ± .5°
X.XXX = ± .125 mm	X.XX = ± .25°

MAXIMUM FINISHED SURFACE ROUGHNESS U.N.O. 1.6

PARENT ASSEMBLY

DRAWN: David Bilney

DESIGNED: David Bilney

DATE: 15/03/2021

CUSTOMER:

RAB ENGINEERING

TITLE:

P1948-000-08  
CHAIN CONVEYORS

DWG NO:

194801/18

JOB NO:

SCALE:  
Scale

SHEET  
18 OF 34


SHEET SIZE:  
A3

REV:  
1

DO NOT SCALE DRAWING

2mm PLATE @ 81 X 30	Steel, Mild	ASTM A240
DESCRIPTION	MATERIAL	COMMENTS

P1948-000-09 - 6 REQ'D AS DRAWN

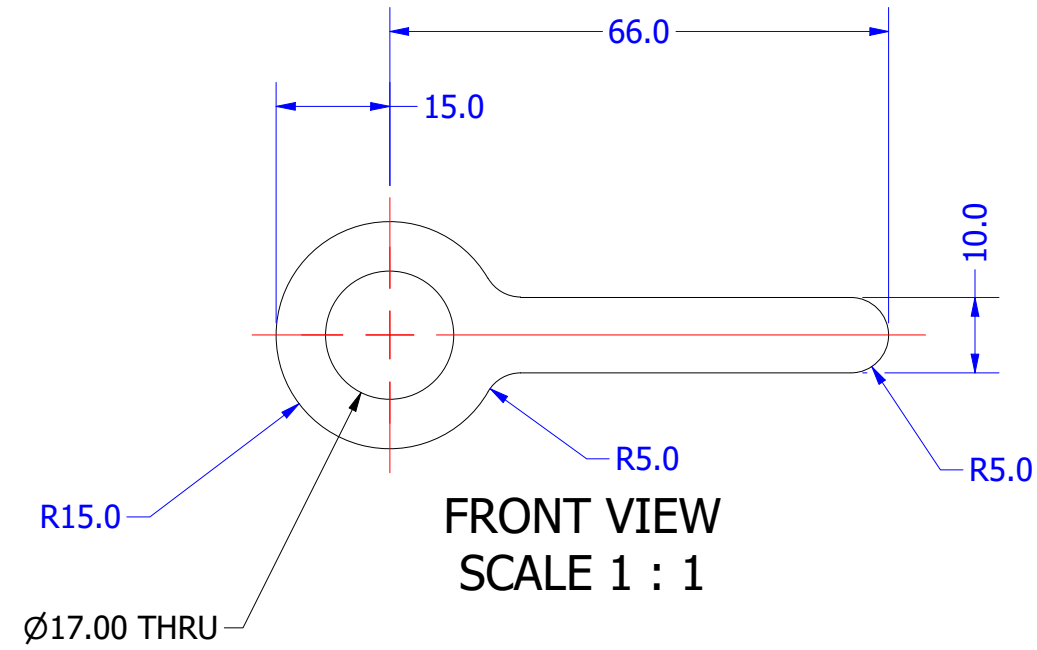


REMOVE ALL BURRS & SHARP EDGES



THESE DRAWINGS ARE THE PROPERTY OF ULTIMATE ENGINEERING AND SHOULD NOT BE REPRODUCED OR COPIED IN ANY WAY WITHOUT WRITTEN PERMISSION FROM ULTIMATE ENGINEERING

PAINT TREATMENT:

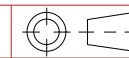

DIMENSION TOLERANCES	
DECIMAL	ANGULAR
X.X = ± .5 mm	X = ± 1°
X.XX = ± .25 mm	X.X = ± .5°
X.XXX = ± .125 mm	X.XX = ± .25°
MAXIMUM FINISHED SURFACE ROUGHNESS U.N.O. 1.6	

PARENT ASSEMBLY

DRAWN: David Bilney

DESIGNED: David Bilney

DATE: 15/03/2021

CUSTOMER: RAB ENGINEERING

TITLE: P1948-000-09  
CHAIN CONVEYORS

DWG NO: 194801/19

JOB NO:

SCALE: Scale 19 OF 34

SHEET SIZE: A3

REV: 1

DRAWN BY ULTIMATE ENGINEERING PTY LTD Ph 8562 1511


DO NOT SCALE DRAWING

40 RND BAR @ 12.5mm	Steel, Mild	AS3679 - GR300
DESCRIPTION	MATERIAL	COMMENTS


P1948-000-10 - 6 REQ'D AS DRAWN



ISO VIEW  
SCALE 1 : 1

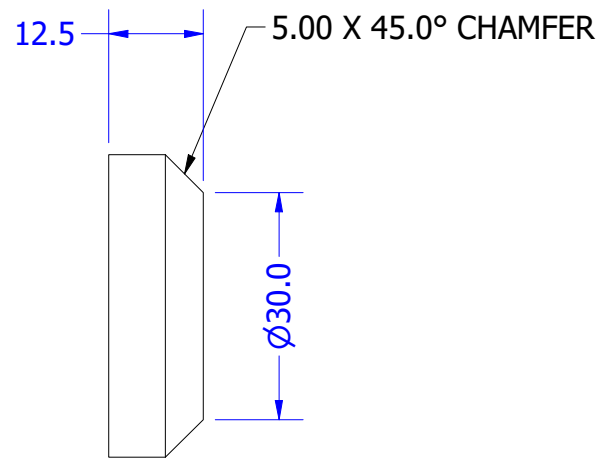

SIDE VIEW  
SCALE 1 : 1

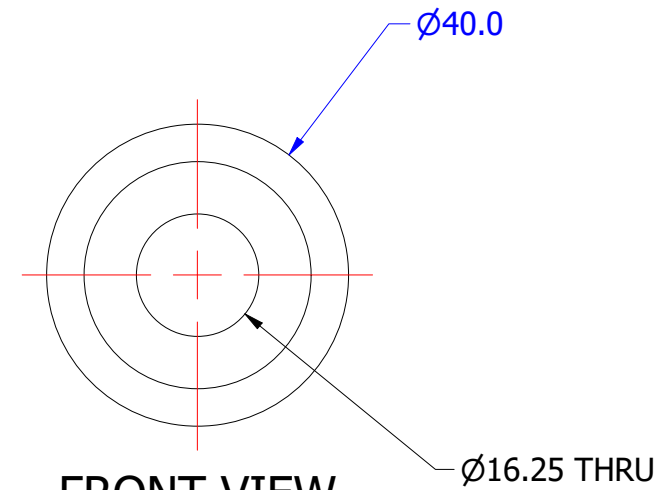


FRONT VIEW  
SCALE 1 : 1

REMOVE ALL BURRS & SHARP EDGES



THESE DRAWINGS ARE THE PROPERTY OF ULTIMATE ENGINEERING AND SHOULD NOT BE REPRODUCED OR COPIED IN ANY WAY WITHOUT WRITTEN PERMISSION FROM ULTIMATE ENGINEERING

PAINT TREATMENT: ZINC PLATE

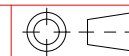

DIMENSION TOLERANCES	
DECIMAL	ANGULAR
X.X = ± .5 mm	X = ± 1'
X.XX = ± .25 mm	X.X = ± .5'
X.XXX = ± .125 mm	X.XX = ± .25'

MAXIMUM FINISHED SURFACE ROUGHNESS U.N.O. 1.6

PARENT ASSEMBLY

DRAWN: David Bilney

DESIGNED: David Bilney

DATE: 15/03/2021

CUSTOMER: RAB ENGINEERING

TITLE: P1948-000-10  
CHAIN CONVEYORS

DWG NO: 194801/20

JOB NO:

SCALE: Scale 20 OF 34

SHEET SIZE: A3




REV: 1



DO NOT SCALE DRAWING

2	32x15 HOLLOW BAR @ 30	Steel, Mild		1
1	M12 ALL THREAD @ 185	Steel, Mild		1
ITEM	PART NUMBER	MATERIAL	COMMENTS	ITEM QTY

P1948-000-11 - 3 REQ'D AS DRAWN

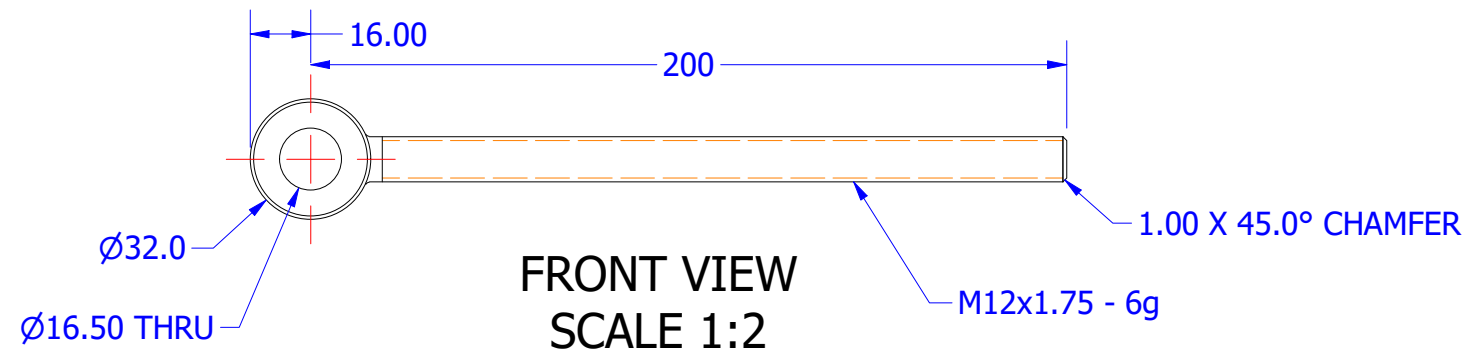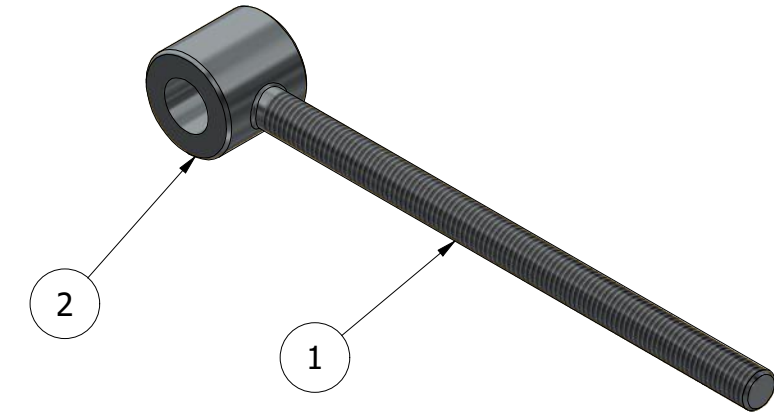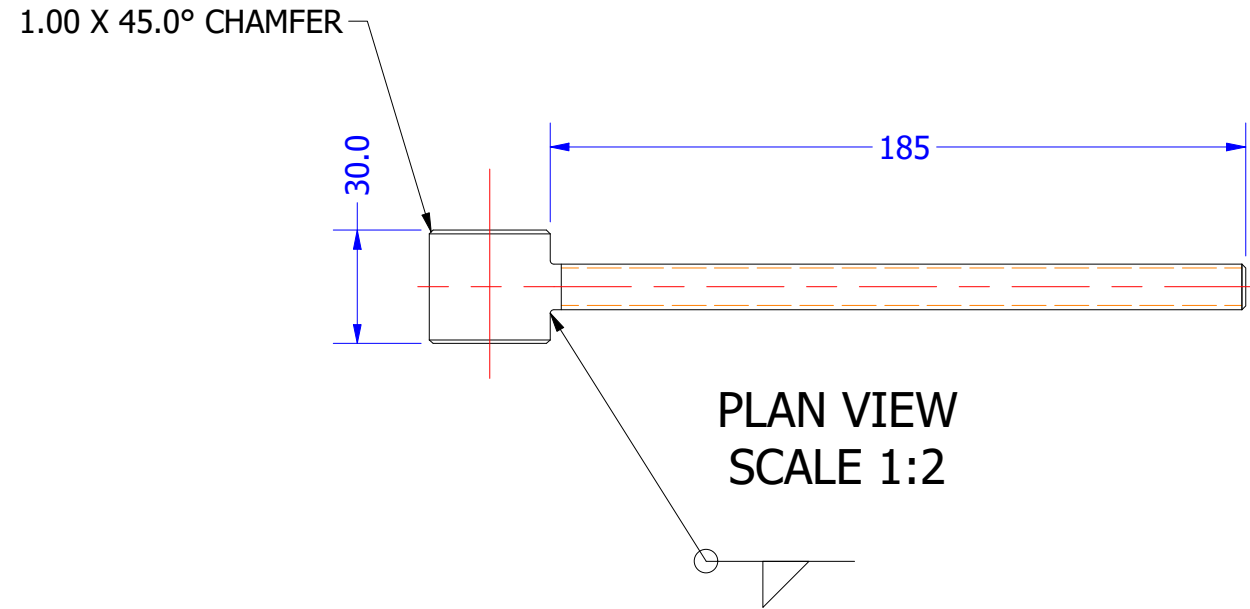


- NOTES:
- ALL WELDING TO CONFORM TO AS1554-GP UNO
  - ALL FILLET WELDS TO BE 6mm CONTINUOUS UNO
  - ALL BUTT WELDS SHALL BE FULL STRENGTH, COMPLETE PENETRATION WELDS
  - ALL FLAME CUT SURFACES SHALL BE UNIFORM & CLEAN BEFORE WELDING
  - REMOVE ALL BURRS & SHARP EDGES
  - NON DESTRUCTIVE TESTING:
    - ALL WELDS, 100% VISUAL SCAN TO AS1554 PART 1
  - FINISH:
    - ALL STEELWORK TO BE PRIMED OR COLD GALV UNO

DRAWN BY ULTIMATE ENGINEERING PTY LTD Ph 8562 1511



THESE DRAWINGS ARE THE PROPERTY OF ULTIMATE ENGINEERING AND SHOULD NOT BE REPRODUCED OR COPIED IN ANY WAY WITHOUT WRITTEN PERMISSION FROM ULTIMATE ENGINEERING

PAINT TREATMENT: ZINC PLATE

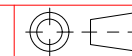

DIMENSION TOLERANCES	
DECIMAL	ANGULAR
X.X = ± .5 mm	X = ± 1'
X.XX = ± .25 mm	X.X = ± .5'
X.XXX = ± .125 mm	X.XX = ± .25'


MAXIMUM FINISHED SURFACE ROUGHNESS U.N.O. 1.6

PARENT ASSEMBLY	CUSTOMER: <b>RAB ENGINEERING</b>
DRAWN: David Bilney	TITLE: P1948-000-11 CHAIN CONVEYORS
DESIGNED: David Bilney	DWG NO: <b>194801/21</b>
DATE: 15/03/2021	JOB NO:
SCALE: Scale	SHEET 21 OF 34
SHEET SIZE: A3	REV: 1

DO NOT SCALE DRAWING

10mm PLATE @ 370 X 170	Mild Steel	AS3678 - GR250
DESCRIPTION	MATERIAL	COMMENTS

P1948-000-12 - 1 REQ'D AS DRAWN

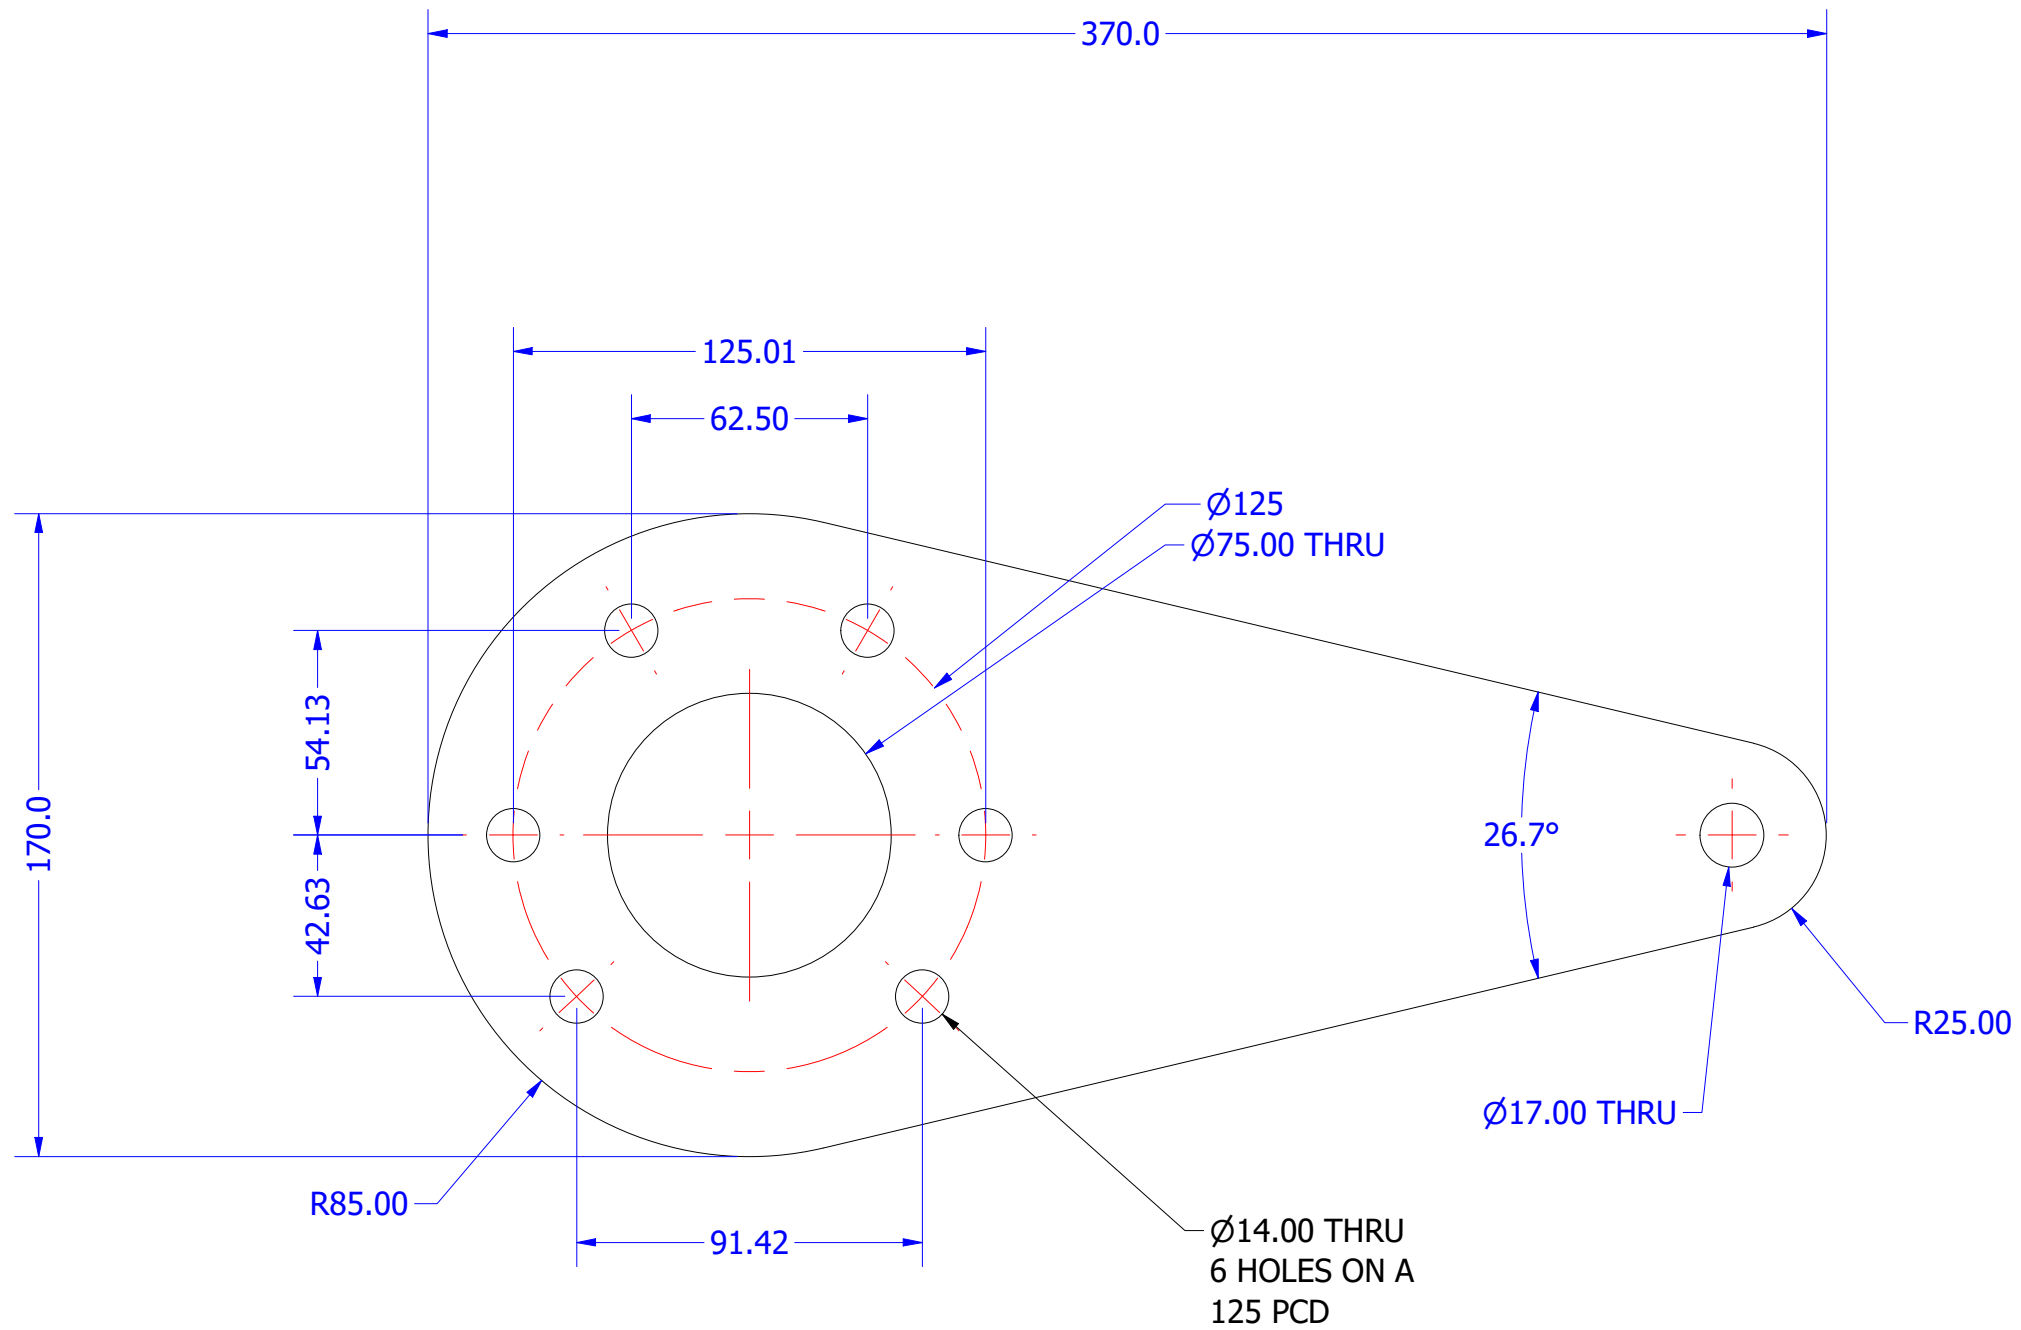


FRONT VIEW  
SCALE 1:2

REMOVE ALL BURRS & SHARP EDGES



THESE DRAWINGS ARE THE PROPERTY OF ULTIMATE ENGINEERING AND SHOULD NOT BE REPRODUCED OR COPIED IN ANY WAY WITHOUT WRITTEN PERMISSION FROM ULTIMATE ENGINEERING

PAINT TREATMENT:

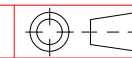

DIMENSION TOLERANCES	
DECIMAL	ANGULAR
X.X = ± .5 mm	X = ± 1'
X.XX = ± .25 mm	X.X = ± .5'
X.XXX = ± .125 mm	X.XX = ± .25'

MAXIMUM FINISHED SURFACE ROUGHNESS U.N.O. 1.6

PARENT ASSEMBLY

DRAWN: David Bilney

DESIGNED: David Bilney

DATE: 15/03/2021

CUSTOMER:

RAB ENGINEERING

TITLE:

P1948-000-12  
CHAIN CONVEYORS

DWG NO:

194801/22

JOB NO:

SCALE:  
Scale

SHEET  
22 OF 34


SHEET SIZE:  
A3

REV:  
1

DO NOT SCALE DRAWING

16mm PLATE @ 200 X 50	Steel, Mild	AS3678 - GR250
DESCRIPTION	MATERIAL	COMMENTS

P1948-000-13 - 1 REQ'D AS DRAWN

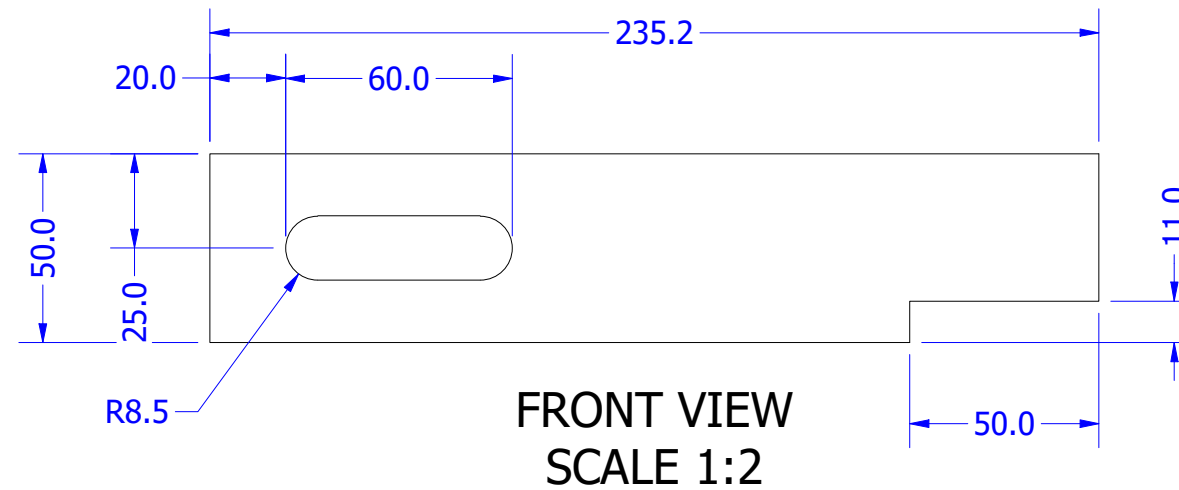

REMOVE ALL BURRS & SHARP EDGES



THESE DRAWINGS ARE THE PROPERTY OF ULTIMATE ENGINEERING AND SHOULD NOT BE REPRODUCED OR COPIED IN ANY WAY WITHOUT WRITTEN PERMISSION FROM ULTIMATE ENGINEERING

PAINT TREATMENT:



DIMENSION TOLERANCES	
DECIMAL	ANGULAR
X.X = ± .5 mm	X = ± 1°
X.XX = ± .25 mm	X.X = ± .5°
X.XXX = ± .125 mm	X.XX = ± .25°

MAXIMUM FINISHED SURFACE ROUGHNESS U.N.O. 1.6

PARENT ASSEMBLY

CUSTOMER: **RAB ENGINEERING**

DRAWN: David Bilney

TITLE: P1948-000-13  
CHAIN CONVEYORS

DESIGNED: David Bilney

DWG NO: **194801/23**

DATE: 15/03/2021

JOB NO:

SCALE: Scale  
SHEET 23 OF 34

SHEET SIZE: A3

REV: 1




DO NOT SCALE DRAWING

40 RND BAR @ 1525	Steel, Mild	AS1444-1996 4140
DESCRIPTION	MATERIAL	COMMENTS

P1948-000-14 - 1 REQ'D AS DRAWN



ISO VIEW  
SCALE 1:10

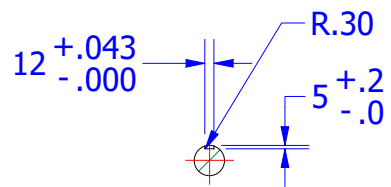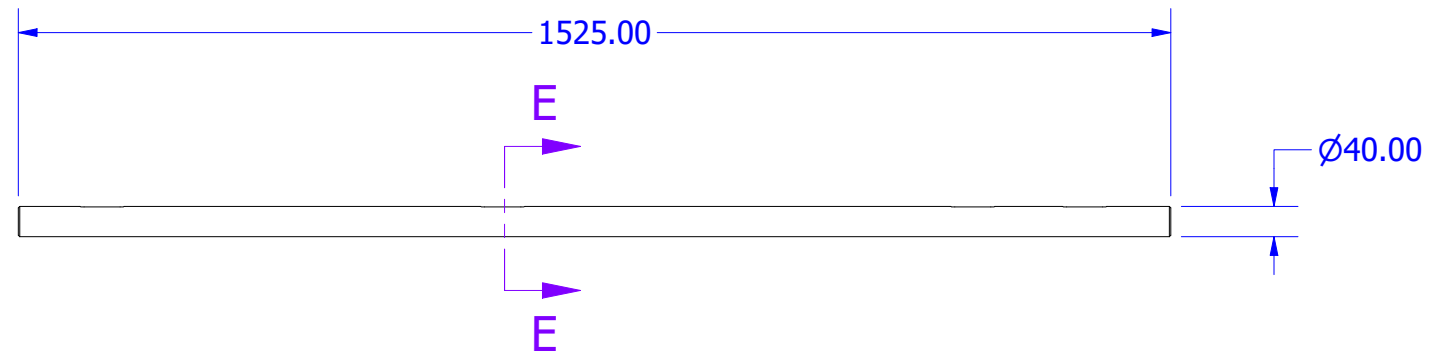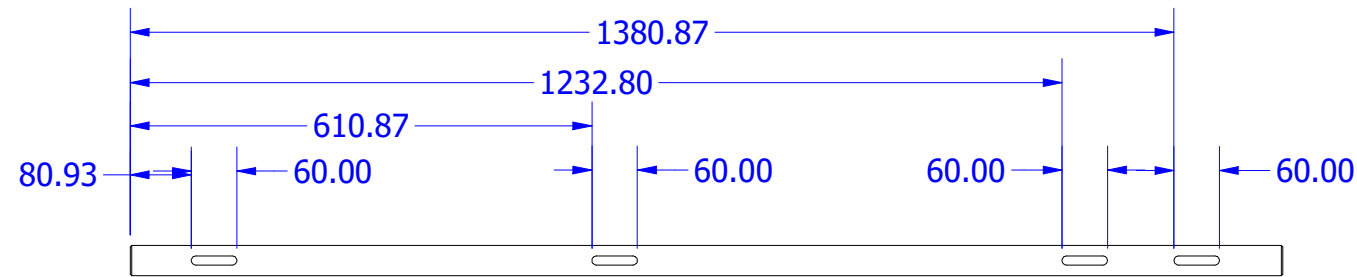


SECTION E-E  
SCALE 1:10

REMOVE ALL BURRS & SHARP EDGES



THESE DRAWINGS ARE THE PROPERTY OF ULTIMATE ENGINEERING AND SHOULD NOT BE REPRODUCED OR COPIED IN ANY WAY WITHOUT WRITTEN PERMISSION FROM ULTIMATE ENGINEERING

PAINT TREATMENT:

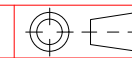

DIMENSION TOLERANCES	
DECIMAL	ANGULAR
X.X = ± .5 mm	X = ± 1°
X.XX = ± .25 mm	X.X = ± .5°
X.XXX = ± .125 mm	X.XX = ± .25°
MAXIMUM FINISHED SURFACE ROUGHNESS U.N.O. 1.6 ✓	

PARENT ASSEMBLY

DRAWN: David Bilney

DESIGNED: David Bilney

DATE: 15/03/2021

CUSTOMER: RAB ENGINEERING

TITLE: P1948-000-14  
CHAIN CONVEYORS

DWG NO: 194801/24

JOB NO:

SCALE: Scale  
SHEET 24 OF 34

SHEET SIZE: A3

REV: 1




DO NOT SCALE DRAWING

30x13.5 FLAT @ 995	Polyethylene, High Density	POSSIBLY STORE ITEM (ORORA)
DESCRIPTION	MATERIAL	COMMENTS

P1948-000-15 - 12 REQ'D AS DRAWN



ISO VIEW  
SCALE 1:5

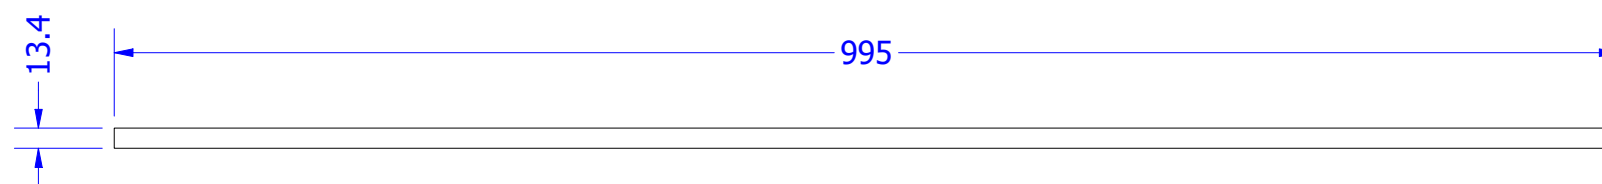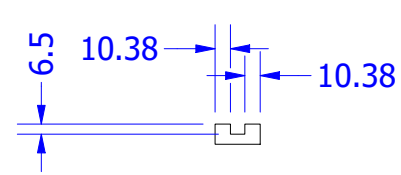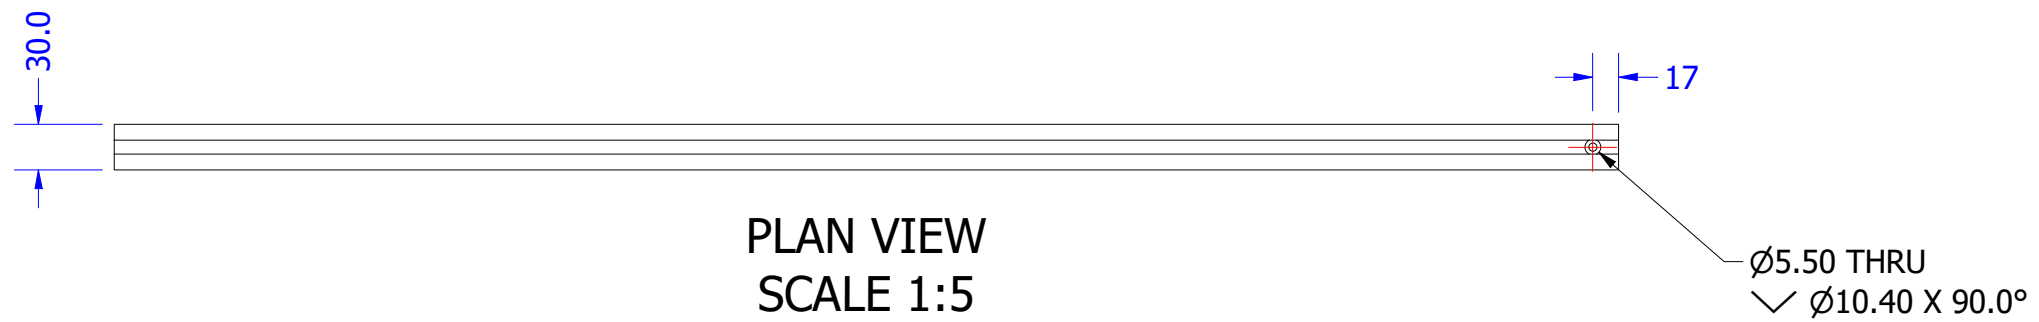


DRAWN BY ULTIMATE ENGINEERING PTY LTD Ph 8562 1511



THESE DRAWINGS ARE THE PROPERTY OF ULTIMATE ENGINEERING AND SHOULD NOT BE REPRODUCED OR COPIED IN ANY WAY WITHOUT WRITTEN PERMISSION FROM ULTIMATE ENGINEERING

PAINT TREATMENT:

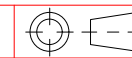

DIMENSION TOLERANCES	
DECIMAL	ANGULAR
X.X = ± .5 mm	X = ± 1°
X.XX = ± .25 mm	X.X = ± .5°
X.XXX = ± .125 mm	X.XX = ± .25°

MAXIMUM FINISHED SURFACE ROUGHNESS U.N.O. 1.6

PARENT ASSEMBLY

CUSTOMER: **RAB ENGINEERING**

DRAWN: David Bilney

TITLE: P1948-000-15  
CHAIN CONVEYORS

DESIGNED: David Bilney

DWG NO: **194801/25**

DATE: 15/03/2021

JOB NO:

SCALE: Scale  
SHEET 25 OF 34


SHEET SIZE: A3

REV: 1


DO NOT SCALE DRAWING

2mm PLATE @ 790 X 355	Steel, Mild	AS1594 - GR250
DESCRIPTION	MATERIAL	COMMENTS


P1948-000-16 - 1 REQ'D AS DRAWN  
 P1948-000-17 - 2 REQ'D OPPOSITE  
 (3 BLANKS REQ'D)

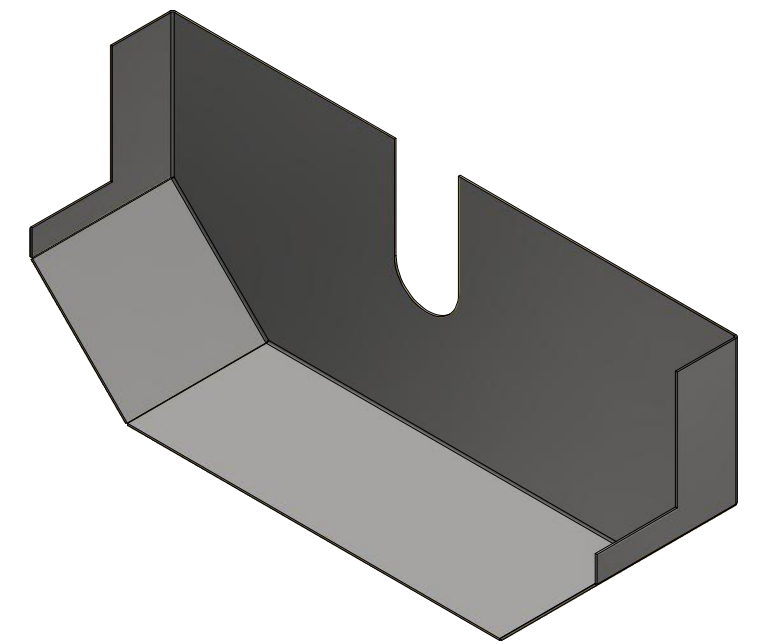


ISO VIEW - FOLDED  
 SCALE 1:5

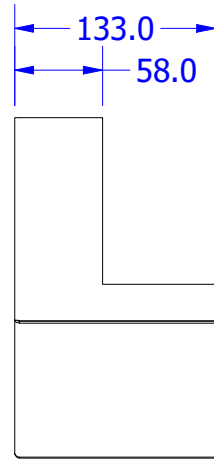

SIDE VIEW - FOLDED  
 SCALE 1:5

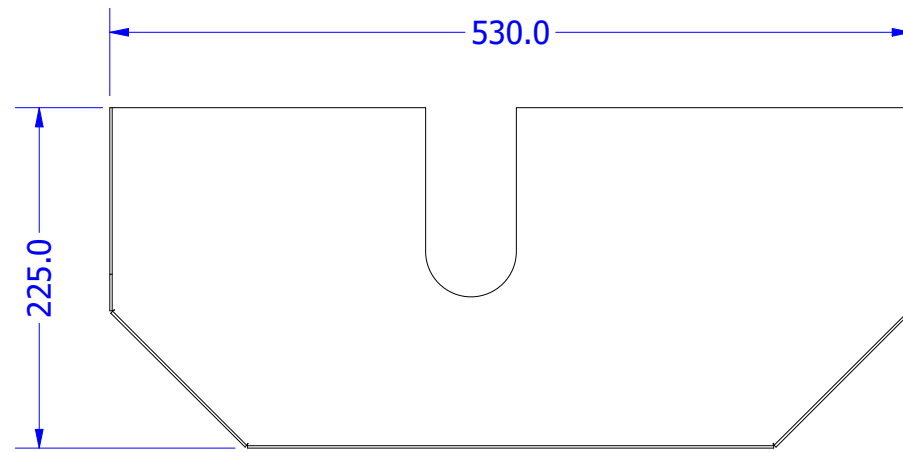

FRONT VIEW - FOLDED  
 SCALE 1:5

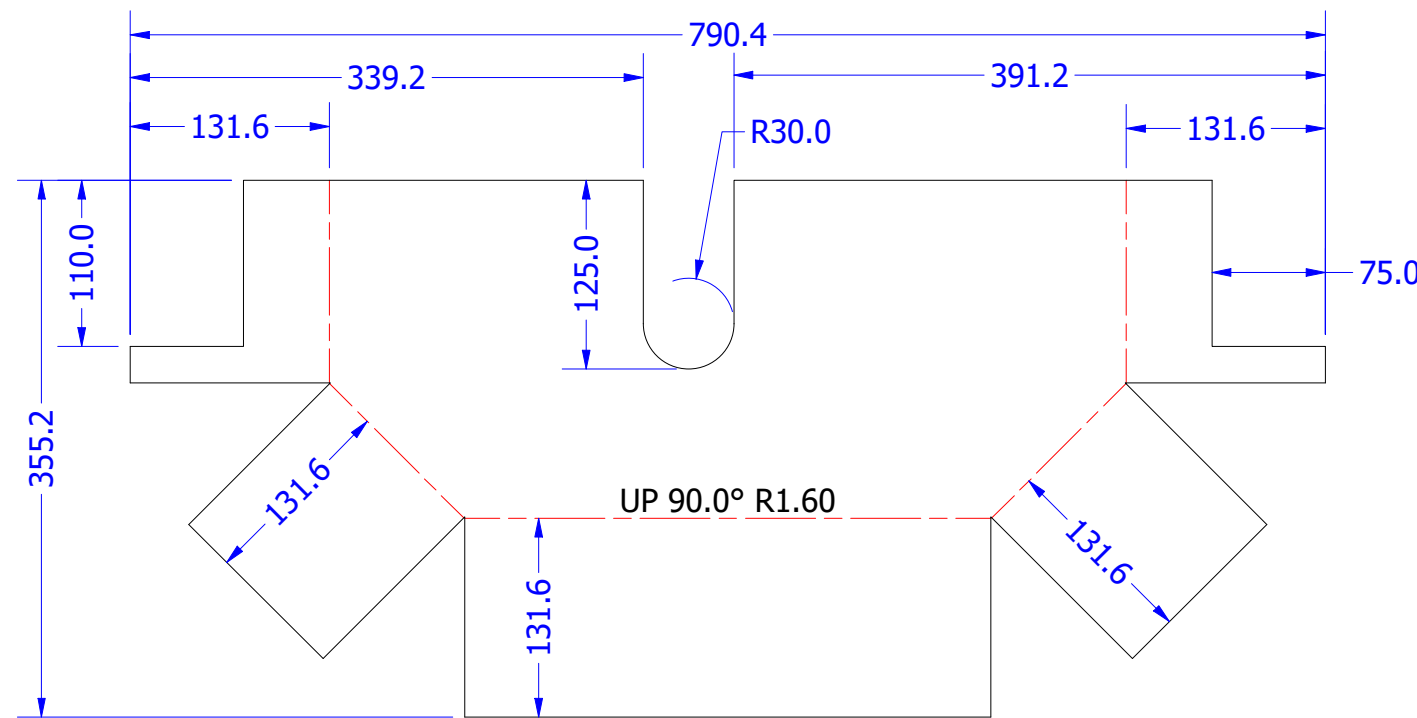


P1948-000-16 - ALL FOLDS UP 90°  
 P1948-000-17 - ALL FOLDS DOWN 90°  
 SCALE 1:5

REMOVE ALL BURRS & SHARP EDGES



THESE DRAWINGS ARE THE PROPERTY OF ULTIMATE ENGINEERING AND SHOULD NOT BE REPRODUCED OR COPIED IN ANY WAY WITHOUT WRITTEN PERMISSION FROM ULTIMATE ENGINEERING

PAINT TREATMENT:

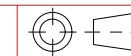

DIMENSION TOLERANCES	
DECIMAL	ANGULAR
X.X = ± .5 mm	X = ± 1°
X.XX = ± .25 mm	X.X = ± .5°
X.XXX = ± .125 mm	X.XX = ± .25°

MAXIMUM FINISHED SURFACE ROUGHNESS U.N.O. 1.6





PARENT ASSEMBLY	CUSTOMER: RAB ENGINEERING
DRAWN: David Bilney	TITLE: P1948-000-16 CHAIN CONVEYORS
DESIGNED: David Bilney	DWG NO: 194801/26
DATE: 15/03/2021	JOB NO:
SCALE: Scale	SHEET: 26 OF 34
SHEET SIZE: A3	REV: 1



DO NOT SCALE DRAWING

5mm PLATE @ 1653 X 710	Aluminum 5052	AS1734
DESCRIPTION	MATERIAL	COMMENTS

P1948-000-18 - 1 REQ'D AS DRAWN

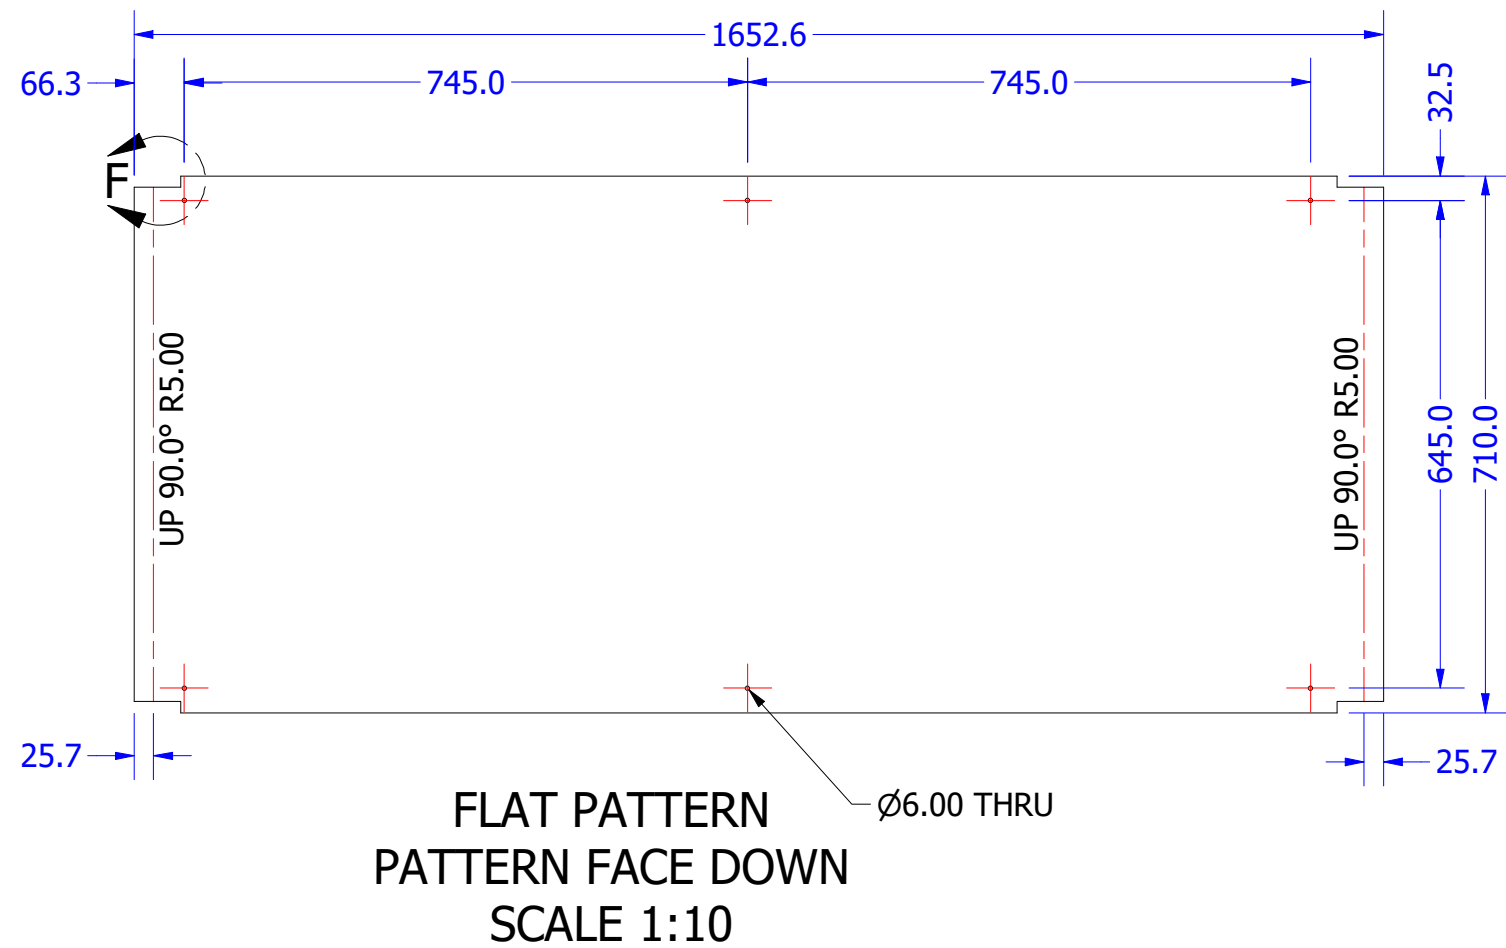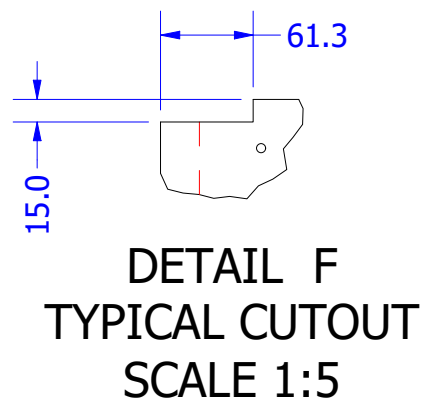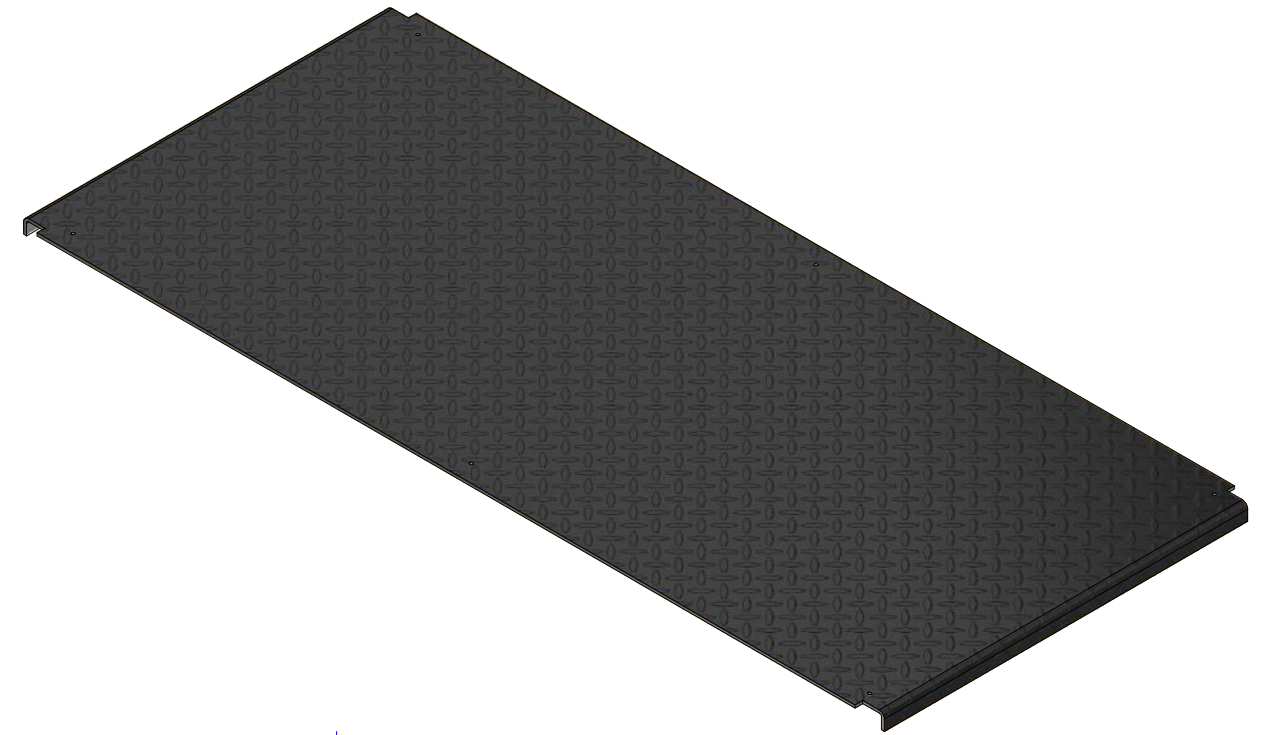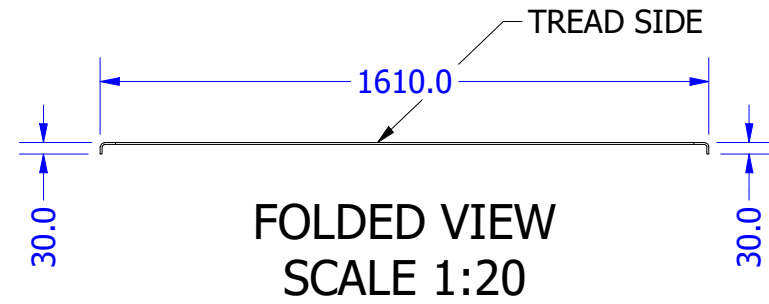


ISO VIEW  
SCALE 1:10

REMOVE ALL BURRS & SHARP EDGES



THESE DRAWINGS ARE THE PROPERTY OF ULTIMATE ENGINEERING AND SHOULD NOT BE REPRODUCED OR COPIED IN ANY WAY WITHOUT WRITTEN PERMISSION FROM ULTIMATE ENGINEERING

PAINT TREATMENT: YELLOW

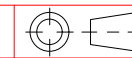

PARENT ASSEMBLY

CUSTOMER: **RAB ENGINEERING**

DIMENSION TOLERANCES	
DECIMAL	ANGULAR
X.X = ± .5 mm	X = ± 1°
X.XX = ± .25 mm	X.X = ± .5°
X.XXX = ± .125 mm	X.XX = ± .25°

MAXIMUM FINISHED SURFACE ROUGHNESS U.N.O. 1.6

DRAWN: David Bilney

TITLE: P1948-000-18  
CHAIN CONVEYORS

DESIGNED: David Bilney

DWG NO: **194801/27**





DATE: 15/03/2021

JOB NO:

SCALE: Scale	SHEET 27 OF 34	SHEET SIZE: A3	REV: 1
--------------	----------------	----------------	--------

DO NOT SCALE DRAWING

5mm PLATE @ 1653 X 490	Aluminum 5052	AS1734
DESCRIPTION	MATERIAL	COMMENTS
P1948-000-19 - 1 REQ'D AS DRAWN		

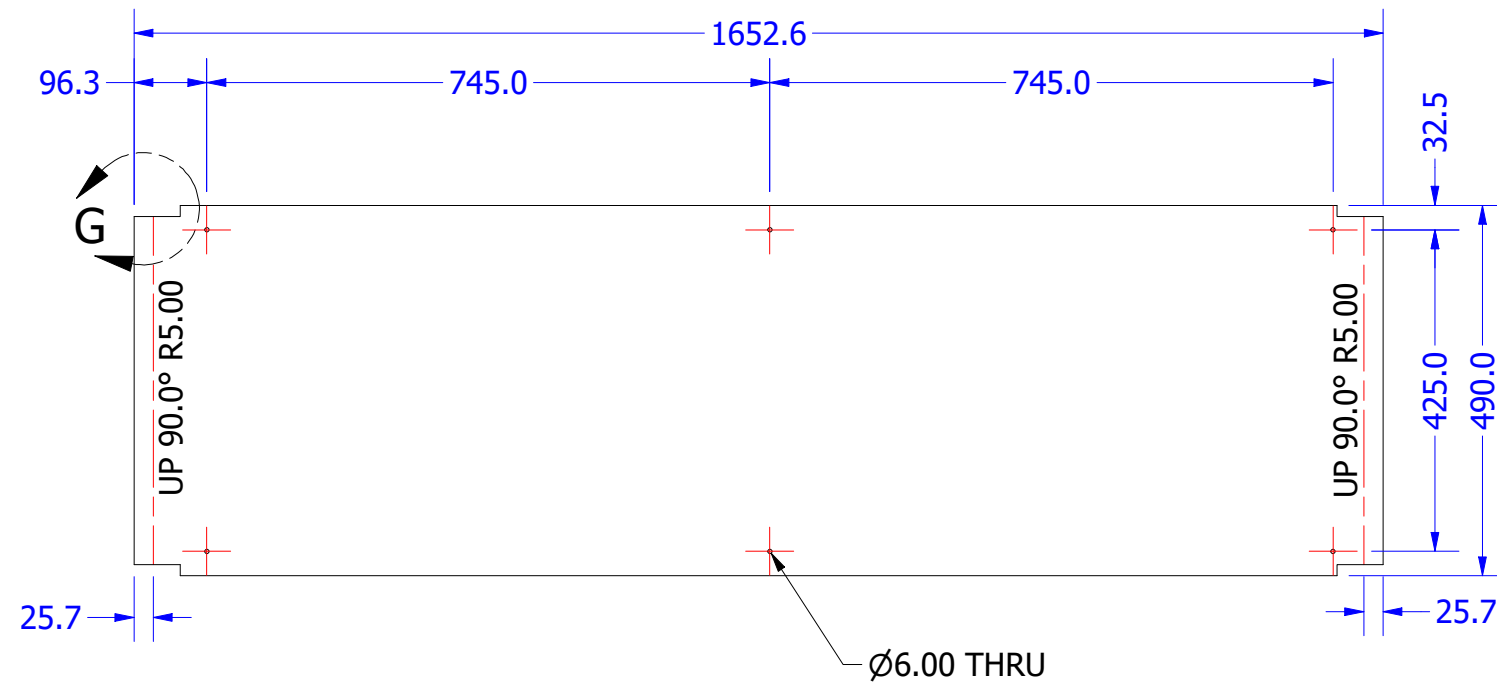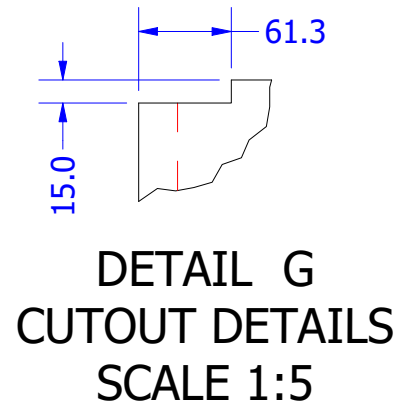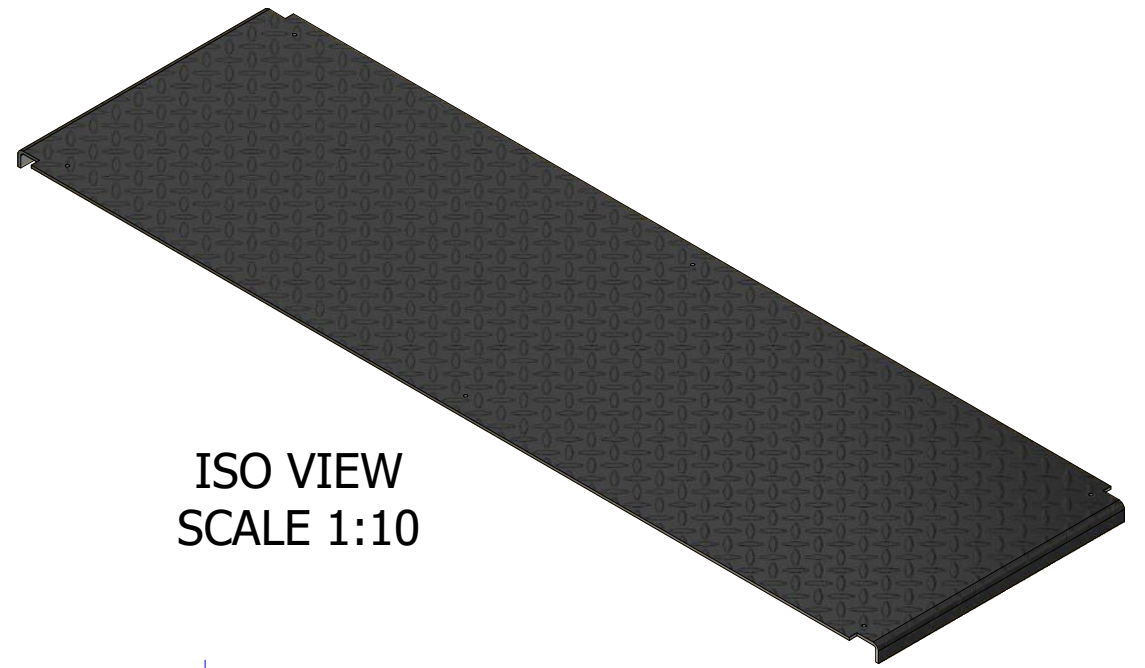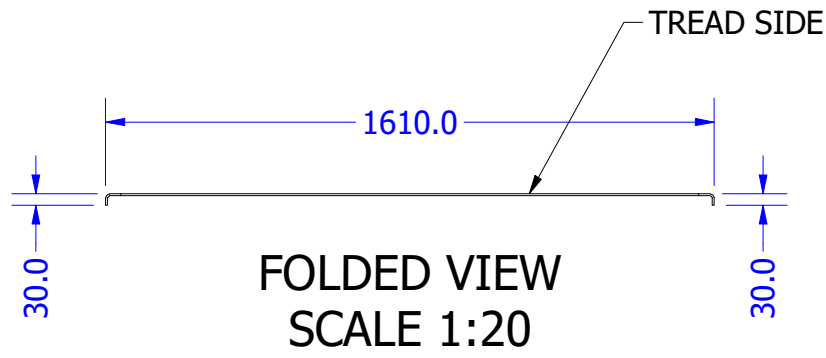


REMOVE ALL BURRS & SHARP EDGES



THESE DRAWINGS ARE THE PROPERTY OF ULTIMATE ENGINEERING AND SHOULD NOT BE REPRODUCED OR COPIED IN ANY WAY WITHOUT WRITTEN PERMISSION FROM ULTIMATE ENGINEERING

PAINT TREATMENT: YELLOW

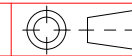

PARENT ASSEMBLY

CUSTOMER: **RAB ENGINEERING**

DIMENSION TOLERANCES	
DECIMAL	ANGULAR
X.X = ± .5 mm	X = ± 1°
X.XX = ± .25 mm	X.X = ± .5°
X.XXX = ± .125 mm	X.XX = ± .25°

MAXIMUM FINISHED SURFACE ROUGHNESS U.N.O. 1.6

DRAWN: David Bilney

TITLE: P1948-000-19  
CHAIN CONVEYORS

DESIGNED: David Bilney

DWG NO: **194801/28**

DATE: 15/03/2021


JOB NO:

SCALE: Scale  
SHEET 28 OF 34


SHEET SIZE: A3  
REV: 1

DO NOT SCALE DRAWING


5mm PLATE @ 1593 X 710	Aluminum 5052	AS1734
DESCRIPTION	MATERIAL	COMMENTS
P1948-000-20 - 1 REQ'D AS DRAWN		

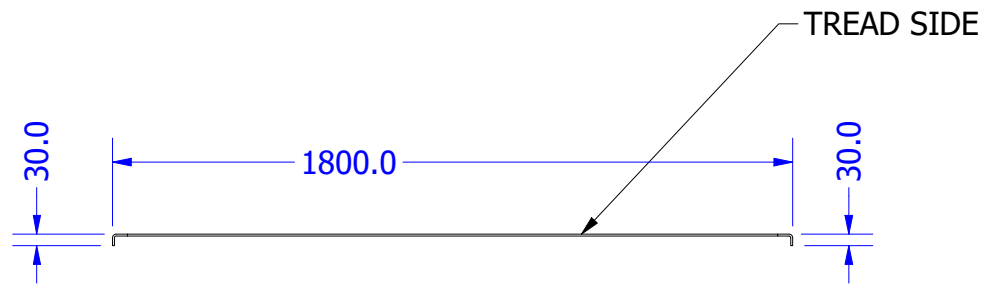


FOLDED VIEW  
SCALE 1:20

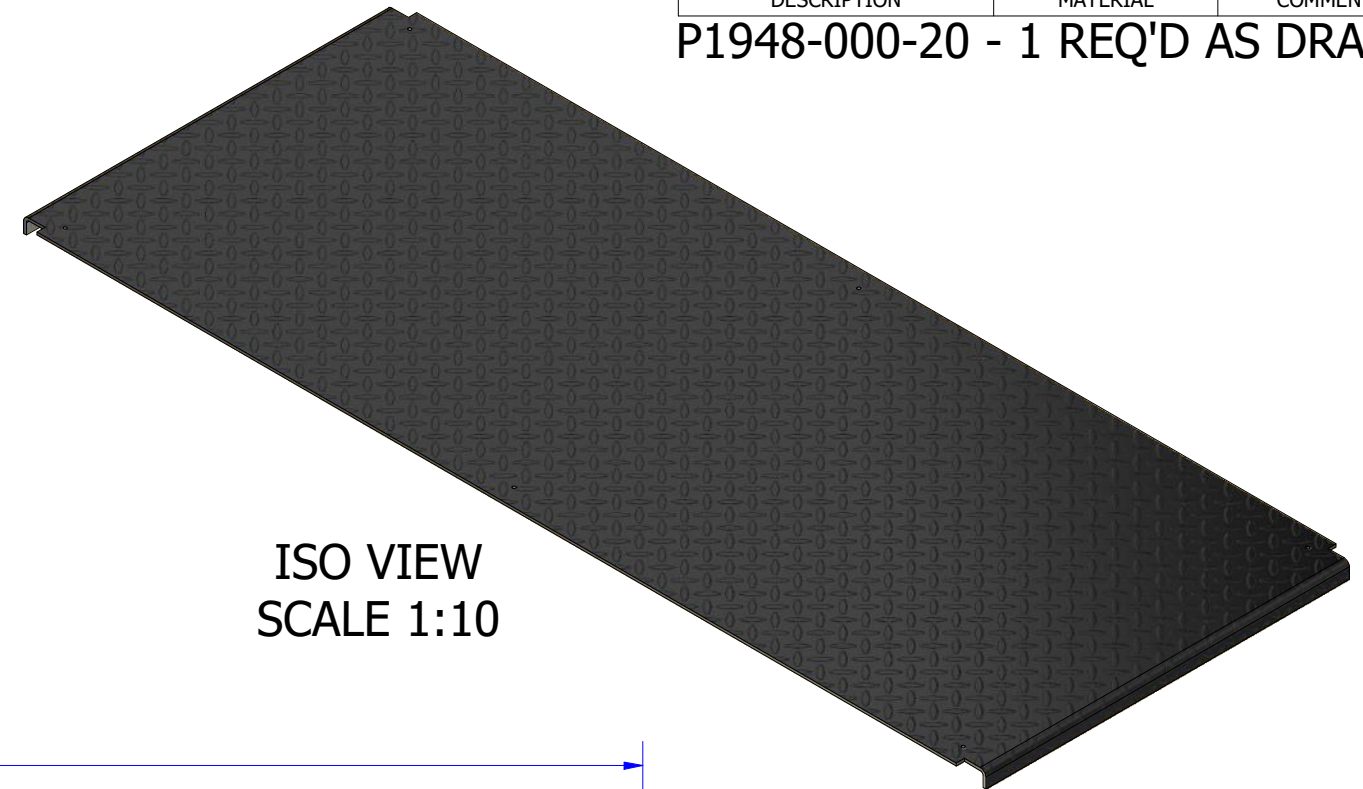

ISO VIEW  
SCALE 1:10

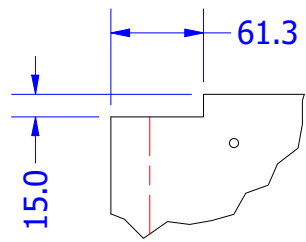

DETAIL H  
TYPICAL CUTOUT  
SCALE 1:5

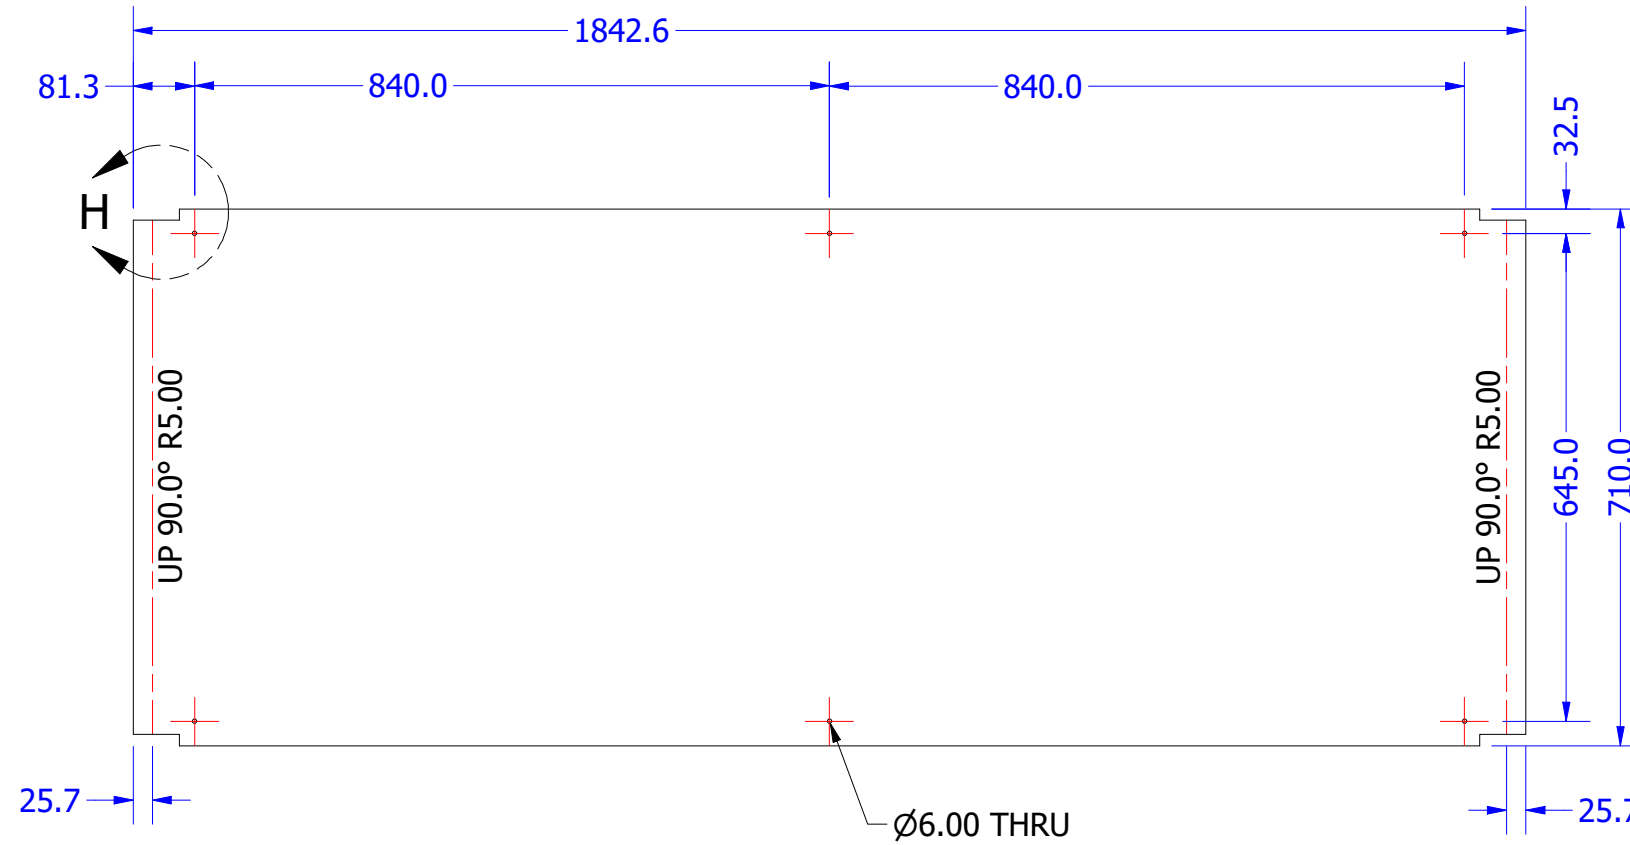

FLAT PATTERN  
TREAD FACE DOWN  
SCALE 1:10


REMOVE ALL BURRS & SHARP EDGES

DRAWN BY ULTIMATE ENGINEERING PTY LTD Ph 8562 1511



THESE DRAWINGS ARE THE PROPERTY OF ULTIMATE ENGINEERING AND SHOULD NOT BE REPRODUCED OR COPIED IN ANY WAY WITHOUT WRITTEN PERMISSION FROM ULTIMATE ENGINEERING

PAINT TREATMENT: YELLOW

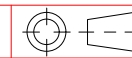

PARENT ASSEMBLY

CUSTOMER: **RAB ENGINEERING**

DIMENSION TOLERANCES	
DECIMAL	ANGULAR
X.X = ± .5 mm	X = ± 1°
X.XX = ± .25 mm	X.X = ± .5°
X.XXX = ± .125 mm	X.XX = ± .25°

MAXIMUM FINISHED SURFACE ROUGHNESS U.N.O. 1.6

DRAWN: David Bilney

TITLE: P1948-000-20  
CHAIN CONVEYORS

DESIGNED: David Bilney

DWG NO: **194801/29**

DATE: 15/03/2021

JOB NO:

SCALE: Scale  
SHEET 29 OF 34


SHEET SIZE: A3

REV: 1


DO NOT SCALE DRAWING

5mm PLATE @ 1293 X 490	Aluminum 5052	AS1734
DESCRIPTION	MATERIAL	COMMENTS


P1948-000-21 - 1 REQ'D AS DRAWN

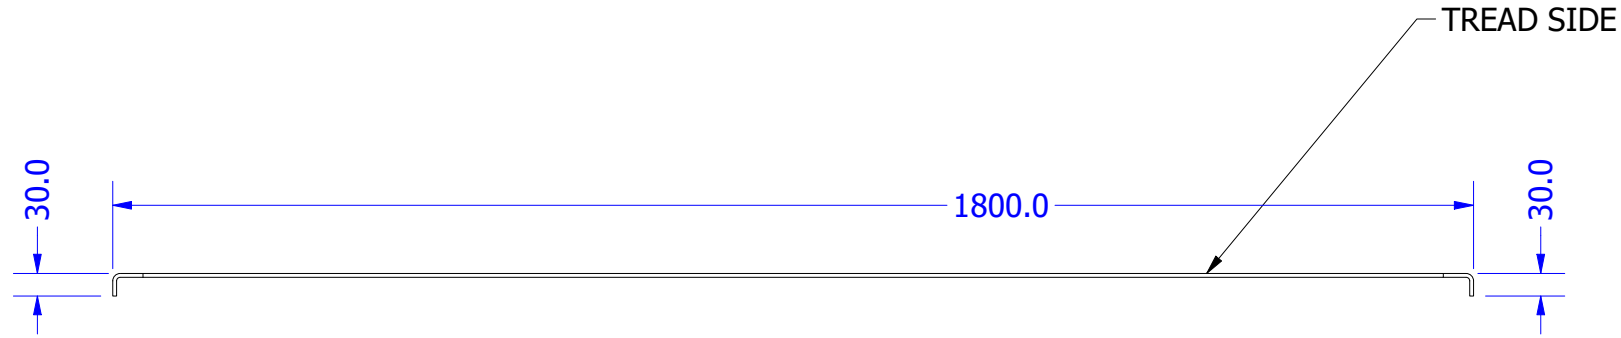


FOLDED VIEW  
SCALE 1:10

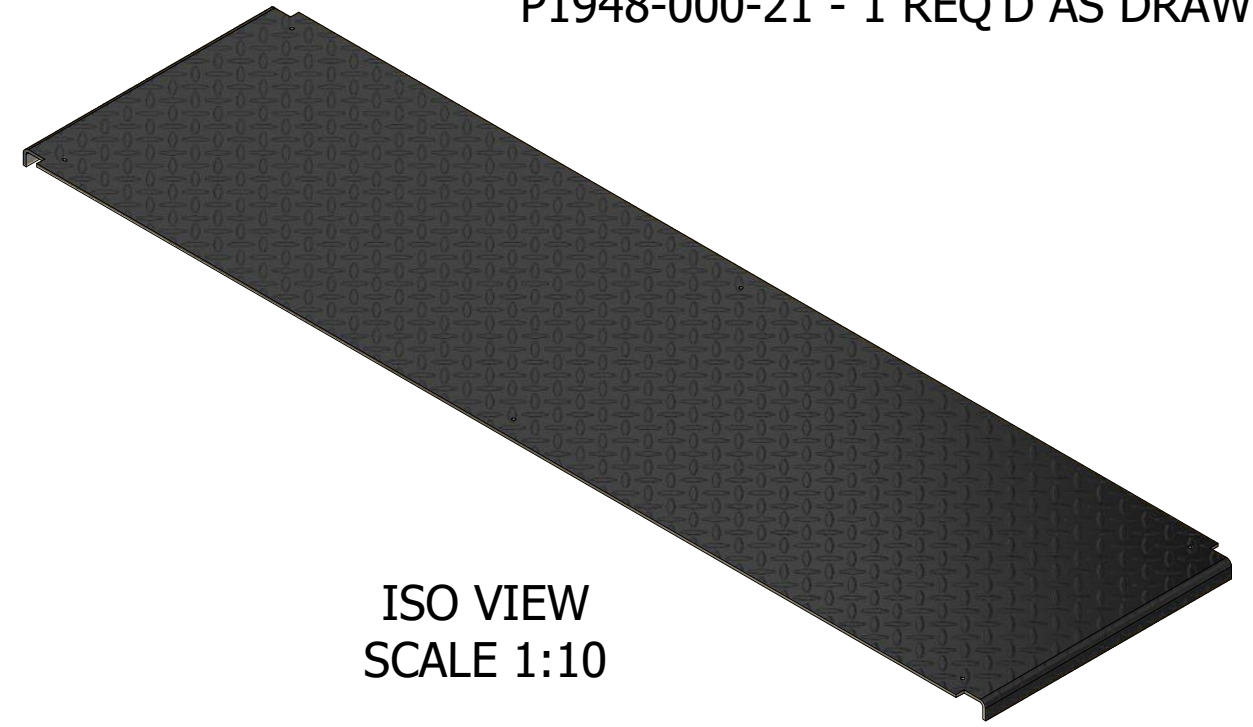

ISO VIEW  
SCALE 1:10

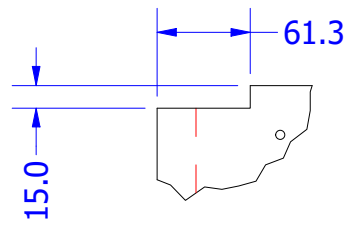

DETAIL J  
TYPICAL CUTOUT  
SCALE 1:5

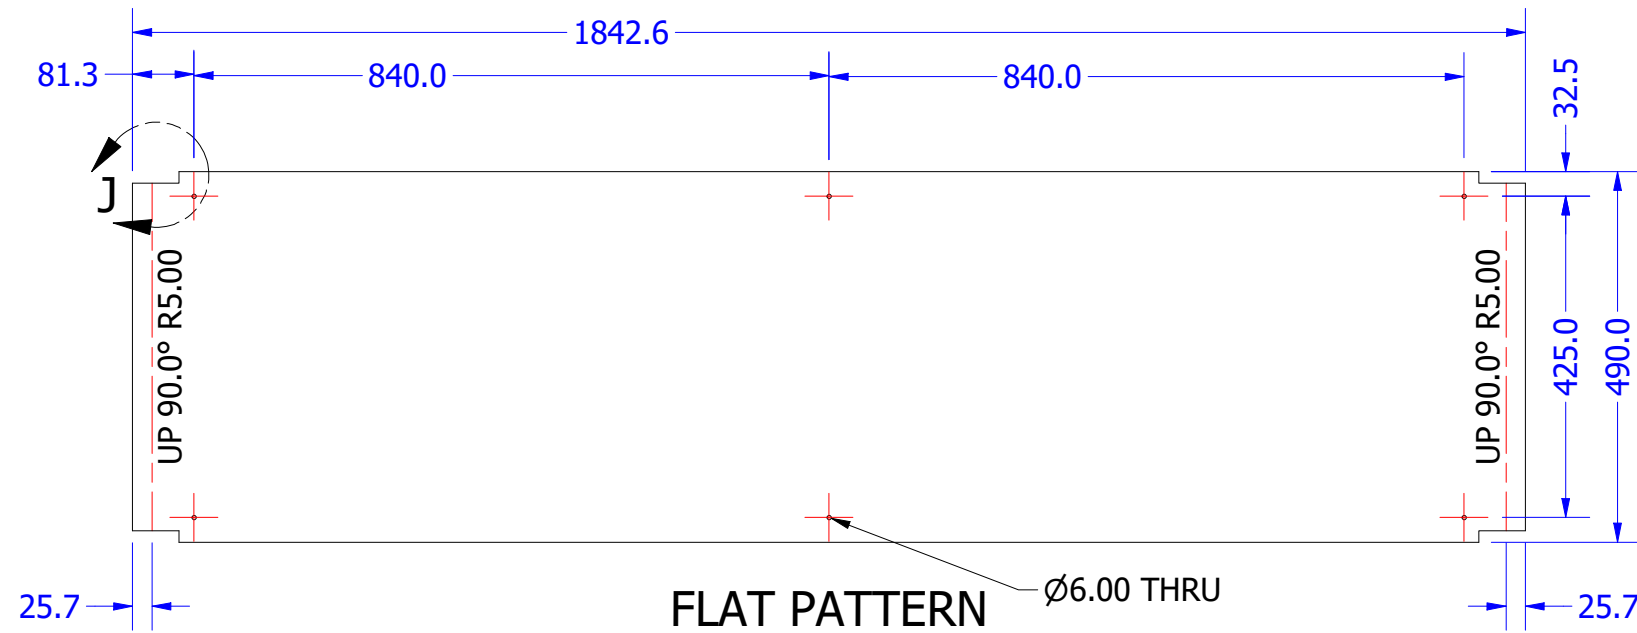

FLAT PATTERN  
TREAD SIDE DOWN  
SCALE 1:10

Ø6.00 THRU


REMOVE ALL BURRS & SHARP EDGES

DRAWN BY ULTIMATE ENGINEERING PTY LTD Ph 8562 1511



THESE DRAWINGS ARE THE PROPERTY OF ULTIMATE ENGINEERING AND SHOULD NOT BE REPRODUCED OR COPIED IN ANY WAY WITHOUT WRITTEN PERMISSION FROM ULTIMATE ENGINEERING

PAINT TREATMENT: YELLOW

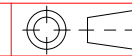

PARENT ASSEMBLY

CUSTOMER: **RAB ENGINEERING**

DIMENSION TOLERANCES	
DECIMAL	ANGULAR
X.X = ± .5 mm	X = ± 1°
X.XX = ± .25 mm	X.X = ± .5°
X.XXX = ± .125 mm	X.XX = ± .25°

MAXIMUM FINISHED SURFACE ROUGHNESS U.N.O. 1.6

DRAWN: David Bilney

TITLE: P1948-000-21  
CHAIN CONVEYORS

DESIGNED: David Bilney

DWG NO: **194801/30**


DATE: 15/03/2021

JOB NO:

SCALE: Scale	SHEET 30 OF 34	SHEET SIZE: A3	REV: 1
--------------	----------------	----------------	--------

DO NOT SCALE DRAWING


30x10 FLAT @ 895	Polyethylene, High Density	
DESCRIPTION	MATERIAL	COMMENTS
P1948-000-24 - 3 REQ'D AS DRAWN		

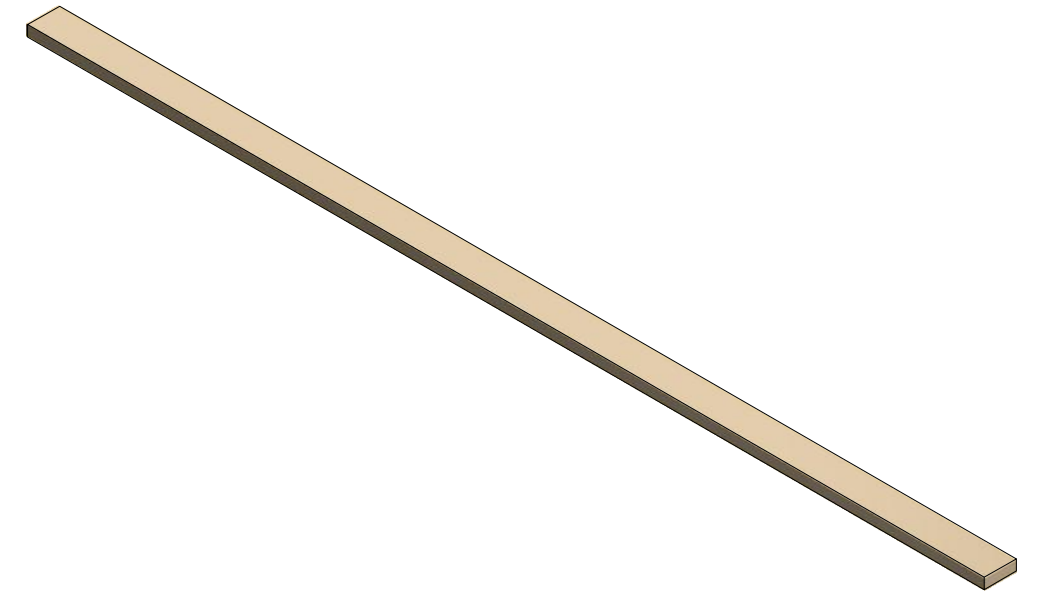


ISO VIEW  
SCALE 1:5



PLAN VIEW  
SCALE 1:5

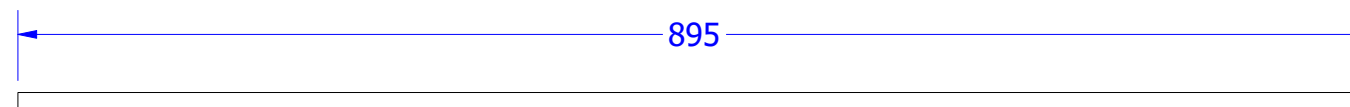

SIDE VIEW  
SCALE 1:5

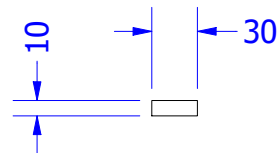

END VIEW  
SCALE 1:5

REMOVE ALL BURRS & SHARP EDGES



THESE DRAWINGS ARE THE PROPERTY OF ULTIMATE ENGINEERING AND SHOULD NOT BE REPRODUCED OR COPIED IN ANY WAY WITHOUT WRITTEN PERMISSION FROM ULTIMATE ENGINEERING

PAINT TREATMENT:



DIMENSION TOLERANCES	
DECIMAL	ANGULAR
X.X = ± .5 mm	X = ± 1°
X.XX = ± .25 mm	X.X = ± .5°
X.XXX = ± .125 mm	X.XX = ± .25°
MAXIMUM FINISHED SURFACE ROUGHNESS U.N.O. 1.6	

PARENT ASSEMBLY

DRAWN: David Bilney

DESIGNED: David Bilney

DATE: 15/03/2021

CUSTOMER: RAB ENGINEERING

TITLE: P1948-000-24  
CHAIN CONVEYORS

DWG NO: 194801/31

JOB NO:

SCALE: Scale 31 OF 34

SHEET SIZE: A3


REV: 1




DO NOT SCALE DRAWING

2mm PLATE @ 3470 X 95	Steel, Mild	AS1594 - GR250
DESCRIPTION	MATERIAL	COMMENTS


P1948-000-27 - 3 REQ'D AS DRAWN

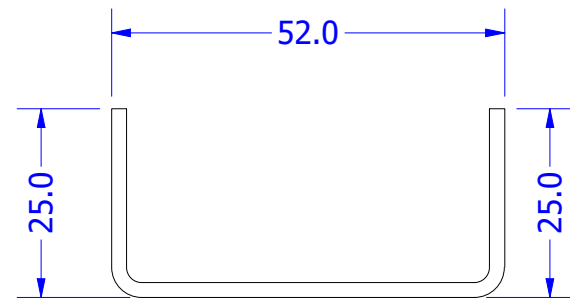

END VIEW - FOLDED  
SCALE 1 : 1

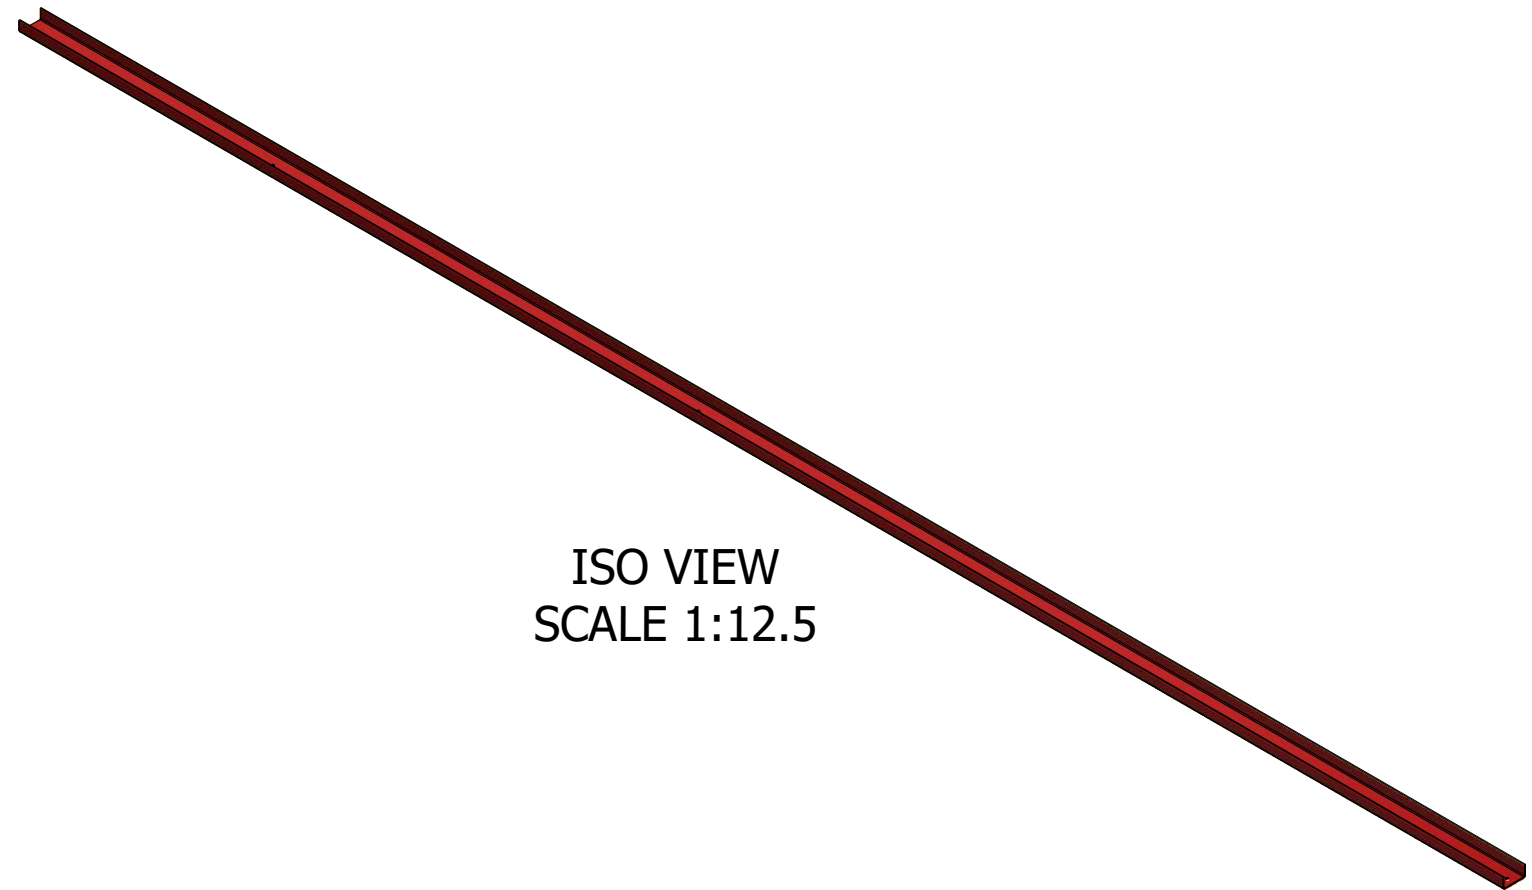

ISO VIEW  
SCALE 1:12.5

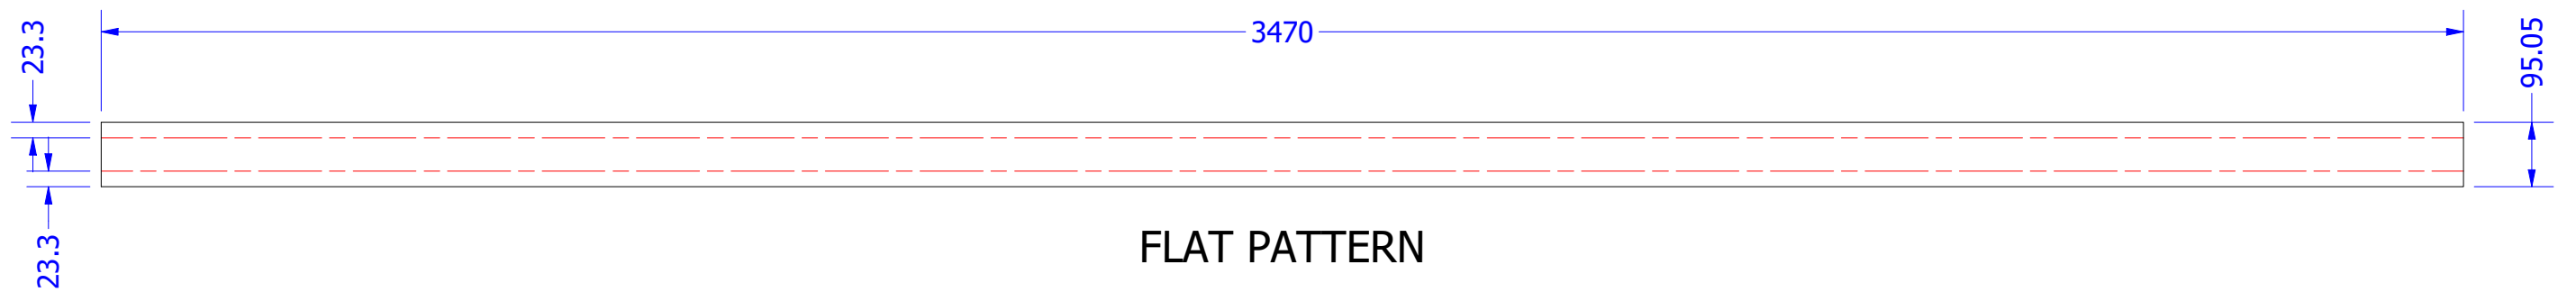


FLAT PATTERN  
ALL FOLDS UP 90°  
SCALE 1:10

REMOVE ALL BURRS & SHARP EDGES



THESE DRAWINGS ARE THE PROPERTY OF ULTIMATE ENGINEERING AND SHOULD NOT BE REPRODUCED OR COPIED IN ANY WAY WITHOUT WRITTEN PERMISSION FROM ULTIMATE ENGINEERING

PAINT TREATMENT:

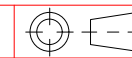

DIMENSION TOLERANCES	
DECIMAL	ANGULAR
X.X = ± .5 mm	X = ± 1°
X.XX = ± .25 mm	X.X = ± .5°
X.XXX = ± .125 mm	X.XX = ± .25°

MAXIMUM FINISHED SURFACE ROUGHNESS U.N.O. 1.6

PARENT ASSEMBLY

CUSTOMER: **RAB ENGINEERING**

DRAWN: David Bilney

TITLE: P1948-000-27  
CHAIN CONVEYORS

DESIGNED: David Bilney

DWG NO: **194801/32**

DATE: 15/03/2021

JOB NO:

SCALE: Scale 32 OF 34

SHEET SIZE: A3


REV: 1




DO NOT SCALE DRAWING

30x10 FLAT @ 2045	Polyethylene, High Density	
DESCRIPTION	MATERIAL	COMMENTS


P1948-000-28 - 3 REQ'D AS DRAWN

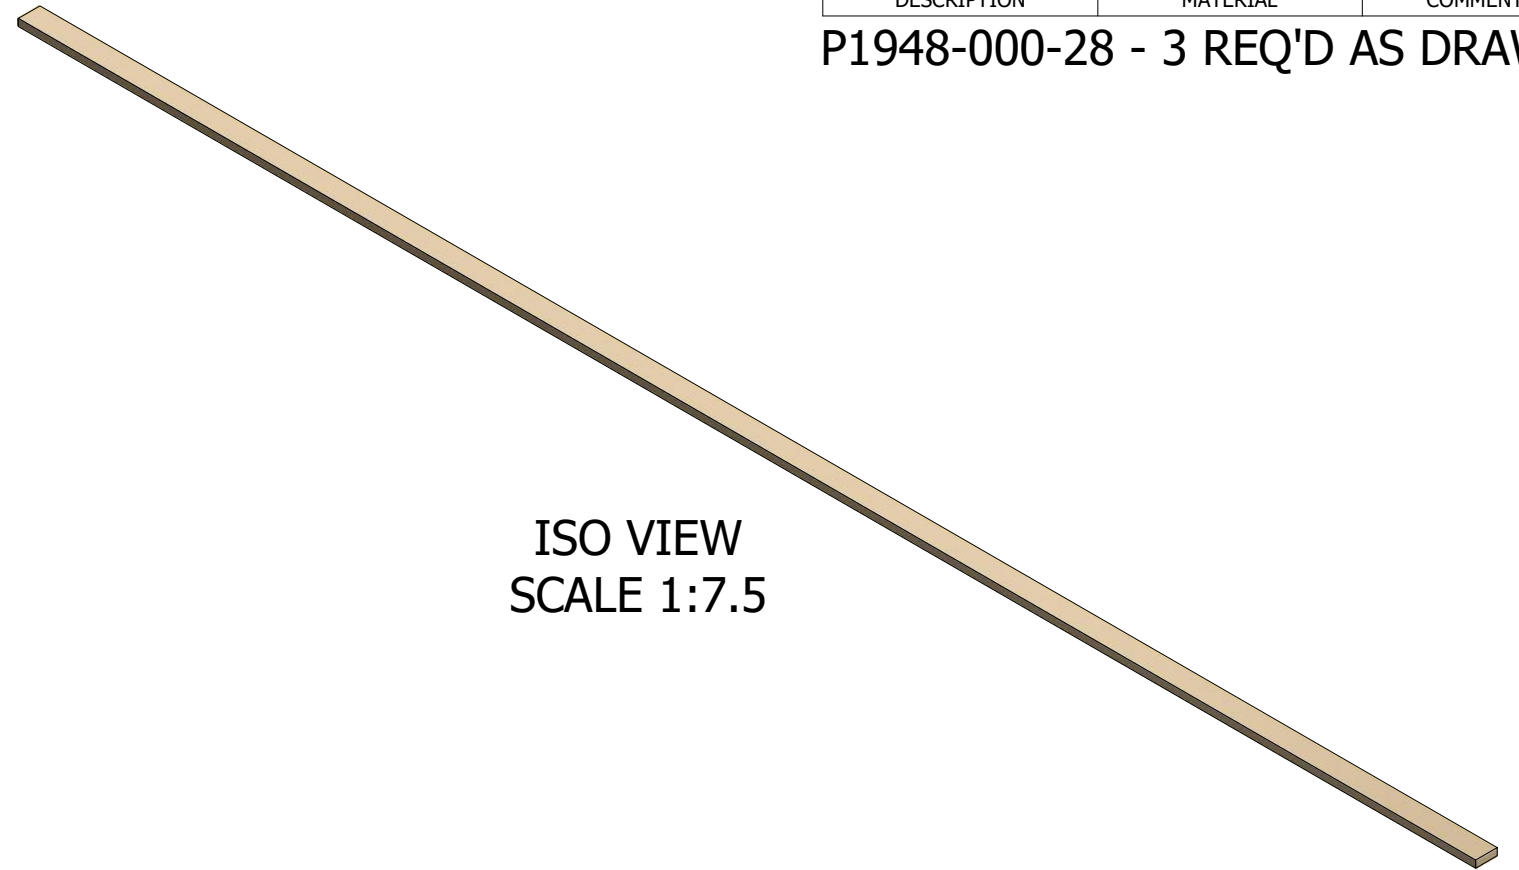

ISO VIEW  
SCALE 1:7.5

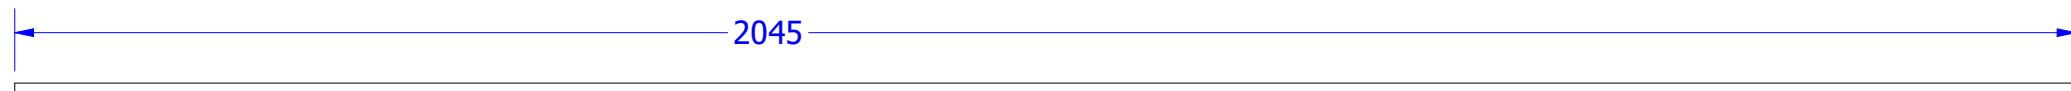

FRONT VIEW  
SCALE 1:7.5

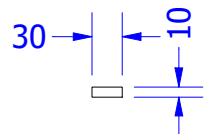


END VIEW  
SCALE 1:7.5

REMOVE ALL BURRS & SHARP EDGES



THESE DRAWINGS ARE THE PROPERTY OF ULTIMATE ENGINEERING AND SHOULD NOT BE REPRODUCED OR COPIED IN ANY WAY WITHOUT WRITTEN PERMISSION FROM ULTIMATE ENGINEERING

PAINT TREATMENT:

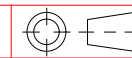

DIMENSION TOLERANCES	
DECIMAL	ANGULAR
X.X = ± .5 mm	X = ± 1°
X.XX = ± .25 mm	X.X = ± .5°
X.XXX = ± .125 mm	X.XX = ± .25°
MAXIMUM FINISHED SURFACE ROUGHNESS U.N.O. 1.6	

PARENT ASSEMBLY

DRAWN: David Bilney

DESIGNED: David Bilney

DATE: 15/03/2021

CUSTOMER: **RAB ENGINEERING**

TITLE: P1948-000-28  
CHAIN CONVEYORS

DWG NO: **194801/33**

JOB NO:

SCALE: Scale 33 OF 34


SHEET SIZE: A3

REV: 1


DO NOT SCALE DRAWING

24RND BAR @ 50mm	Steel, Mild	AS1443 - 1020
DESCRIPTION	MATERIAL	COMMENTS


QTY: 1 PER IDLER SPROCKET

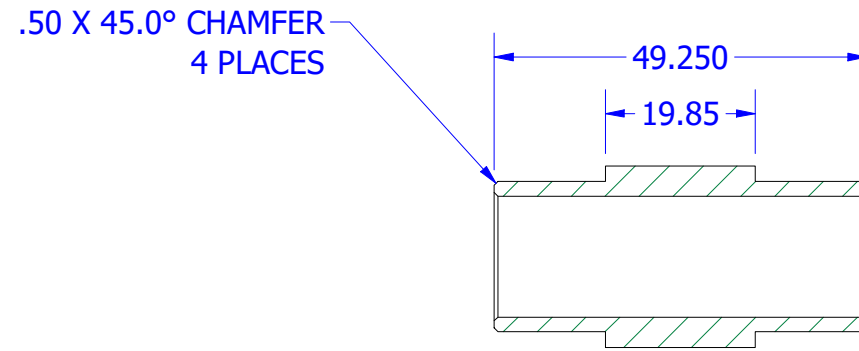


SECTION M-M  
SCALE 1 : 1

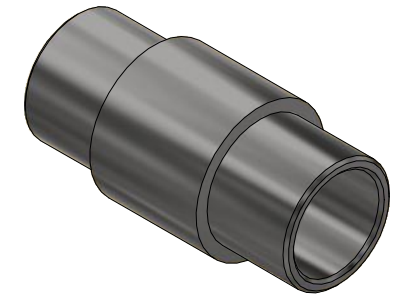

ISO VIEW  
SCALE 1 : 1

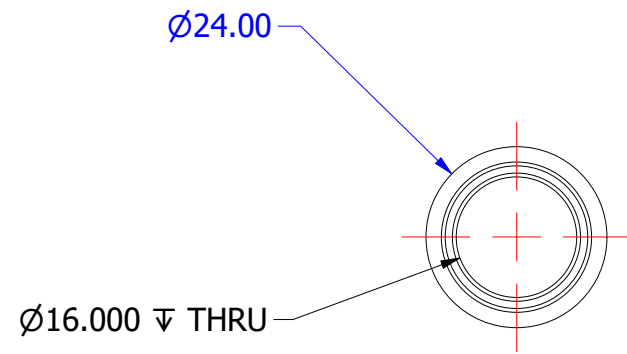

END VIEW  
SCALE 1 : 1

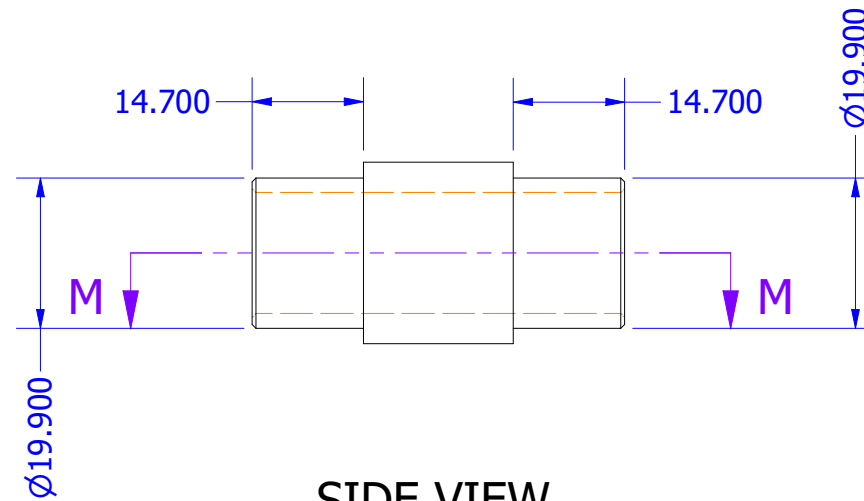


SIDE VIEW  
SCALE 1 : 1

DRAWN BY ULTIMATE ENGINEERING PTY LTD Ph 8562 1511



THESE DRAWINGS ARE THE PROPERTY OF ULTIMATE ENGINEERING AND SHOULD NOT BE REPRODUCED OR COPIED IN ANY WAY WITHOUT WRITTEN PERMISSION FROM ULTIMATE ENGINEERING

PAINT TREATMENT:

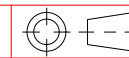

DIMENSION TOLERANCES	
DECIMAL	ANGULAR
X.X = ± .5 mm	X = ± 1°
X.XX = ± .25 mm	X.X = ± .5°
X.XXX = ± .125 mm	X.XX = ± .25°

MAXIMUM FINISHED SURFACE ROUGHNESS U.N.O. 1.6

PARENT ASSEMBLY

DRAWN: David Bilney

DESIGNED: David Bilney

DATE: 15/03/2021

CUSTOMER:

**RAB ENGINEERING**

TITLE:

P1948-000-29  
CHAIN CONVEYORS

DWG NO:

**194801/34**

JOB NO:


SCALE:  
Scale

SHEET  
34 OF 34

SHEET SIZE:  
A3

REV:  
1

DO NOT SCALE DRAWING

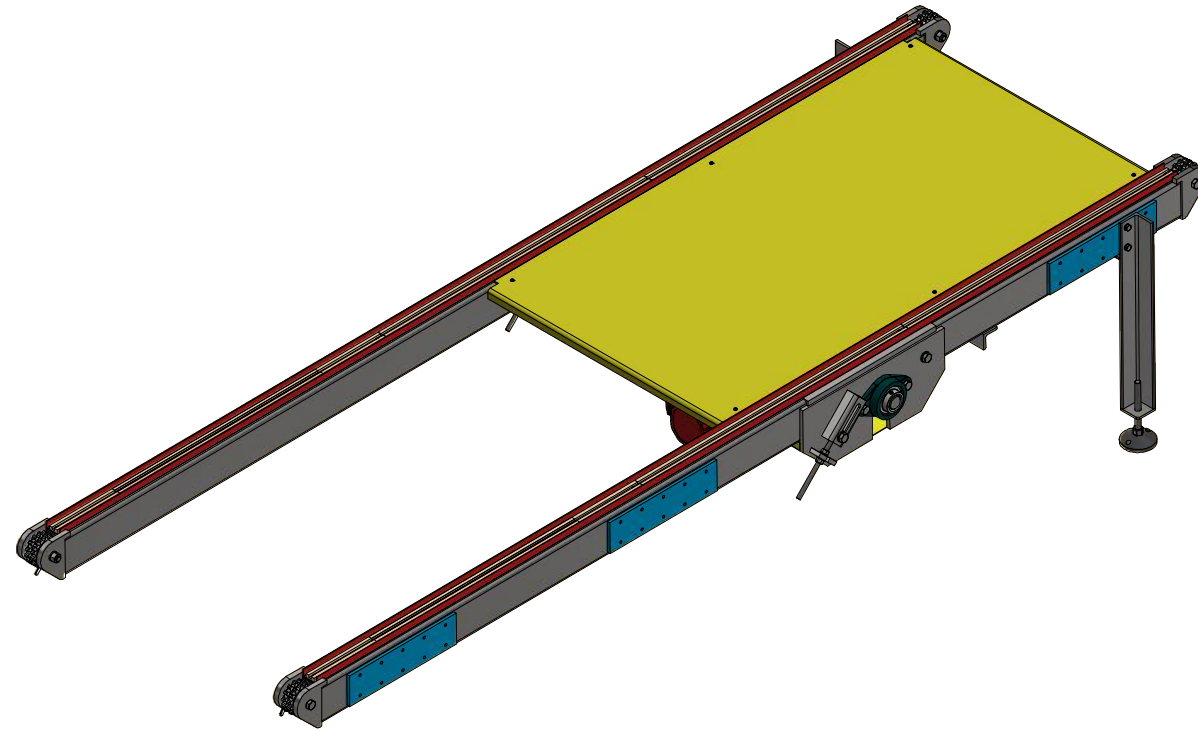

ISO VIEW  
SCALE 1:20

37	ISO 10642 - M5x16	Steel, Mild	C/SUNK SOCKET HEAD	8
36	14 TOOTH DOUBLE ROW IDLER		BSC. 2x BEARINGS & SLEEVE	8
35	KA67_DRN90S4		MOTOR: SEW	1
34	AS 1110 - M12 x 25	Steel, Mild	HEX HEAD BOLT	6
33	AS 1968 - 1976 - 12	Steel, Mild	SPRING WASHER	6
32	AS 1110 - M16 x 55	Steel, Mild	HEX HEAD BOLT	4
31	LDK-FL210. UC210D1+H2309		2 BOLT PILLOW BLOCK	2
30	LVR10016140B	Steel, Mild	ADJUSTABLE FOOT	2
29	P1948-002-01	Steel, Mild	SHEET 12	1
28	AS 1112 - M12	Steel, Mild	HEX NUT	4
27	AS 1237 - 12 mm(3)	Steel, Mild	FLAT WASHER	4
26	M5 x 16 BUTTON HEAD	Steel		14
25	AS 1110 - M8 x 12	Steel, Mild	HEX HEAD BOLT	4
24	AS 1968 - 1976 - 8	Steel, Mild	SPRING WASHER	4
23	AS 1111 - M16 x 140	Steel, Mild	HEX HEAD BOLT	2
22	AS 1285 - M16	Steel, Mild	NYLOCK NUT	4
21	AS 1111 - M16 x 110	Steel, Mild	HEX HEAD BOLT	6
20	AS 1110 - M10 x 20	Steel, Mild	HEX HEAD BOLT	4
19	AS 1968 - 1976 - 10	Steel, Mild	SPRING WASHER	4
18	AS 1968 - 1976 - 16	Steel, Mild	SPRING WASHER	9
17	AS 1237 - 16 mm(3)	Steel, Mild	FLAT WASHER	13
16	AS 1110 - M16 x 50	Steel, Mild	HEX HEAD BOLT	1
15	P1948-000-11	Steel, Mild	SHEET 24	2
14	P1948-000-23	HDPE	SHEET 29	2
13	P1948-000-24	HDPE	SHEET 30	2
12	P1948-000-15	HDPE	SHEET 27	8
11	W1948-000-04		SHEET 7	1
10	P1948-000-10	Steel, Mild	SHEET 23	4
9	21T DRIVE SPROCKET	Steel, Mild	194810	2
8	W1948-000-05		SHEET 8	1
7	P1948-000-09	Steel, Mild	SHEET 22	4
6	P1948-000-12	Steel, Mild	SHEET 25	1
5	W1948-002-04		SHEET 7	1
4	W1948-002-03		SHEET 10	1
3	W1948-002-02		SHEET 5	1
2	W1948-002-01		SHEET 4	1
1	AS 1112 - M16	Steel, Mild	HEX NUT	11
ITEM	PART NUMBER	MATERIAL	COMMENTS	ITEM QTY

A1948-002-01 - 7 REQ'D AS DRAWN

DRAWN BY ULTIMATE ENGINEERING PTY LTD Ph 8562 1511







1	27/04/2021	AS BUILT	DB
0	7/04/2021	APPROVED FOR MANUFACTURE	PB
REV	DATE	DESCRIPTION	APPRD
REVISION HISTORY			
THESE DRAWINGS ARE THE PROPERTY OF ULTIMATE ENGINEERING AND SHOULD NOT BE REPRODUCED OR COPIED IN ANY WAY WITHOUT WRITTEN PERMISSION FROM ULTIMATE ENGINEERING			

PAINT TREATMENT:			
DIMENSION TOLERANCES			
DECIMAL		ANGULAR	
X.X	= ± .5 mm	X	= ± 1°
X.XX	= ± .25 mm	X.X	= ± .5°
X.XXX	= ± .125 mm	X.XX	= ± .25°
MAXIMUM FINISHED SURFACE ROUGHNESS U.N.O. 1.6			

PARENT ASSEMBLY	CUSTOMER:	<b>RAB ENGINEERING</b>			
DRAWN: David Bilney	TITLE:	A1948-002-01 CHAIN CONVEYORS			
DESIGNED: David Bilney	DWG NO:	<b>194802</b>			
DATE: 17/03/2021	JOB NO:	SCALE: Scale	SHEET 1 OF 31	SHEET SIZE: A3	REV: 1

DO NOT SCALE DRAWING

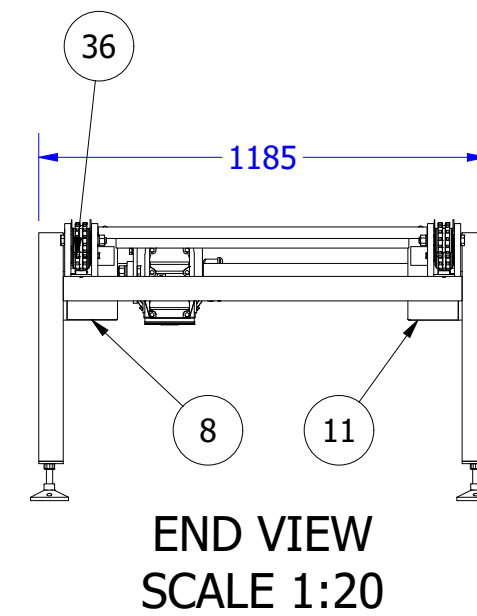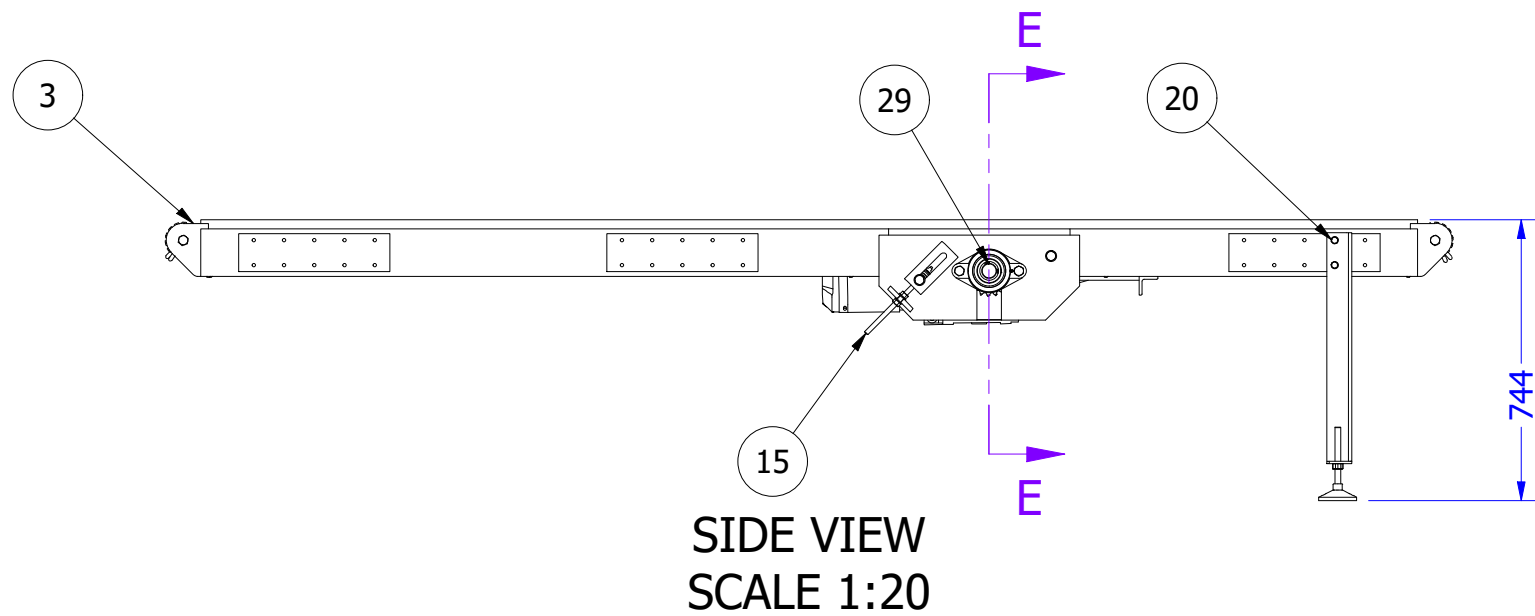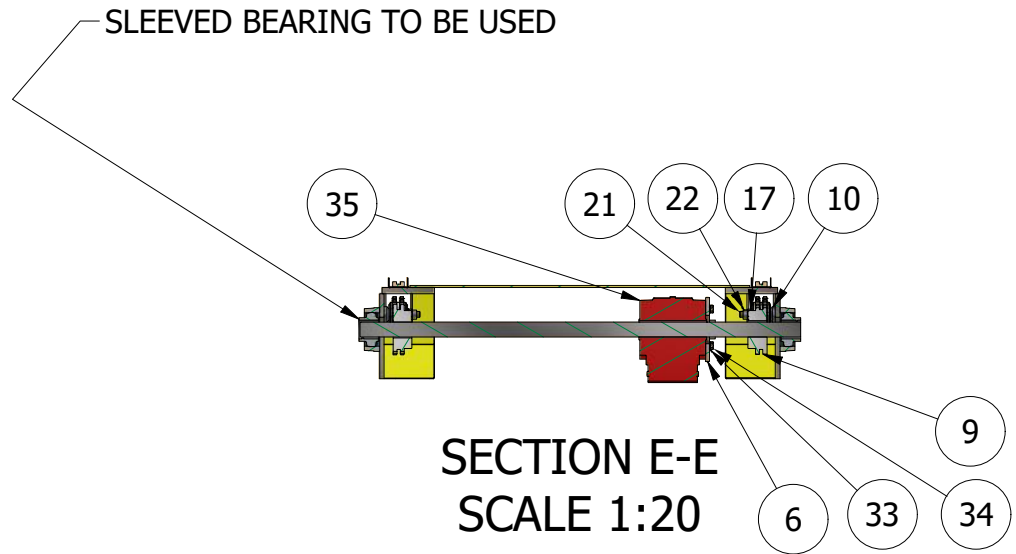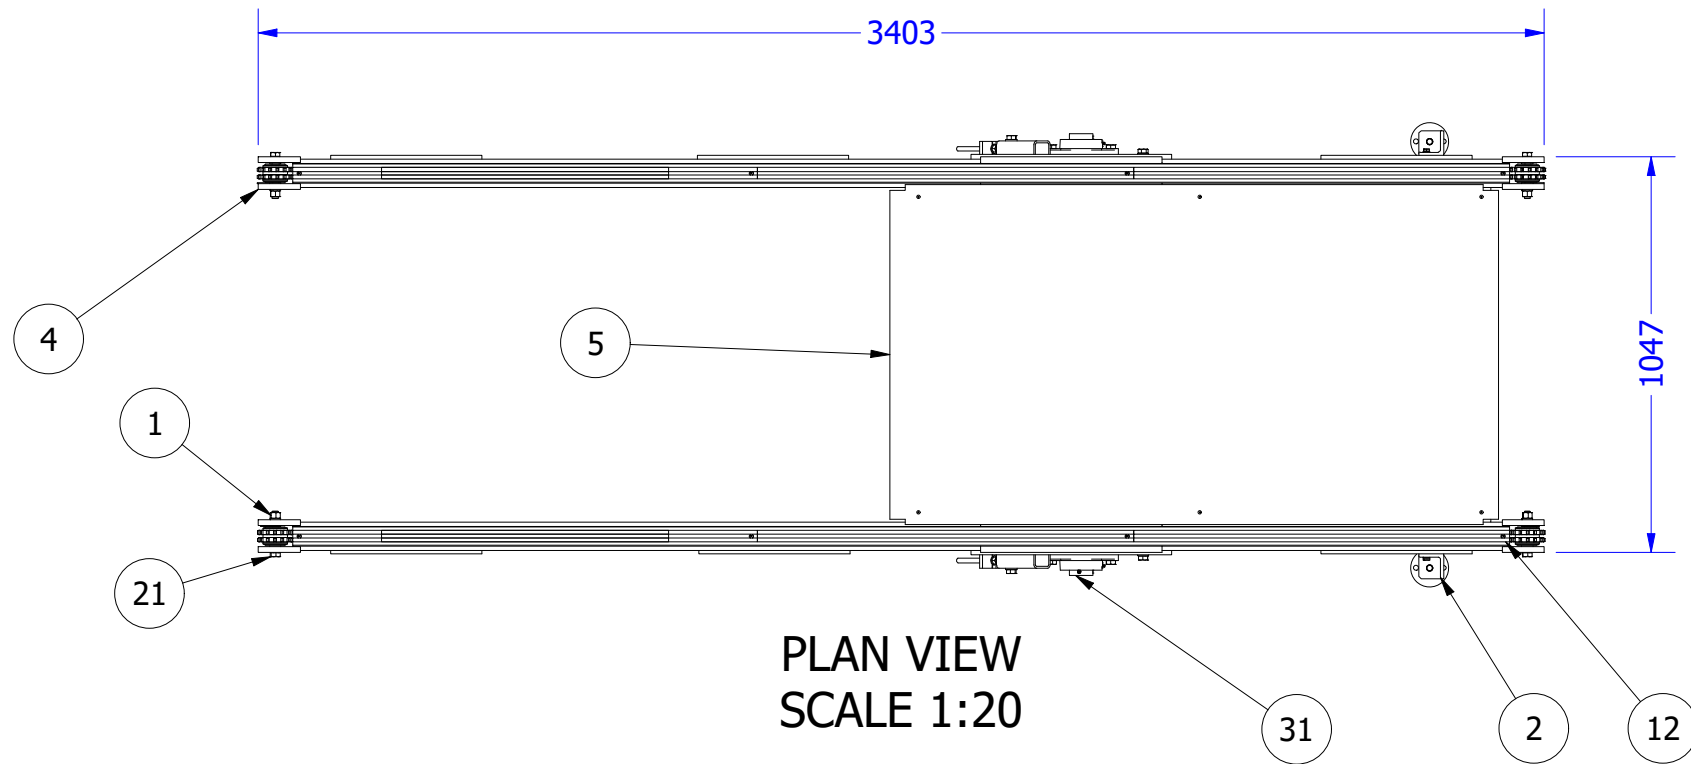


DRAWN BY ULTIMATE ENGINEERING PTY LTD Ph 8562 1511



THESE DRAWINGS ARE THE PROPERTY OF ULTIMATE ENGINEERING AND SHOULD NOT BE REPRODUCED OR COPIED IN ANY WAY WITHOUT WRITTEN PERMISSION FROM ULTIMATE ENGINEERING

PAINT TREATMENT:

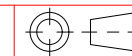

DIMENSION TOLERANCES	
DECIMAL	ANGULAR
X.X = ± .5 mm	X = ± 1°
X.XX = ± .25 mm	X.X = ± .5°
X.XXX = ± .125 mm	X.XX = ± .25°

MAXIMUM FINISHED SURFACE ROUGHNESS U.N.O. 1.6 ✓

PARENT ASSEMBLY

CUSTOMER:

RAB ENGINEERING

DRAWN: David Bilney

TITLE:

A1948-002-01  
CHAIN CONVEYORS

DESIGNED: David Bilney

DWG NO:

194802

DATE: 17/03/2021

JOB NO:

SCALE:  
Scale



SHEET  
2 OF 31

SHEET SIZE:  
A3

REV:  
1

DO NOT SCALE DRAWING

3	NTN 6304LLUNR		BEARING	2
2	P1948-000-29	Steel, Mild	SHEET 31	1
1	12B2-14 DUPLEX SPROCKET	Steel, Mild	52mm BORE	1
ITEM	PART NUMBER	MATERIAL	COMMENTS	ITEM QTY

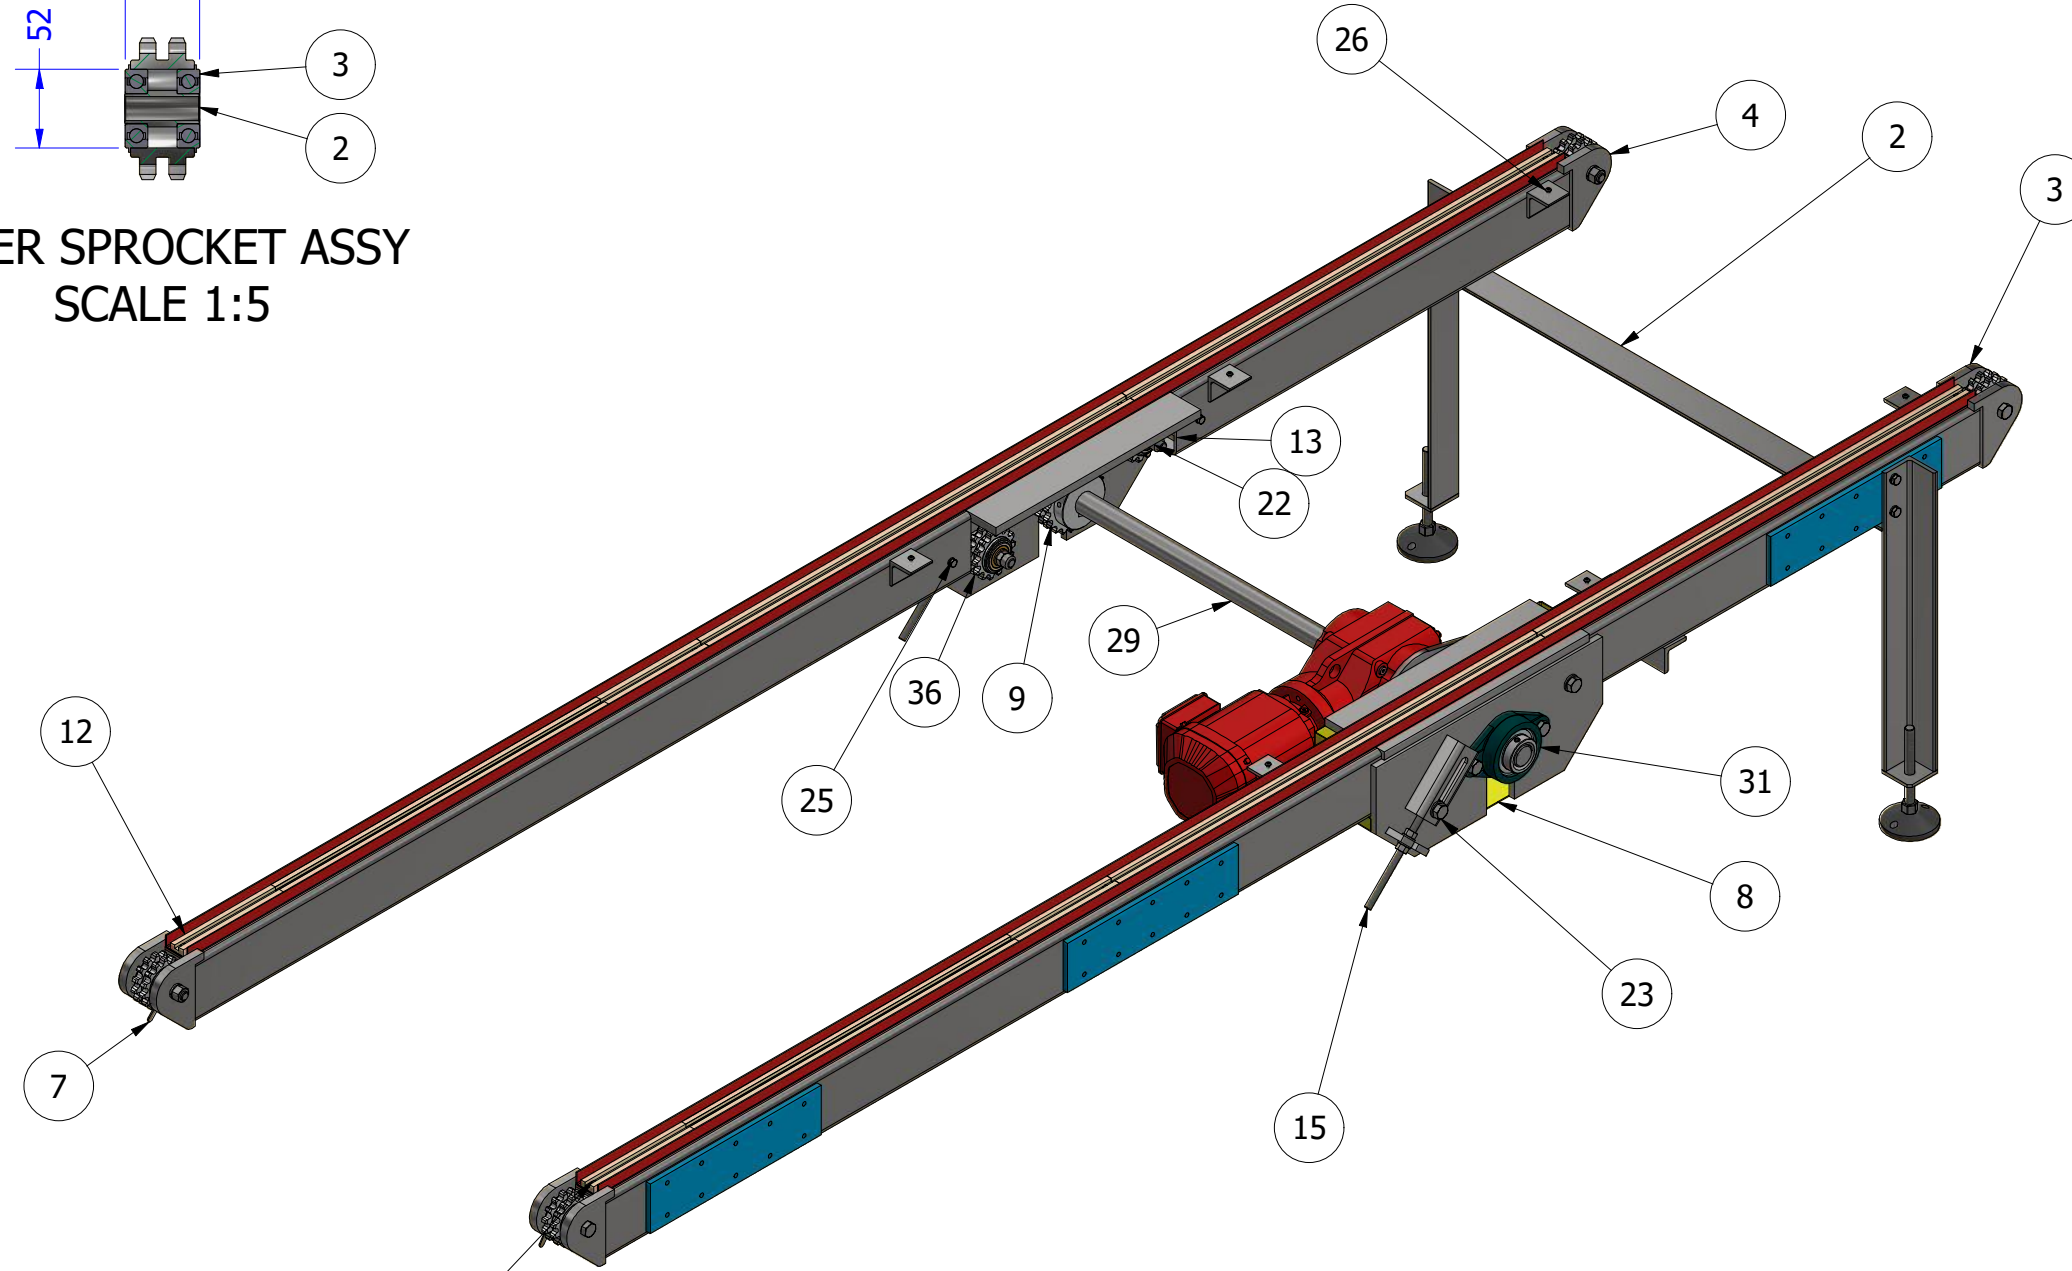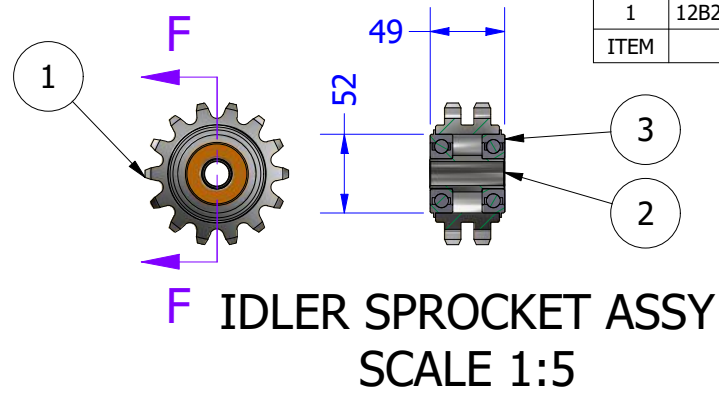

DRILL & TAP M5  
WHEN INSTALLING ALL  
WEAR STRIPS


ISO VIEW  
TREAD PLATE REMOVED FOR CLARITY  
SCALE 1:12.5

DRAWN BY ULTIMATE ENGINEERING PTY LTD Ph 8562 1511



THESE DRAWINGS ARE THE PROPERTY OF ULTIMATE ENGINEERING AND SHOULD NOT BE REPRODUCED OR COPIED IN ANY WAY WITHOUT WRITTEN PERMISSION FROM ULTIMATE ENGINEERING

PAINT TREATMENT:

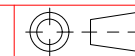

DIMENSION TOLERANCES	
DECIMAL	ANGULAR
X.X = ± .5 mm	X = ± 1°
X.XX = ± .25 mm	X.X = ± .5°
X.XXX = ± .125 mm	X.XX = ± .25°

MAXIMUM FINISHED SURFACE ROUGHNESS U.N.O. 1.6

PARENT ASSEMBLY

CUSTOMER:

**RAB ENGINEERING**

DRAWN: David Bilney

TITLE:

A1948-002-01  
CHAIN CONVEYORS

DESIGNED: David Bilney

DWG NO:

**194802**

DATE: 17/03/2021

JOB NO:

SCALE:  
Scale

SHEET  
3 OF 31

SHEET SIZE:  
A3


REV:  
1




DO NOT SCALE DRAWING

4	P1948-000-03	Steel, Mild	SHEET 16	1
3	P1948-000-05	Steel, Mild	SHEET 18	2
2	P1948-000-04	Steel, Mild	SHEET 17	1
1	P1948-000-01	Steel, Mild	SHEET 14	1
ITEM	PART NUMBER	MATERIAL	COMMENTS	ITEM QTY


W1948-000-01 - 1 REQ'D AS DRAWN

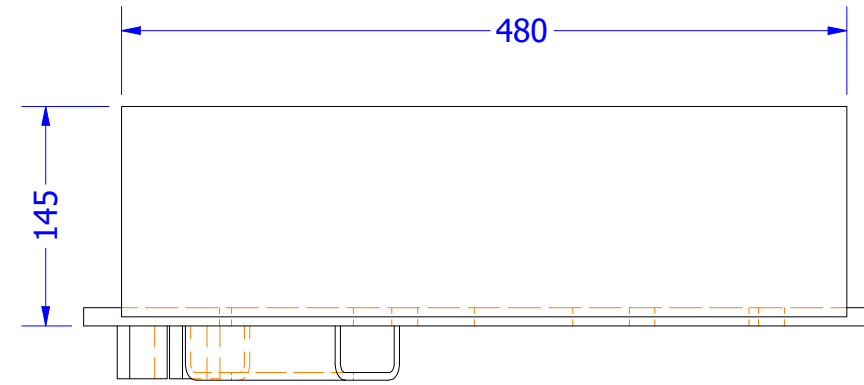


PLAN VIEW  
SCALE 1:5

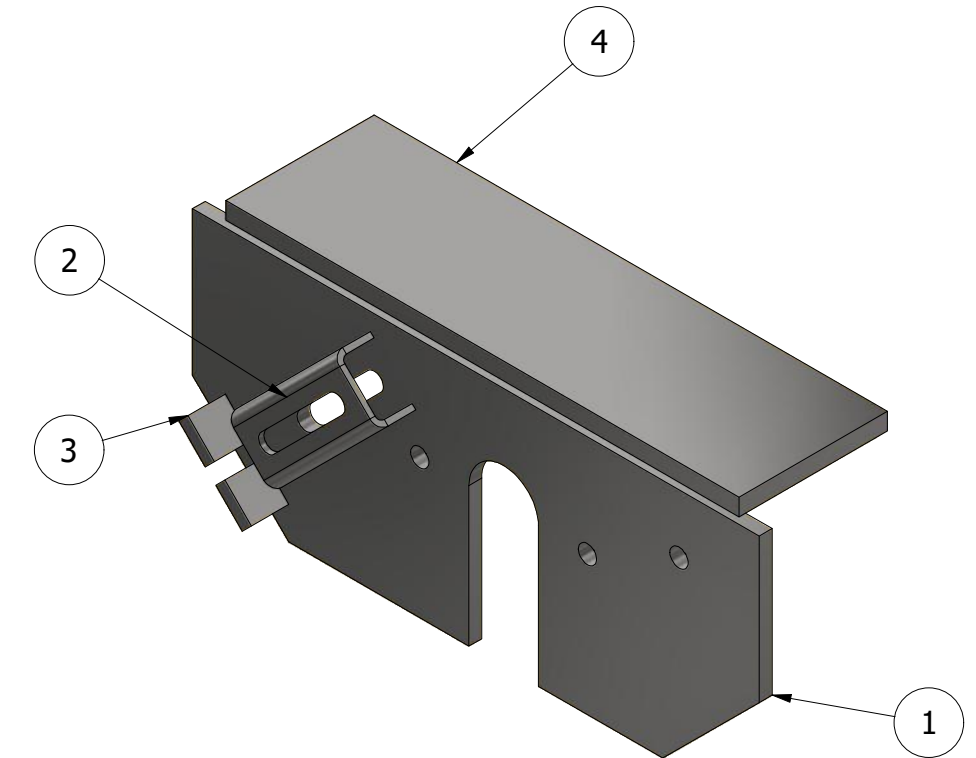

ISO VIEW  
SCALE 1:5

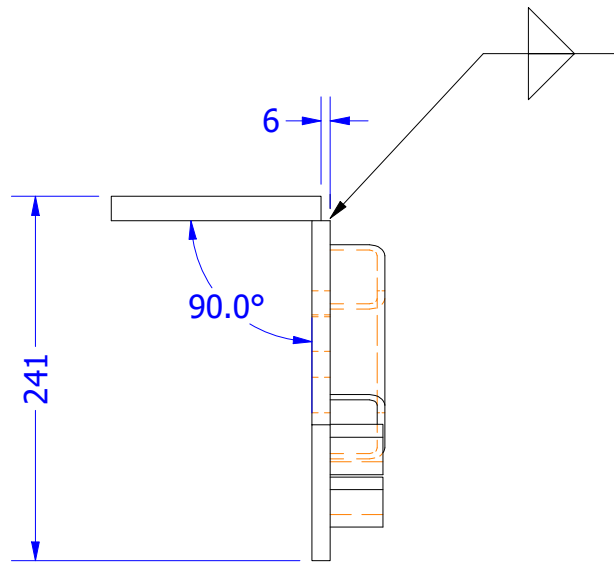

END VIEW  
SCALE 1:5

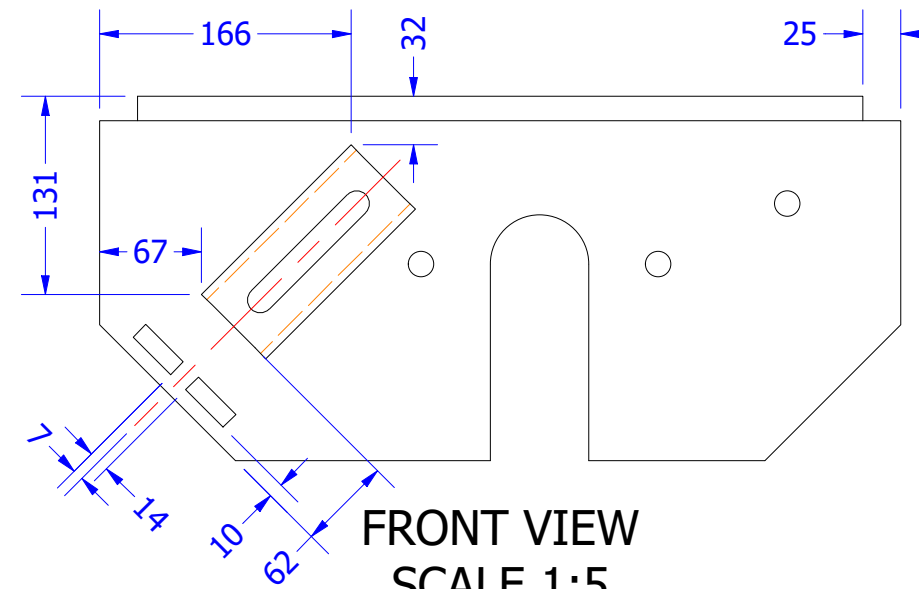

FRONT VIEW  
SCALE 1:5


- NOTES:
- ALL WELDING TO CONFORM TO AS1554-GP UNO
  - ALL FILLET WELDS TO BE 6mm CONTINUOUS UNO
  - ALL BUTT WELDS SHALL BE FULL STRENGTH, COMPLETE PENETRATION WELDS
  - ALL FLAME CUT SURFACES SHALL BE UNIFORM & CLEAN BEFORE WELDING
  - REMOVE ALL BURRS & SHARP EDGES
  - NON DESTRUCTIVE TESTING:
    - A) ALL WELDS, 100% VISUAL SCAN TO AS1554 PART 1
  - FINISH:
    - A) ALL STEELWORK TO BE PRIMED OR COLD GALV UNO

DRAWN BY ULTIMATE ENGINEERING PTY LTD Ph 8562 1511



THESE DRAWINGS ARE THE PROPERTY OF ULTIMATE ENGINEERING AND SHOULD NOT BE REPRODUCED OR COPIED IN ANY WAY WITHOUT WRITTEN PERMISSION FROM ULTIMATE ENGINEERING

PAINT TREATMENT:

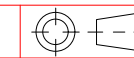

DIMENSION TOLERANCES	
DECIMAL	ANGULAR
X.X = ± .5 mm	X = ± 1°
X.XX = ± .25 mm	X.X = ± .5°
X.XXX = ± .125 mm	X.XX = ± .25°

MAXIMUM FINISHED SURFACE ROUGHNESS U.N.O. 1.6


PARENT ASSEMBLY	CUSTOMER: <b>RAB ENGINEERING</b>
DRAWN: David Bilney	TITLE: W1948-000-01 CHAIN CONVEYORS
DESIGNED: David Bilney	DWG NO: <b>194801/4</b>
DATE: 17/03/2021	JOB NO:
SCALE: Scale	SHEET: 4 OF 31
SHEET SIZE: A3	REV: 1




DO NOT SCALE DRAWING

4	P1948-000-03	Steel, Mild	SHEET 16	1
3	P1948-000-05	Steel, Mild	SHEET 18	2
2	P1948-000-04	Steel, Mild	SHEET 17	1
1	P1948-000-01	Steel, Mild	SHEET 14	1
ITEM	PART NUMBER	MATERIAL	COMMENTS	ITEM QTY


W1948-000-02 - 1 REQ'D AS DRAWN

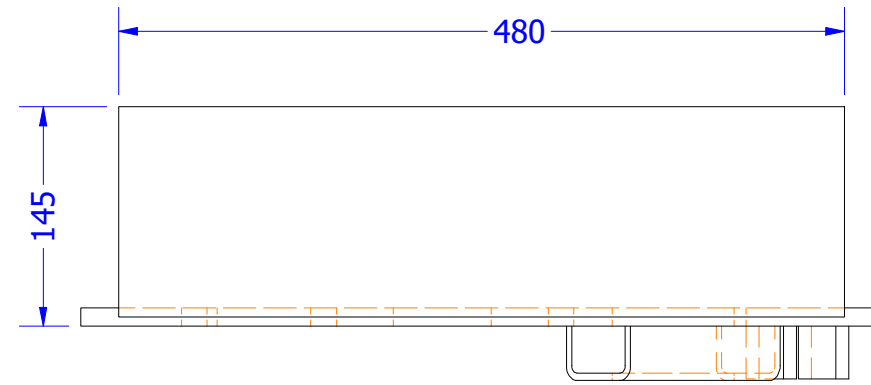


PLAN VIEW  
SCALE 1:5

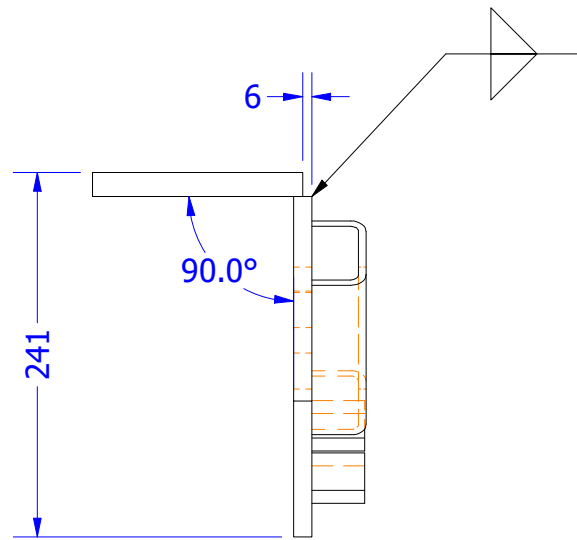

END VIEW  
SCALE 1:5

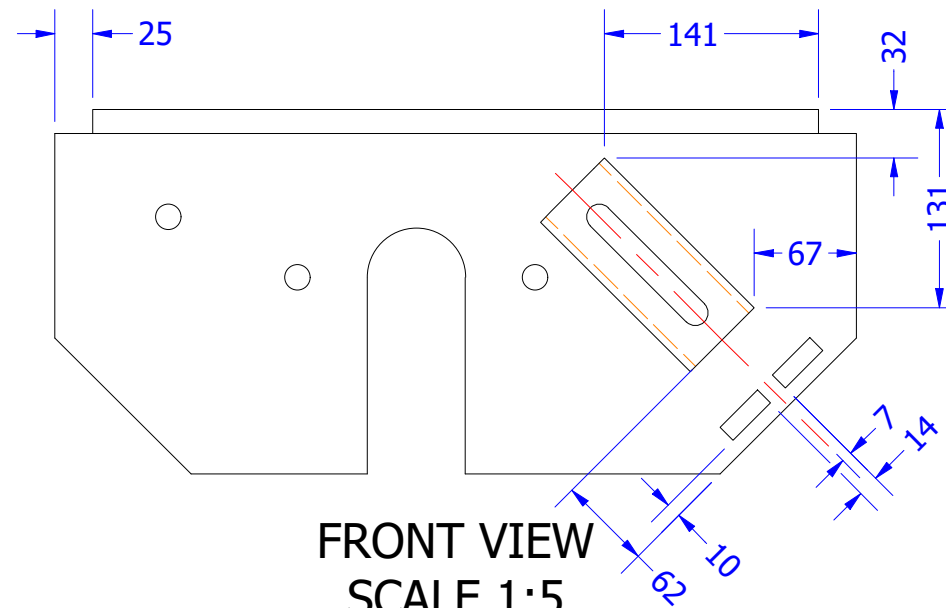

FRONT VIEW  
SCALE 1:5

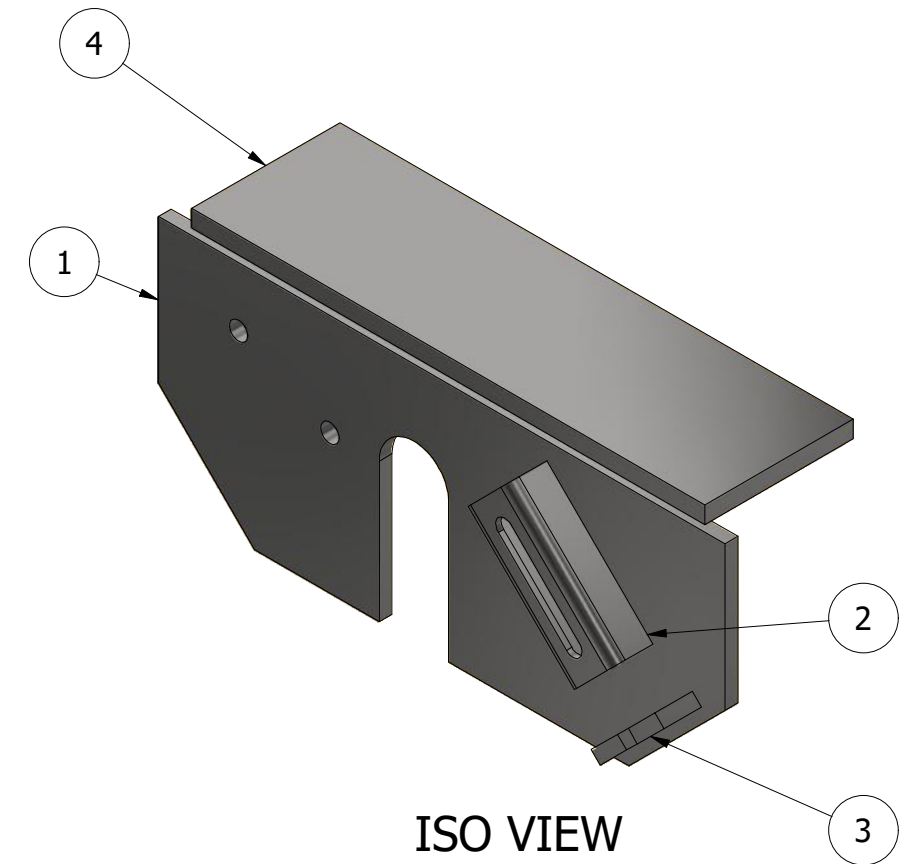

ISO VIEW  
SCALE 1:5

NOTES:

- ALL WELDING TO CONFORM TO AS1554-GP UNO
- ALL FILLET WELDS TO BE 6mm CONTINUOUS UNO
- ALL BUTT WELDS SHALL BE FULL STRENGTH, COMPLETE PENETRATION WELDS
- ALL FLAME CUT SURFACES SHALL BE UNIFORM & CLEAN BEFORE WELDING
- REMOVE ALL BURRS & SHARP EDGES
- NON DESTRUCTIVE TESTING:
  - ALL WELDS, 100% VISUAL SCAN TO AS1554 PART 1
- FINISH:
  - ALL STEELWORK TO BE PRIMED OR COLD GALV UNO

DRAWN BY ULTIMATE ENGINEERING PTY LTD Ph 8562 1511




THESE DRAWINGS ARE THE PROPERTY OF ULTIMATE ENGINEERING AND SHOULD NOT BE REPRODUCED OR COPIED IN ANY WAY WITHOUT WRITTEN PERMISSION FROM ULTIMATE ENGINEERING

PAINT TREATMENT:

DIMENSION TOLERANCES	
DECIMAL	ANGULAR
X.X = ± .5 mm	X = ± 1°
X.XX = ± .25 mm	X.X = ± .5°
X.XXX = ± .125 mm	X.XX = ± .25°

MAXIMUM FINISHED SURFACE ROUGHNESS U.N.O. 1.6

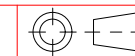

PARENT ASSEMBLY

CUSTOMER:

RAB ENGINEERING

DRAWN: David Bilney

TITLE:

W1948-000-02  
CHAIN CONVEYORS

DESIGNED: David Bilney

DWG NO:

194801/5

DATE: 17/03/2021

JOB NO:

SCALE: Scale

SHEET 5 OF 31


SHEET SIZE: A3

REV: 1


DO NOT SCALE DRAWING

5	65x8EA @ 604	Steel, Mild		1
4	65x8EA @ 1055	Steel, Mild		1
3	AS 1112 - M16	Steel, Mild	HEX NUT	2
2	P1948-000-08	Steel, Mild	SHEET 21	2
1	65x8EA @ 604	Steel, Mild		1
ITEM	PART NUMBER	MATERIAL	COMMENTS	ITEM QTY


W1948-002-01 - 1 REQ'D AS DRAWN

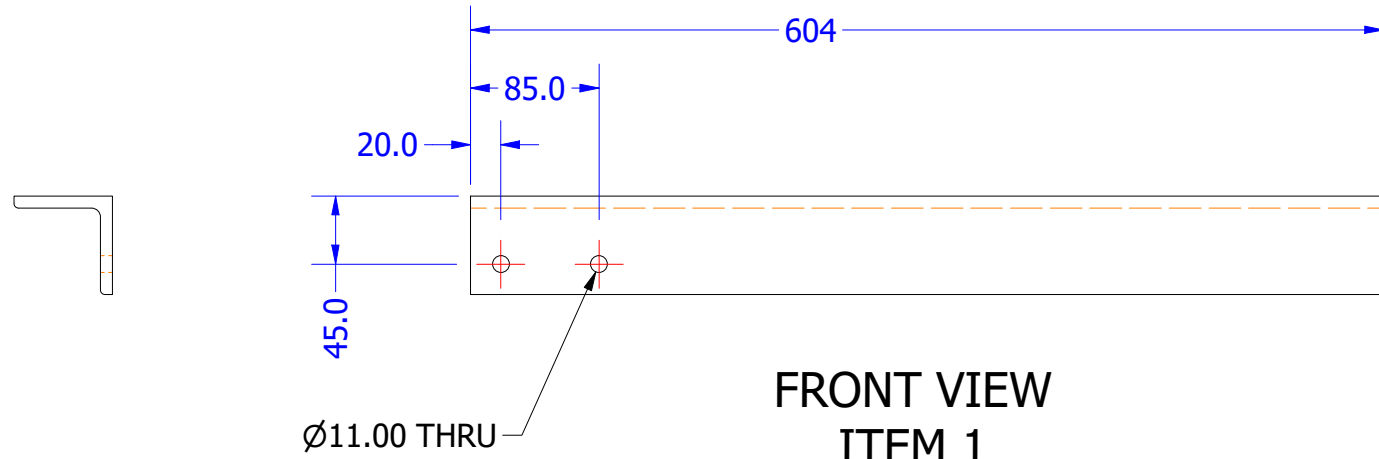


FRONT VIEW  
ITEM 1  
ITEM 5 OPPOSITE  
SCALE 1:5

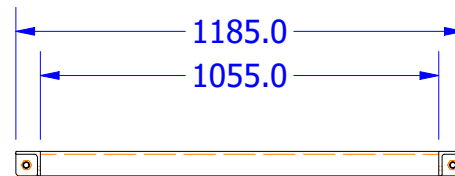


PLAN VIEW  
SCALE 1:20

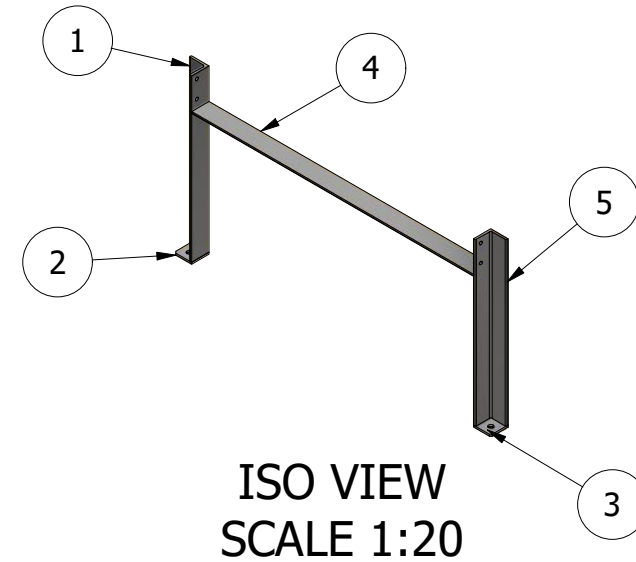

ISO VIEW  
SCALE 1:20

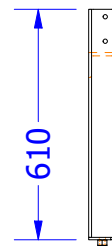

SIDE VIEW  
SCALE 1:20

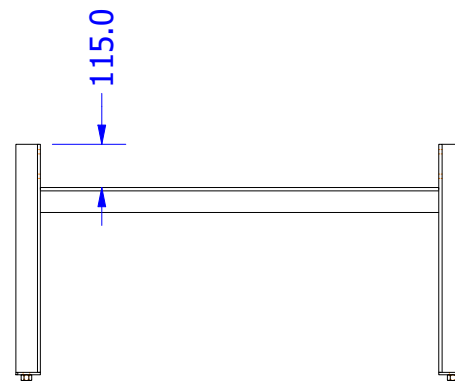

FRONT VIEW  
SCALE 1:20


- NOTES:
- ALL WELDING TO CONFORM TO AS1554-GP UNO
  - ALL FILLET WELDS TO BE 6mm CONTINUOUS UNO
  - ALL BUTT WELDS SHALL BE FULL STRENGTH, COMPLETE PENETRATION WELDS
  - ALL FLAME CUT SURFACES SHALL BE UNIFORM & CLEAN BEFORE WELDING
  - REMOVE ALL BURRS & SHARP EDGES
  - NON DESTRUCTIVE TESTING:  
A) ALL WELDS, 100% VISUAL SCAN TO AS1554 PART 1
  - FINISH:  
A) ALL STEELWORK TO BE PRIMED OR COLD GALV UNO

DRAWN BY ULTIMATE ENGINEERING PTY LTD Ph 8562 1511



THESE DRAWINGS ARE THE PROPERTY OF ULTIMATE ENGINEERING AND SHOULD NOT BE REPRODUCED OR COPIED IN ANY WAY WITHOUT WRITTEN PERMISSION FROM ULTIMATE ENGINEERING

PAINT TREATMENT: GREY

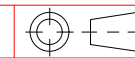

DIMENSION TOLERANCES	
DECIMAL	ANGULAR
X.X = ± .5 mm	X = ± 1°
X.XX = ± .25 mm	X.X = ± .5°
X.XXX = ± .125 mm	X.XX = ± .25°






MAXIMUM FINISHED SURFACE ROUGHNESS U.N.O. 1.6

PARENT ASSEMBLY	CUSTOMER: <b>RAB ENGINEERING</b>
DRAWN: David Bilney	TITLE: W1948-002-01 CHAIN CONVEYORS
DESIGNED: David Bilney	DWG NO: <b>194802</b>
DATE: 17/03/2021	JOB NO:
SCALE: Scale	SHEET: 6 OF 31
SHEET SIZE: A3	REV: 1

DO NOT SCALE DRAWING

2	50x3 EA @ 50	Steel, Mild		2
1	P1948-000-16	Steel, Mild	SHEET 28	1
ITEM	PART NUMBER	MATERIAL	COMMENTS	ITEM QTY

W1948-000-04 - 1 REQ'D AS DRAWN

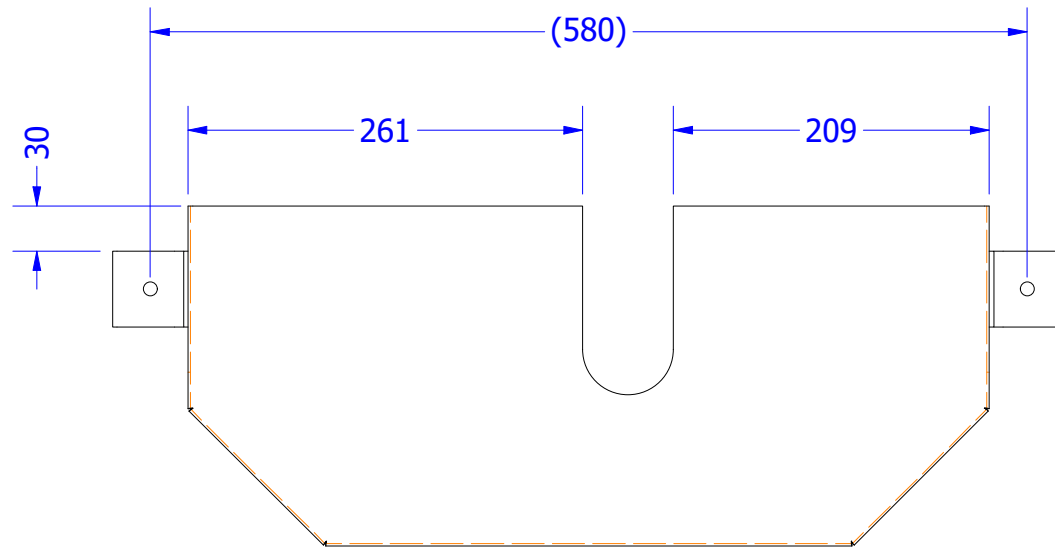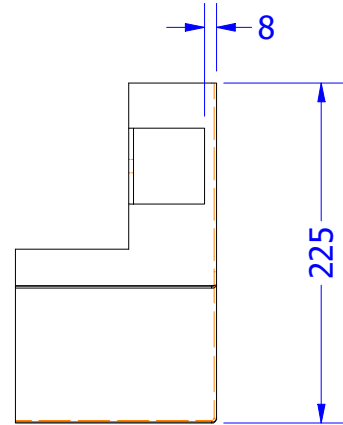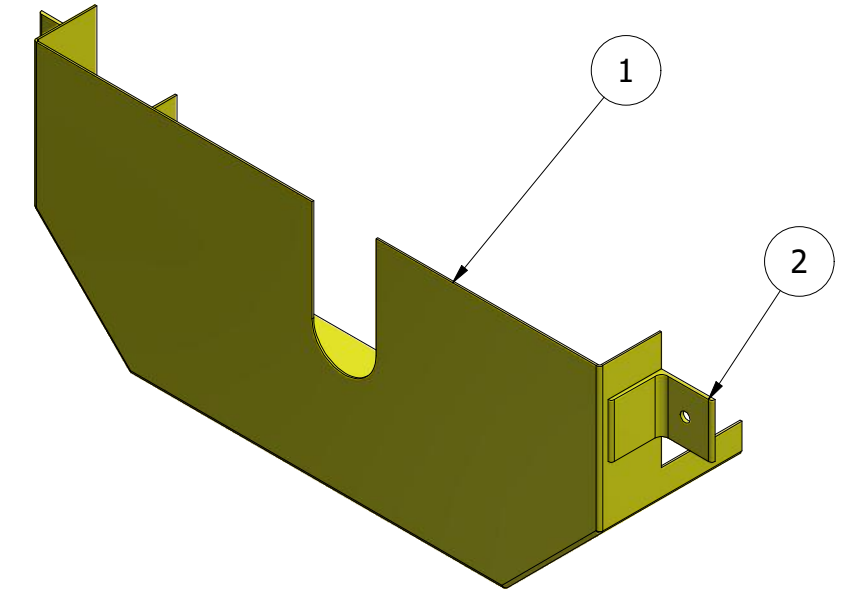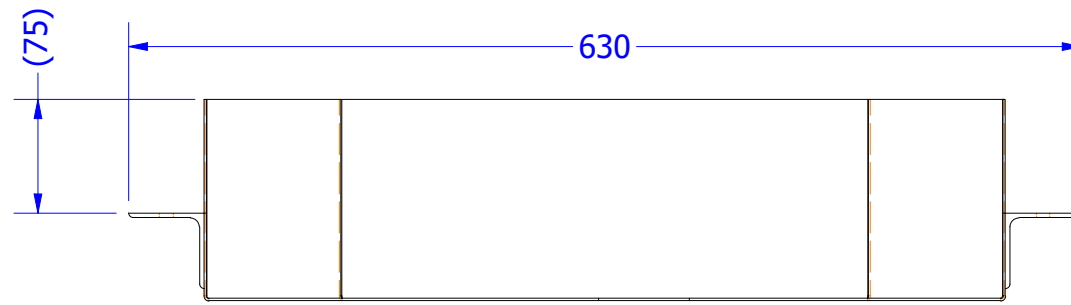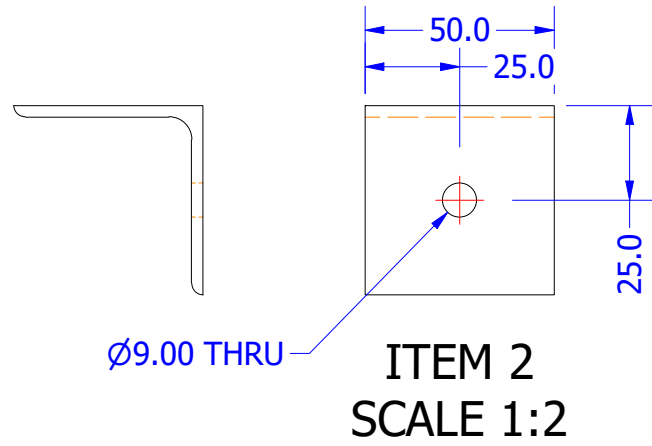

NOTES:


- ALL WELDING TO CONFORM TO AS1554-GP UNO
- ALL FILLET WELDS TO BE 6mm CONTINUOUS UNO
- ALL BUTT WELDS SHALL BE FULL STRENGTH, COMPLETE PENETRATION WELDS
- ALL FLAME CUT SURFACES SHALL BE UNIFORM & CLEAN BEFORE WELDING
- REMOVE ALL BURRS & SHARP EDGES
- NON DESTRUCTIVE TESTING:
  - ALL WELDS, 100% VISUAL SCAN TO AS1554 PART 1
- FINISH:
  - ALL STEELWORK TO BE PRIMED OR COLD GALV UNO

DRAWN BY ULTIMATE ENGINEERING PTY LTD Ph 8562 1511



THESE DRAWINGS ARE THE PROPERTY OF ULTIMATE ENGINEERING AND SHOULD NOT BE REPRODUCED OR COPIED IN ANY WAY WITHOUT WRITTEN PERMISSION FROM ULTIMATE ENGINEERING

PAINT TREATMENT: YELLOW

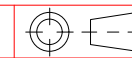

DIMENSION TOLERANCES	
DECIMAL	ANGULAR
X.X = ± .5 mm	X = ± 1°
X.XX = ± .25 mm	X.X = ± .5°
X.XXX = ± .125 mm	X.XX = ± .25°






MAXIMUM FINISHED SURFACE ROUGHNESS U.N.O. 1.6

PARENT ASSEMBLY	CUSTOMER: <b>RAB ENGINEERING</b>
DRAWN: David Bilney	TITLE: W1948-000-04 CHAIN CONVEYORS
DESIGNED: David Bilney	DWG NO: <b>194801/7</b>
DATE: 17/03/2021	JOB NO:
SCALE: Scale	SHEET: 7 OF 31
	SHEET SIZE: A3
	REV: 1

DO NOT SCALE DRAWING

2	50x3 EA @ 50	Steel, Mild		2
1	P1948-000-17	Steel, Mild	SHEET 28	1
ITEM	PART NUMBER	MATERIAL	COMMENTS	ITEM QTY

W1948-000-05 - 1 REQ'D AS DRAWN

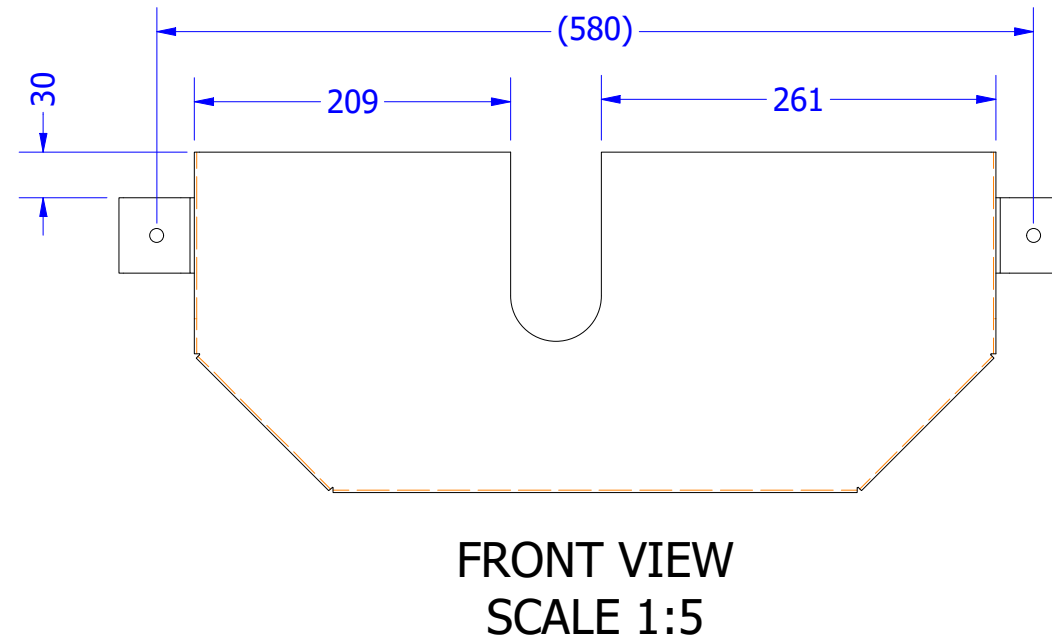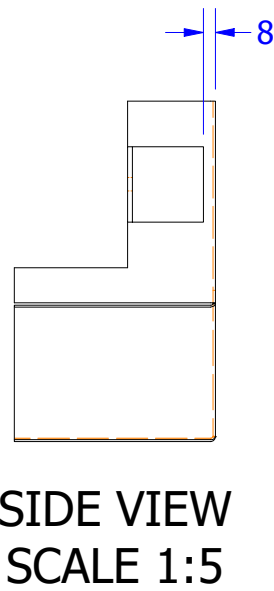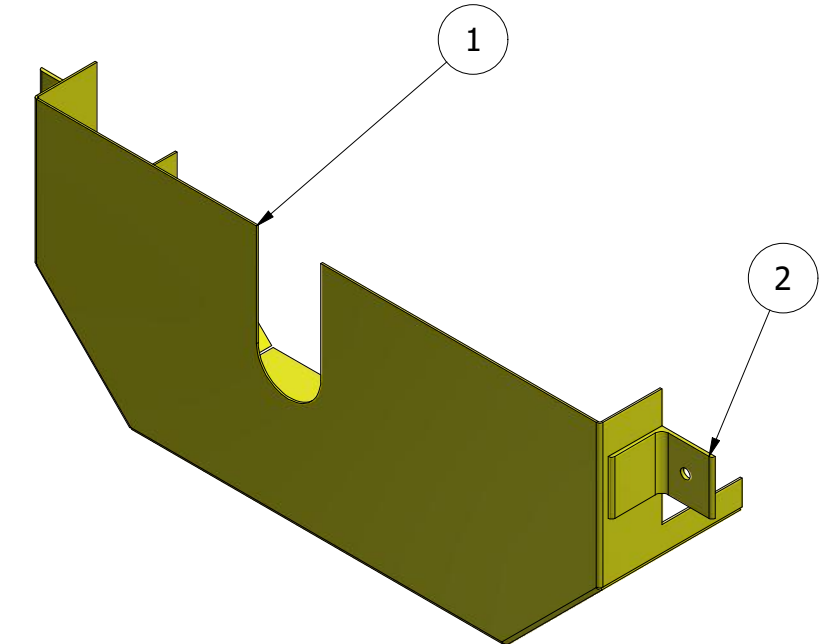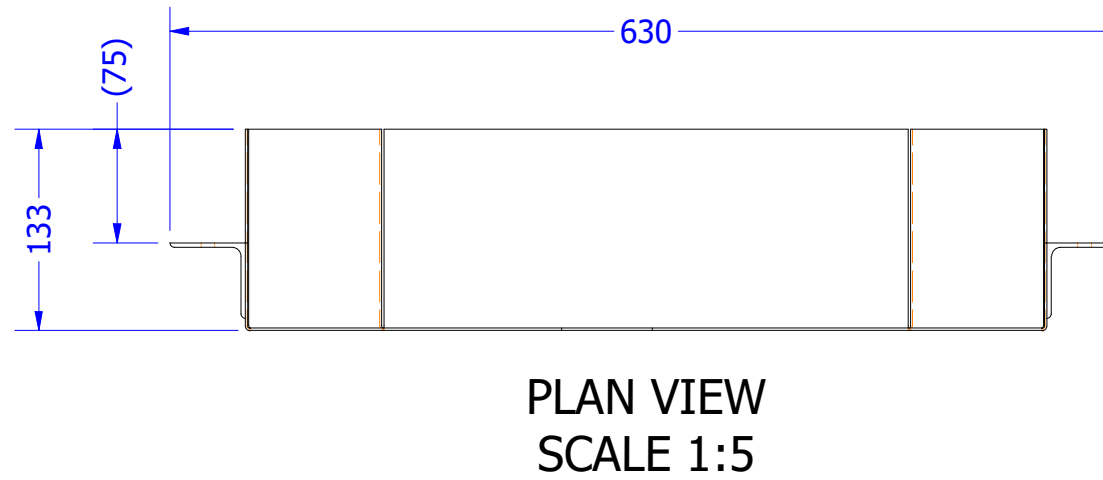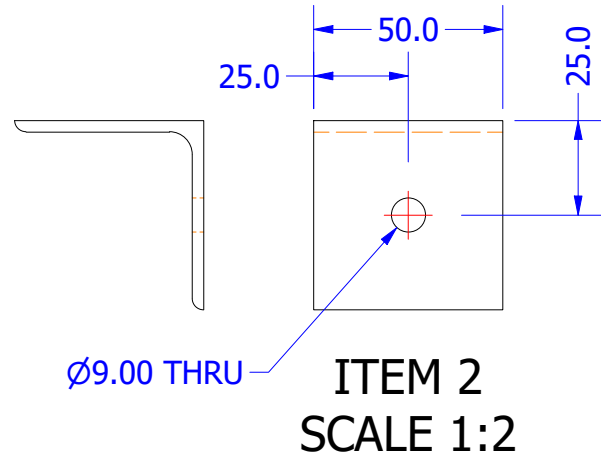


- NOTES:
- ALL WELDING TO CONFORM TO AS1554-GP UNO
  - ALL FILLET WELDS TO BE 6mm CONTINUOUS UNO
  - ALL BUTT WELDS SHALL BE FULL STRENGTH, COMPLETE PENETRATION WELDS
  - ALL FLAME CUT SURFACES SHALL BE UNIFORM & CLEAN BEFORE WELDING
  - REMOVE ALL BURRS & SHARP EDGES
  - NON DESTRUCTIVE TESTING:
    - A) ALL WELDS, 100% VISUAL SCAN TO AS1554 PART 1
  - FINISH:
    - A) ALL STEELWORK TO BE PRIMED OR COLD GALV UNO

DRAWN BY ULTIMATE ENGINEERING PTY LTD Ph 8562 1511



THESE DRAWINGS ARE THE PROPERTY OF ULTIMATE ENGINEERING AND SHOULD NOT BE REPRODUCED OR COPIED IN ANY WAY WITHOUT WRITTEN PERMISSION FROM ULTIMATE ENGINEERING

PAINT TREATMENT: YELLOW

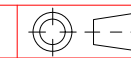

DIMENSION TOLERANCES	
DECIMAL	ANGULAR
X.X = ± .5 mm	X = ± 1°
X.XX = ± .25 mm	X.X = ± .5°
X.XXX = ± .125 mm	X.XX = ± .25°


MAXIMUM FINISHED SURFACE ROUGHNESS U.N.O. 1.6

PARENT ASSEMBLY	CUSTOMER: <b>RAB ENGINEERING</b>
DRAWN: David Bilney	TITLE: W1948-000-05 CHAIN CONVEYORS
DESIGNED: David Bilney	DWG NO: <b>194801/8</b>
DATE: 17/03/2021	JOB NO:
SCALE: Scale	SHEET: 8 OF 31
SHEET SIZE: A3	REV: 1


DO NOT SCALE DRAWING

9	125x75x5.0 RHS @ 1820	Steel, Mild		1
8	125x75x5.0 RHS @ 920	Steel, Mild		1
7	50x8 EA @ 175	Steel, Mild		1
6	50x6 EA @ 50	Steel, Mild		3
5	P1948-000-13	Steel, Mild	SHEET 26	1
4	P1948-000-07	Steel, Mild	SHEET 20	1
3	P1948-000-06	Steel, Mild	SHEET 19	3
2	W1948-000-01	Weldment	SHEET 4	1
1	P1948-000-02	Steel, Mild	SHEET 15	4
ITEM	PART NUMBER	MATERIAL	COMMENTS	ITEM QTY


W1948-002-02 - 1 REQ'D AS DRAWN

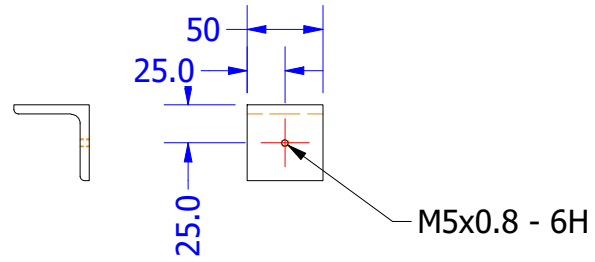


ITEM 8  
SCALE 1:5

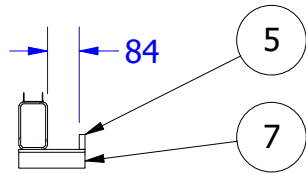


SECTION A-A  
SCALE 1:20

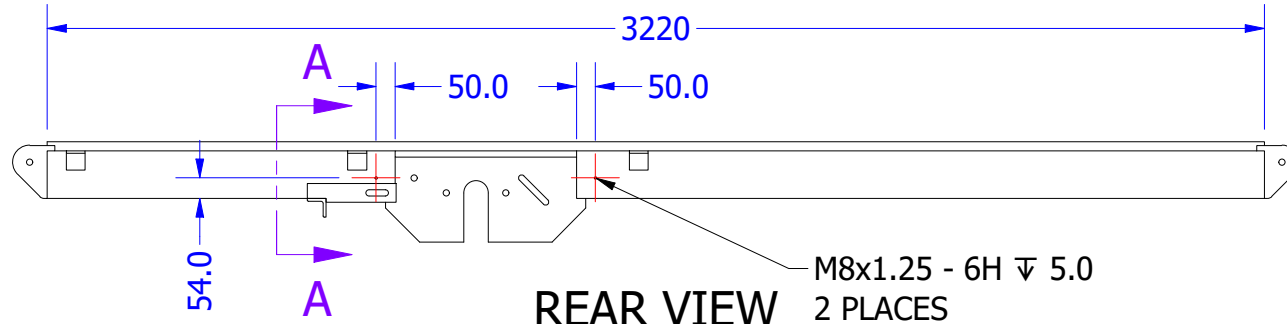


REAR VIEW  
SCALE 1:20

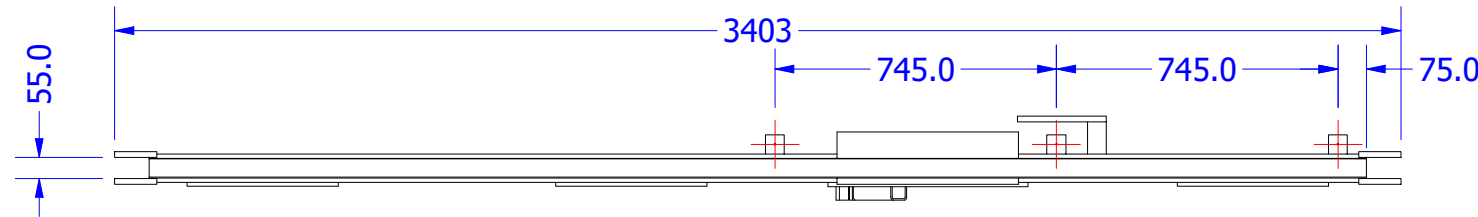


PLAN VIEW  
SCALE 1:20

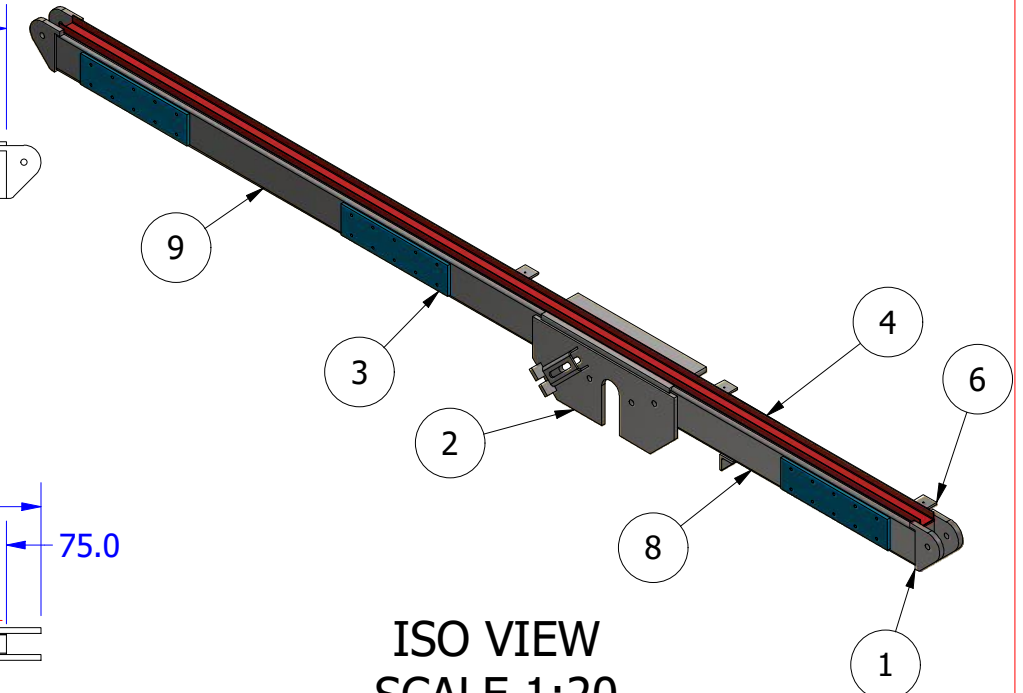

ISO VIEW  
SCALE 1:20

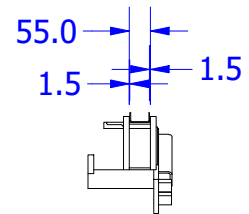

END VIEW  
SCALE 1:20

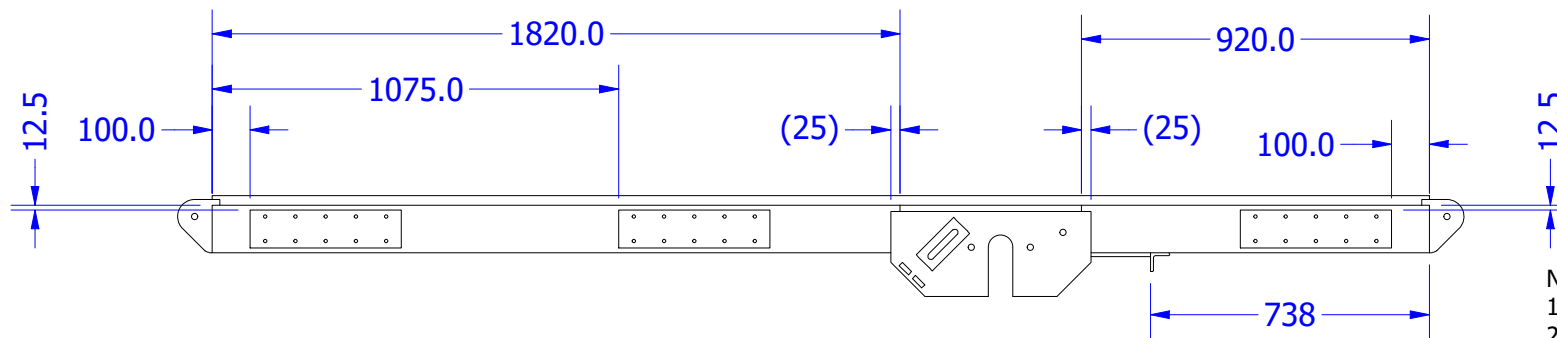

FRONT VIEW  
SCALE 1:20


- NOTES:
- ALL WELDING TO CONFORM TO AS1554-GP UNO
  - ALL FILLET WELDS TO BE 6mm CONTINUOUS UNO
  - ALL BUTT WELDS SHALL BE FULL STRENGTH, COMPLETE PENETRATION WELDS
  - ALL FLAME CUT SURFACES SHALL BE UNIFORM & CLEAN BEFORE WELDING
  - REMOVE ALL BURRS & SHARP EDGES
  - NON DESTRUCTIVE TESTING:
    - A) ALL WELDS, 100% VISUAL SCAN TO AS1554 PART 1
  - FINISH:
    - A) ALL STEELWORK TO BE PRIMED OR COLD GALV UNO

DRAWN BY ULTIMATE ENGINEERING PTY LTD Ph 8562 1511



THESE DRAWINGS ARE THE PROPERTY OF ULTIMATE ENGINEERING AND SHOULD NOT BE REPRODUCED OR COPIED IN ANY WAY WITHOUT WRITTEN PERMISSION FROM ULTIMATE ENGINEERING

PAINT TREATMENT: GREY

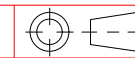

DIMENSION TOLERANCES	
DECIMAL	ANGULAR
X.X = ± .5 mm	X = ± 1°
X.XX = ± .25 mm	X.X = ± .5°
X.XXX = ± .125 mm	X.XX = ± .25°
MAXIMUM FINISHED SURFACE ROUGHNESS U.N.O. 1.6	


PARENT ASSEMBLY	CUSTOMER: <b>RAB ENGINEERING</b>
DRAWN: David Bilney	TITLE: W1948-002-02 CHAIN CONVEYORS
DESIGNED: David Bilney	DWG NO: <b>194802</b>
DATE: 17/03/2021	JOB NO:
SCALE: Scale	SHEET: 9 OF 31
	SHEET SIZE: A3
	REV: 1




DO NOT SCALE DRAWING

9	125x75x5.0 RHS @ 920	Steel, Mild		1
8	125x75x5.0 RHS @ 1820	Steel, Mild		1
7	50x6 EA @ 50	Steel, Mild	REFER SHEET 9	3
6	P1948-000-07	Steel, Mild	SHEET 20	1
5	P1948-000-06	Steel, Mild	SHEET 19	3
3	W1948-000-02	Weldment	SHEET 5	1
1	P1948-000-02	Steel, Mild	SHEET 15	4
ITEM	PART NUMBER	MATERIAL	COMMENTS	ITEM QTY


W1948-002-03 - 1 REQ'D AS DRAWN

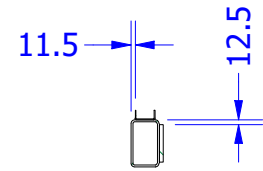


SECTION B-B  
SCALE 1:20

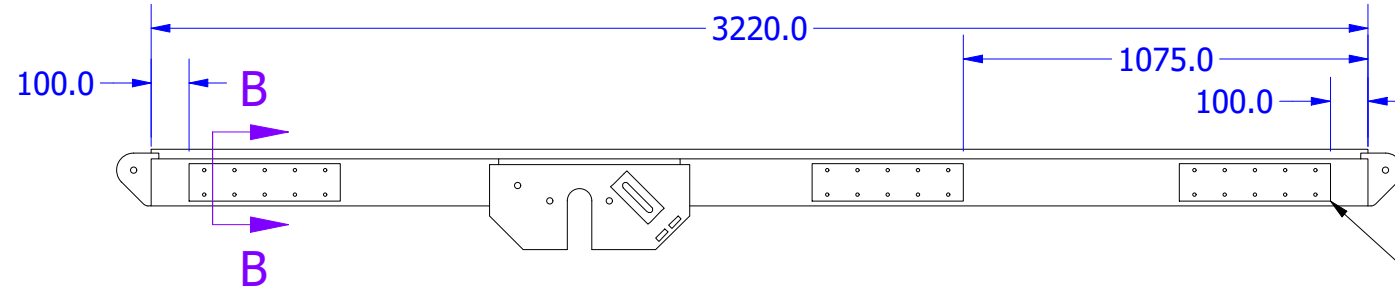


FRONT VIEW  
SCALE 1:20

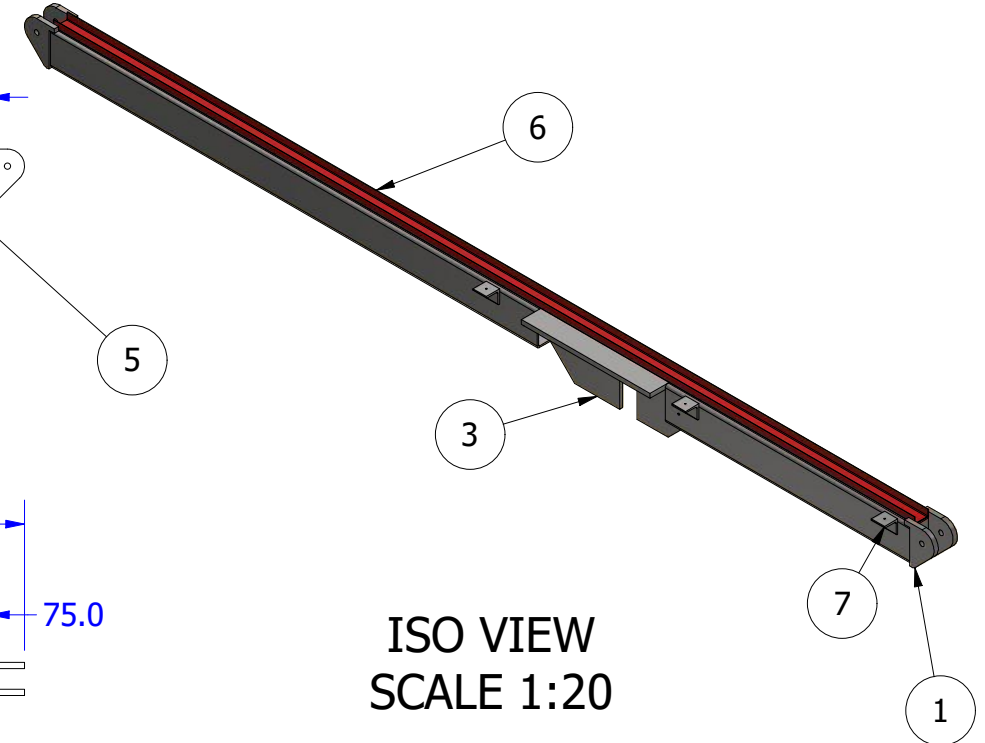


ISO VIEW  
SCALE 1:20

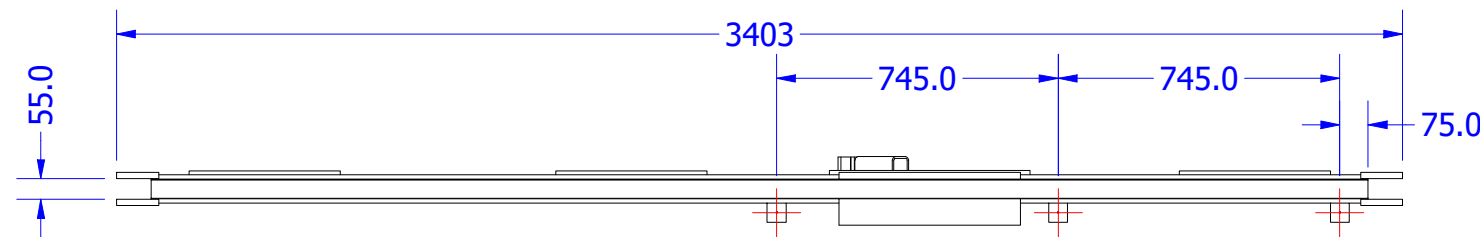

PLAN VIEW  
SCALE 1:20

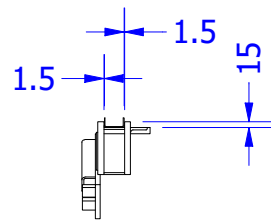

END VIEW  
SCALE 1:20

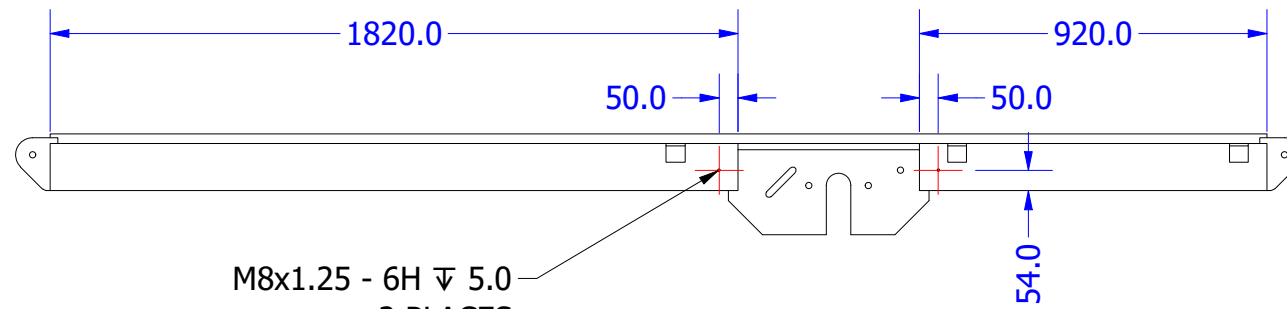

REAR VIEW  
SCALE 1:20

NOTES:


- ALL WELDING TO CONFORM TO AS1554-GP UNO
- ALL FILLET WELDS TO BE 6mm CONTINUOUS UNO
- ALL BUTT WELDS SHALL BE FULL STRENGTH, COMPLETE PENETRATION WELDS
- ALL FLAME CUT SURFACES SHALL BE UNIFORM & CLEAN BEFORE WELDING
- REMOVE ALL BURRS & SHARP EDGES
- NON DESTRUCTIVE TESTING:
  - A) ALL WELDS, 100% VISUAL SCAN TO AS1554 PART 1
- FINISH:
  - A) ALL STEELWORK TO BE PRIMED OR COLD GALV UNO

DRAWN BY ULTIMATE ENGINEERING PTY LTD Ph 8562 1511



THESE DRAWINGS ARE THE PROPERTY OF ULTIMATE ENGINEERING AND SHOULD NOT BE REPRODUCED OR COPIED IN ANY WAY WITHOUT WRITTEN PERMISSION FROM ULTIMATE ENGINEERING

PAINT TREATMENT: GREY

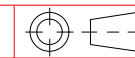

DIMENSION TOLERANCES	
DECIMAL	ANGULAR
X.X = ± .5 mm	X = ± 1°
X.XX = ± .25 mm	X.X = ± .5°
X.XXX = ± .125 mm	X.XX = ± .25°

MAXIMUM FINISHED SURFACE ROUGHNESS U.N.O. 1.6

PARENT ASSEMBLY

CUSTOMER: **RAB ENGINEERING**

DRAWN: David Bilney

TITLE: W1948-002-03  
CHAIN CONVEYORS

DESIGNED: David Bilney

DWG NO: **194802**

DATE: 17/03/2021

JOB NO:


SCALE: Scale 10 OF 31 SHEET SIZE: A3 REV: 1




DO NOT SCALE DRAWING

2	50x5 EA @ 775	Aluminum 6061		1
1	P1948-003-02	Aluminum 5052	SHEET 13	1
ITEM	PART NUMBER	MATERIAL	COMMENTS	ITEM QTY


W1948-002-04 - 1 REQ'D AS DRAWN

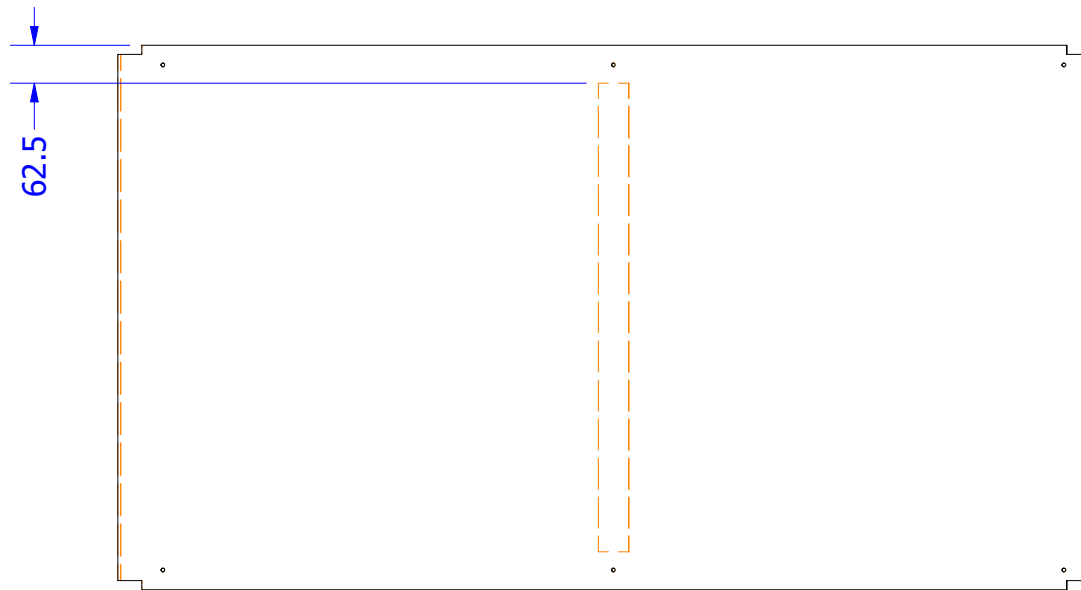

PLAN VIEW  
SCALE 1:12.5

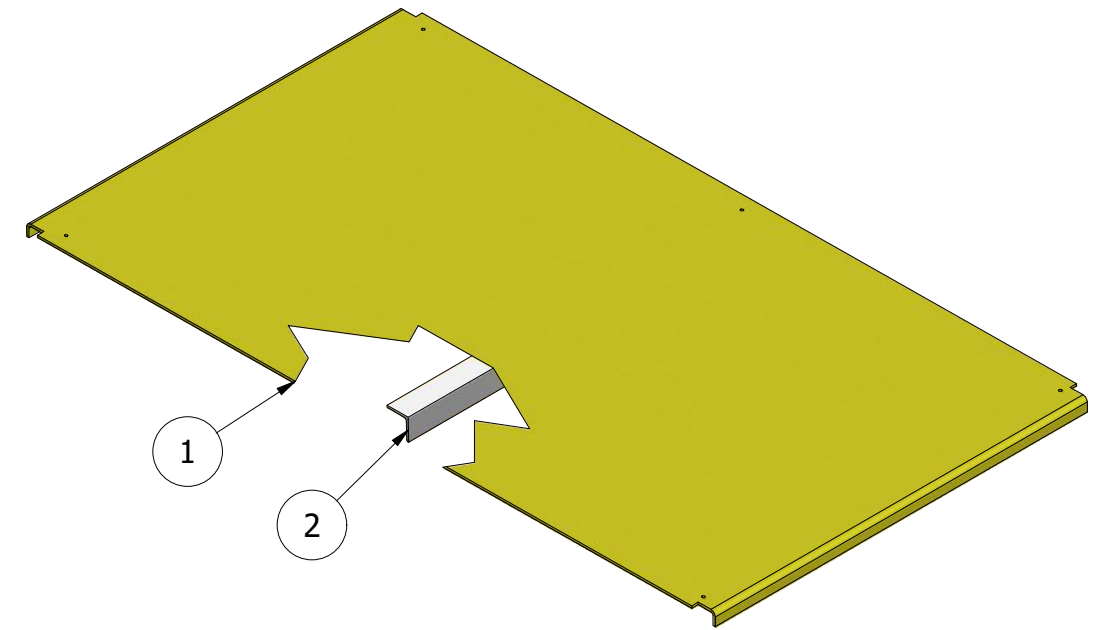

ISO VIEW  
SCALE 1:12.5

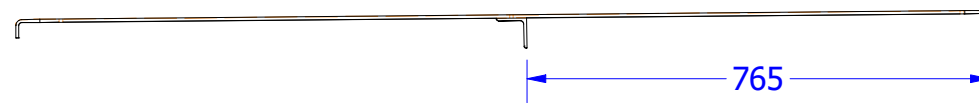

FRONT VIEW  
SCALE 1:12.5

NOTES:

1. ALL WELDING TO CONFORM TO AS1554-GP UNO
2. ALL FILLET WELDS TO BE 6mm CONTINUOUS UNO
3. ALL BUTT WELDS SHALL BE FULL STRENGTH, COMPLETE PENETRATION WELDS
4. ALL FLAME CUT SURFACES SHALL BE UNIFORM & CLEAN BEFORE WELDING
5. REMOVE ALL BURRS & SHARP EDGES
6. NON DESTRUCTIVE TESTING:
  - A) ALL WELDS, 100% VISUAL SCAN TO AS1554 PART 1
7. FINISH:
  - A) ALL STEELWORK TO BE PRIMED OR COLD GALV UNO

DRAWN BY ULTIMATE ENGINEERING PTY LTD Ph 8562 1511



THESE DRAWINGS ARE THE PROPERTY OF ULTIMATE ENGINEERING AND SHOULD NOT BE REPRODUCED OR COPIED IN ANY WAY WITHOUT WRITTEN PERMISSION FROM ULTIMATE ENGINEERING

PAINT TREATMENT: YELLOW



DIMENSION TOLERANCES	
DECIMAL	ANGULAR
X.X = ± .5 mm	X = ± 1°
X.XX = ± .25 mm	X.X = ± .5°
X.XXX = ± .125 mm	X.XX = ± .25°

MAXIMUM FINISHED SURFACE ROUGHNESS U.N.O. 1.6

PARENT ASSEMBLY

CUSTOMER: **RAB ENGINEERING**

DRAWN: David Bilney

TITLE: W1948-002-04  
CHAIN CONVEYORS

DESIGNED: David Bilney

DWG NO: **194802**

DATE: 17/03/2021


JOB NO:

SCALE: Scale	SHEET 11 OF 31	SHEET SIZE: A3	REV: 1
--------------	----------------	----------------	--------


DO NOT SCALE DRAWING

40 RND BAR @ 1165	Steel	AS1444-1996 4140
DESCRIPTION	MATERIAL	COMMENTS

P1948-002-01 - 1 REQ'D AS DRAWN

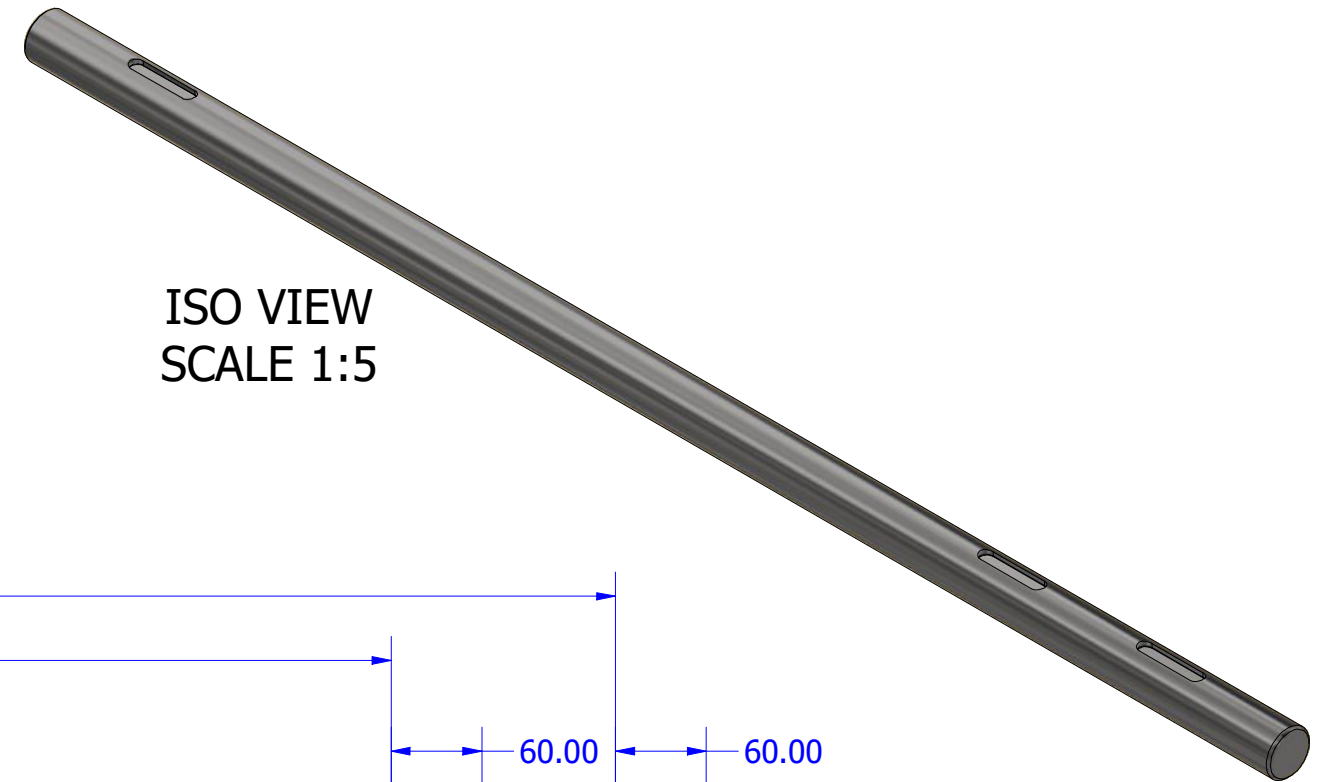

ISO VIEW  
SCALE 1:5

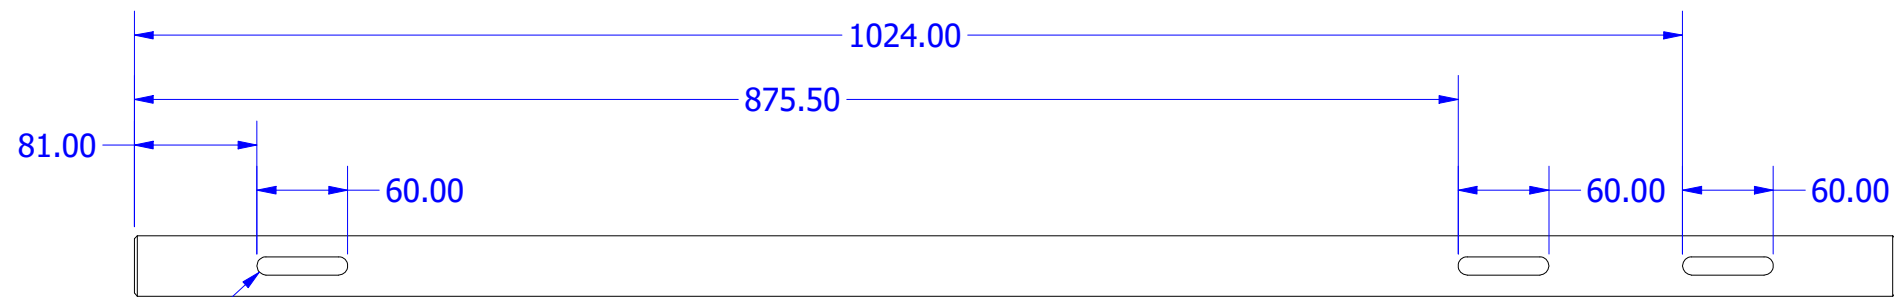


R6.00

2.00 X 45.0° CHAMFER

1165.0

2.00 X 45.0° CHAMFER

Ø40.00

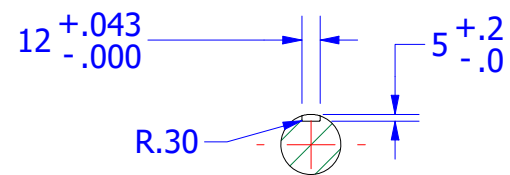


SECTION C-C  
SCALE 1:5

REMOVE ALL BURRS & SHARP EDGES



THESE DRAWINGS ARE THE PROPERTY OF ULTIMATE ENGINEERING AND SHOULD NOT BE REPRODUCED OR COPIED IN ANY WAY WITHOUT WRITTEN PERMISSION FROM ULTIMATE ENGINEERING

PAINT TREATMENT:

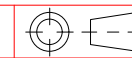

PARENT ASSEMBLY

CUSTOMER:

RAB ENGINEERING

DIMENSION TOLERANCES

DECIMAL		ANGULAR	
X.X	= ± .5 mm	X	= ± 1°
X.XX	= ± .25 mm	X.X	= ± .5°
X.XXX	= ± .125 mm	X.XX	= ± .25°

DRAWN: David Bilney

TITLE:

P1948-002-01  
CHAIN CONVEYORS

DESIGNED: David Bilney

DWG NO:

194802

MAXIMUM FINISHED SURFACE ROUGHNESS U.N.O. 1.6

DATE: 17/03/2021


JOB NO:

SCALE: Scale	SHEET 12 OF 31	SHEET SIZE: A3	REV: 1
-----------------	-------------------	-------------------	-----------


DO NOT SCALE DRAWING

5mm PLATE @ 1653 X 900	Aluminum 5052	AS1734
DESCRIPTION	MATERIAL	COMMENTS


P1948-003-02 - 1 REQ'D AS DRAWN

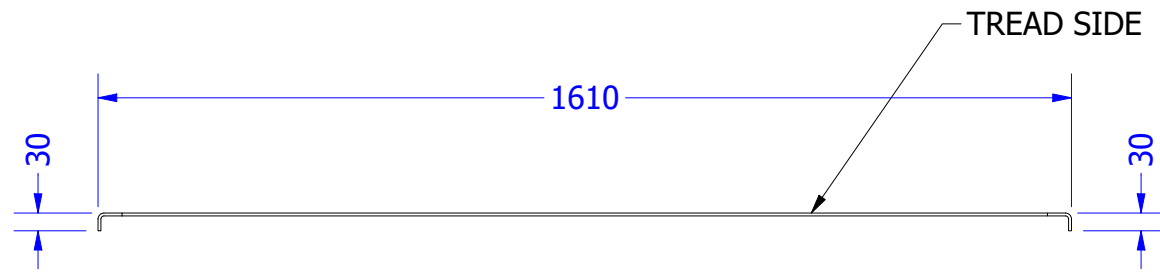


FRONT VIEW - FOLDED  
SCALE 1:12.5

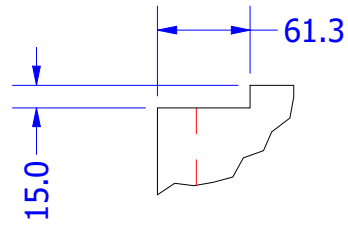

DETAIL D  
TYPICAL CUTOUT  
SCALE 1:5

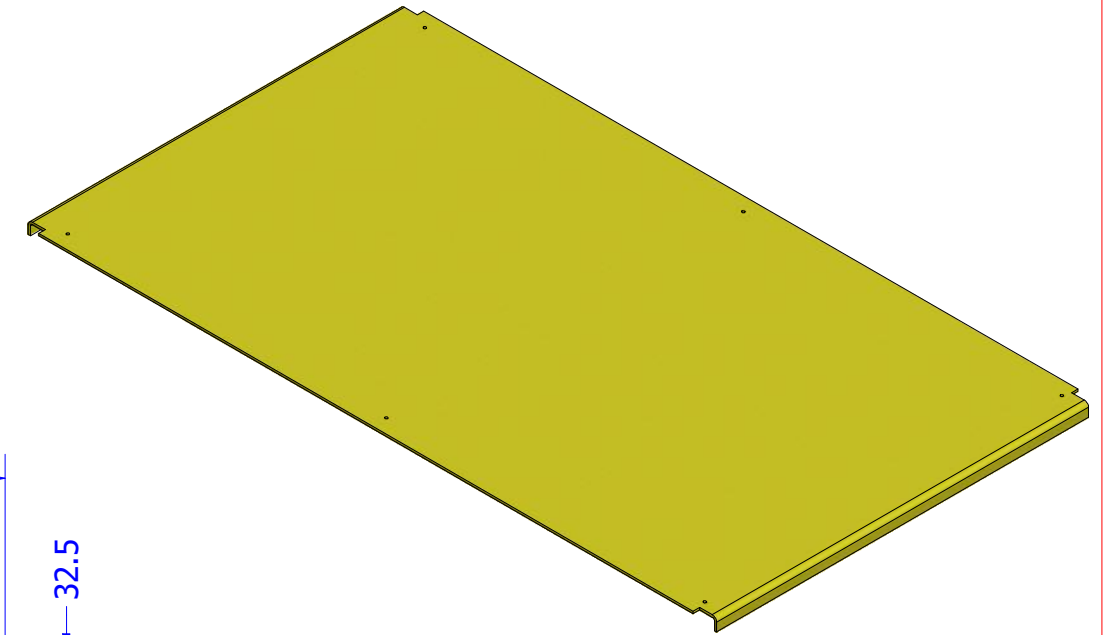

ISO VIEW  
SCALE 1:12.5

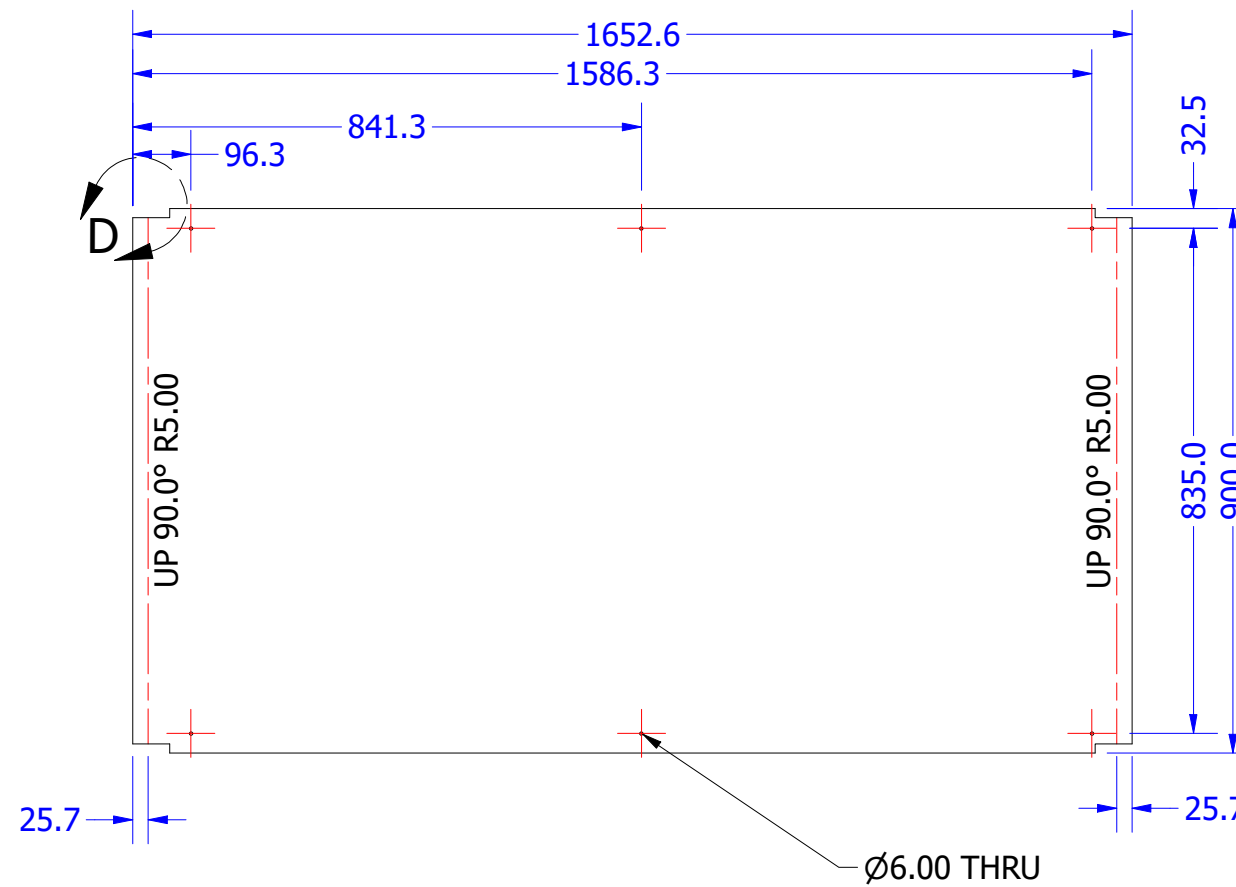

FLAT PATTERN  
TREAD SIDE DOWN  
SCALE 1:12.5

REMOVE ALL BURRS & SHARP EDGES



THESE DRAWINGS ARE THE PROPERTY OF ULTIMATE ENGINEERING AND SHOULD NOT BE REPRODUCED OR COPIED IN ANY WAY WITHOUT WRITTEN PERMISSION FROM ULTIMATE ENGINEERING

PAINT TREATMENT:



DIMENSION TOLERANCES	
DECIMAL	ANGULAR
X.X = ± .5 mm	X = ± 1°
X.XX = ± .25 mm	X.X = ± .5°
X.XXX = ± .125 mm	X.XX = ± .25°

MAXIMUM FINISHED SURFACE ROUGHNESS U.N.O. 1.6

PARENT ASSEMBLY

CUSTOMER: **RAB ENGINEERING**

DRAWN: David Bilney

TITLE: P1948-003-02  
CHAIN CONVEYORS

DESIGNED: David Bilney

DWG NO: **194802**

DATE: 17/03/2021


JOB NO:	SCALE: Scale	SHEET 13 OF 31	SHEET SIZE: A3	REV: 1
---------	--------------	----------------	----------------	--------

DRAWN BY ULTIMATE ENGINEERING PTY LTD Ph 8562 1511

DO NOT SCALE DRAWING

12mm PLATE @ 530 X 225	Steel, Mild	AS3678 - GR250
DESCRIPTION	MATERIAL	COMMENTS

P1948-000-01 - 2 REQ'D AS DRAWN

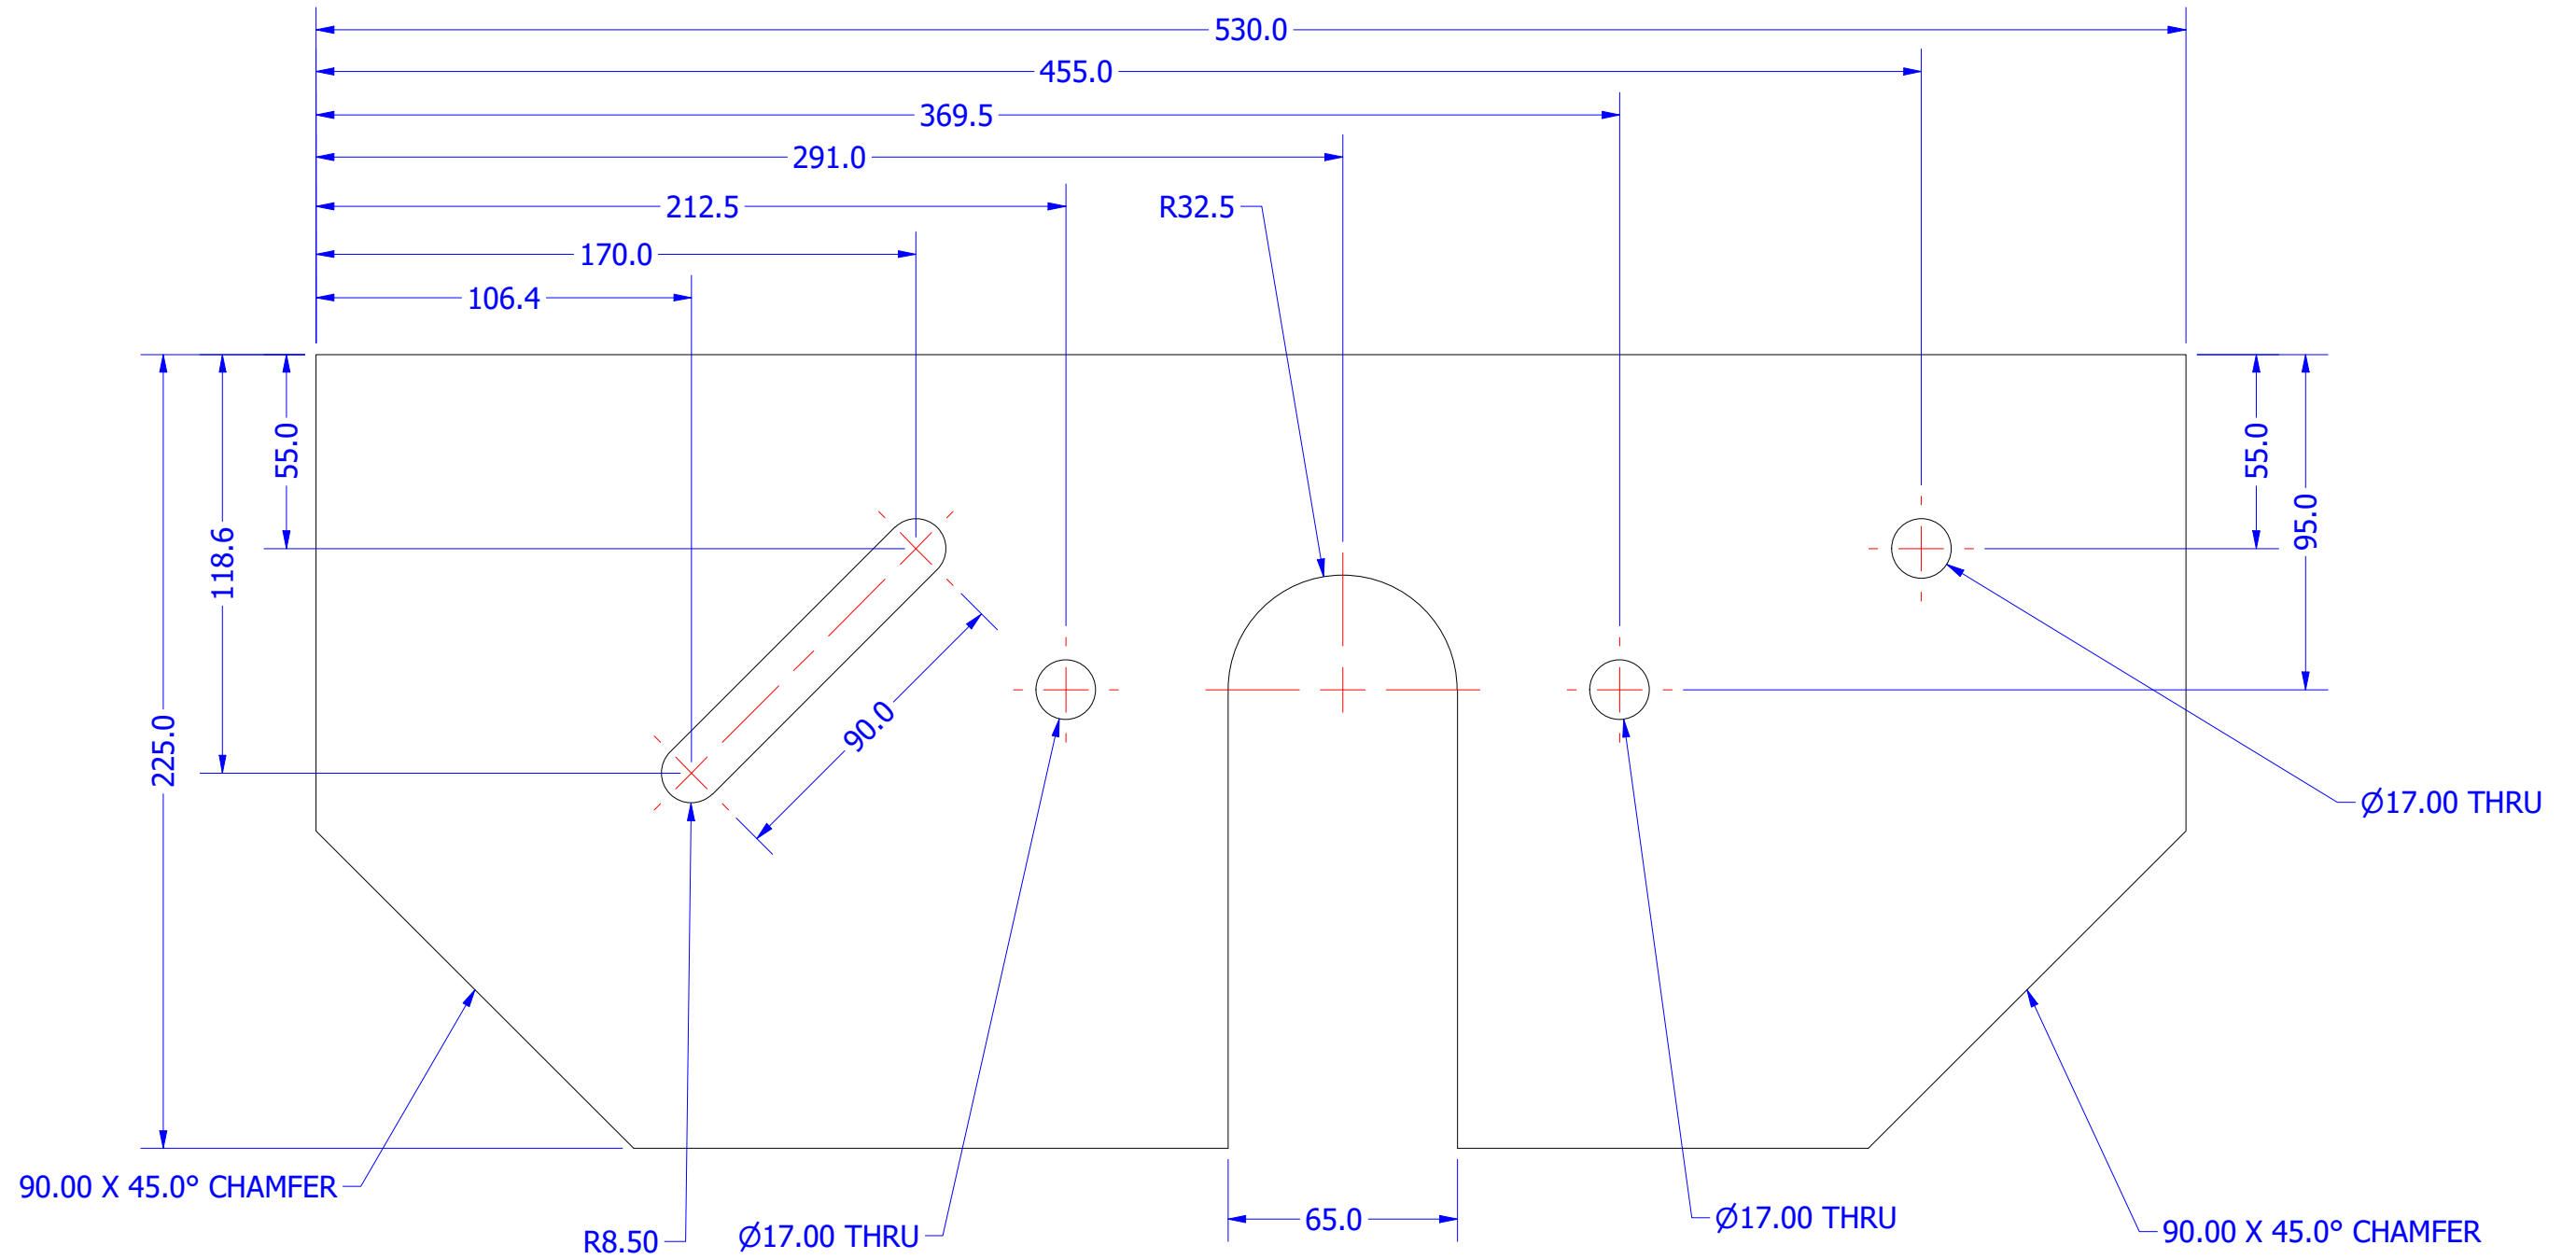


FRONT VIEW  
SCALE 1:2

REMOVE ALL BURRS & SHARP EDGES



THESE DRAWINGS ARE THE PROPERTY OF ULTIMATE ENGINEERING AND SHOULD NOT BE REPRODUCED OR COPIED IN ANY WAY WITHOUT WRITTEN PERMISSION FROM ULTIMATE ENGINEERING

PAINT TREATMENT:

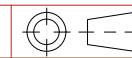

DIMENSION TOLERANCES	
DECIMAL	ANGULAR
X.X = ± .5 mm	X = ± 1°
X.XX = ± .25 mm	X.X = ± .5°
X.XXX = ± .125 mm	X.XX = ± .25°

MAXIMUM FINISHED SURFACE ROUGHNESS U.N.O. 1.6

PARENT ASSEMBLY

CUSTOMER:

RAB ENGINEERING

DRAWN: David Bilney

TITLE:

P1948-000-01  
CHAIN CONVEYORS

DESIGNED: David Bilney

DWG NO:

194801/12

DATE: 17/03/2021

JOB NO:

SCALE:  
Scale

SHEET  
14 OF 31


SHEET SIZE:  
A3

REV:  
1

DO NOT SCALE DRAWING

16mm PLATE @ 140 X 111	Steel, Mild	AS3678 - GR250
DESCRIPTION	MATERIAL	COMMENTS

P1948-000-02 - 8 REQ'D AS DRAWN

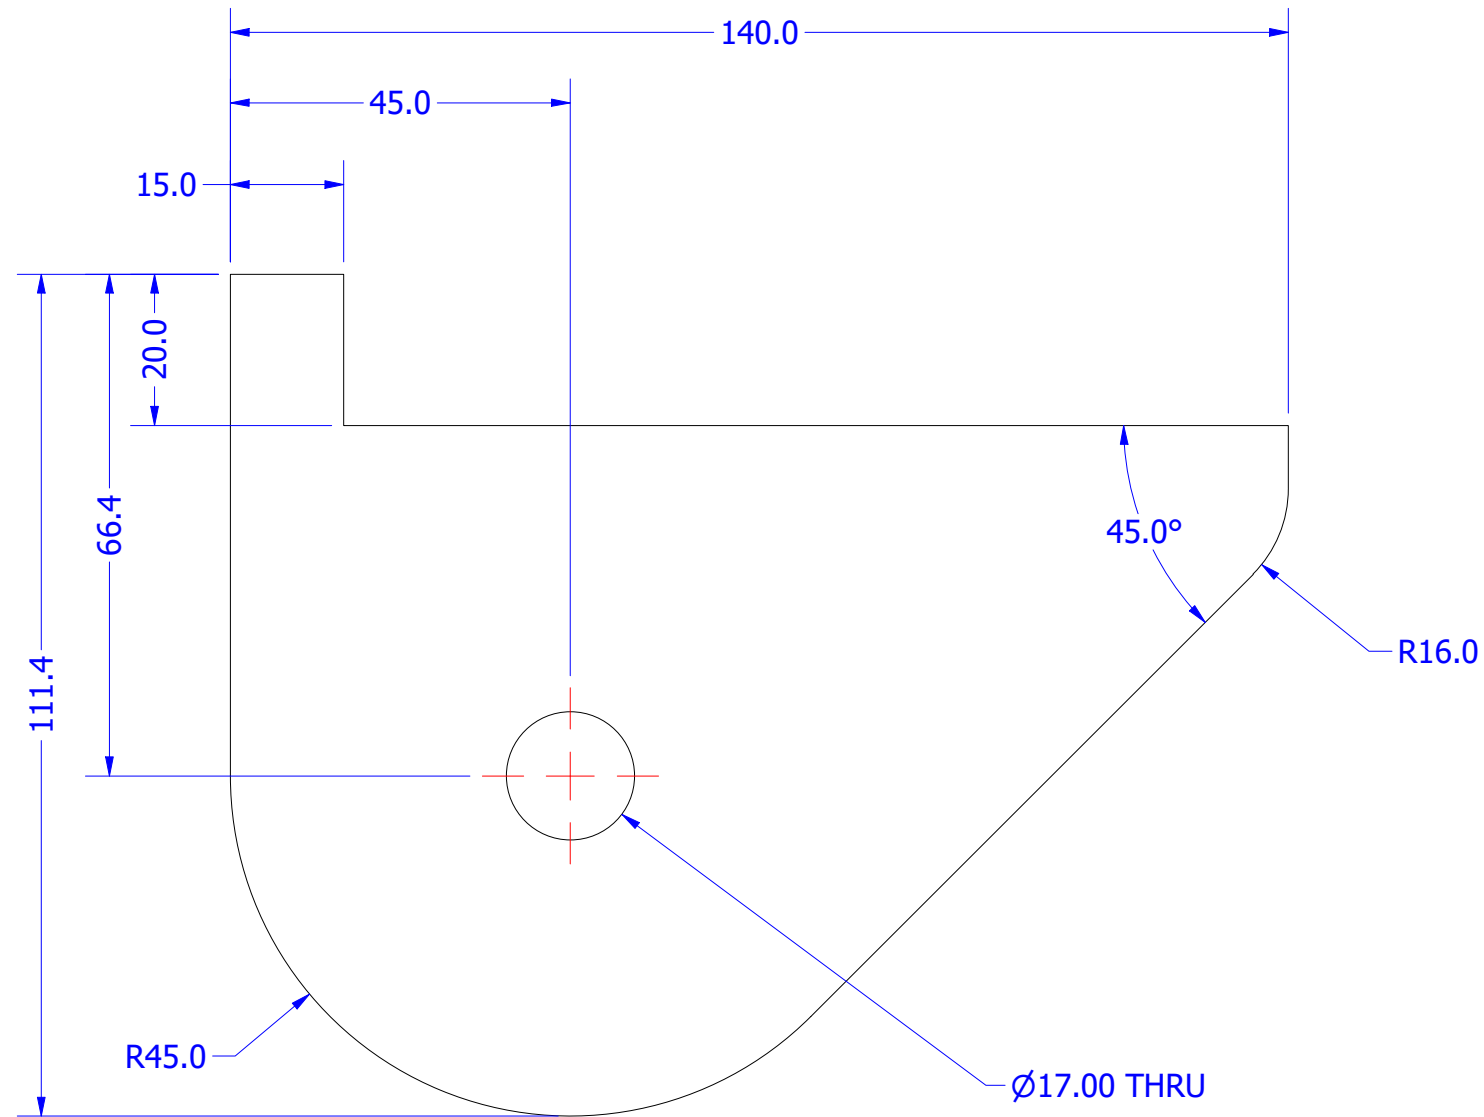


FRONT VIEW  
SCALE 1 : 1

REMOVE ALL BURRS & SHARP EDGES



THESE DRAWINGS ARE THE PROPERTY OF ULTIMATE ENGINEERING AND SHOULD NOT BE REPRODUCED OR COPIED IN ANY WAY WITHOUT WRITTEN PERMISSION FROM ULTIMATE ENGINEERING

PAINT TREATMENT:

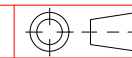

DIMENSION TOLERANCES	
DECIMAL	ANGULAR
X.X = ± .5 mm	X = ± 1°
X.XX = ± .25 mm	X.X = ± .5°
X.XXX = ± .125 mm	X.XX = ± .25°

MAXIMUM FINISHED SURFACE ROUGHNESS U.N.O. 1.6

PARENT ASSEMBLY

DRAWN: David Bilney

DESIGNED: David Bilney

DATE: 17/03/2021

CUSTOMER:

TITLE:

DWG NO:

JOB NO:

RAB ENGINEERING

P1948-000-02  
CHAIN CONVEYORS


194801/13

SCALE: Scale	SHEET 15 OF 31	SHEET SIZE: A3	REV: 1
-----------------	-------------------	-------------------	-----------

DO NOT SCALE DRAWING

16mm PLATE @ 480 X 139	Steel, Mild	AS3678 - GR250
DESCRIPTION	MATERIAL	COMMENTS

P1948-000-03 - 2 REQ'D AS DRAWN

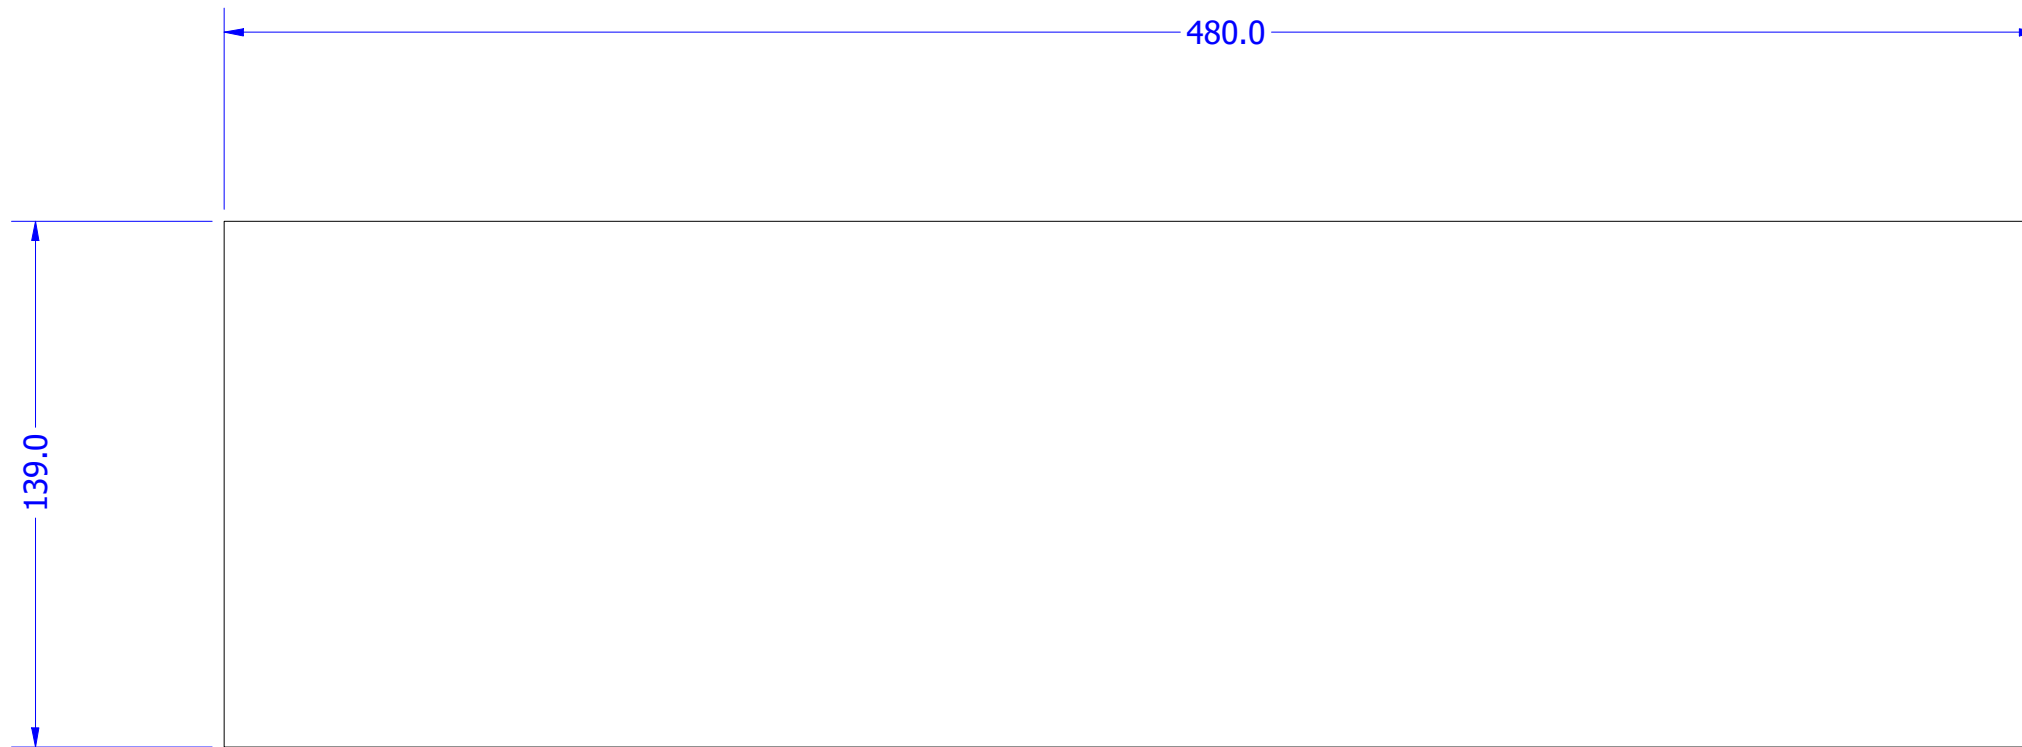

FRONT VIEW  
SCALE 1:2


REMOVE ALL BURRS & SHARP EDGES

DRAWN BY ULTIMATE ENGINEERING PTY LTD Ph 8562 1511



THESE DRAWINGS ARE THE PROPERTY OF ULTIMATE ENGINEERING AND SHOULD NOT BE REPRODUCED OR COPIED IN ANY WAY WITHOUT WRITTEN PERMISSION FROM ULTIMATE ENGINEERING

PAINT TREATMENT:

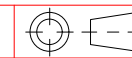

PARENT ASSEMBLY

CUSTOMER: **RAB ENGINEERING**

DIMENSION TOLERANCES	
DECIMAL	ANGULAR
X.X = ± .5 mm	X = ± 1°
X.XX = ± .25 mm	X.X = ± .5°
X.XXX = ± .125 mm	X.XX = ± .25°
MAXIMUM FINISHED SURFACE ROUGHNESS U.N.O. 1.6	

DRAWN: David Bilney

TITLE: P1948-000-03  
CHAIN CONVEYORS

DESIGNED: David Bilney

DWG NO: **194801/14**

DATE: 17/03/2021

JOB NO:

SCALE: Scale 16 OF 31

SHEET SIZE: A3


REV: 1




DO NOT SCALE DRAWING

5mm PLATE @ 140 X 115	Steel, Mild	AS3678 - GR250
DESCRIPTION	MATERIAL	COMMENTS

P1948-000-04 - 2 REQ'D AS DRAWN

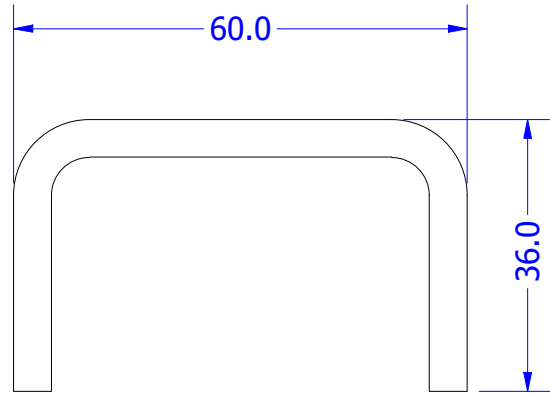

FOLDED VIEW  
SCALE 1 : 1

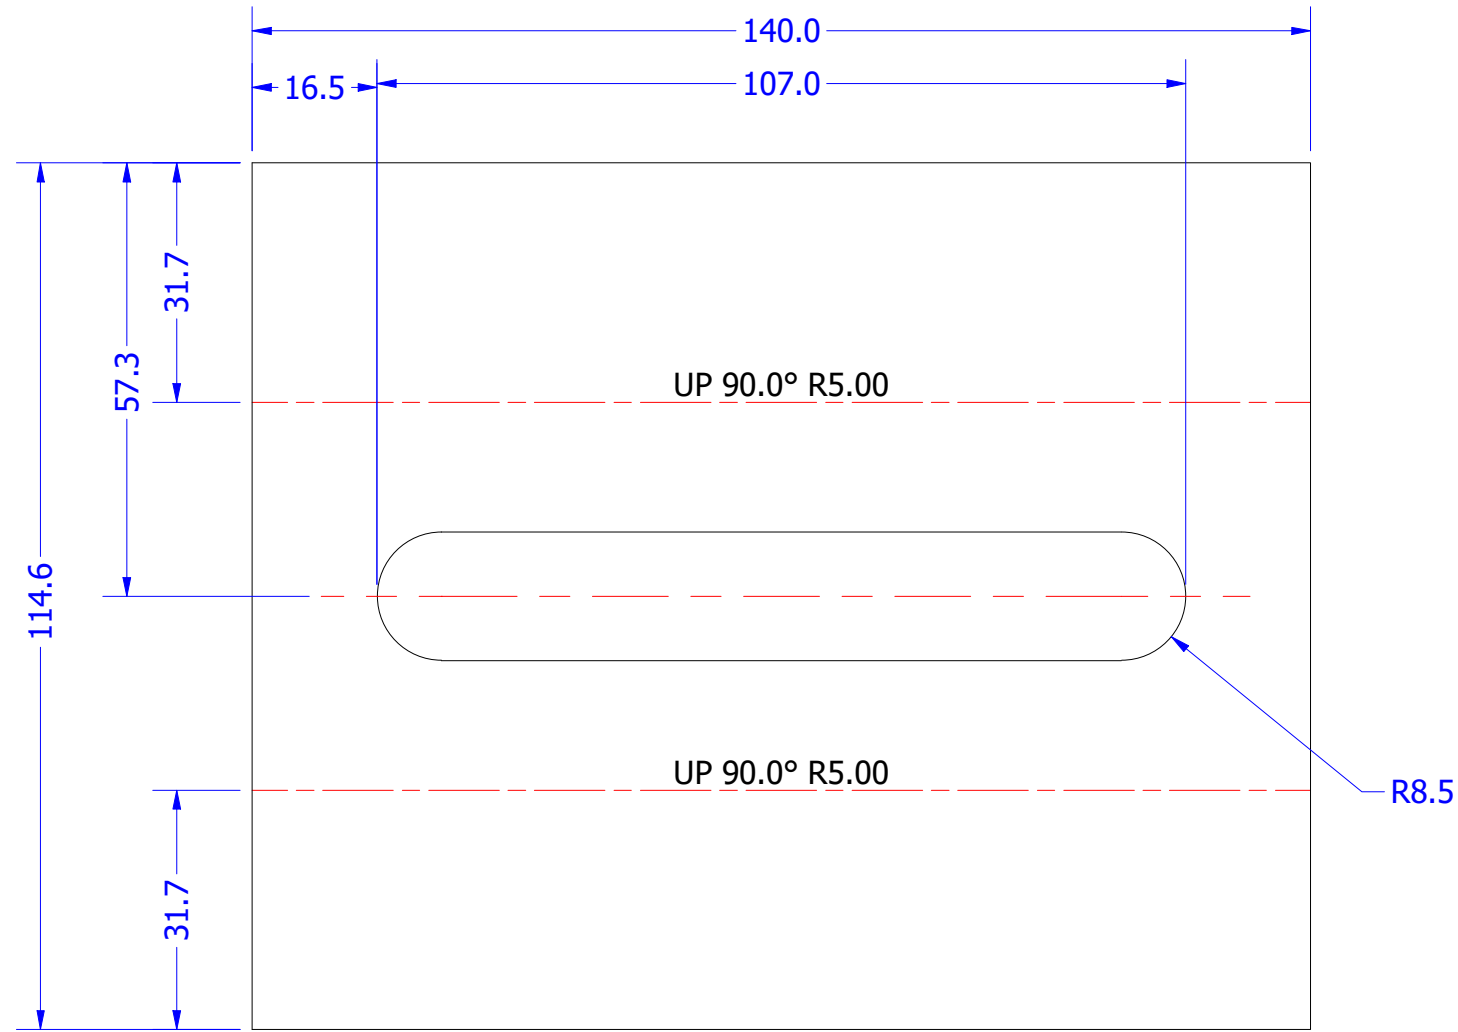


FLAT PATTERN  
SCALE 1 : 1

REMOVE ALL BURRS & SHARP EDGES



THESE DRAWINGS ARE THE PROPERTY OF ULTIMATE ENGINEERING AND SHOULD NOT BE REPRODUCED OR COPIED IN ANY WAY WITHOUT WRITTEN PERMISSION FROM ULTIMATE ENGINEERING

PAINT TREATMENT:

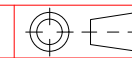

DIMENSION TOLERANCES	
DECIMAL	ANGULAR
X.X = ± .5 mm	X = ± 1°
X.XX = ± .25 mm	X.X = ± .5°
X.XXX = ± .125 mm	X.XX = ± .25°
MAXIMUM FINISHED SURFACE ROUGHNESS U.N.O. 1.6	

PARENT ASSEMBLY

DRAWN: David Bilney

DESIGNED: David Bilney

DATE: 17/03/2021

CUSTOMER:

RAB ENGINEERING

TITLE:

P1948-000-04  
CHAIN CONVEYORS

DWG NO:

194801/15

JOB NO:

SCALE:  
Scale

SHEET  
17 OF 31


SHEET SIZE:  
A3

REV:  
1

DO NOT SCALE DRAWING

12mm PLATE @ 35 X 35	Steel, Mild	AS3678 - GR250
DESCRIPTION	MATERIAL	COMMENTS

P1948-000-05 - 4 REQ'D AS DRAWN

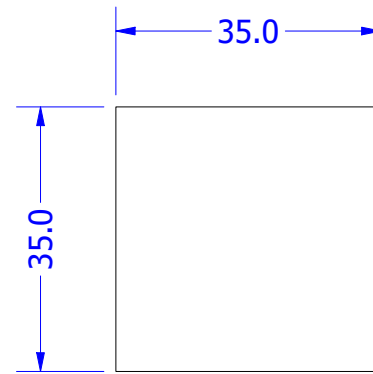


FRONT VIEW  
SCALE 1 : 1

REMOVE ALL BURRS & SHARP EDGES



THESE DRAWINGS ARE THE PROPERTY OF ULTIMATE ENGINEERING AND SHOULD NOT BE REPRODUCED OR COPIED IN ANY WAY WITHOUT WRITTEN PERMISSION FROM ULTIMATE ENGINEERING

PAINT TREATMENT:

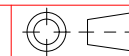

PARENT ASSEMBLY

CUSTOMER: **RAB ENGINEERING**

DIMENSION TOLERANCES	
DECIMAL	ANGULAR
X.X = ± .5 mm	X = ± 1°
X.XX = ± .25 mm	X.X = ± .5°
X.XXX = ± .125 mm	X.XX = ± .25°

MAXIMUM FINISHED SURFACE ROUGHNESS U.N.O. 1.6

DRAWN: David Bilney

TITLE: P1948-000-05  
CHAIN CONVEYORS

DESIGNED: David Bilney

DWG NO: **194801/16**

DATE: 17/03/2021

JOB NO:

SCALE: Scale 18 OF 31

SHEET SIZE: A3


REV: 1

DRAWN BY ULTIMATE ENGINEERING PTY LTD Ph 8562 1511

DO NOT SCALE DRAWING

100x10 FMS @ 400mm	Steel, Mild	AS3679 - GR300
DESCRIPTION	MATERIAL	COMMENTS

P1948-000-06 - 6 REQ'D AS DRAWN

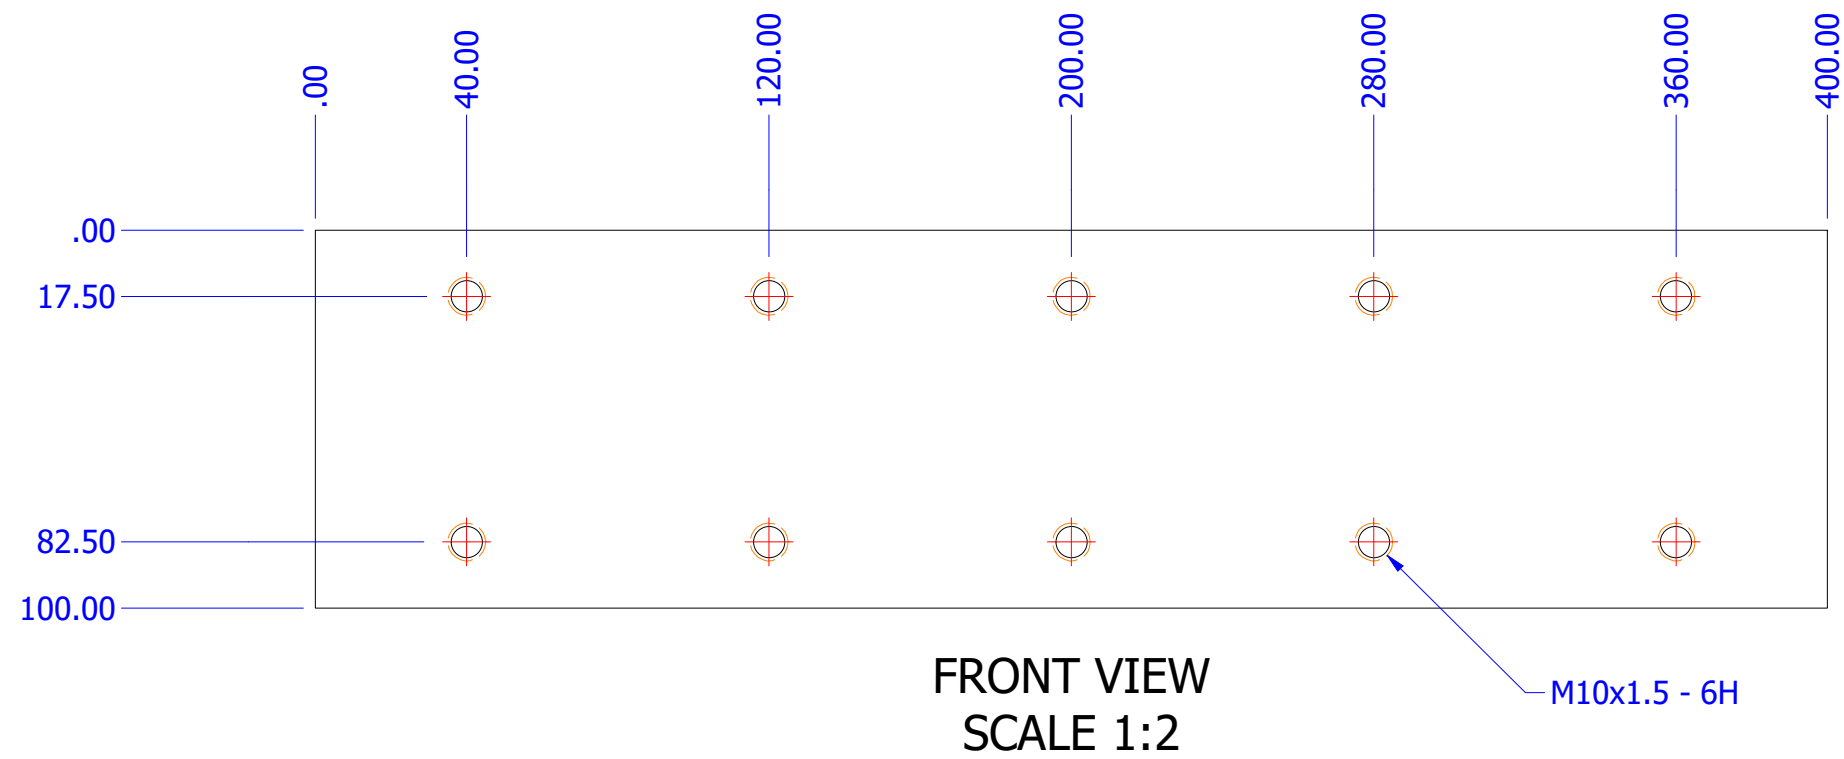


REMOVE ALL BURRS & SHARP EDGES



THESE DRAWINGS ARE THE PROPERTY OF ULTIMATE ENGINEERING AND SHOULD NOT BE REPRODUCED OR COPIED IN ANY WAY WITHOUT WRITTEN PERMISSION FROM ULTIMATE ENGINEERING

PAINT TREATMENT:

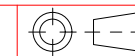

DIMENSION TOLERANCES	
DECIMAL	ANGULAR
X.X = ± .5 mm	X = ± 1°
X.XX = ± .25 mm	X.X = ± .5°
X.XXX = ± .125 mm	X.XX = ± .25°

MAXIMUM FINISHED SURFACE ROUGHNESS U.N.O. 1.6 ✓

PARENT ASSEMBLY

DRAWN: David Bilney

DESIGNED: David Bilney

DATE: 17/03/2021

CUSTOMER:

RAB ENGINEERING

TITLE:

P1948-000-06  
CHAIN CONVEYORS

DWG NO:

194801/17

JOB NO:

SCALE:  
Scale


SHEET  
19 OF 31

SHEET SIZE:  
A3


REV:  
1

DO NOT SCALE DRAWING


2mm PLATE @ 3220 X 95	Steel, Mild	AS1594 - GR250
DESCRIPTION	MATERIAL	COMMENTS
P1948-000-07 - 2 REQ'D AS DRAWN		

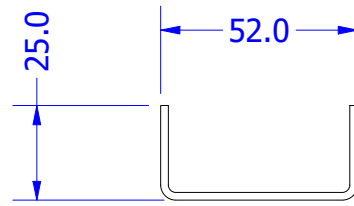

FOLDED VIEW  
SCALE 1:2

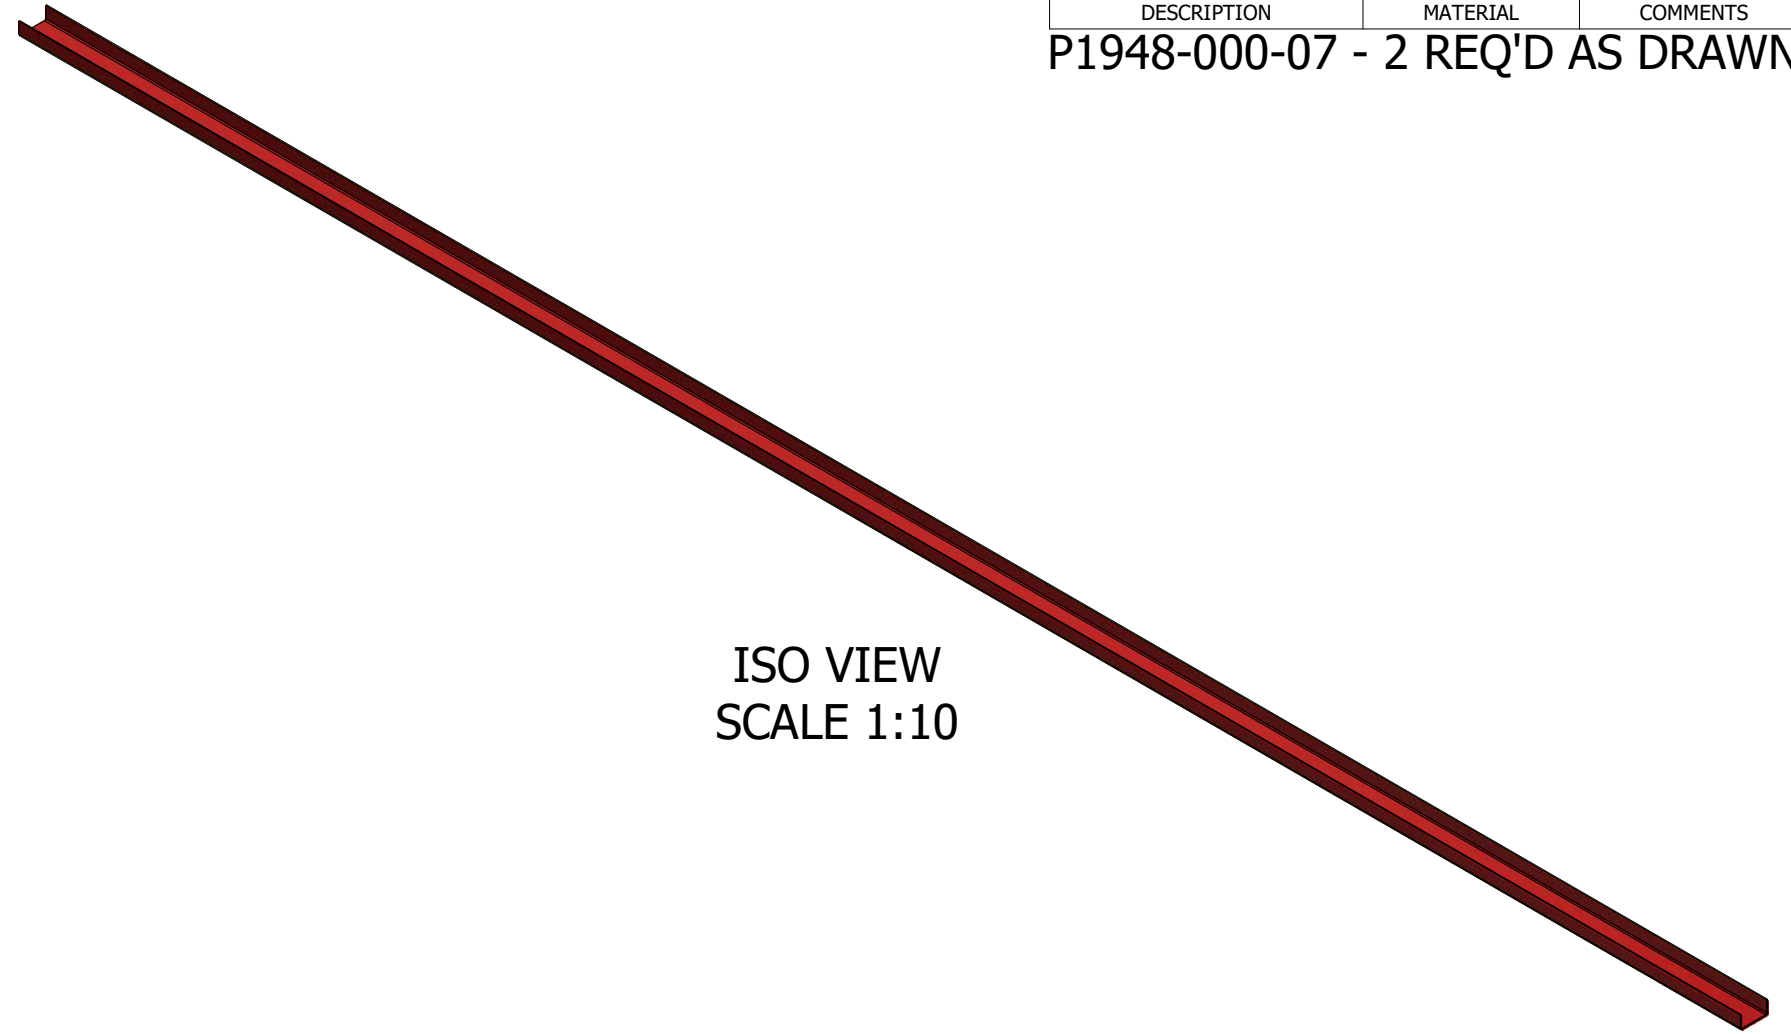

ISO VIEW  
SCALE 1:10

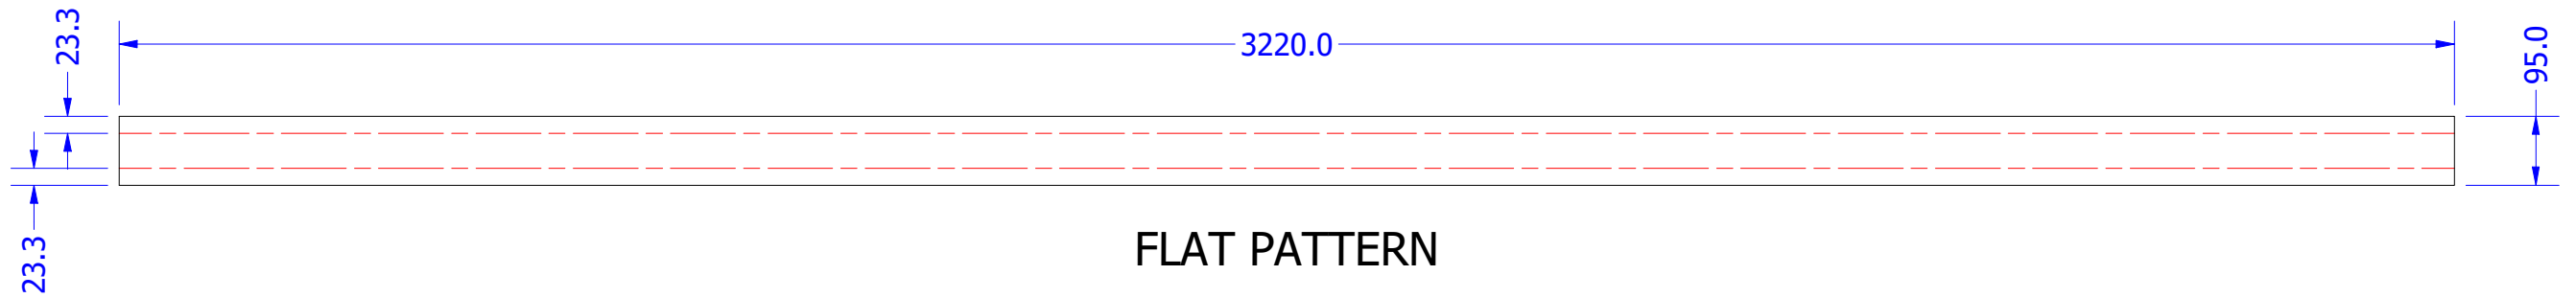


FLAT PATTERN  
ALL FOLDS UP 90°  
SCALE 1:10

REMOVE ALL BURRS & SHARP EDGES



THESE DRAWINGS ARE THE PROPERTY OF ULTIMATE ENGINEERING AND SHOULD NOT BE REPRODUCED OR COPIED IN ANY WAY WITHOUT WRITTEN PERMISSION FROM ULTIMATE ENGINEERING

PAINT TREATMENT:

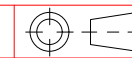

DIMENSION TOLERANCES	
DECIMAL	ANGULAR
X.X = ± .5 mm	X = ± 1°
X.XX = ± .25 mm	X.X = ± .5°
X.XXX = ± .125 mm	X.XX = ± .25°
MAXIMUM FINISHED SURFACE ROUGHNESS U.N.O. 1.6	

PARENT ASSEMBLY

CUSTOMER:

RAB ENGINEERING

DRAWN: David Bilney

TITLE:

P1948-000-07  
CHAIN CONVEYORS

DESIGNED: David Bilney

DWG NO:

194801

DATE: 17/03/2021

JOB NO:

SCALE: 20 OF 31


SHEET SIZE: A3  
REV: 1

DRAWN BY ULTIMATE ENGINEERING PTY LTD Ph 8562 1511

DO NOT SCALE DRAWING

6mm PLATE @ 65 X 65	Steel, Mild	AS3678 - GR250
DESCRIPTION	MATERIAL	COMMENTS

P1948-000-08 - 2 REQ'D AS DRAWN

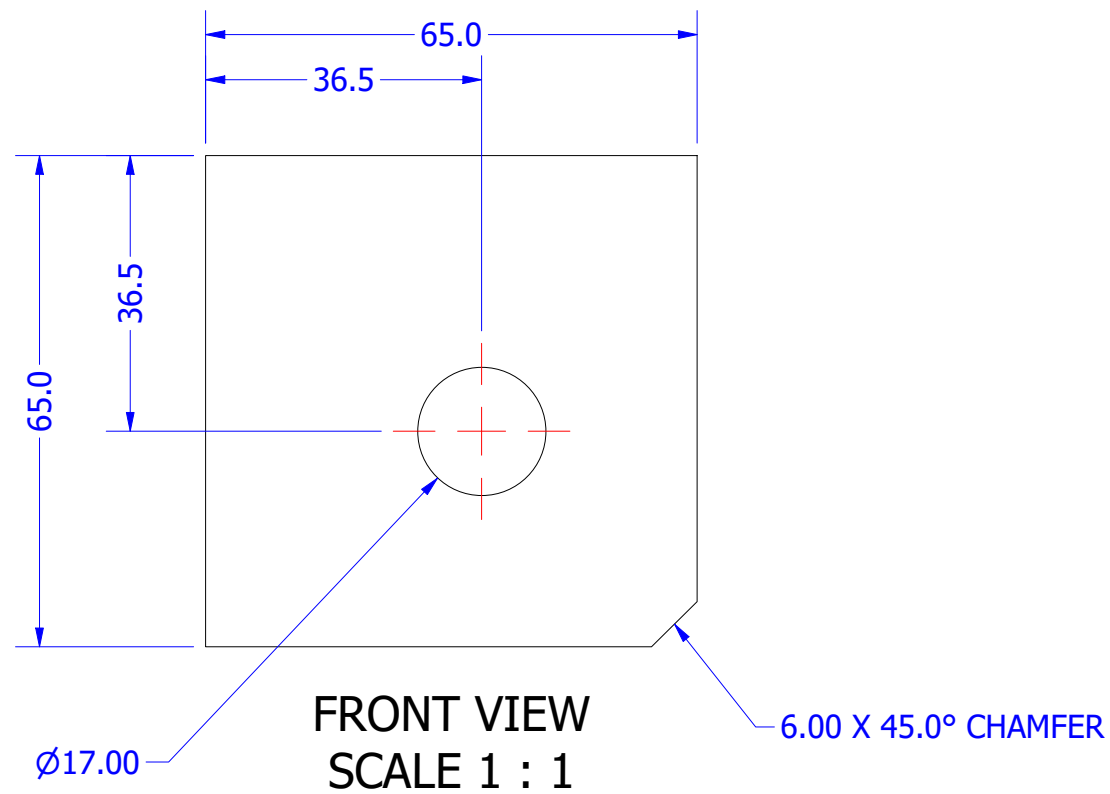


REMOVE ALL BURRS & SHARP EDGES



THESE DRAWINGS ARE THE PROPERTY OF ULTIMATE ENGINEERING AND SHOULD NOT BE REPRODUCED OR COPIED IN ANY WAY WITHOUT WRITTEN PERMISSION FROM ULTIMATE ENGINEERING

PAINT TREATMENT:

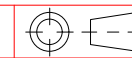

DIMENSION TOLERANCES	
DECIMAL	ANGULAR
X.X = ± .5 mm	X = ± 1°
X.XX = ± .25 mm	X.X = ± .5°
X.XXX = ± .125 mm	X.XX = ± .25°

MAXIMUM FINISHED SURFACE ROUGHNESS U.N.O. 1.6

PARENT ASSEMBLY

DRAWN: David Bilney

DESIGNED: David Bilney

DATE: 17/03/2021

CUSTOMER:

RAB ENGINEERING

TITLE:

P1948-000-08  
CHAIN CONVEYORS

DWG NO:

194801/18

JOB NO:

SCALE:  
Scale

SHEET  
21 OF 31


SHEET SIZE:  
A3

REV:  
1

DO NOT SCALE DRAWING

2mm PLATE @ 81 X 30	Steel, Mild	ASTM A240
DESCRIPTION	MATERIAL	COMMENTS

P1948-000-09 - 4 REQ'D AS DRAWN

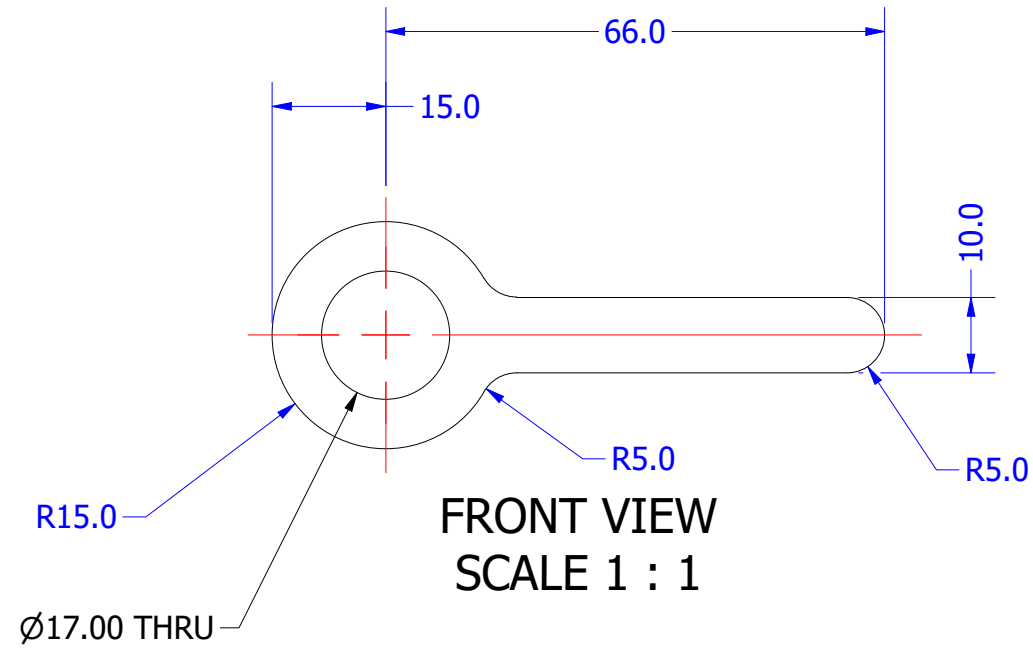


REMOVE ALL BURRS & SHARP EDGES



THESE DRAWINGS ARE THE PROPERTY OF ULTIMATE ENGINEERING AND SHOULD NOT BE REPRODUCED OR COPIED IN ANY WAY WITHOUT WRITTEN PERMISSION FROM ULTIMATE ENGINEERING

PAINT TREATMENT:

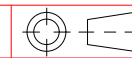

DIMENSION TOLERANCES	
DECIMAL	ANGULAR
X.X = ± .5 mm	X = ± 1°
X.XX = ± .25 mm	X.X = ± .5°
X.XXX = ± .125 mm	X.XX = ± .25°

MAXIMUM FINISHED SURFACE ROUGHNESS U.N.O. 1.6

PARENT ASSEMBLY

CUSTOMER: **RAB ENGINEERING**

DRAWN: David Bilney

TITLE: P1948-000-09  
CHAIN CONVEYORS

DESIGNED: David Bilney

DWG NO: **194801/19**

DATE: 17/03/2021

JOB NO:

SCALE: Scale  
SHEET 22 OF 31

SHEET SIZE: A3

REV: 1

DRAWN BY ULTIMATE ENGINEERING PTY LTD Ph 8562 1511




DO NOT SCALE DRAWING

40 RND BAR @ 12.5mm	Steel, Mild	AS3679 - GR300
DESCRIPTION	MATERIAL	COMMENTS


P1948-000-10 - 4 REQ'D AS DRAWN



ISO VIEW  
SCALE 1 : 1

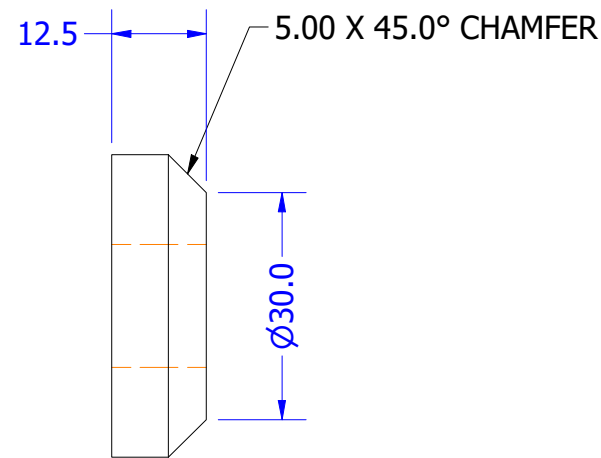

SIDE VIEW  
SCALE 1 : 1

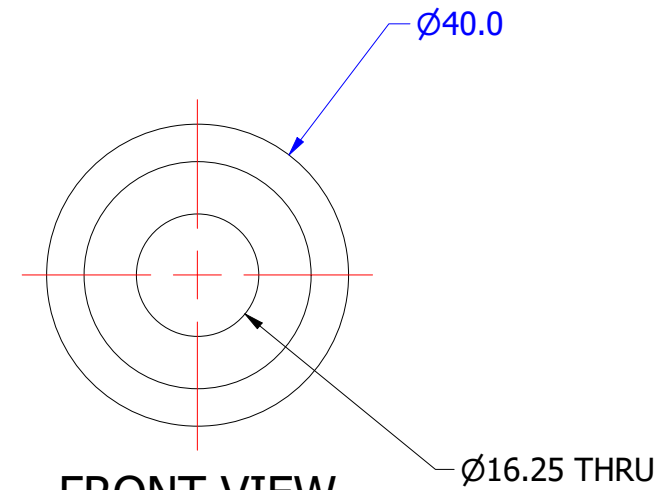


FRONT VIEW  
SCALE 1 : 1

REMOVE ALL BURRS & SHARP EDGES



THESE DRAWINGS ARE THE PROPERTY OF ULTIMATE ENGINEERING AND SHOULD NOT BE REPRODUCED OR COPIED IN ANY WAY WITHOUT WRITTEN PERMISSION FROM ULTIMATE ENGINEERING

PAINT TREATMENT: ZINC PLATE

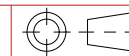

DIMENSION TOLERANCES	
DECIMAL	ANGULAR
X.X = ± .5 mm	X = ± 1°
X.XX = ± .25 mm	X.X = ± .5°
X.XXX = ± .125 mm	X.XX = ± .25°

MAXIMUM FINISHED SURFACE ROUGHNESS U.N.O. 1.6

PARENT ASSEMBLY

DRAWN: David Bilney

DESIGNED: David Bilney

DATE: 17/03/2021

CUSTOMER: **RAB ENGINEERING**

TITLE: P1948-000-10  
CHAIN CONVEYORS

DWG NO: **194801/20**

JOB NO:

SCALE: Scale  
SHEET 23 OF 31

SHEET SIZE: A3



REV: 1

DRAWN BY ULTIMATE ENGINEERING PTY LTD Ph 8562 1511

DO NOT SCALE DRAWING

2	M12 ALL THREAD @ 185	Steel, Mild		
1	32x15 HOLLOW BAR @ 30	Steel, Mild		1
ITEM	PART NUMBER	MATERIAL	COMMENTS	ITEM QTY

P1948-000-11 - 2 REQ'D AS DRAWN

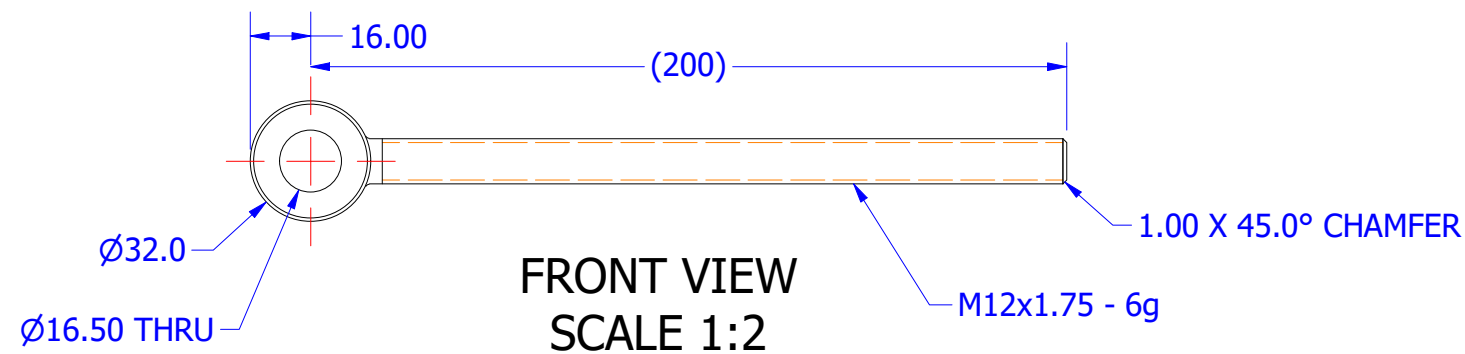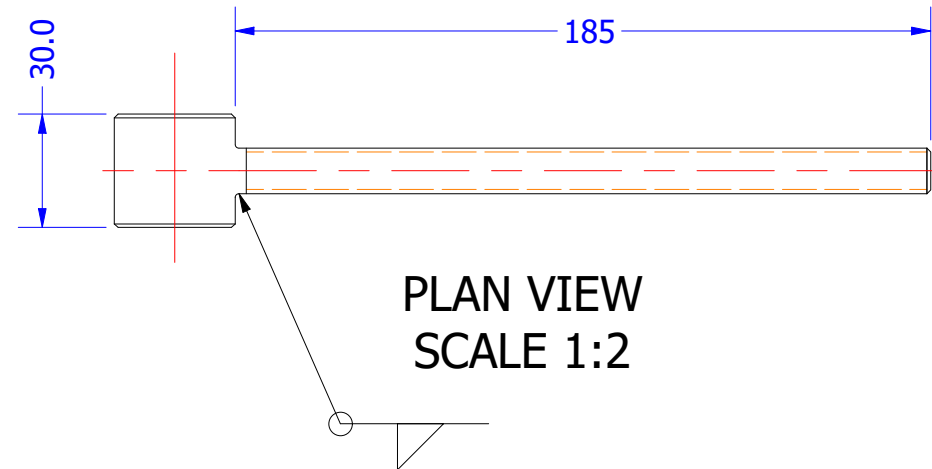

REMOVE ALL BURRS & SHARP EDGES



THESE DRAWINGS ARE THE PROPERTY OF ULTIMATE ENGINEERING AND SHOULD NOT BE REPRODUCED OR COPIED IN ANY WAY WITHOUT WRITTEN PERMISSION FROM ULTIMATE ENGINEERING

PAINT TREATMENT: ZINC PLATE



PARENT ASSEMBLY

CUSTOMER: **RAB ENGINEERING**

DIMENSION TOLERANCES	
DECIMAL	ANGULAR
X.X = ± .5 mm	X = ± 1°
X.XX = ± .25 mm	X.X = ± .5°
X.XXX = ± .125 mm	X.XX = ± .25°

MAXIMUM FINISHED SURFACE ROUGHNESS U.N.O. 1.6 ✓

DRAWN: David Bilney

TITLE: P1948-000-11  
CHAIN CONVEYORS

DESIGNED: David Bilney

DWG NO: **194801/21**

DATE: 17/03/2021

JOB NO:


SCALE: Scale  
SHEET 24 OF 31

SHEET SIZE: A3  
REV: 1

DO NOT SCALE DRAWING

10mm PLATE @ 370 X 170	Mild Steel	AS3678 - GR250
DESCRIPTION	MATERIAL	COMMENTS

P1948-000-12 - 1 REQ'D AS DRAWN

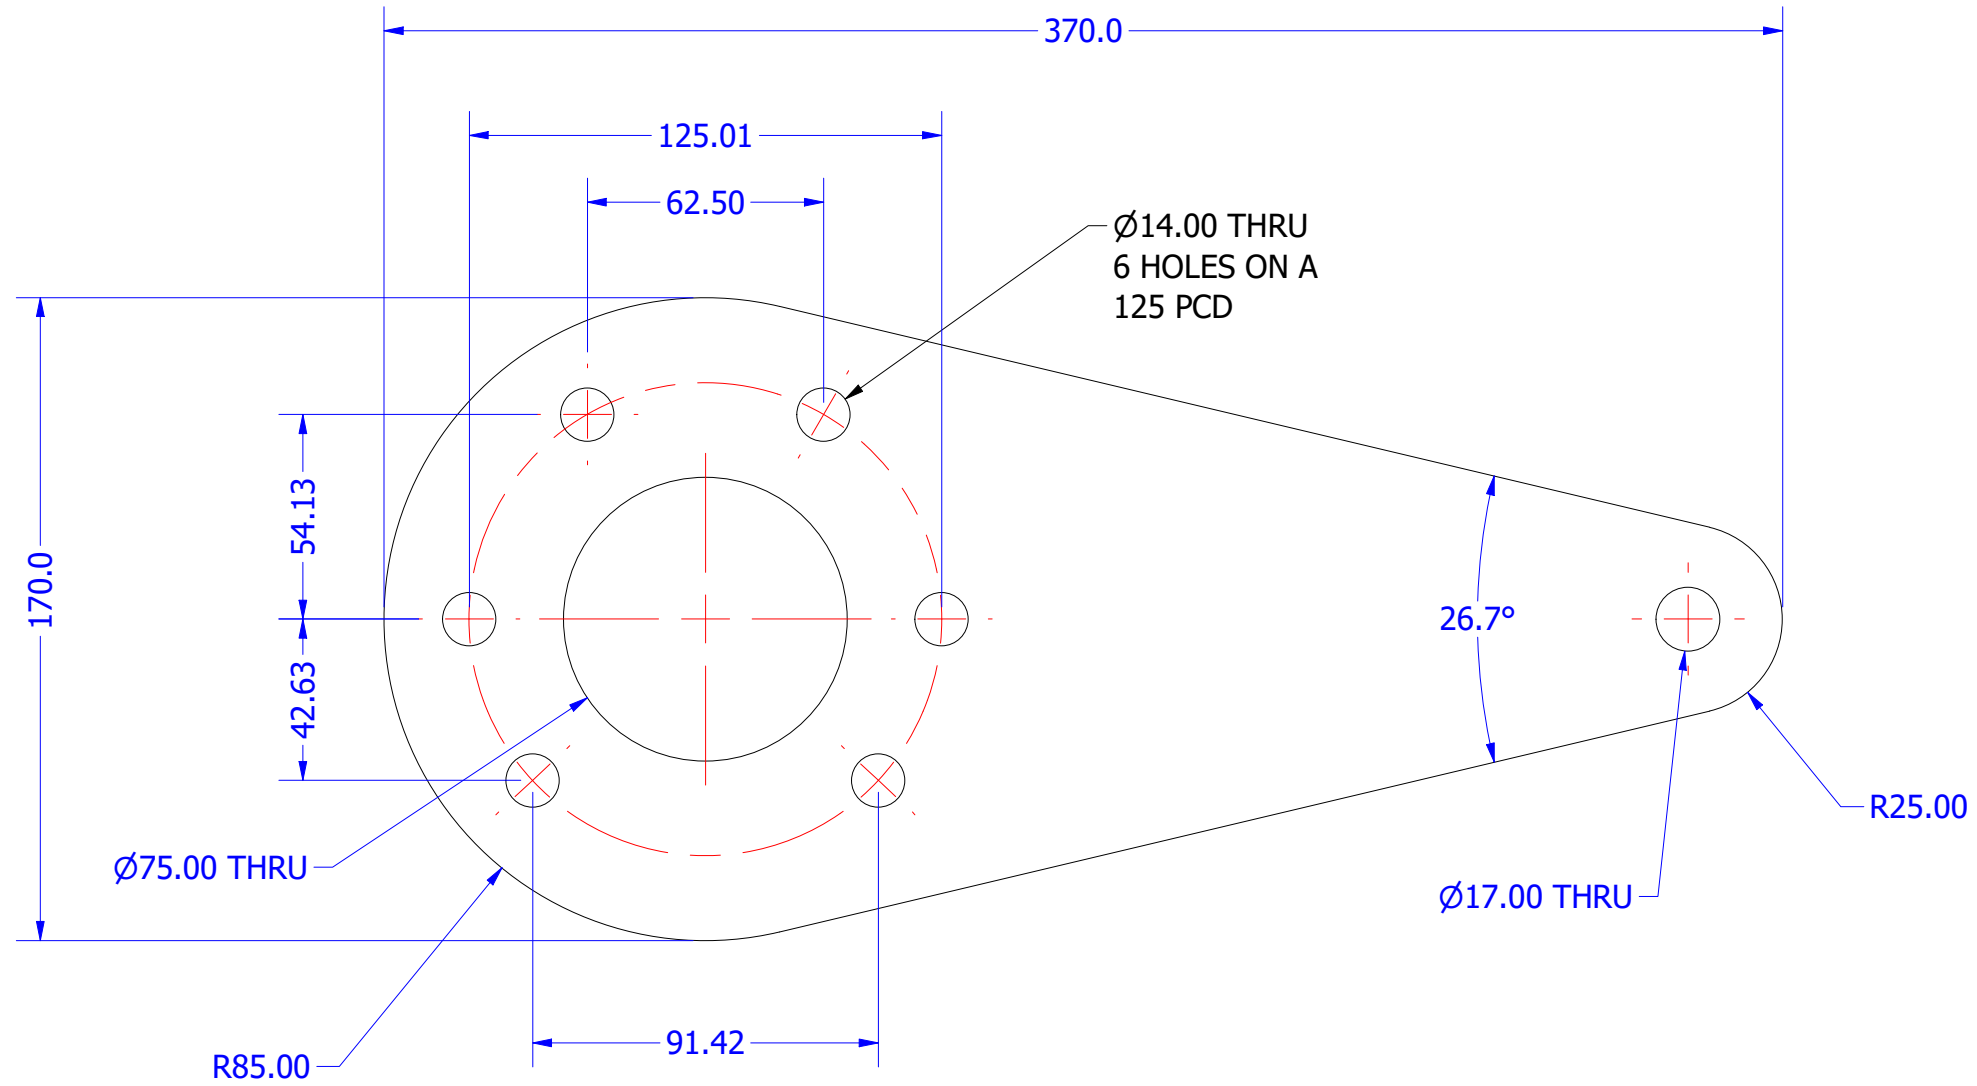


FRONT VIEW  
SCALE 1:2

REMOVE ALL BURRS & SHARP EDGES



THESE DRAWINGS ARE THE PROPERTY OF ULTIMATE ENGINEERING AND SHOULD NOT BE REPRODUCED OR COPIED IN ANY WAY WITHOUT WRITTEN PERMISSION FROM ULTIMATE ENGINEERING

PAINT TREATMENT:

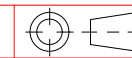

PARENT ASSEMBLY

CUSTOMER:

RAB ENGINEERING

DIMENSION TOLERANCES

DECIMAL	ANGULAR
X.X = ± .5 mm	X = ± 1'
X.XX = ± .25 mm	X.X = ± .5'
X.XXX = ± .125 mm	X.XX = ± .25'

DRAWN: David Bilney

TITLE:

P1948-000-12  
CHAIN CONVEYORS

DESIGNED: David Bilney

DWG NO:

194801/22

MAXIMUM FINISHED SURFACE ROUGHNESS U.N.O. 1.6

DATE: 17/03/2021

JOB NO:

SCALE:  
Scale

SHEET  
25 OF 31


SHEET SIZE:  
A3

REV:  
1

DO NOT SCALE DRAWING

16mm PLATE @ 200 X 50	Steel, Mild	AS3678 - GR250
DESCRIPTION	MATERIAL	COMMENTS

P1948-000-13 - 1 REQ'D AS DRAWN

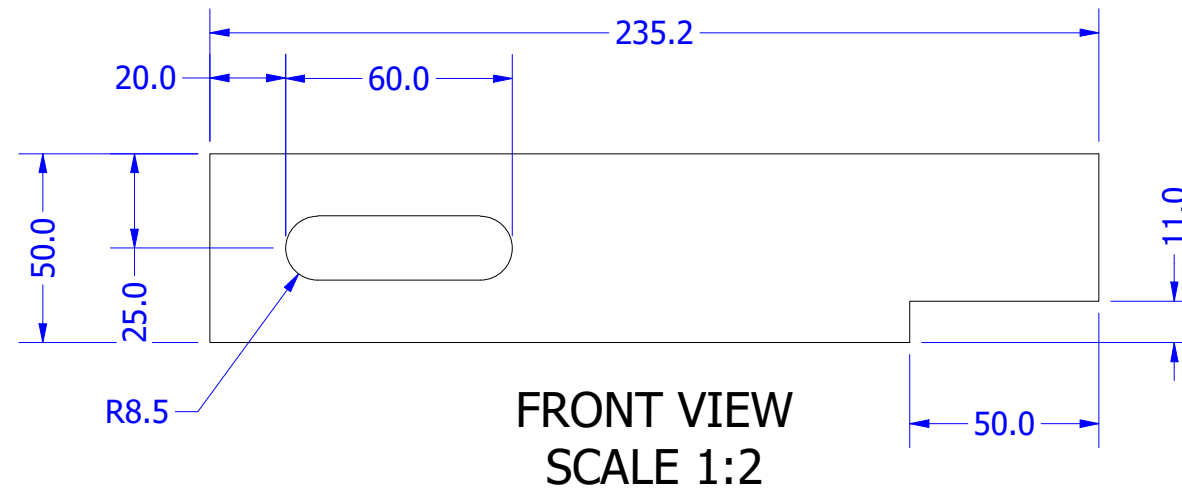


REMOVE ALL BURRS & SHARP EDGES



THESE DRAWINGS ARE THE PROPERTY OF ULTIMATE ENGINEERING AND SHOULD NOT BE REPRODUCED OR COPIED IN ANY WAY WITHOUT WRITTEN PERMISSION FROM ULTIMATE ENGINEERING

PAINT TREATMENT:

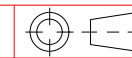

DIMENSION TOLERANCES	
DECIMAL	ANGULAR
X.X = ± .5 mm	X = ± 1°
X.XX = ± .25 mm	X.X = ± .5°
X.XXX = ± .125 mm	X.XX = ± .25°
MAXIMUM FINISHED SURFACE ROUGHNESS U.N.O. 1.6	

PARENT ASSEMBLY

CUSTOMER: **RAB ENGINEERING**

DRAWN: David Bilney

TITLE: P1948-000-13  
CHAIN CONVEYORS

DESIGNED: David Bilney

DWG NO: **194801/23**

DATE: 17/03/2021

JOB NO:

SCALE: Scale  
SHEET 26 OF 31

SHEET SIZE: A3

REV: 1



DO NOT SCALE DRAWING

30x13.5 FLAT @ 995	Polyethylene, High Density	
DESCRIPTION	MATERIAL	COMMENTS


P1948-000-15 - 8 REQ'D AS DRAWN



ISO VIEW  
SCALE 1:5

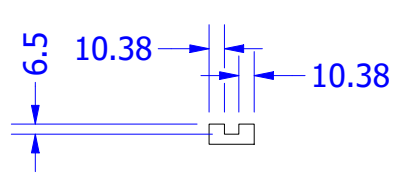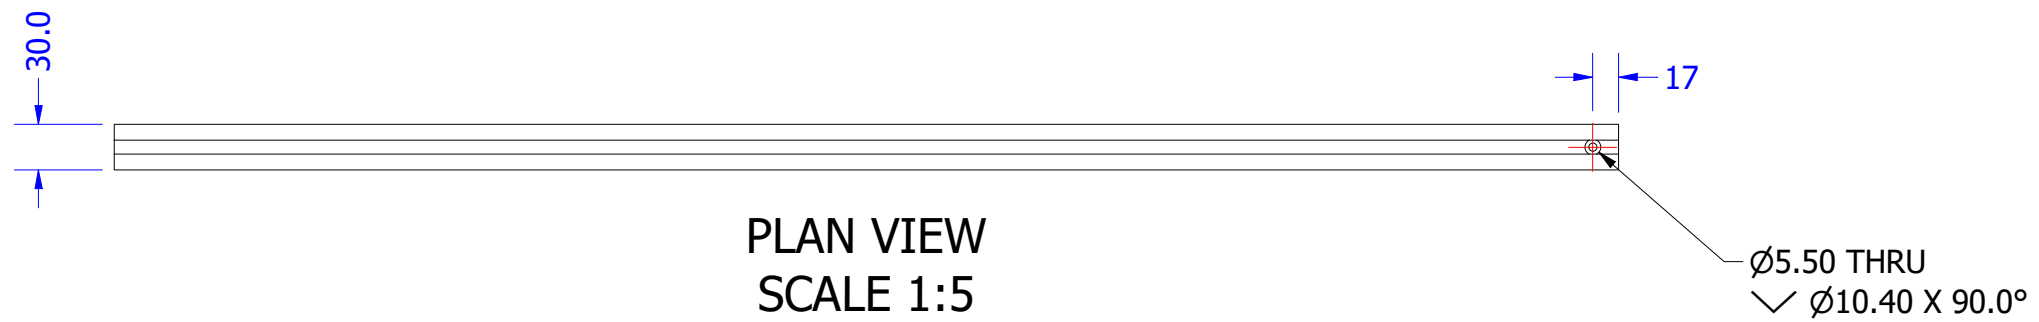

END VIEW  
SCALE 1:5

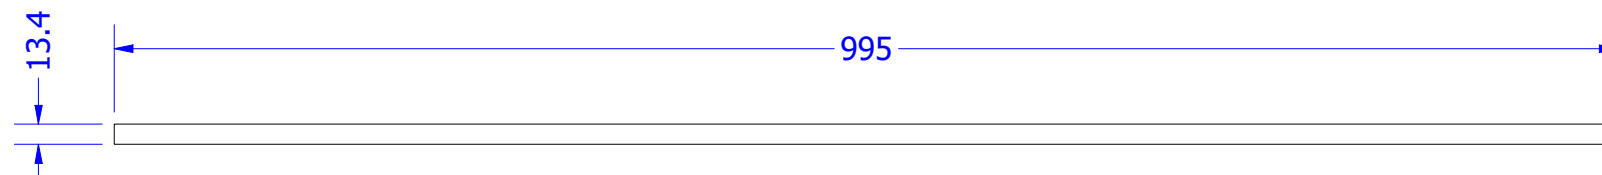


SIDE VIEW  
SCALE 1:5

DRAWN BY ULTIMATE ENGINEERING PTY LTD Ph 8562 1511



THESE DRAWINGS ARE THE PROPERTY OF ULTIMATE ENGINEERING AND SHOULD NOT BE REPRODUCED OR COPIED IN ANY WAY WITHOUT WRITTEN PERMISSION FROM ULTIMATE ENGINEERING

PAINT TREATMENT:

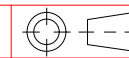

DIMENSION TOLERANCES	
DECIMAL	ANGULAR
X.X = ± .5 mm	X = ± 1°
X.XX = ± .25 mm	X.X = ± .5°
X.XXX = ± .125 mm	X.XX = ± .25°

MAXIMUM FINISHED SURFACE ROUGHNESS U.N.O. 1.6

PARENT ASSEMBLY

CUSTOMER:

RAB ENGINEERING

DRAWN: David Bilney

TITLE:

P1948-000-15  
CHAIN CONVEYORS

DESIGNED: David Bilney

DWG NO:

194801/25

DATE: 17/03/2021

JOB NO:

SCALE:  
Scale

SHEET  
27 OF 31


SHEET SIZE:  
A3

REV:  
1


DO NOT SCALE DRAWING

2mm PLATE @ 790 X 355	Steel, Mild	AS1594 - GR250
DESCRIPTION	MATERIAL	COMMENTS


P1948-000-16 - 1 REQ'D AS DRAWN  
 P1948-000-17 - 1 REQ'D OPPOSITE  
 (2 BLANKS REQ'D)

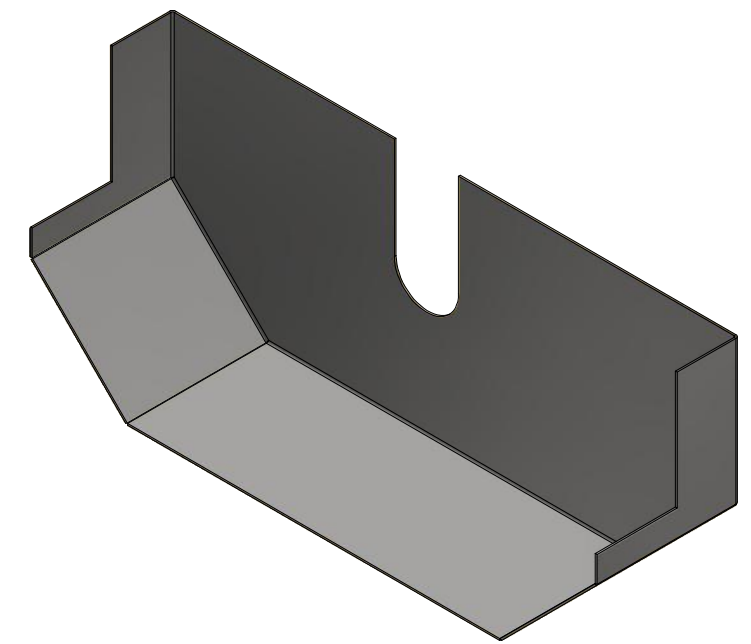


ISO VIEW - FOLDED  
 SCALE 1:5

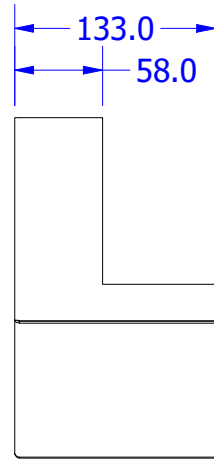

SIDE VIEW - FPLDED  
 SCALE 1:5

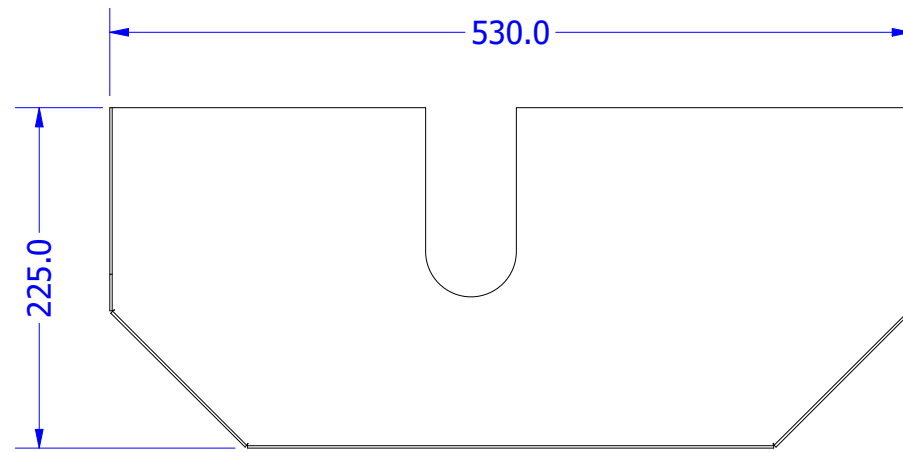

FRONT VIEW - FOLDED  
 SCALE 1:5

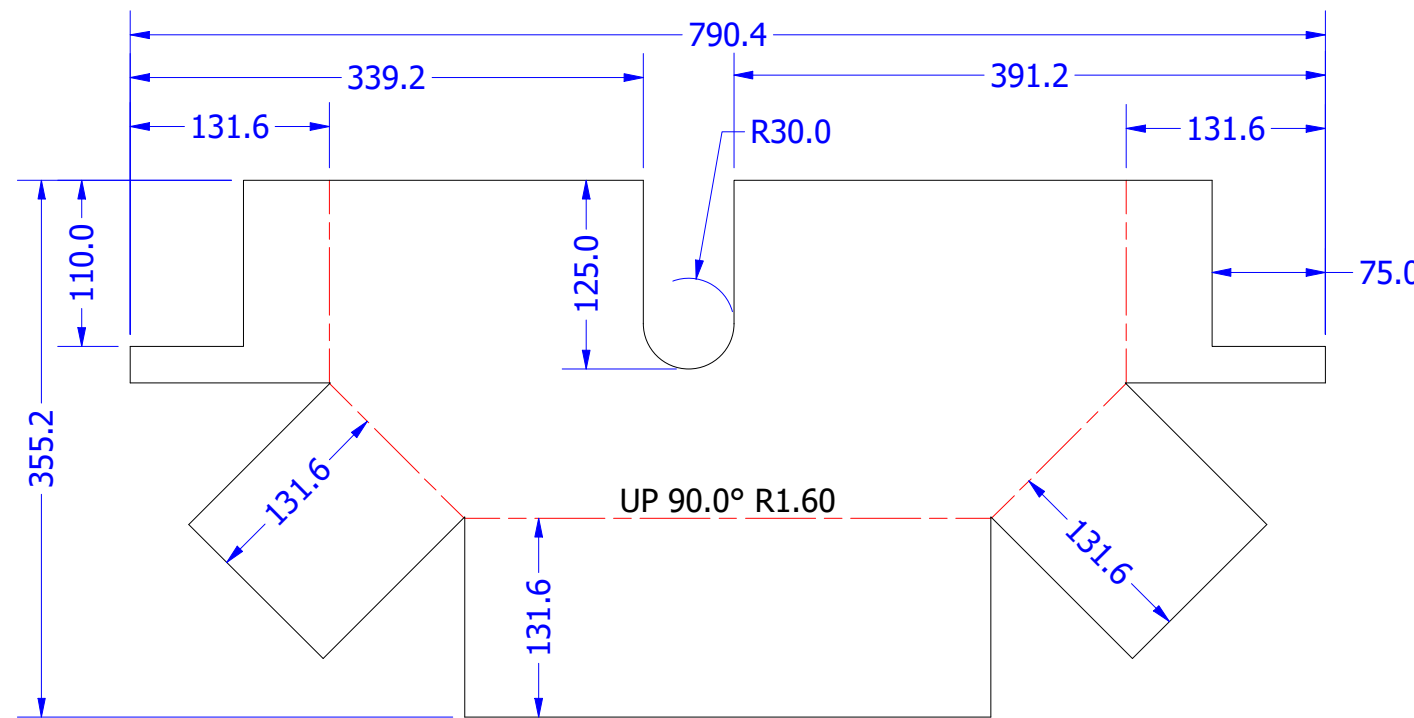

P1948-000-16 - ALL FOLDS UP 90°

P1948-000-17 - ALL FOLDS DOWN 90°


SCALE 1:5

REMOVE ALL BURRS & SHARP EDGES



THESE DRAWINGS ARE THE PROPERTY OF ULTIMATE ENGINEERING AND SHOULD NOT BE REPRODUCED OR COPIED IN ANY WAY WITHOUT WRITTEN PERMISSION FROM ULTIMATE ENGINEERING

PAINT TREATMENT:

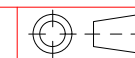

DIMENSION TOLERANCES	
DECIMAL	ANGULAR
X.X = ± .5 mm	X = ± 1°
X.XX = ± .25 mm	X.X = ± .5°
X.XXX = ± .125 mm	X.XX = ± .25°
MAXIMUM FINISHED SURFACE ROUGHNESS U.N.O. 1.6	


PARENT ASSEMBLY	CUSTOMER: RAB ENGINEERING
DRAWN: David Bilney	TITLE: P1948-000-16 CHAIN CONVEYORS
DESIGNED: David Bilney	DWG NO: 194801/26
DATE: 17/03/2021	JOB NO:
SCALE: Scale	SHEET: 28 OF 31
SHEET SIZE: A3	REV: 1

DRAWN BY ULTIMATE ENGINEERING PTY LTD Ph 8562 1511




DO NOT SCALE DRAWING


30x10 FLAT @ 1820	HDPE	
DESCRIPTION	MATERIAL	COMMENTS
P1948-000-23 - 2 REQ'D AS DRAWN		

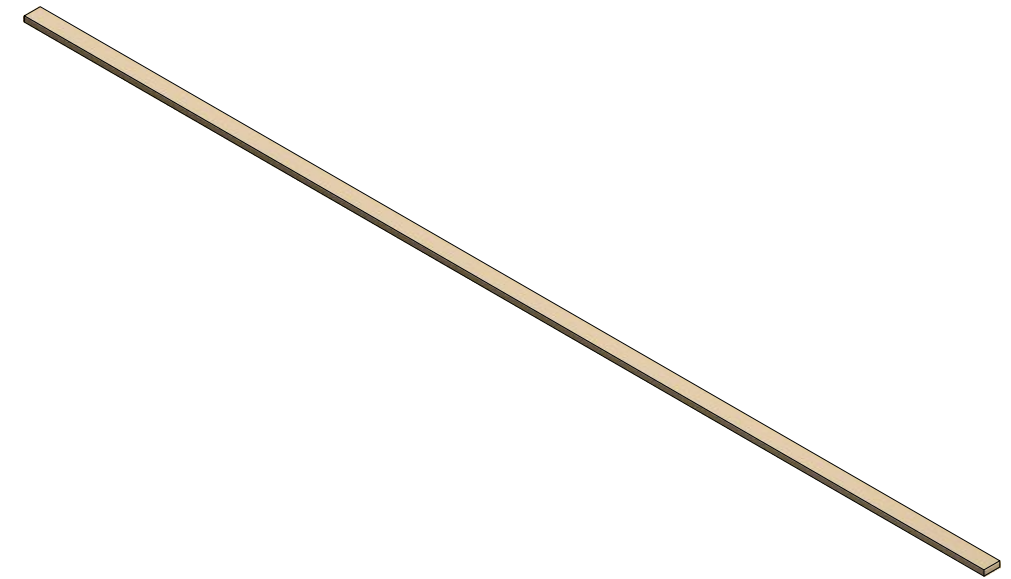

ISO VIEW  
SCALE 1:10

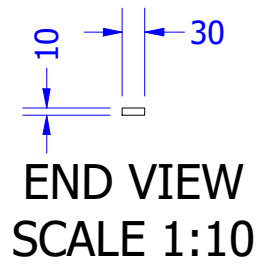

END VIEW  
SCALE 1:10

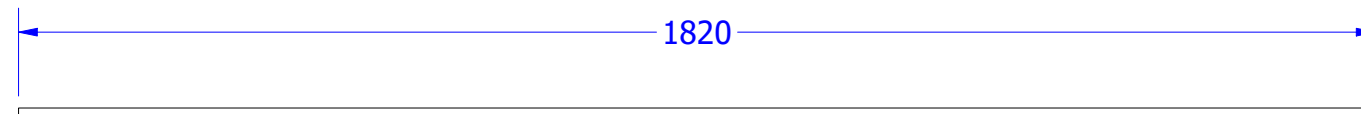


SIDE VIEW  
SCALE 1:10

REMOVE ALL BURRS & SHARP EDGES



THESE DRAWINGS ARE THE PROPERTY OF ULTIMATE ENGINEERING AND SHOULD NOT BE REPRODUCED OR COPIED IN ANY WAY WITHOUT WRITTEN PERMISSION FROM ULTIMATE ENGINEERING

PAINT TREATMENT:

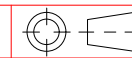

DIMENSION TOLERANCES	
DECIMAL	ANGULAR
X.X = ± .5 mm	X = ± 1°
X.XX = ± .25 mm	X.X = ± .5°
X.XXX = ± .125 mm	X.XX = ± .25°
MAXIMUM FINISHED SURFACE ROUGHNESS U.N.O. 1.6	

PARENT ASSEMBLY

CUSTOMER:

RAB ENGINEERING

DRAWN: David Bilney

TITLE:

P1948-000-23  
CHAIN CONVEYORS

DESIGNED: David Bilney

DWG NO:

194802

DATE: 17/03/2021

JOB NO:

SCALE: Scale 29 OF 31


SHEET SIZE: A3

REV: 1

DO NOT SCALE DRAWING

30x10 FLAT @ 920	Polyethylene, High Density	
DESCRIPTION	MATERIAL	COMMENTS


P1948-000-24 - 2 REQ'D AS DRAWN

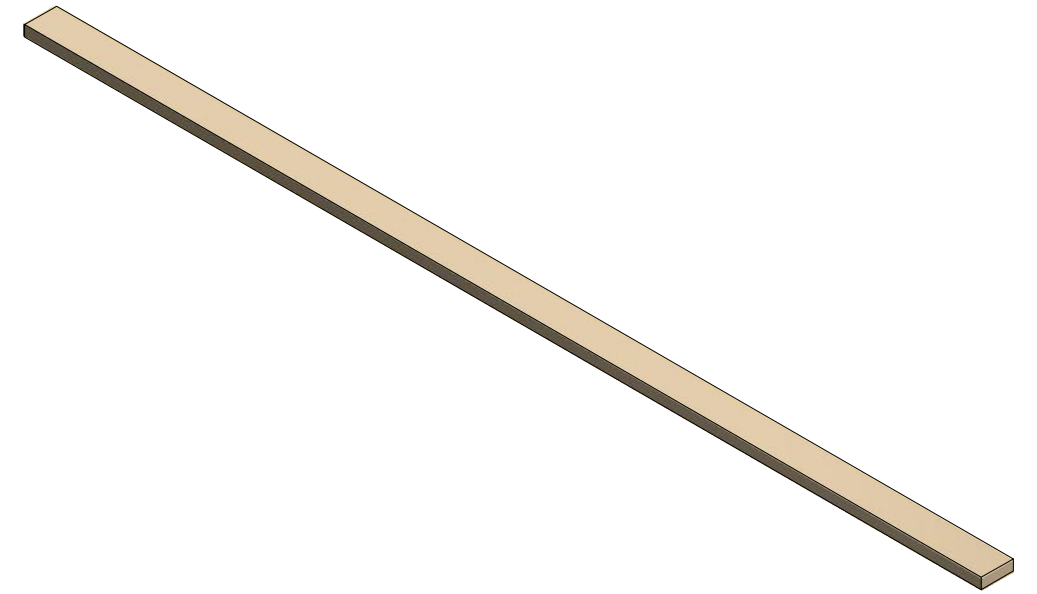


ISO VIEW  
SCALE 1:5



PLAN VIEW  
SCALE 1:5

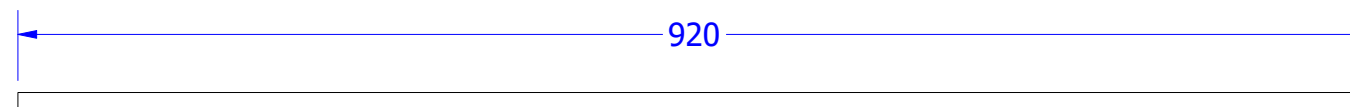

SIDE VIEW  
SCALE 1:5

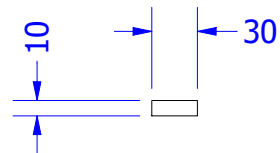

END VIEW  
SCALE 1:5

REMOVE ALL BURRS & SHARP EDGES



THESE DRAWINGS ARE THE PROPERTY OF ULTIMATE ENGINEERING AND SHOULD NOT BE REPRODUCED OR COPIED IN ANY WAY WITHOUT WRITTEN PERMISSION FROM ULTIMATE ENGINEERING

PAINT TREATMENT:



DIMENSION TOLERANCES	
DECIMAL	ANGULAR
X.X = ± .5 mm	X = ± 1°
X.XX = ± .25 mm	X.X = ± .5°
X.XXX = ± .125 mm	X.XX = ± .25°
MAXIMUM FINISHED SURFACE ROUGHNESS U.N.O. 1.6	

PARENT ASSEMBLY

DRAWN: David Bilney

DESIGNED: David Bilney

DATE: 17/03/2021

CUSTOMER: RAB ENGINEERING

TITLE: P1948-000-24  
CHAIN CONVEYORS

DWG NO: 194801/31

JOB NO:

SCALE: Scale 30 OF 31




SHEET SIZE: A3

REV: 1

DRAWN BY ULTIMATE ENGINEERING PTY LTD Ph 8562 1511

DO NOT SCALE DRAWING

24RND BAR @ 50mm	Steel, Mild	AS1443 - 1020
DESCRIPTION	MATERIAL	COMMENTS

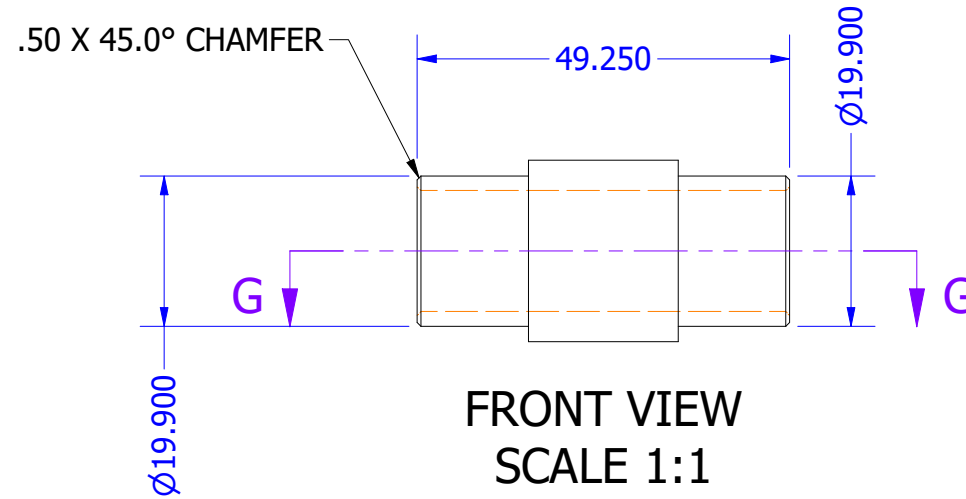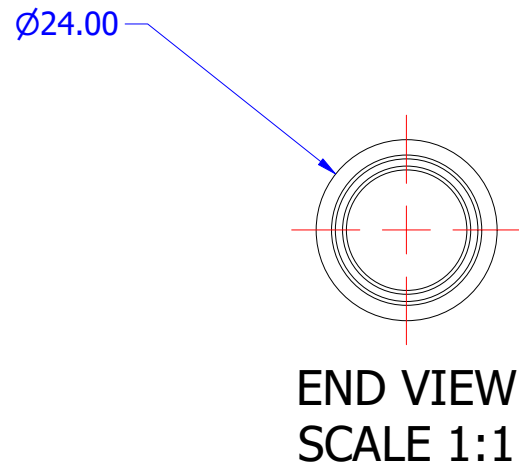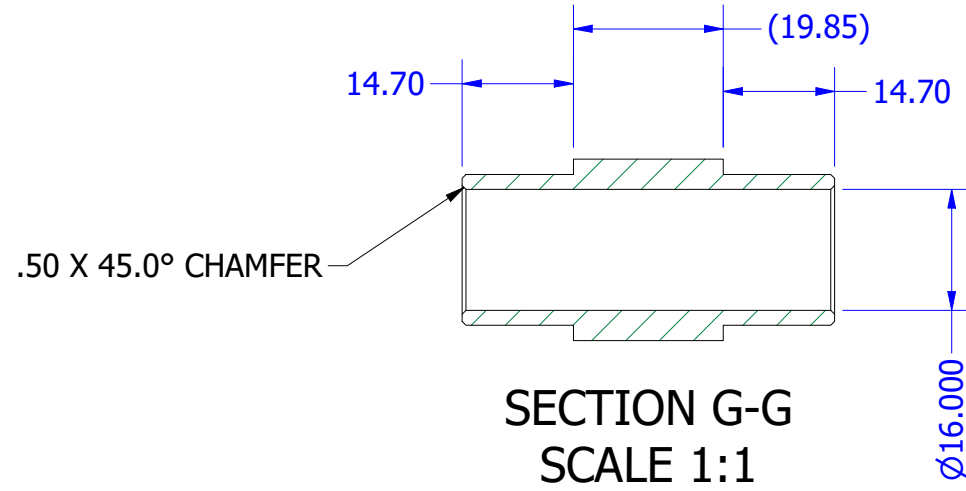


REMOVE ALL BURRS & SHARP EDGES



THESE DRAWINGS ARE THE PROPERTY OF ULTIMATE ENGINEERING AND SHOULD NOT BE REPRODUCED OR COPIED IN ANY WAY WITHOUT WRITTEN PERMISSION FROM ULTIMATE ENGINEERING

PAINT TREATMENT:

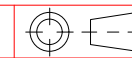

DIMENSION TOLERANCES	
DECIMAL	ANGULAR
X.X = ± .5 mm	X = ± 1°
X.XX = ± .25 mm	X.X = ± .5°
X.XXX = ± .125 mm	X.XX = ± .25°
MAXIMUM FINISHED SURFACE ROUGHNESS U.N.O. 1.6	

PARENT ASSEMBLY

DRAWN: David Bilney

DESIGNED: David Bilney

DATE: 17/03/2021

CUSTOMER: RAB ENGINEERING

TITLE: P1948-000-29  
CHAIN CONVEYORS

DWG NO: 194801/34


JOB NO:

SCALE: Scale 31 OF 31

SHEET SIZE: A3

REV: 1

DO NOT SCALE DRAWING

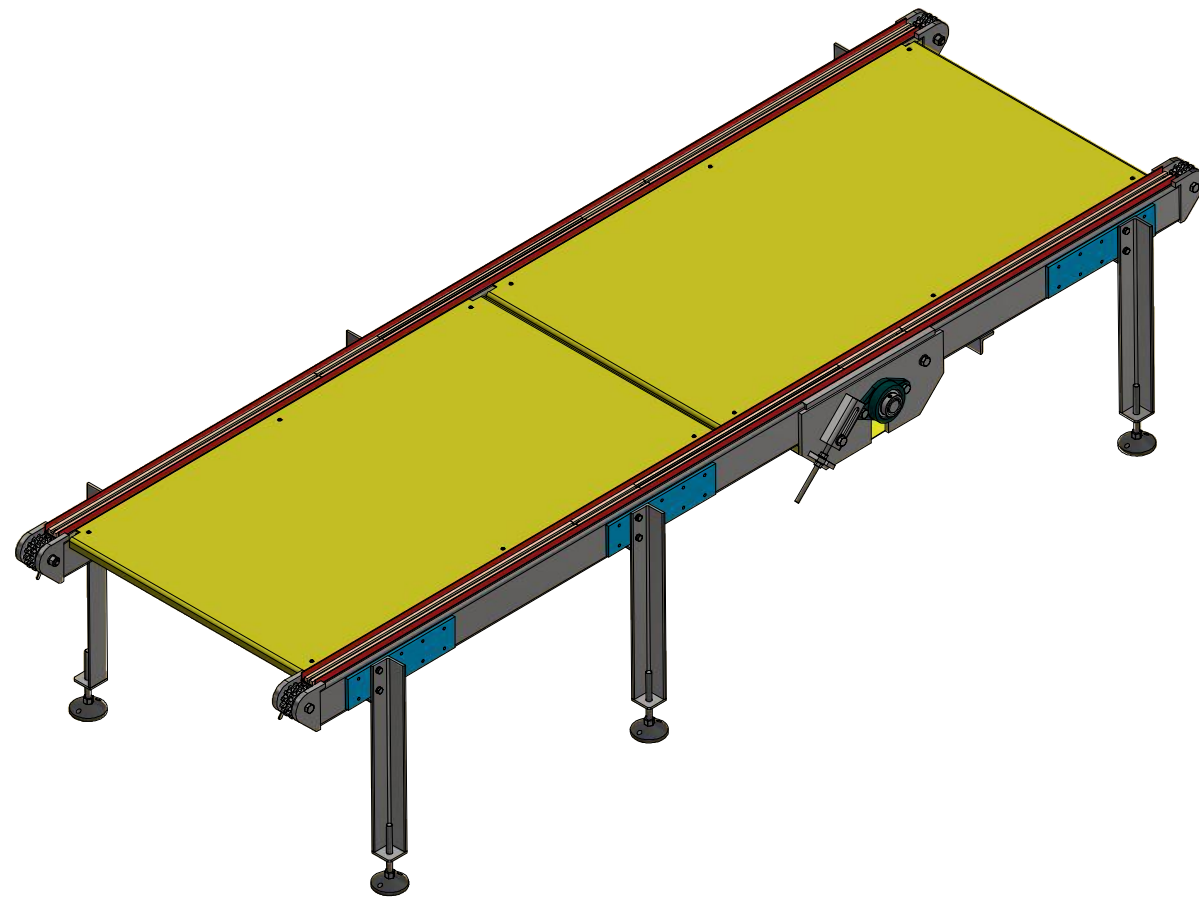

ISO VIEW  
SCALE 1:20

38	14 TOOTH DOUBLE ROW IDLER		REFER SHEET 3	8
37	21T DRIVE SPROCKET	12B2-21 FENNER	194810	2
36	KA67_DRN90S4		SEW MOTOR/ GEARDRIVE	1
35	AS 1110 - M12 x 25	Steel, Mild	HEX HEAD BOLT	6
34	AS 1968 - 1976 - 12	Steel, Mild	SPRING WASHER	6
33	AS 1110 - M16 x 55	Steel, Mild	HEX HEAD BOLT	4
32	LDK-FL210. UC210D1 & H2309		2 BOLT PILLOW BLOCK	2
31	LVR10016140B	Steel, Mild	ADJUSTABLE FOOT	6
30	AS 1110 - M10 x 20	Steel, Mild	HEX HEAD BOLT	12
29	AS 1968 - 1976 - 10	Steel, Mild	SPRING WASHER	12
28	AS 1110 - M8 x 16	Steel, Mild	HEX HEAD BOLT	4
27	AS 1968 - 1976 - 8	Steel, Mild	SPRING WASHER	4
26	W1948-000-05		SHEET 8	1
25	W1948-000-04		SHEET 7	1
24	M5 x 16 BUTTON HEAD	Steel		22
23	ASME/ANSI B18.3.5M - M5x16(2)	Steel, Mild	C/SUNK SOCKET HEAD SCREW	8
22	P1948-000-23	HDPE	SHEET 31	2
21	P1948-000-24	HDPE	SHEET 32	2
20	P1948-000-15	HDPE	SHEET 29	8
19	AS 1285 - M16	Steel, Mild	NYLOCK NUT	4
18	AS 1111 - M16 x 140	Steel, Mild	HEX HEAD BOLT	2
17	AS 1111 - M16 x 110	Steel, Mild	HEX HEAD BOLT	6
16	AS 1112 - M12	Steel, Mild	HEX NUT	4
15	P1948-000-11	Steel, Mild	SHEET 26	2
14	AS 1237 - 12 mm(3)	Steel, Mild	FLAT WASHER	4
13	P1948-000-10	Steel, Mild	SHEET 25	4
12	P1948-000-09	Steel, Mild	SHEET 24	4
11	AS 1968 - 1976 - 16	Steel, Mild	SPRING WASHER	9
10	AS 1237 - 16 mm	Steel, Mild	FLAT WASHER	13
9	AS 1110 - M16 x 50	Steel, Mild	HEX HEAD BOLT	1
8	P1948-000-12	Steel, Mild	SHEET 27	1
7	P1948-002-01	Steel, Mild	SHEET 13	1
6	W1948-003-02		SHEET 12	1
5	W1948-003-01		SHEET 11	1
4	A1948-003-02		SHEET 9	1
3	A1948-003-03		SHEET 10	1
2	W1948-002-01		SHEET 6	3
1	AS 1112 - M16	Steel, Mild	HEX NUT	15
ITEM	PART NUMBER	MATERIAL	COMMENTS	ITEM QTY

A1948-003-01 - 24 REQ'D AS DRAWN


DRAWN BY ULTIMATE ENGINEERING PTY LTD Ph 8562 1511



REV	DATE	DESCRIPTION	APPRD
1	27/04/2021	AS BUILT	DB
0	7/04/2021	APPROVED FOR MANUFACTURE	PB

THESE DRAWINGS ARE THE PROPERTY OF ULTIMATE ENGINEERING AND SHOULD NOT BE REPRODUCED OR COPIED IN ANY WAY WITHOUT WRITTEN PERMISSION FROM ULTIMATE ENGINEERING

PAINT TREATMENT:

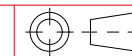

DIMENSION TOLERANCES  
DECIMAL ANGULAR  
X.X = ± .5 mm X = ± 1°  
X.XX = ± .25 mm X.X = ± .5°  
X.XXX = ± .125 mm X.XX = ± .25°  
MAXIMUM FINISHED SURFACE ROUGHNESS U.N.O. 1.6

PARENT ASSEMBLY

DRAWN: David Bilney

DESIGNED: David Bilney

DATE: 18/03/2021

CUSTOMER:

RAB ENGINEERING

TITLE:

A1948-003-01  
CHAIN CONVEYORS

DWG NO:

194803

JOB NO:


SCALE: Noted

SHEET 1 OF 33

SHEET SIZE: A3


REV: 1

DO NOT SCALE DRAWING

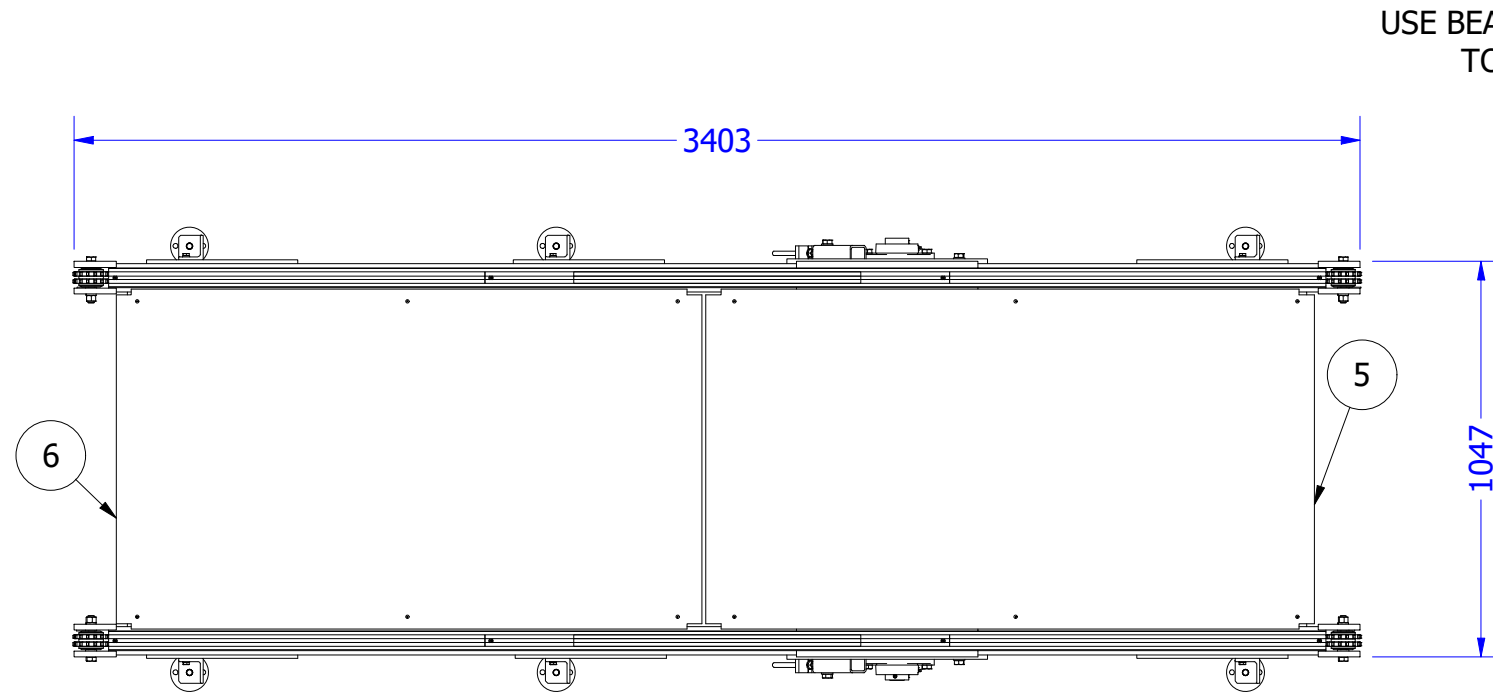


PLAN VIEW  
SCALE 1:20


USE BEARING WITH SLEEVE  
TO SUIT 40mm SHAFT

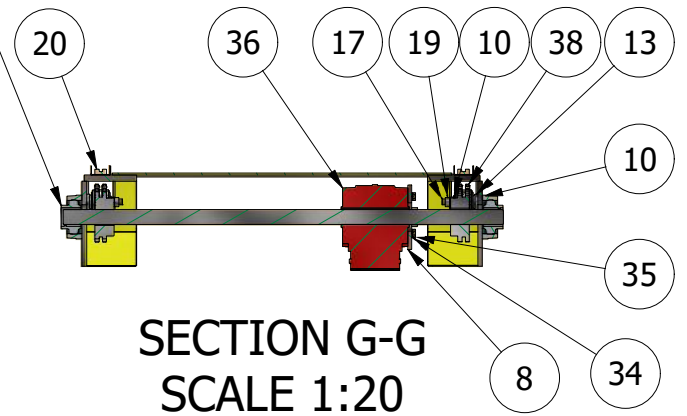

SECTION G-G  
SCALE 1:20

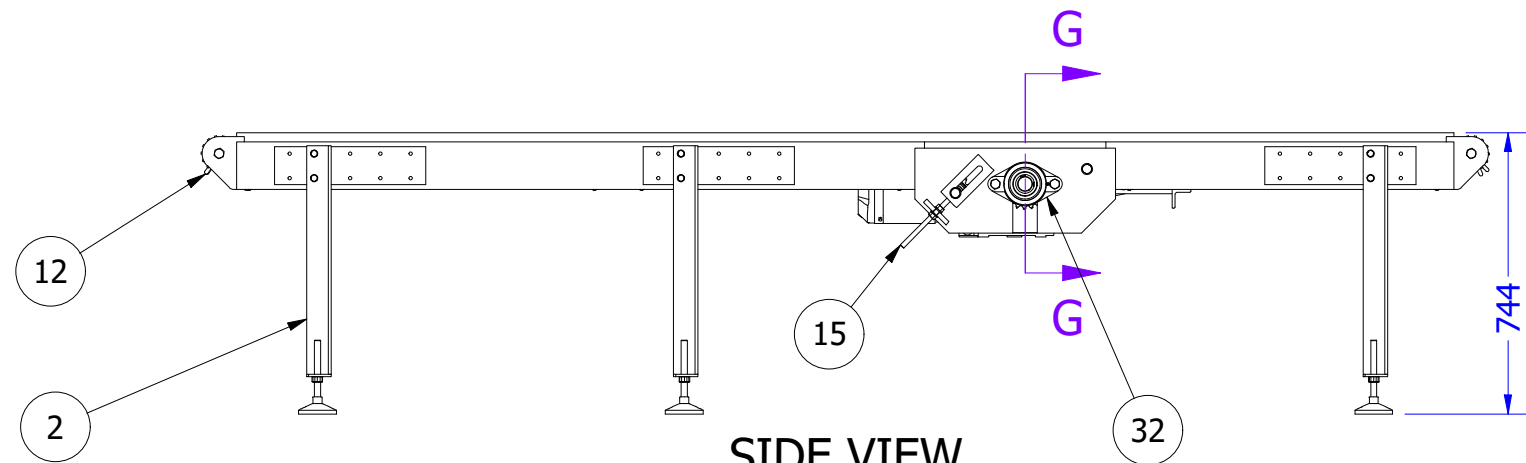

SIDE VIEW  
SCALE 1:20

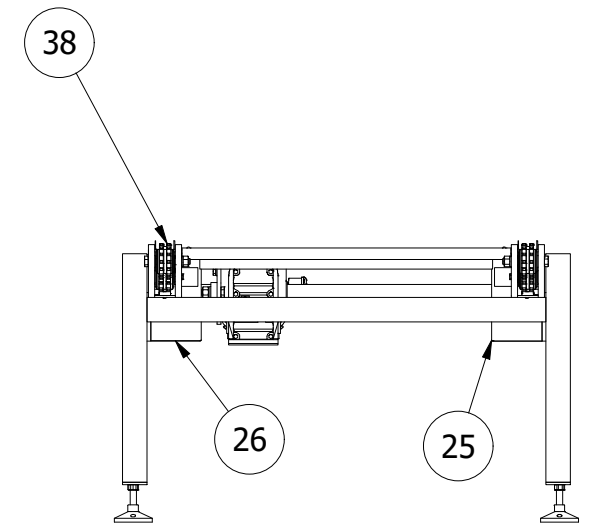


END VIEW  
SCALE 1:20

DRAWN BY ULTIMATE ENGINEERING PTY LTD Ph 8562 1511



THESE DRAWINGS ARE THE PROPERTY OF ULTIMATE ENGINEERING AND SHOULD NOT BE REPRODUCED OR COPIED IN ANY WAY WITHOUT WRITTEN PERMISSION FROM ULTIMATE ENGINEERING

PAINT TREATMENT:

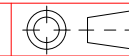

DIMENSION TOLERANCES	
DECIMAL	ANGULAR
X.X = ± .5 mm	X = ± 1°
X.XX = ± .25 mm	X.X = ± .5°
X.XXX = ± .125 mm	X.XX = ± .25°

MAXIMUM FINISHED SURFACE ROUGHNESS U.N.O. 1.6 ✓

PARENT ASSEMBLY

CUSTOMER:

**RAB ENGINEERING**

DRAWN: David Bilney

TITLE:

A1948-003-01  
CHAIN CONVEYORS

DESIGNED: David Bilney

DWG NO:

**194803**

DATE: 18/03/2021

JOB NO:

SCALE:  
Noted

SHEET  
2 OF 33


SHEET SIZE:  
A3

REV:  
1




DO NOT SCALE DRAWING

3	NTN 6304LLUNR		BEARING	2
2	P1948-000-29	Steel, Mild	SHEET 33	1
1	12B2-14 DUPLEX SPROCKET	Steel, Mild		1
ITEM	PART NUMBER	MATERIAL	COMMENTS	ITEM QTY

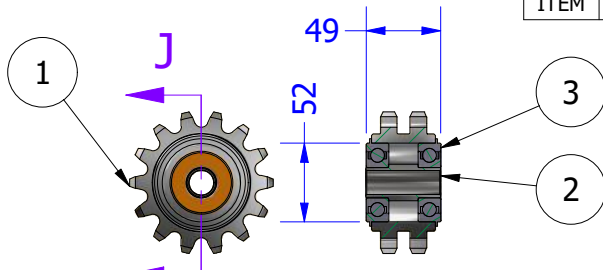

**IDLER SPROCKET ASSY**  
SCALE 1:5

DRILL & TAP M5 ON ASSEMBLY  
APPLIES TO TOP AND BOTTOM  
WEAR STRIPS

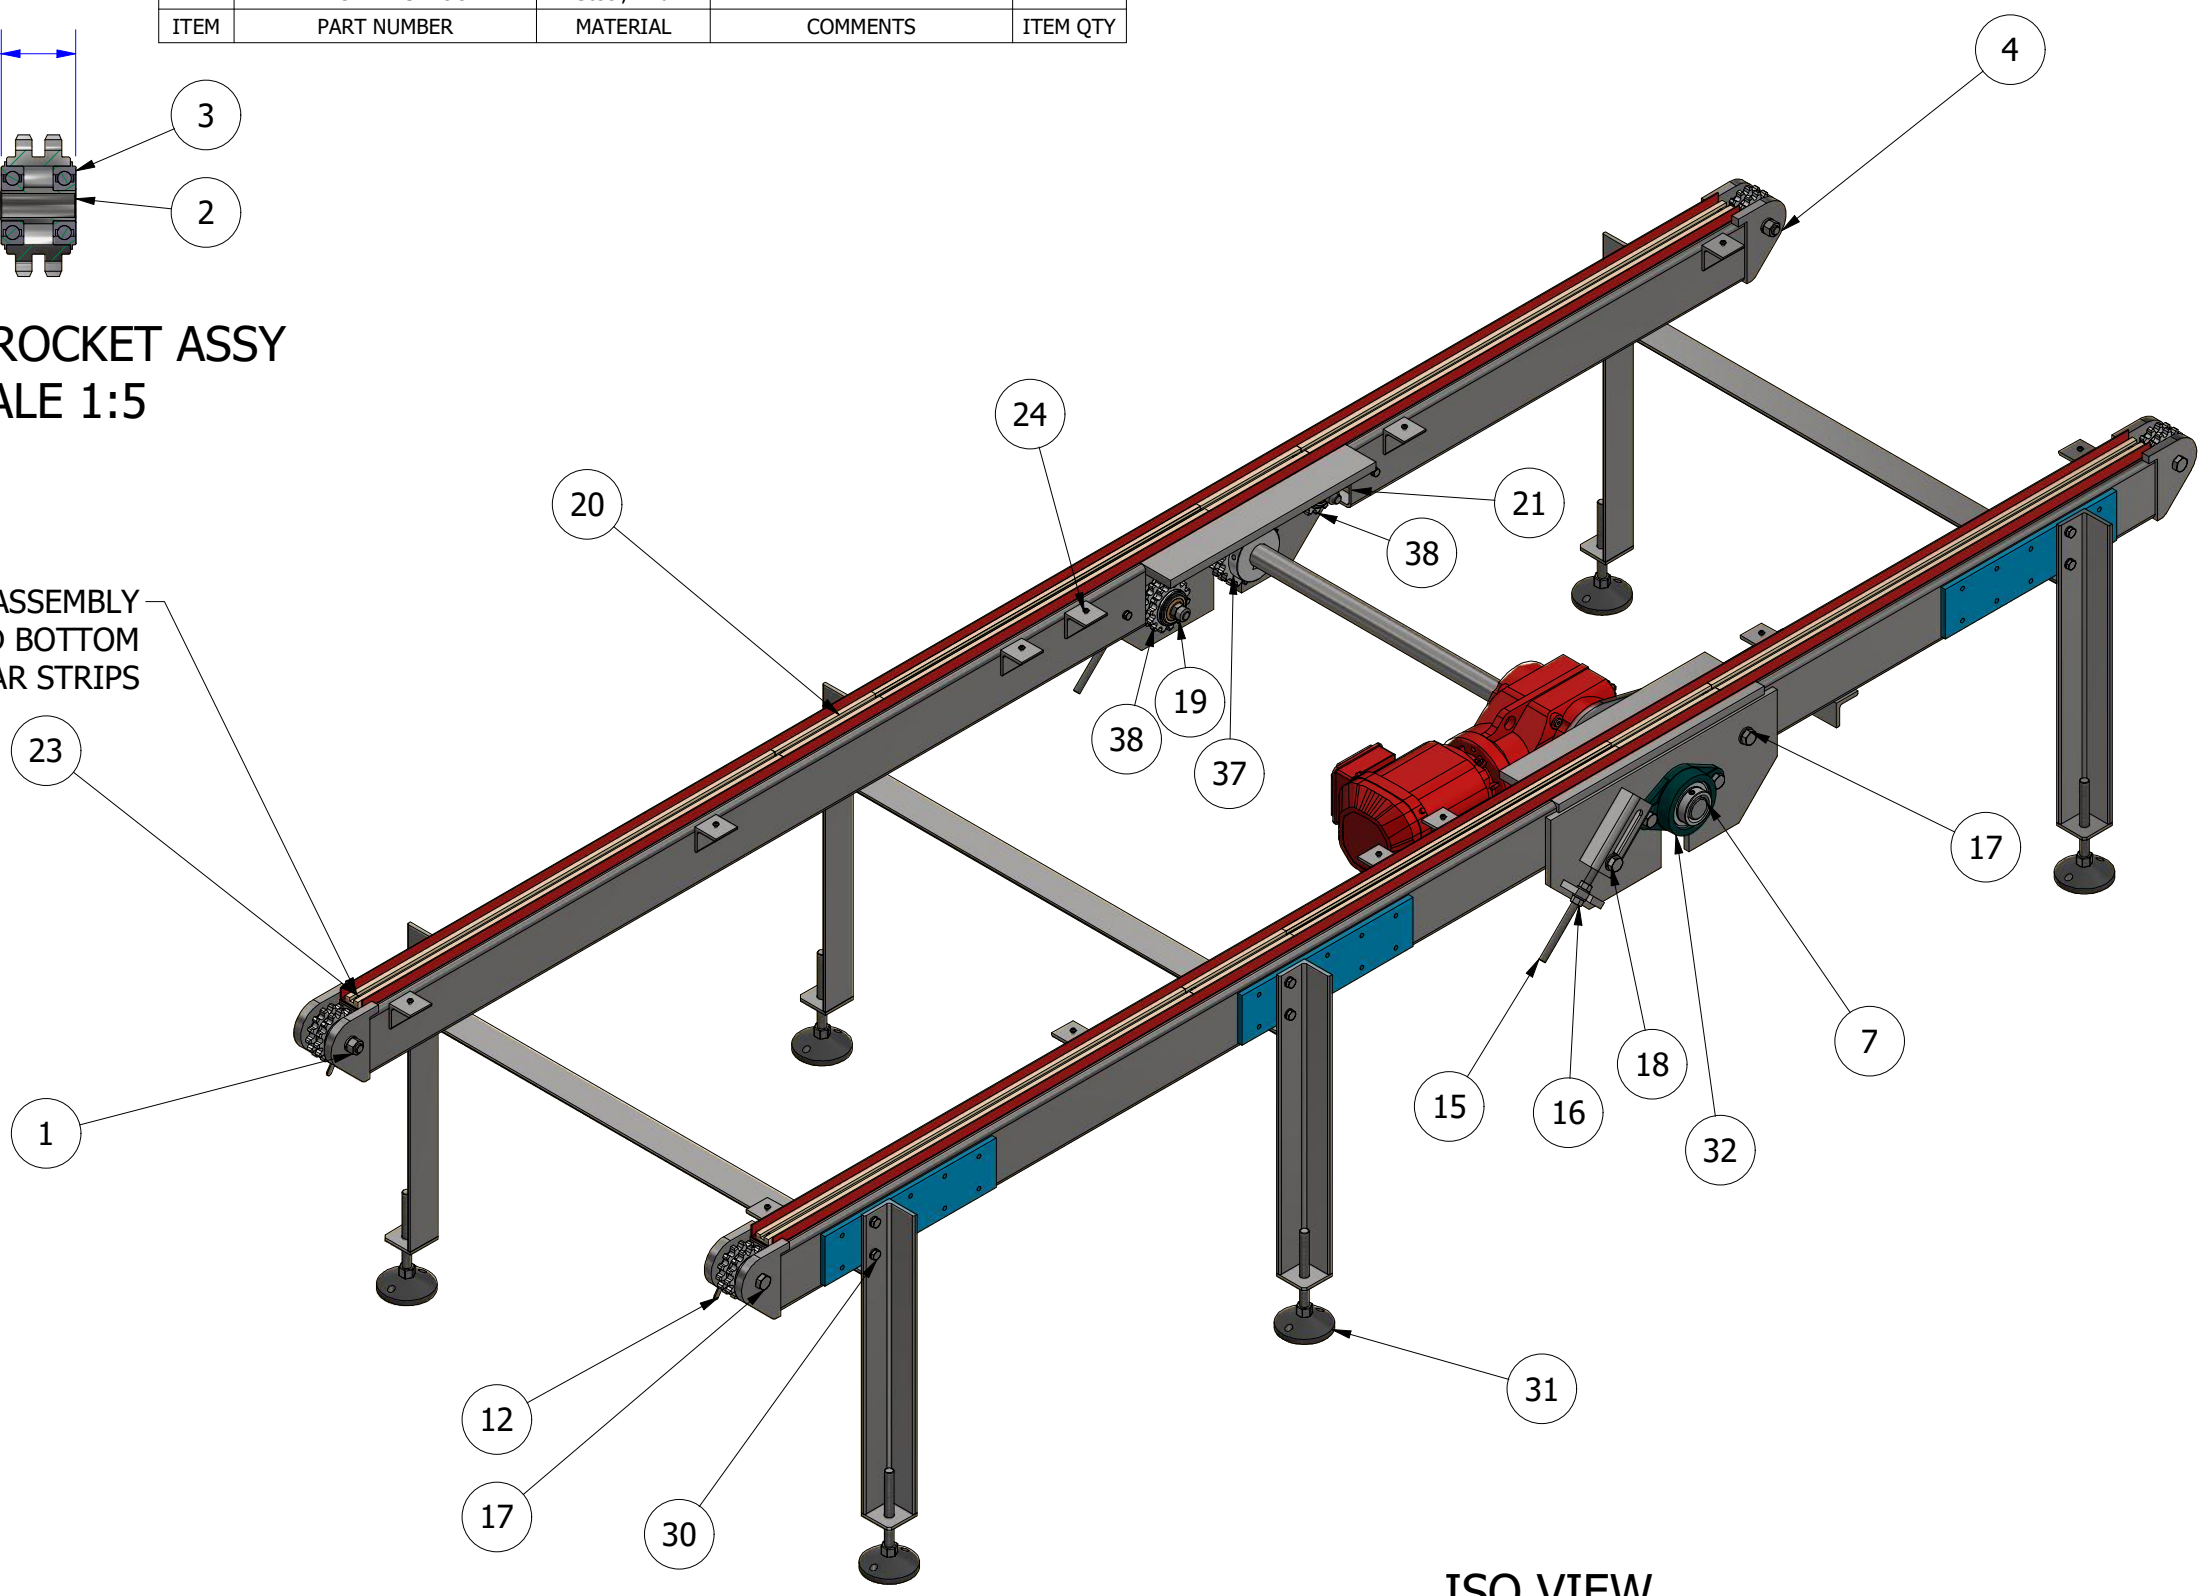

**ISO VIEW**  
**COVERS REMOVED FOR CLARITY**  
**SCALE 1:12.5**

DRAWN BY ULTIMATE ENGINEERING PTY LTD Ph 8562 1511



THESE DRAWINGS ARE THE PROPERTY OF ULTIMATE ENGINEERING AND SHOULD NOT BE REPRODUCED OR COPIED IN ANY WAY WITHOUT WRITTEN PERMISSION FROM ULTIMATE ENGINEERING

PAINT TREATMENT:		
DIMENSION TOLERANCES		
DECIMAL	ANGULAR	
X.X = ± .5 mm	X = ± 1°	
X.XX = ± .25 mm	X.X = ± .5°	
X.XXX = ± .125 mm	X.XX = ± .25°	
MAXIMUM FINISHED SURFACE ROUGHNESS U.N.O. 1.6 ✓		


PARENT ASSEMBLY	CUSTOMER:	<b>RAB ENGINEERING</b>			
DRAWN: David Bilney	TITLE:	A1948-003-01 CHAIN CONVEYORS			
DESIGNED: David Bilney	DWG NO:	<b>194803</b>			
DATE: 18/03/2021	JOB NO:	SCALE: Noted	SHEET 3 OF 33	SHEET SIZE: A3	REV: 1




DO NOT SCALE DRAWING

4	P1948-000-03	Steel, Mild	SHEET 18	1
3	P1948-000-05	Steel, Mild	SHEET 20	2
2	P1948-000-04	Steel, Mild	SHEET 19	1
1	P1948-000-01	Steel, Mild	SHEET 16	1
ITEM	PART NUMBER	MATERIAL	COMMENTS	ITEM QTY


W1948-000-01 - 1 REQ'D AS DRAWN

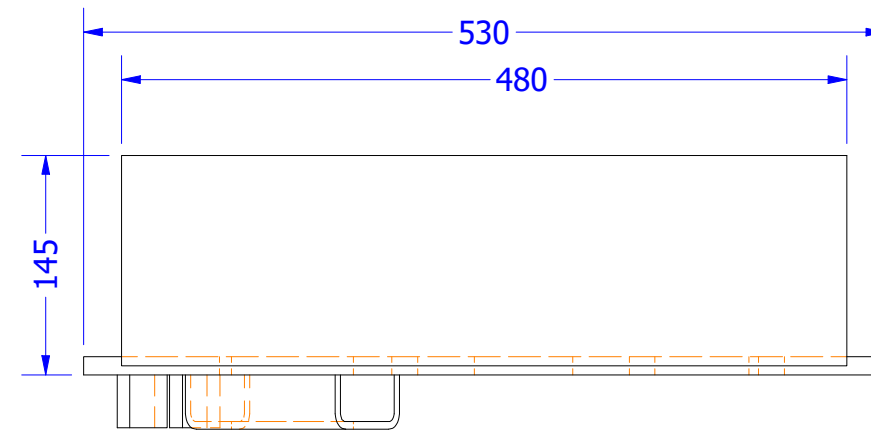


PLAN VIEW  
SCALE 1:5

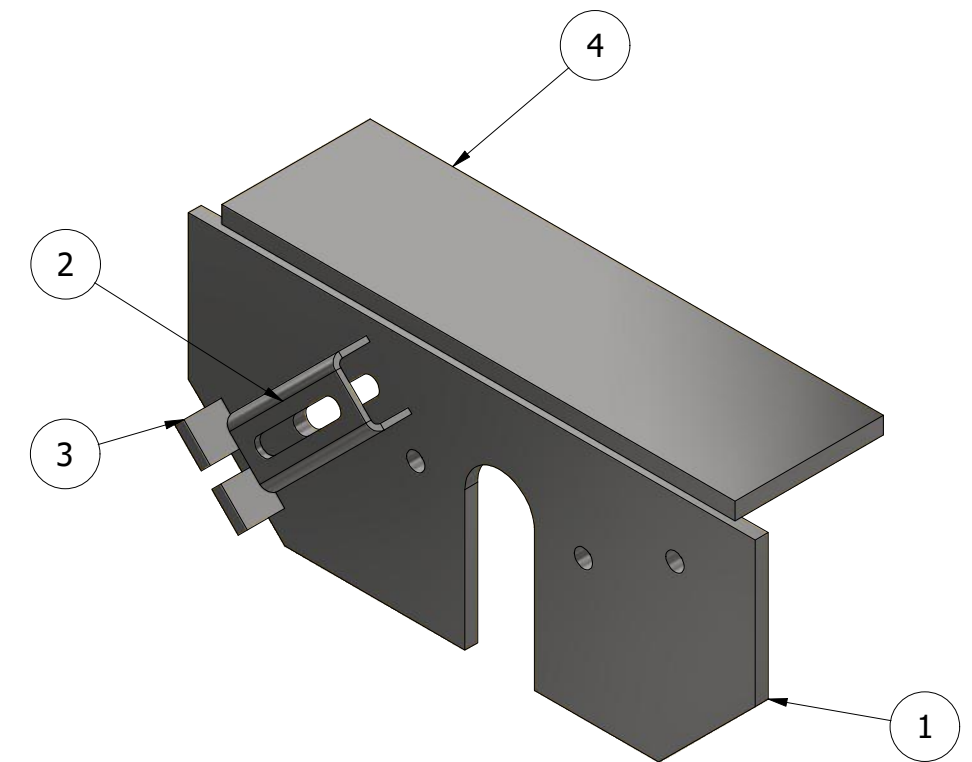

ISO VIEW  
SCALE 1:5

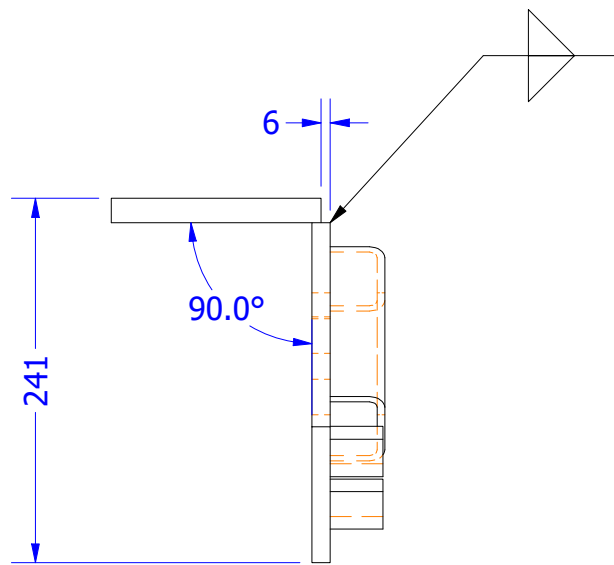

END VIEW  
SCALE 1:5

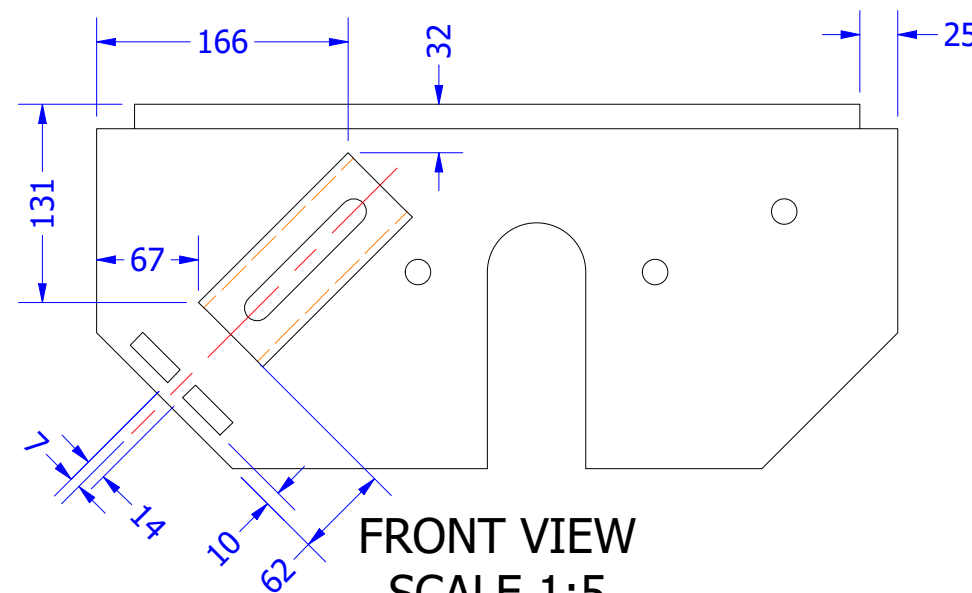

FRONT VIEW  
SCALE 1:5


- NOTES:
- ALL WELDING TO CONFORM TO AS1554-GP UNO
  - ALL FILLET WELDS TO BE 6mm CONTINUOUS UNO
  - ALL BUTT WELDS SHALL BE FULL STRENGTH, COMPLETE PENETRATION WELDS
  - ALL FLAME CUT SURFACES SHALL BE UNIFORM & CLEAN BEFORE WELDING
  - REMOVE ALL BURRS & SHARP EDGES
  - NON DESTRUCTIVE TESTING:
    - A) ALL WELDS, 100% VISUAL SCAN TO AS1554 PART 1
  - FINISH:
    - A) ALL STEELWORK TO BE PRIMED OR COLD GALV UNO

DRAWN BY ULTIMATE ENGINEERING PTY LTD Ph 8562 1511



THESE DRAWINGS ARE THE PROPERTY OF ULTIMATE ENGINEERING AND SHOULD NOT BE REPRODUCED OR COPIED IN ANY WAY WITHOUT WRITTEN PERMISSION FROM ULTIMATE ENGINEERING

PAINT TREATMENT:

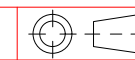

DIMENSION TOLERANCES	
DECIMAL	ANGULAR
X.X = ± .5 mm	X = ± 1°
X.XX = ± .25 mm	X.X = ± .5°
X.XXX = ± .125 mm	X.XX = ± .25°

MAXIMUM FINISHED SURFACE ROUGHNESS U.N.O. 1.6

PARENT ASSEMBLY

CUSTOMER: **RAB ENGINEERING**

DRAWN: David Bilney

TITLE: W1948-000-01  
CHAIN CONVEYORS

DESIGNED: David Bilney

DWG NO: **194801/4**

DATE: 18/03/2021

JOB NO:

SCALE: Noted

SHEET 4 OF 33


SHEET SIZE: A3

REV: 1


DO NOT SCALE DRAWING

4	P1948-000-03	Steel, Mild	SHEET 18	1
3	P1948-000-05	Steel, Mild	SHEET 20	2
2	P1948-000-04	Steel, Mild	SHEET 19	1
1	P1948-000-01	Steel, Mild	SHEET 16	1
ITEM	PART NUMBER	MATERIAL	COMMENTS	ITEM QTY


W1948-000-02 - 1 REQ'D AS DRAWN

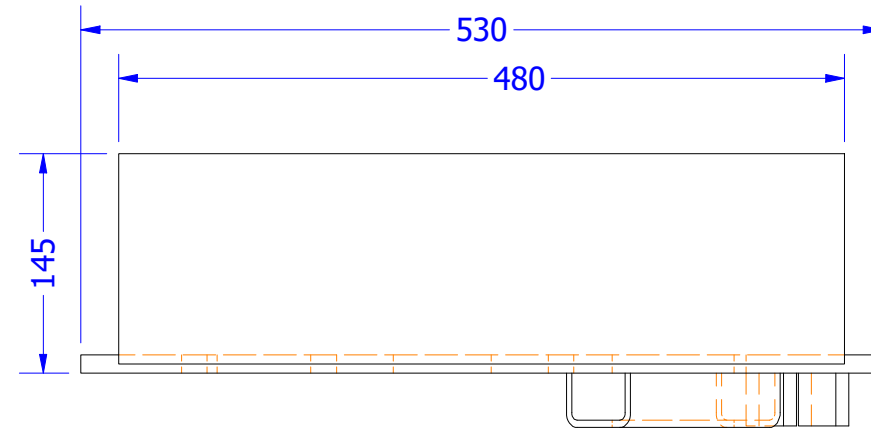


PLAN VIEW  
SCALE 1:5

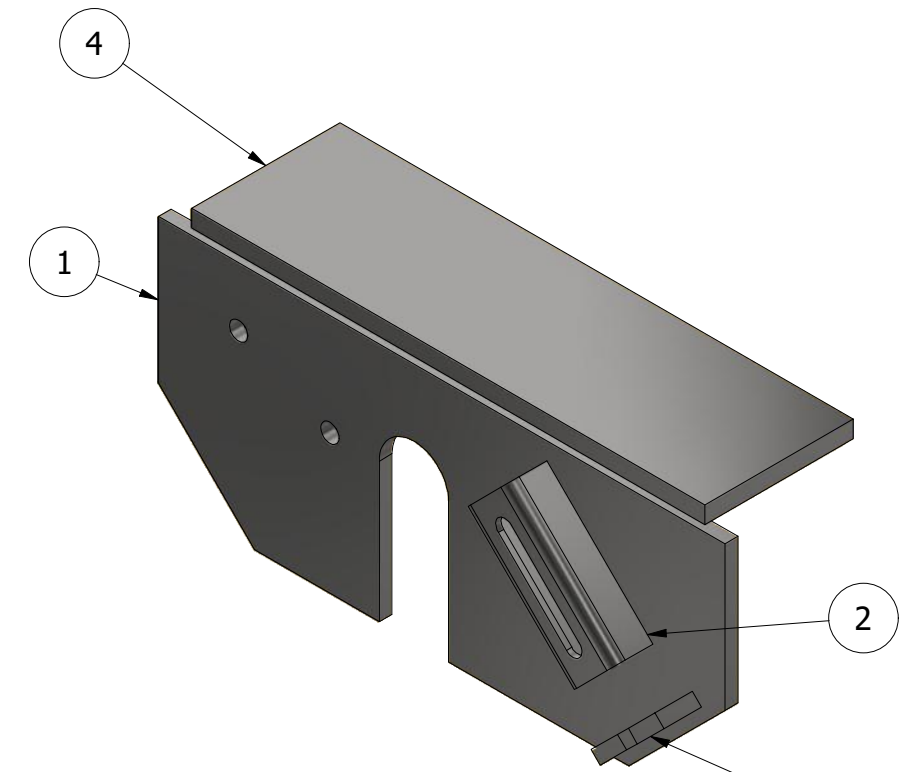

ISO VIEW  
SCALE 1:5

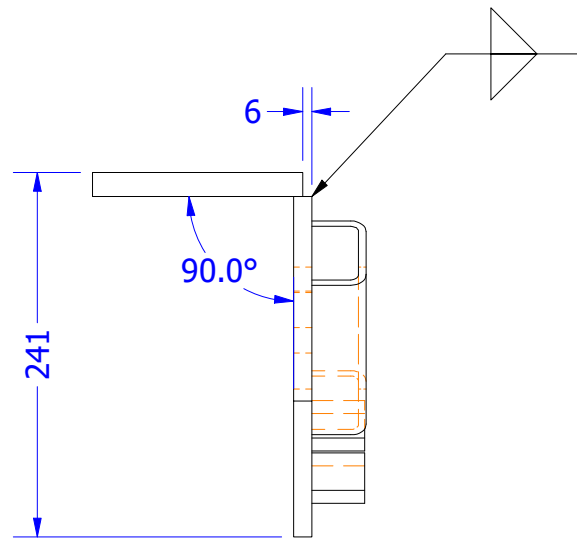

END VIEW  
SCALE 1:5

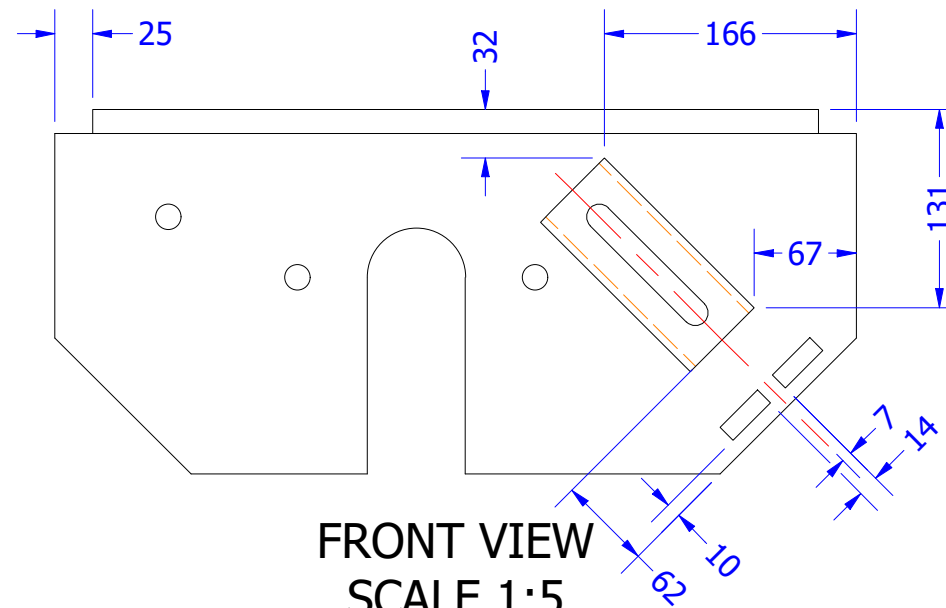

FRONT VIEW  
SCALE 1:5

NOTES:

- ALL WELDING TO CONFORM TO AS1554-GP UNO
- ALL FILLET WELDS TO BE 6mm CONTINUOUS UNO
- ALL BUTT WELDS SHALL BE FULL STRENGTH, COMPLETE PENETRATION WELDS
- ALL FLAME CUT SURFACES SHALL BE UNIFORM & CLEAN BEFORE WELDING
- REMOVE ALL BURRS & SHARP EDGES
- NON DESTRUCTIVE TESTING:
  - A) ALL WELDS, 100% VISUAL SCAN TO AS1554 PART 1
- FINISH:
  - A) ALL STEELWORK TO BE PRIMED OR COLD GALV UNO

DRAWN BY ULTIMATE ENGINEERING PTY LTD Ph 8562 1511



THESE DRAWINGS ARE THE PROPERTY OF ULTIMATE ENGINEERING AND SHOULD NOT BE REPRODUCED OR COPIED IN ANY WAY WITHOUT WRITTEN PERMISSION FROM ULTIMATE ENGINEERING

PAINT TREATMENT:

DIMENSION TOLERANCES	
DECIMAL	ANGULAR
X.X = ± .5 mm	X = ± 1°
X.XX = ± .25 mm	X.X = ± .5°
X.XXX = ± .125 mm	X.XX = ± .25°

MAXIMUM FINISHED SURFACE ROUGHNESS U.N.O. 1.6



PARENT ASSEMBLY

CUSTOMER: **RAB ENGINEERING**

DRAWN: David Bilney

TITLE: W1948-000-02  
CHAIN CONVEYORS

DESIGNED: David Bilney

DWG NO: **194801/5**

DATE: 18/03/2021



JOB NO:

SCALE: Noted  
SHEET 5 OF 33  
SHEET SIZE: A3  
REV: 1


DO NOT SCALE DRAWING

5	65x8 EA @ 604	Steel, Mild		1
4	65x8EA @ 1055	Steel, Mild		1
3	AS 1112 - M16	Steel, Mild	HEX NUT	2
2	P1948-000-08	Steel, Mild	SHEET 23	2
1	65x8 EA @ 604	Steel, Mild		1
ITEM	PART NUMBER	MATERIAL	COMMENTS	ITEM QTY


W1948-002-01 - 3 REQ'D AS DRAWN

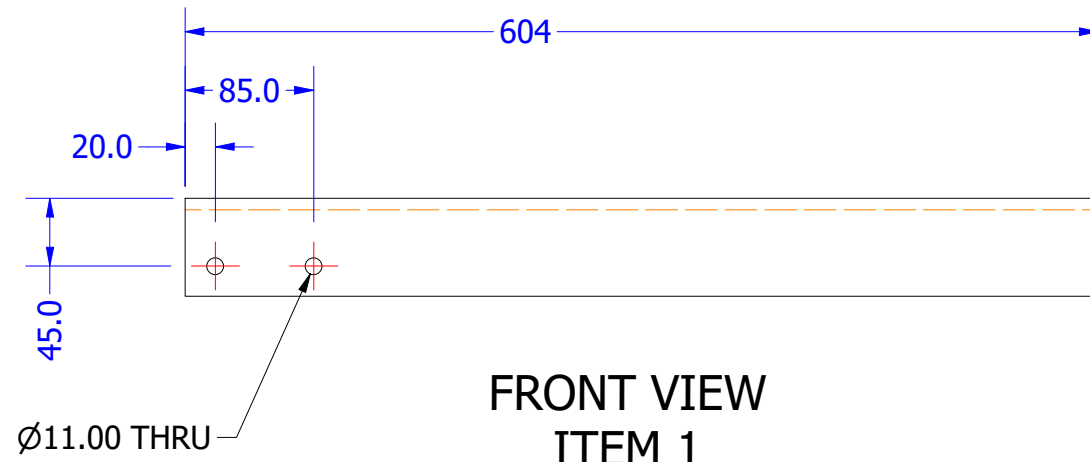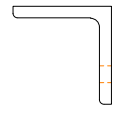


FRONT VIEW  
ITEM 1  
ITEM 5 OPPOSITE  
SCALE 1:5

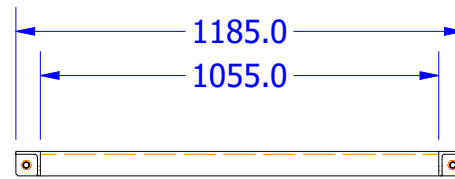


PLAN VIEW  
SCALE 1:20

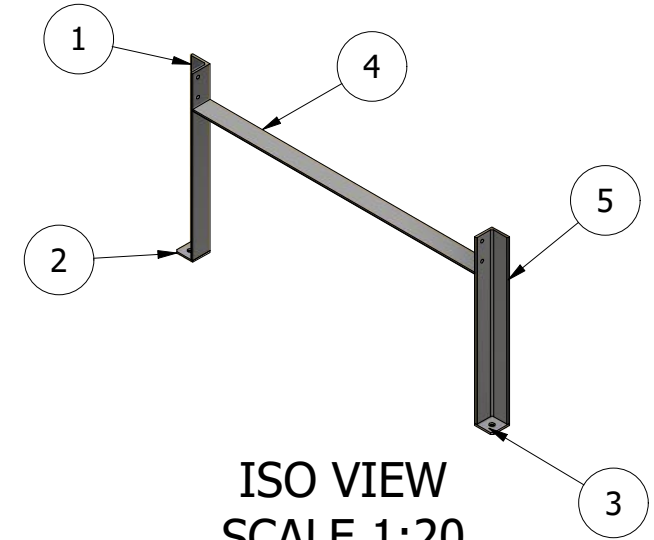

ISO VIEW  
SCALE 1:20

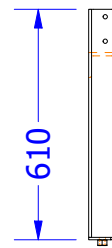

SIDE VIEW  
SCALE 1:20

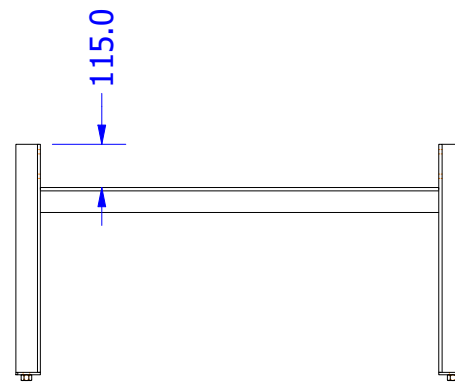

FRONT VIEW  
SCALE 1:20


- NOTES:
- ALL WELDING TO CONFORM TO AS1554-GP UNO
  - ALL FILLET WELDS TO BE 6mm CONTINUOUS UNO
  - ALL BUTT WELDS SHALL BE FULL STRENGTH, COMPLETE PENETRATION WELDS
  - ALL FLAME CUT SURFACES SHALL BE UNIFORM & CLEAN BEFORE WELDING
  - REMOVE ALL BURRS & SHARP EDGES
  - NON DESTRUCTIVE TESTING:  
A) ALL WELDS, 100% VISUAL SCAN TO AS1554 PART 1
  - FINISH:  
A) ALL STEELWORK TO BE PRIMED OR COLD GALV UNO

DRAWN BY ULTIMATE ENGINEERING PTY LTD Ph 8562 1511



THESE DRAWINGS ARE THE PROPERTY OF ULTIMATE ENGINEERING AND SHOULD NOT BE REPRODUCED OR COPIED IN ANY WAY WITHOUT WRITTEN PERMISSION FROM ULTIMATE ENGINEERING

PAINT TREATMENT: GREY

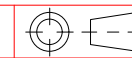

DIMENSION TOLERANCES	
DECIMAL	ANGULAR
X.X = ± .5 mm	X = ± 1°
X.XX = ± .25 mm	X.X = ± .5°
X.XXX = ± .125 mm	X.XX = ± .25°






MAXIMUM FINISHED SURFACE ROUGHNESS U.N.O. 1.6

PARENT ASSEMBLY	CUSTOMER: <b>RAB ENGINEERING</b>
DRAWN: David Bilney	TITLE: W1948-002-01 CHAIN CONVEYORS
DESIGNED: David Bilney	DWG NO: <b>194802</b>
DATE: 18/03/2021	JOB NO:
SCALE: Noted	SHEET: 6 OF 33
	SHEET SIZE: A3
	REV: 1

DO NOT SCALE DRAWING

2	50x3 EA @ 50	Steel, Mild		2
1	P1948-000-16	Steel, Mild	SHEET 30	1
ITEM	PART NUMBER	MATERIAL	COMMENTS	ITEM QTY

W1948-000-04 - 1 REQ'D AS DRAWN

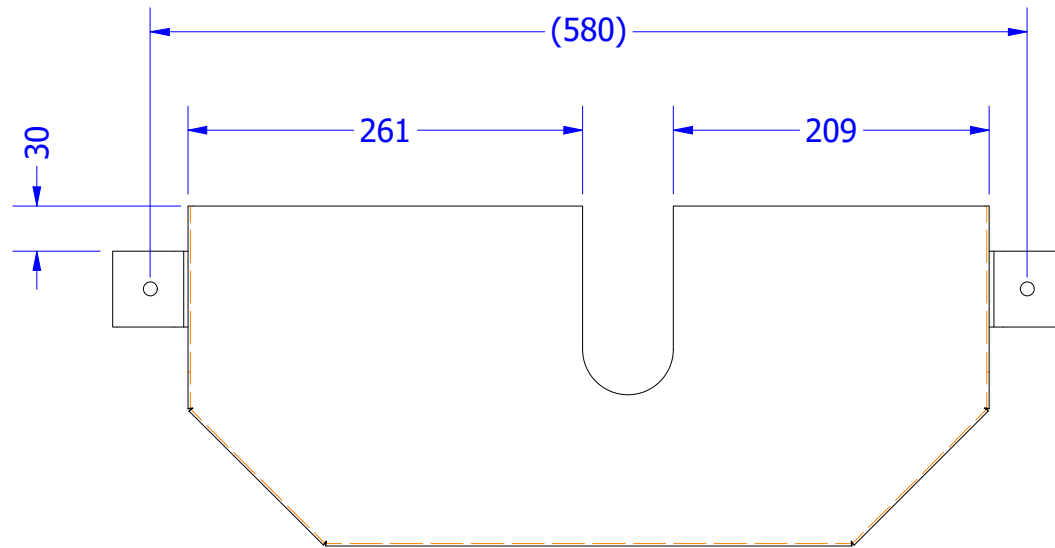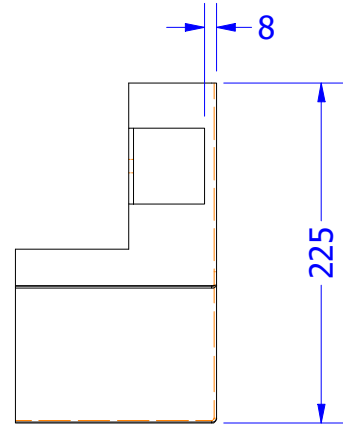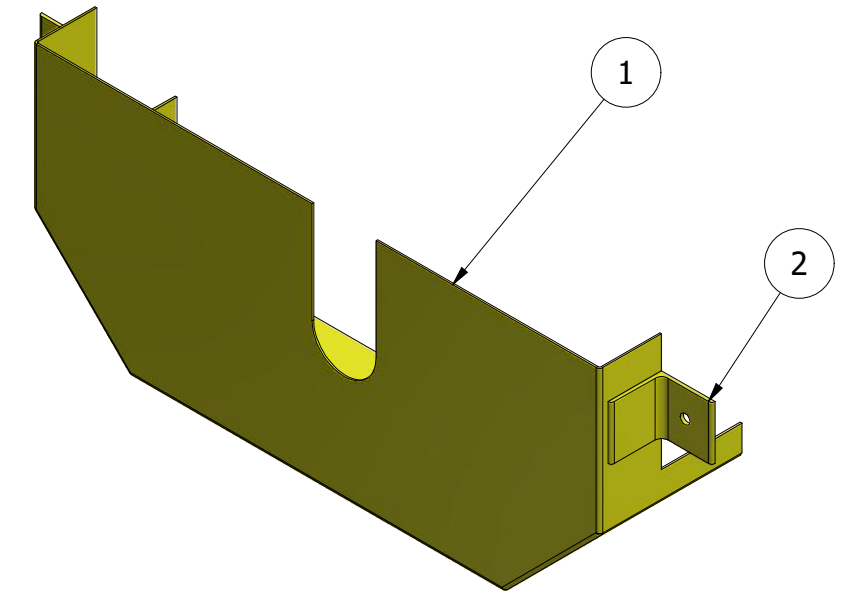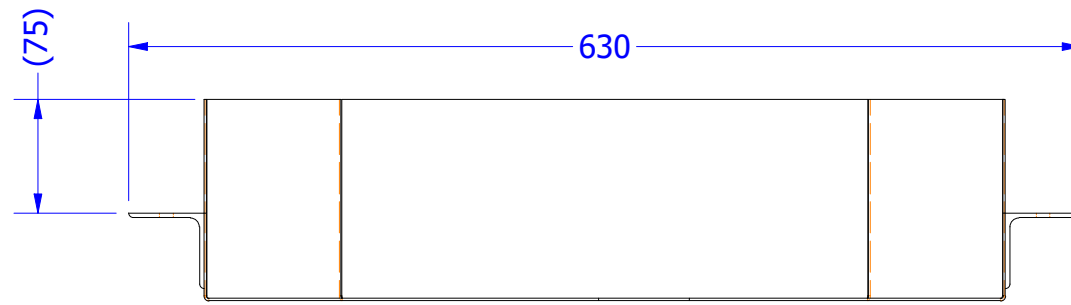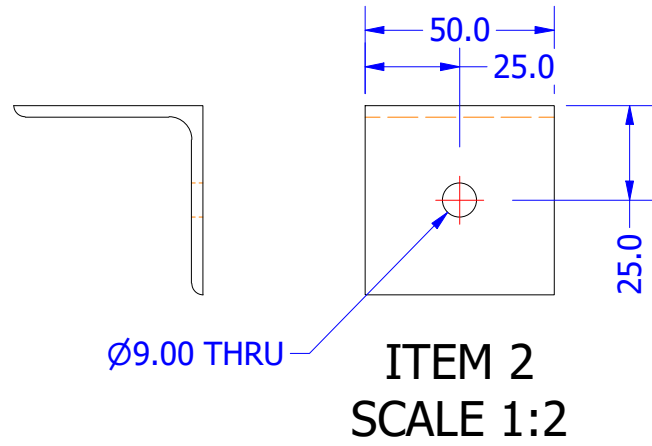

NOTES:


- ALL WELDING TO CONFORM TO AS1554-GP UNO
- ALL FILLET WELDS TO BE 6mm CONTINUOUS UNO
- ALL BUTT WELDS SHALL BE FULL STRENGTH, COMPLETE PENETRATION WELDS
- ALL FLAME CUT SURFACES SHALL BE UNIFORM & CLEAN BEFORE WELDING
- REMOVE ALL BURRS & SHARP EDGES
- NON DESTRUCTIVE TESTING:
  - ALL WELDS, 100% VISUAL SCAN TO AS1554 PART 1
- FINISH:
  - ALL STEELWORK TO BE PRIMED OR COLD GALV UNO

DRAWN BY ULTIMATE ENGINEERING PTY LTD Ph 8562 1511



THESE DRAWINGS ARE THE PROPERTY OF ULTIMATE ENGINEERING AND SHOULD NOT BE REPRODUCED OR COPIED IN ANY WAY WITHOUT WRITTEN PERMISSION FROM ULTIMATE ENGINEERING

PAINT TREATMENT: YELLOW

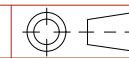

DIMENSION TOLERANCES	
DECIMAL	ANGULAR
X.X = ± .5 mm	X = ± 1°
X.XX = ± .25 mm	X.X = ± .5°
X.XXX = ± .125 mm	X.XX = ± .25°






MAXIMUM FINISHED SURFACE ROUGHNESS U.N.O. 1.6

PARENT ASSEMBLY	CUSTOMER: <b>RAB ENGINEERING</b>
DRAWN: David Bilney	TITLE: W1948-000-04 CHAIN CONVEYORS
DESIGNED: David Bilney	DWG NO: <b>194801/7</b>
DATE: 18/03/2021	JOB NO:
SCALE: Noted	SHEET 7 OF 33
SHEET SIZE: A3	REV: 1

DO NOT SCALE DRAWING

2	50x3 EA @ 50	Steel, Mild		2
1	P1948-000-17	Steel, Mild	SHEET 30	1
ITEM	PART NUMBER	MATERIAL	COMMENTS	ITEM QTY

W1948-000-05 - 1 REQ'D AS DRAWN

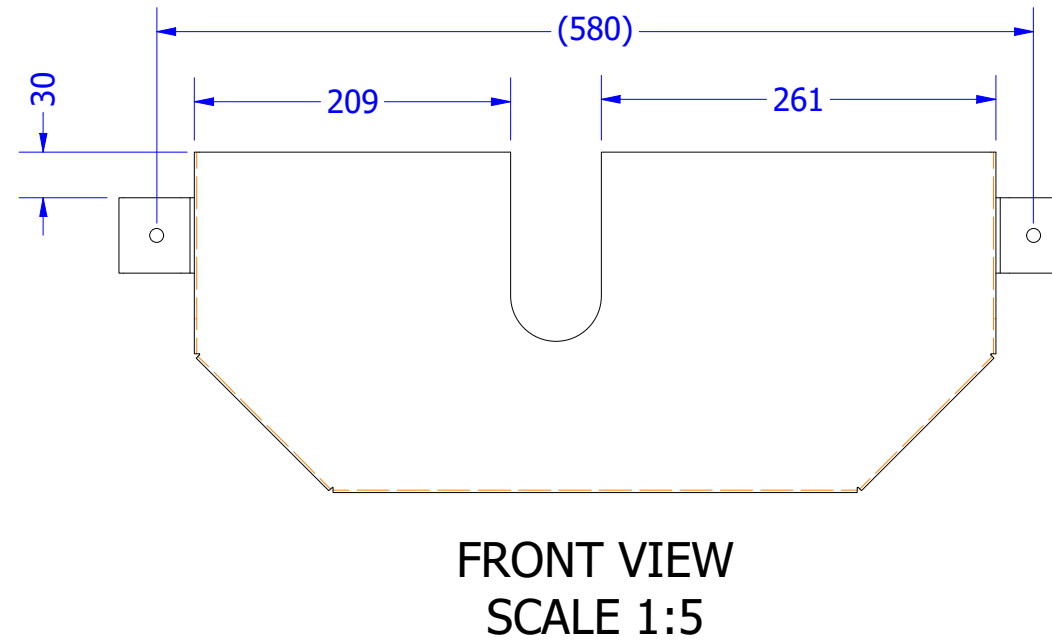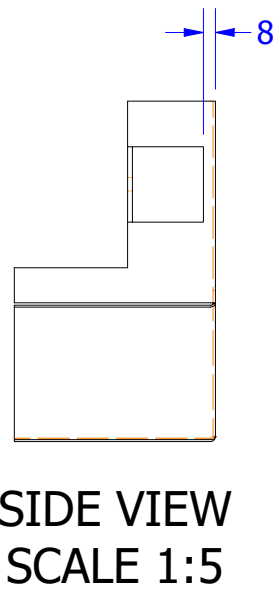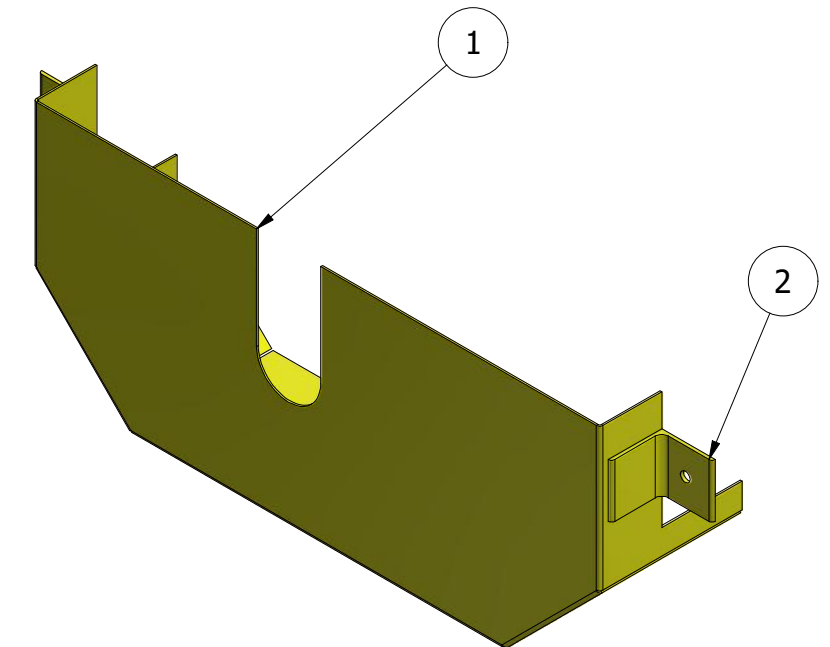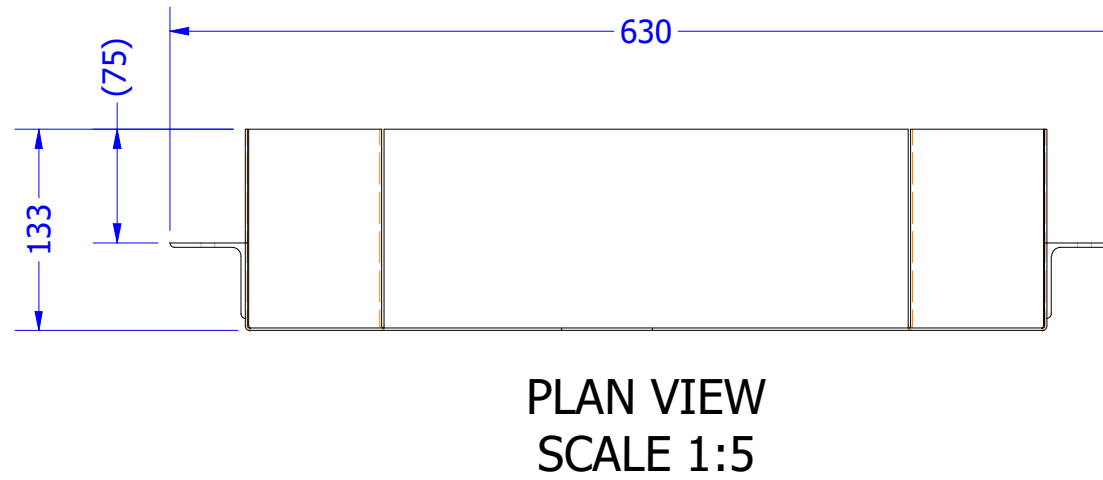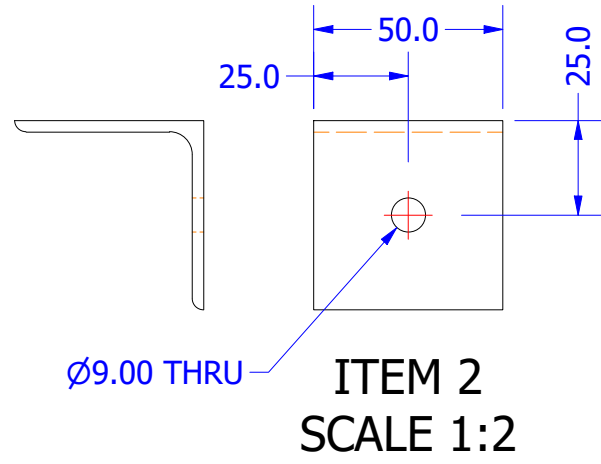

- NOTES:
- ALL WELDING TO CONFORM TO AS1554-GP UNO
  - ALL FILLET WELDS TO BE 6mm CONTINUOUS UNO
  - ALL BUTT WELDS SHALL BE FULL STRENGTH, COMPLETE PENETRATION WELDS
  - ALL FLAME CUT SURFACES SHALL BE UNIFORM & CLEAN BEFORE WELDING
  - REMOVE ALL BURRS & SHARP EDGES
  - NON DESTRUCTIVE TESTING:
    - A) ALL WELDS, 100% VISUAL SCAN TO AS1554 PART 1
  - FINISH:
    - A) ALL STEELWORK TO BE PRIMED OR COLD GALV UNO

DRAWN BY ULTIMATE ENGINEERING PTY LTD Ph 8562 1511




THESE DRAWINGS ARE THE PROPERTY OF ULTIMATE ENGINEERING AND SHOULD NOT BE REPRODUCED OR COPIED IN ANY WAY WITHOUT WRITTEN PERMISSION FROM ULTIMATE ENGINEERING

PAINT TREATMENT: YELLOW	
DIMENSION TOLERANCES DECIMAL                      ANGULAR X.X     = ± .5 mm            X     = ± 1° X.XX    = ± .25 mm          X.X    = ± .5° X.XXX   = ± .125 mm        X.XX   = ± .25°	
MAXIMUM FINISHED SURFACE ROUGHNESS U.N.O. 1.6	

PARENT ASSEMBLY	CUSTOMER: <b>RAB ENGINEERING</b>
DRAWN: David Bilney	TITLE: W1948-000-05 CHAIN CONVEYORS
DESIGNED: David Bilney	DWG NO: <b>194801/8</b>
DATE: 18/03/2021	JOB NO:
SCALE: Noted	SHEET: 8 OF 33
SHEET SIZE: A3	REV: 1









DO NOT SCALE DRAWING

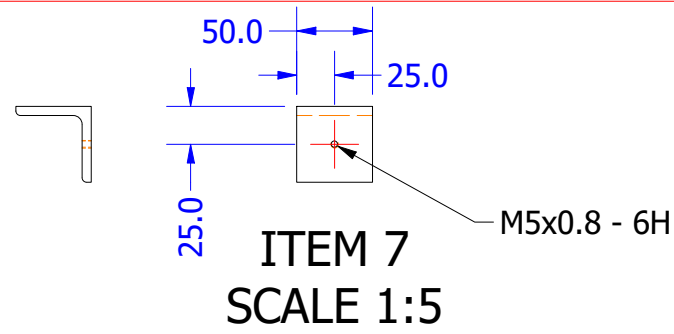

7	125x75x5.0 RHS @ 1820	Steel, Mild		1
6	125x75x5.0 RHS @ 920	Steel, Mild		1
5	50x6 EA @ 50	Steel, Mild		6
4	P1948-000-07	Steel, Mild	SHEET 22	1
3	P1948-000-06	Steel, Mild	SHEET 21	3
2	W1948-000-02	Weldment	SHEET 5	1
1	P1948-000-02	Steel, Mild	SHEET 17	4
ITEM	PART NUMBER	MATERIAL	COMMENTS	ITEM QTY

A1948-003-02 - 1 REQ'D AS DRAWN

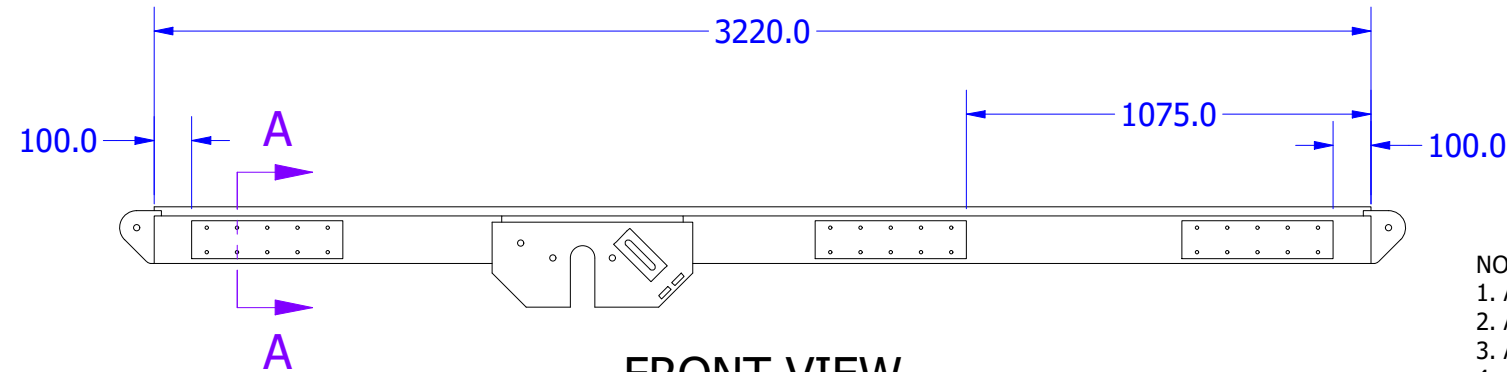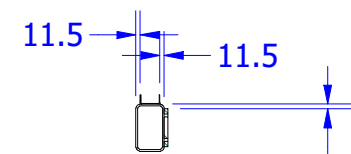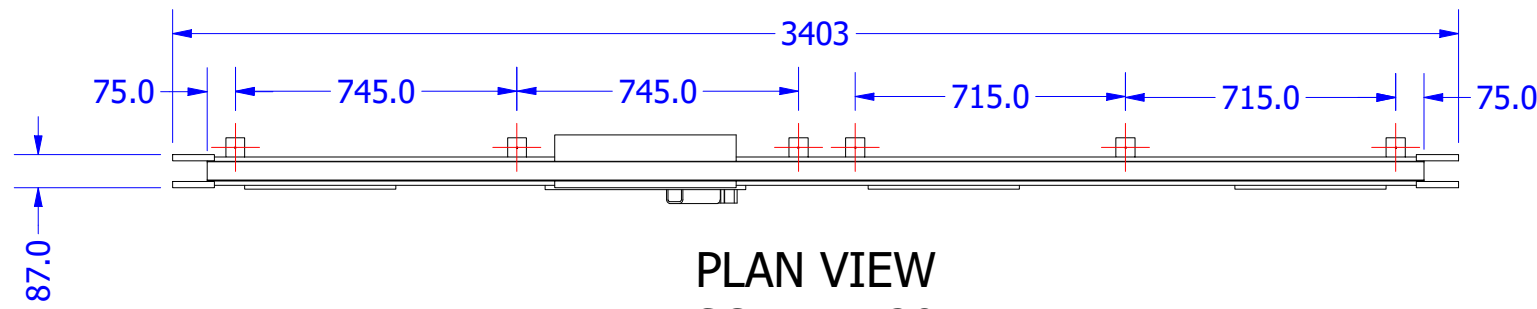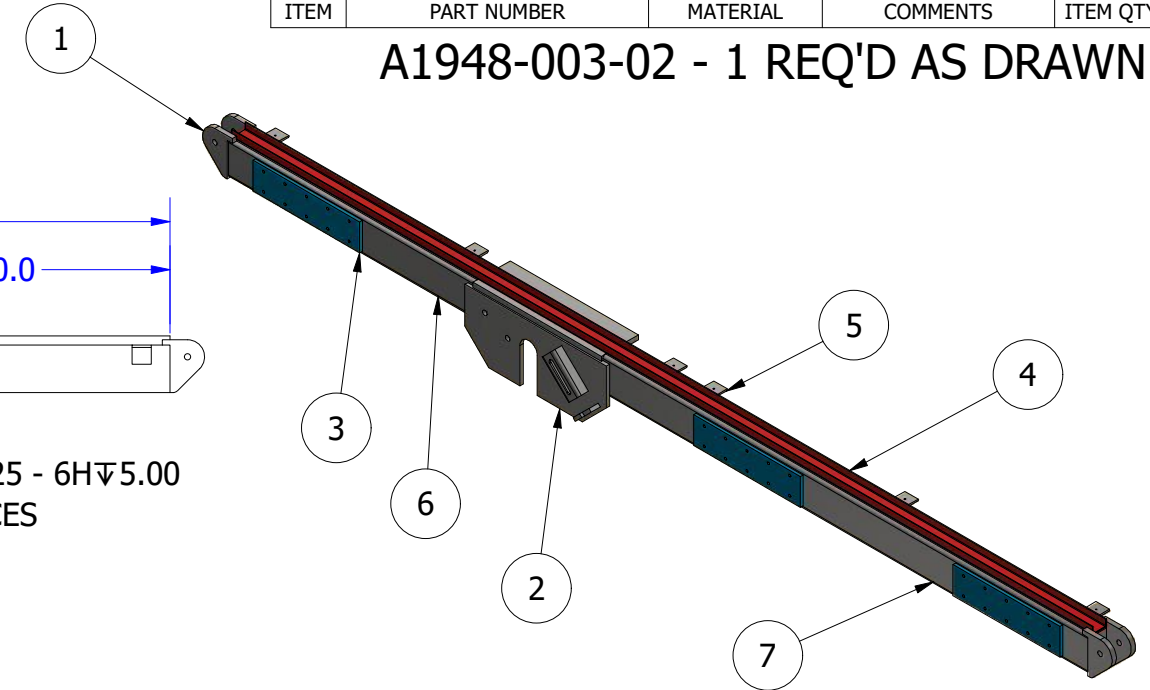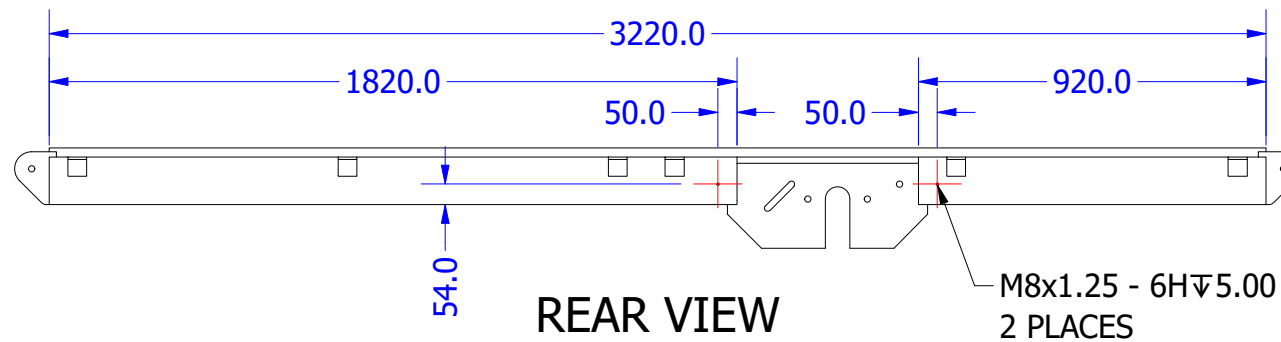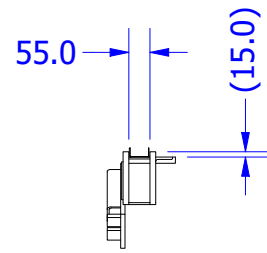


- NOTES:
- ALL WELDING TO CONFORM TO AS1554-GP UNO
  - ALL FILLET WELDS TO BE 6mm CONTINUOUS UNO
  - ALL BUTT WELDS SHALL BE FULL STRENGTH, COMPLETE PENETRATION WELDS
  - ALL FLAME CUT SURFACES SHALL BE UNIFORM & CLEAN BEFORE WELDING
  - REMOVE ALL BURRS & SHARP EDGES
  - NON DESTRUCTIVE TESTING:  
A) ALL WELDS, 100% VISUAL SCAN TO AS1554 PART 1
  - FINISH:  
A) ALL STEELWORK TO BE PRIMED OR COLD GALV UNO

DRAWN BY ULTIMATE ENGINEERING PTY LTD Ph 8562 1511



THESE DRAWINGS ARE THE PROPERTY OF ULTIMATE ENGINEERING AND SHOULD NOT BE REPRODUCED OR COPIED IN ANY WAY WITHOUT WRITTEN PERMISSION FROM ULTIMATE ENGINEERING

PAINT TREATMENT: GREY

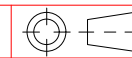

DIMENSION TOLERANCES  
DECIMAL ANGULAR  
X.X = ± .5 mm X = ± 1°  
X.XX = ± .25 mm X.X = ± .5°  
X.XXX = ± .125 mm X.XX = ± .25°  
MAXIMUM FINISHED SURFACE ROUGHNESS U.N.O. 1.6

PARENT ASSEMBLY

CUSTOMER: **RAB ENGINEERING**

DRAWN: David Bilney

TITLE: A1948-003-02  
CHAIN CONVEYORS

DESIGNED: David Bilney

DWG NO: **194803**

DATE: 18/03/2021

JOB NO:







SCALE: Noted SHEET 9 OF 33 SHEET SIZE: A3 REV: 1



DO NOT SCALE DRAWING

ITEM	PART NUMBER	MATERIAL	COMMENTS	ITEM QTY
9	125x75x5.0 RHS @ 920	Steel, Mild		1
8	125x75x5.0 RHS @ 1820	Steel, Mild		1
7	50x8 EA @ 175	Steel, Mild		1
6	50x6 EA @ 50	Steel, Mild	REFER SHEET 9	6
5	P1948-000-13	Steel, Mild	SHEET 28	1
4	P1948-000-07	Steel, Mild	SHEET 22	1
3	P1948-000-06	Steel, Mild	SHEET 21	3
2	W1948-000-01	Weldment	SHEET 4	1
1	P1948-000-02	Steel, Mild	SHEET 17	4

A1948-003-03 - 1 REQ'D AS DRAWN

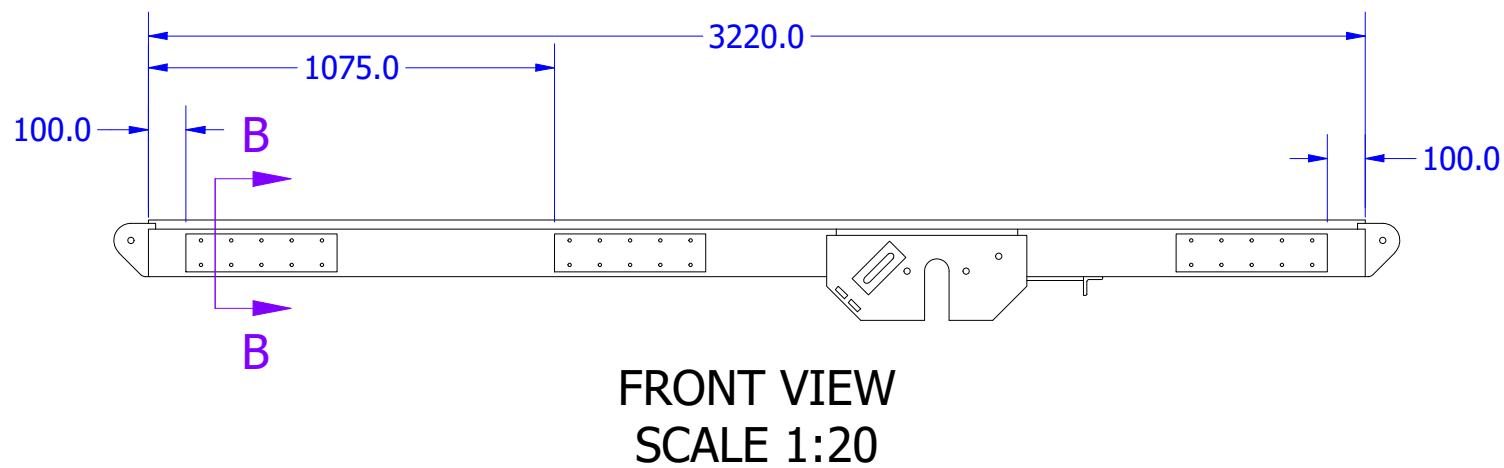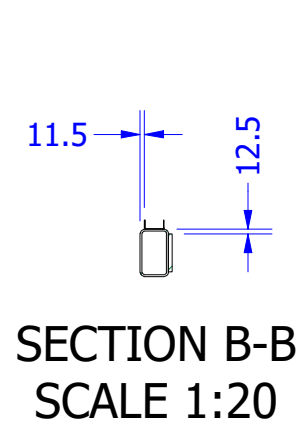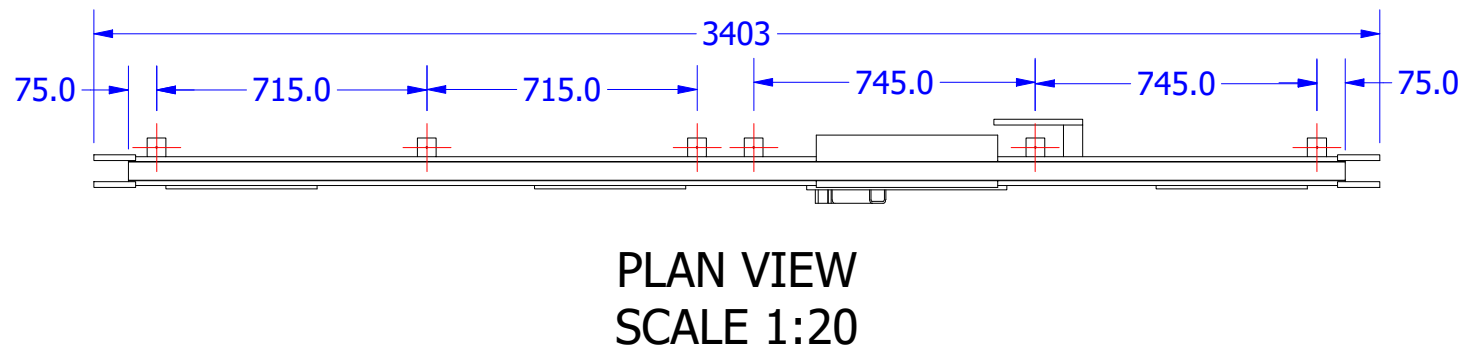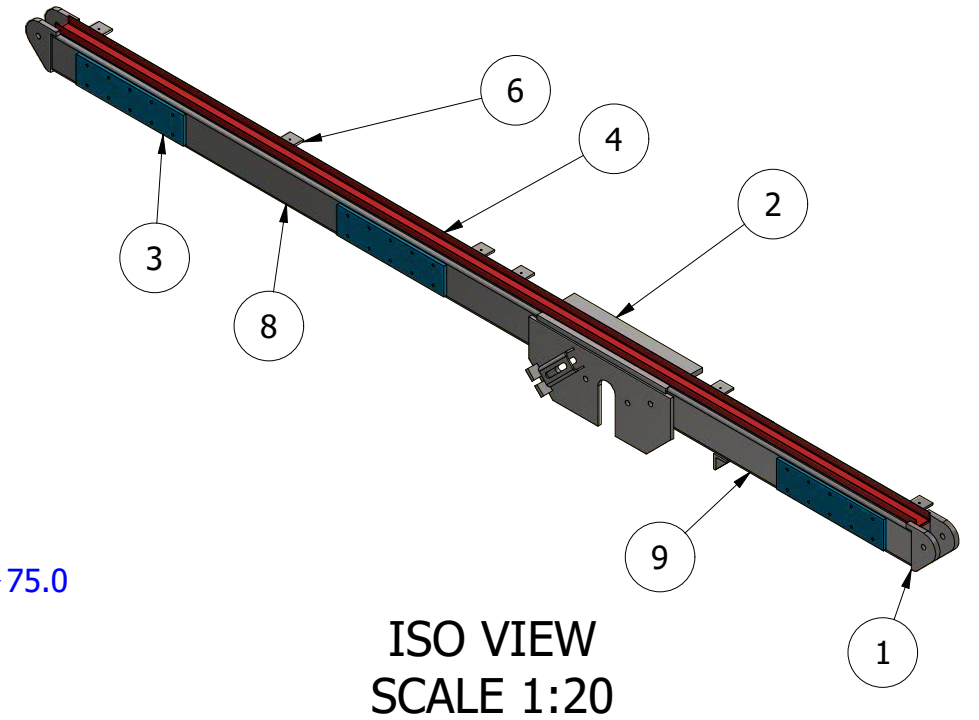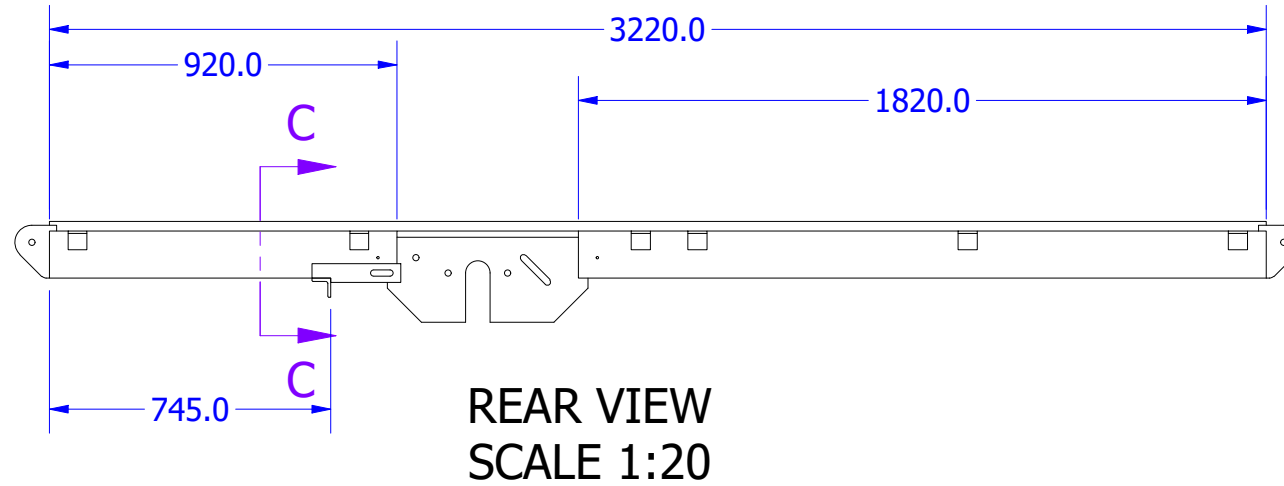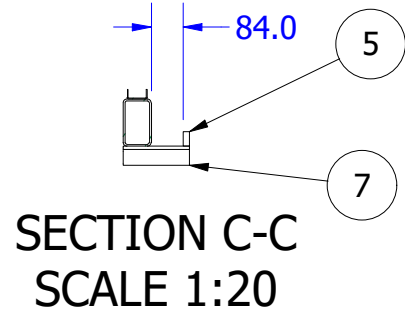

NOTES:


- ALL WELDING TO CONFORM TO AS1554-GP UNO
- ALL FILLET WELDS TO BE 6mm CONTINUOUS UNO
- ALL BUTT WELDS SHALL BE FULL STRENGTH, COMPLETE PENETRATION WELDS
- ALL FLAME CUT SURFACES SHALL BE UNIFORM & CLEAN BEFORE WELDING
- REMOVE ALL BURRS & SHARP EDGES
- NON DESTRUCTIVE TESTING:
  - ALL WELDS, 100% VISUAL SCAN TO AS1554 PART 1
- FINISH:
  - ALL STEELWORK TO BE PRIMED OR COLD GALV UNO

DRAWN BY ULTIMATE ENGINEERING PTY LTD Ph 8562 1511



THESE DRAWINGS ARE THE PROPERTY OF ULTIMATE ENGINEERING AND SHOULD NOT BE REPRODUCED OR COPIED IN ANY WAY WITHOUT WRITTEN PERMISSION FROM ULTIMATE ENGINEERING

PAINT TREATMENT: GREY

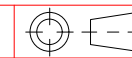

DIMENSION TOLERANCES  
 DECIMAL ANGULAR  
 X.X = ± .5 mm X = ± 1°  
 X.XX = ± .25 mm X.X = ± .5°  
 X.XXX = ± .125 mm X.XX = ± .25°  
 MAXIMUM FINISHED SURFACE ROUGHNESS U.N.O. 1.6

PARENT ASSEMBLY

CUSTOMER:

RAB ENGINEERING

DRAWN: David Bilney

TITLE:

A1948-003-03  
CHAIN CONVEYORS

DESIGNED: David Bilney

DWG NO:

194803

DATE: 18/03/2021

JOB NO:

SCALE: Noted

SHEET 10 OF 33


SHEET SIZE: A3

REV: 1


DO NOT SCALE DRAWING

2	50x5 EA @ 775	Aluminum 6061		1
1	P1948-003-02	Aluminum 5052	SHEET 14	1
ITEM	PART NUMBER	MATERIAL	COMMENTS	ITEM QTY


W1948-003-01 - 1 REQ'D AS DRAWN

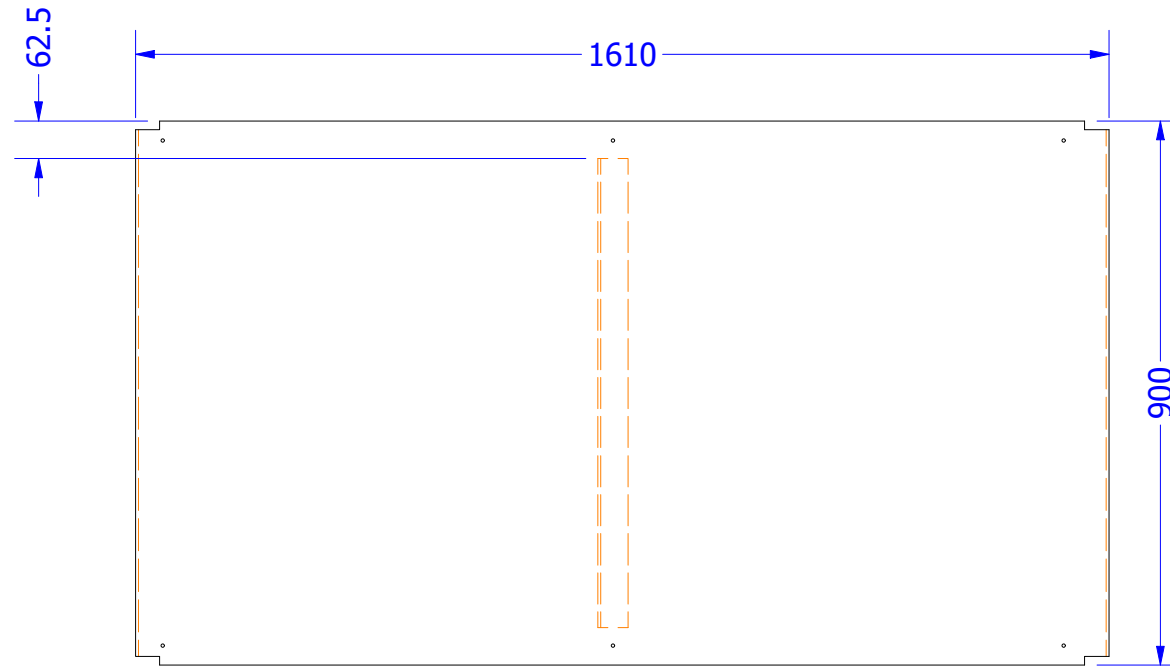

PLAN VIEW  
SCALE 1:12.5

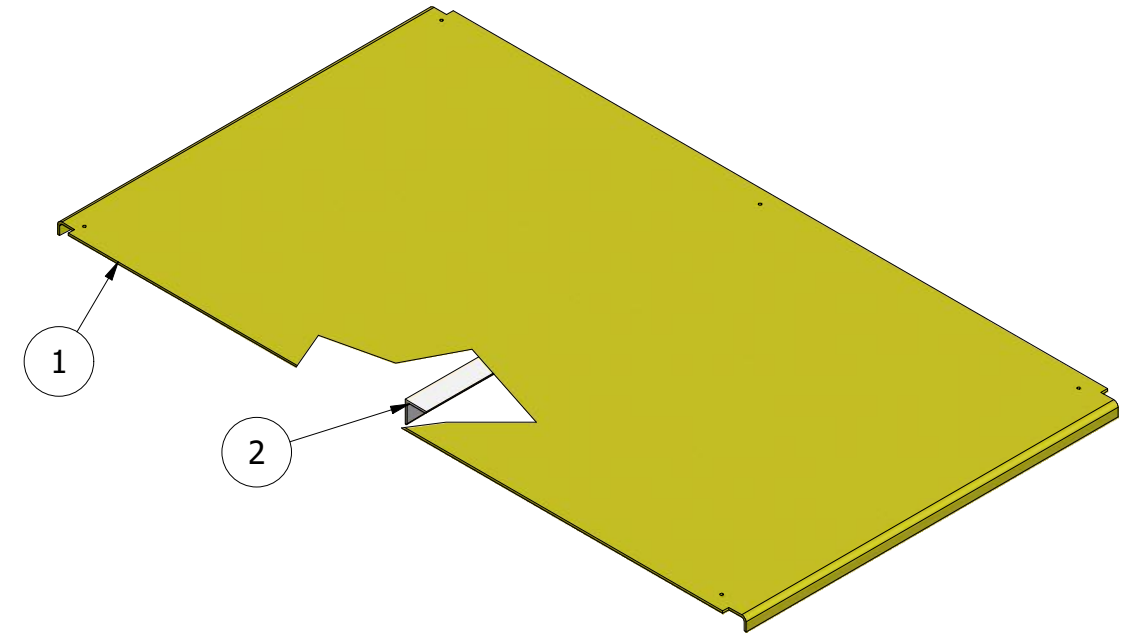

ISO VIEW  
SCALE 1:12.5

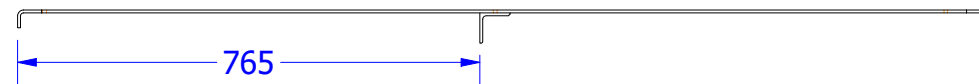

SIDE VIEW  
SCALE 1:12.5

NOTES:


1. ALL WELDING TO CONFORM TO AS1554-GP UNO
2. ALL FILLET WELDS TO BE 6mm CONTINUOUS UNO
3. ALL BUTT WELDS SHALL BE FULL STRENGTH, COMPLETE PENETRATION WELDS
4. ALL FLAME CUT SURFACES SHALL BE UNIFORM & CLEAN BEFORE WELDING
5. REMOVE ALL BURRS & SHARP EDGES
6. NON DESTRUCTIVE TESTING:
  - A) ALL WELDS, 100% VISUAL SCAN TO AS1554 PART 1
7. FINISH:
  - A) ALL STEELWORK TO BE PRIMED OR COLD GALV UNO

DRAWN BY ULTIMATE ENGINEERING PTY LTD Ph 8562 1511



THESE DRAWINGS ARE THE PROPERTY OF ULTIMATE ENGINEERING AND SHOULD NOT BE REPRODUCED OR COPIED IN ANY WAY WITHOUT WRITTEN PERMISSION FROM ULTIMATE ENGINEERING

PAINT TREATMENT: YELLOW

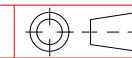

DIMENSION TOLERANCES	
DECIMAL	ANGULAR
X.X = ± .5 mm	X = ± 1°
X.XX = ± .25 mm	X.X = ± .5°
X.XXX = ± .125 mm	X.XX = ± .25°


MAXIMUM FINISHED SURFACE ROUGHNESS U.N.O. 1.6

PARENT ASSEMBLY	CUSTOMER: <b>RAB ENGINEERING</b>
DRAWN: David Bilney	TITLE: W1948-003-01 CHAIN CONVEYORS
DESIGNED: David Bilney	DWG NO: <b>194803</b>
DATE: 18/03/2021	JOB NO:
SCALE: Noted	SHEET 11 OF 33
SHEET SIZE: A3	REV: 1


DO NOT SCALE DRAWING

2	50x5 EA @ 775	Aluminum 6061		1
1	P1948-003-03	Aluminum 5052	SHEET 15	1
ITEM	PART NUMBER	MATERIAL	COMMENTS	ITEM QTY


W1948-003-02 - 1 REQ'D AS DRAWN

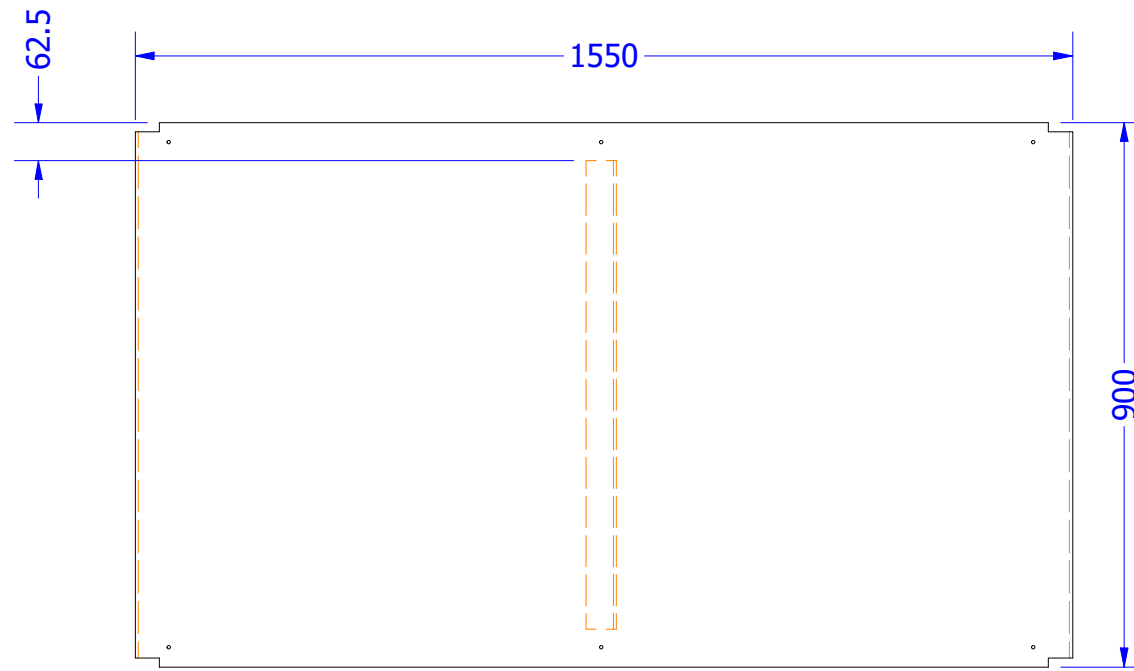

PLAN VIEW  
SCALE 1:12.5

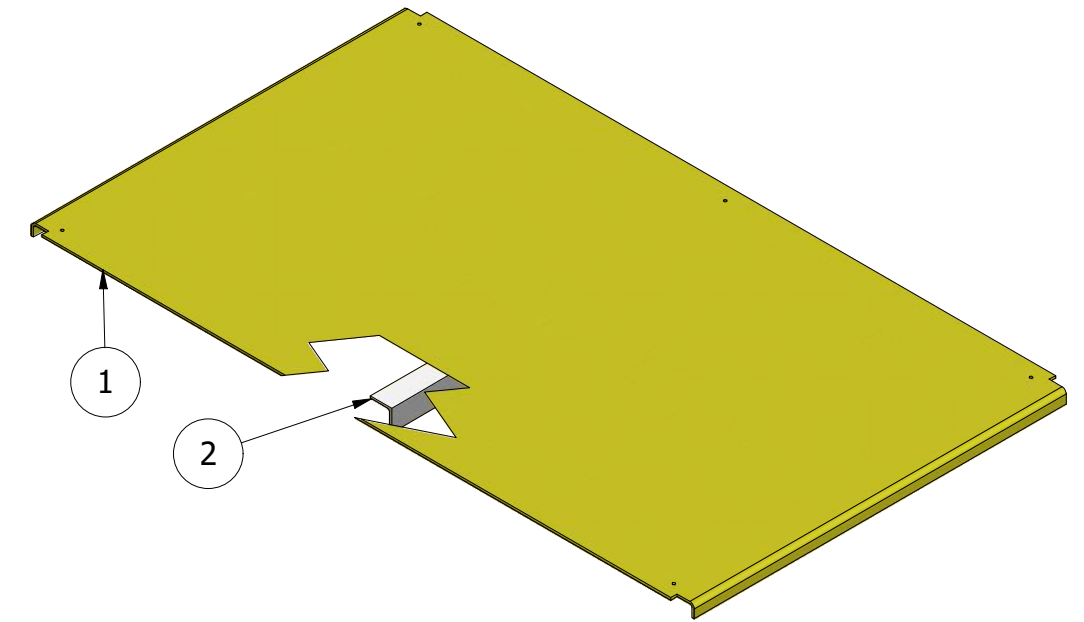

ISO VIEW  
SCALE 1:12.5

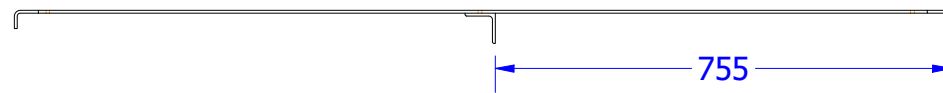

SIDE VIEW  
SCALE 1:12.5

NOTES:


1. ALL WELDING TO CONFORM TO AS1554-GP UNO
2. ALL FILLET WELDS TO BE 6mm CONTINUOUS UNO
3. ALL BUTT WELDS SHALL BE FULL STRENGTH, COMPLETE PENETRATION WELDS
4. ALL FLAME CUT SURFACES SHALL BE UNIFORM & CLEAN BEFORE WELDING
5. REMOVE ALL BURRS & SHARP EDGES
6. NON DESTRUCTIVE TESTING:
  - A) ALL WELDS, 100% VISUAL SCAN TO AS1554 PART 1
7. FINISH:
  - A) ALL STEELWORK TO BE PRIMED OR COLD GALV UNO

DRAWN BY ULTIMATE ENGINEERING PTY LTD Ph 8562 1511



THESE DRAWINGS ARE THE PROPERTY OF ULTIMATE ENGINEERING AND SHOULD NOT BE REPRODUCED OR COPIED IN ANY WAY WITHOUT WRITTEN PERMISSION FROM ULTIMATE ENGINEERING

PAINT TREATMENT: YELLOW

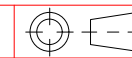

DIMENSION TOLERANCES	
DECIMAL	ANGULAR
X.X = ± .5 mm	X = ± 1°
X.XX = ± .25 mm	X.X = ± .5°
X.XXX = ± .125 mm	X.XX = ± .25°


MAXIMUM FINISHED SURFACE ROUGHNESS U.N.O. 1.6

PARENT ASSEMBLY	CUSTOMER: <b>RAB ENGINEERING</b>
DRAWN: David Bilney	TITLE: W1948-003-02 CHAIN CONVEYORS
DESIGNED: David Bilney	DWG NO: <b>194803</b>
DATE: 18/03/2021	JOB NO:
SCALE: Noted	SHEET: 12 OF 33
SHEET SIZE: A3	REV: 1


DO NOT SCALE DRAWING

50 RND BAR @ 1165	Steel	AS1444-1996 4140
DESCRIPTION	MATERIAL	COMMENTS

P1948-002-01 - 1 REQ'D AS DRAWN

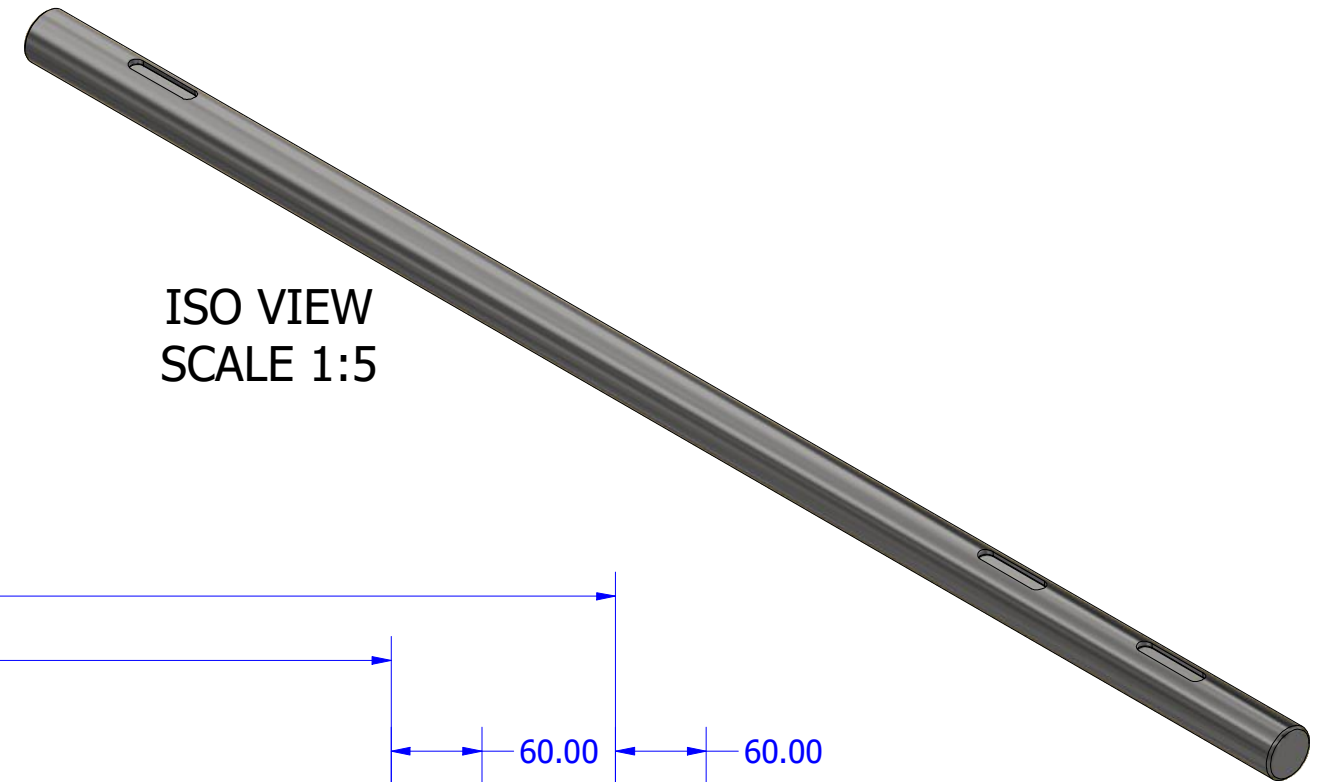

ISO VIEW  
SCALE 1:5

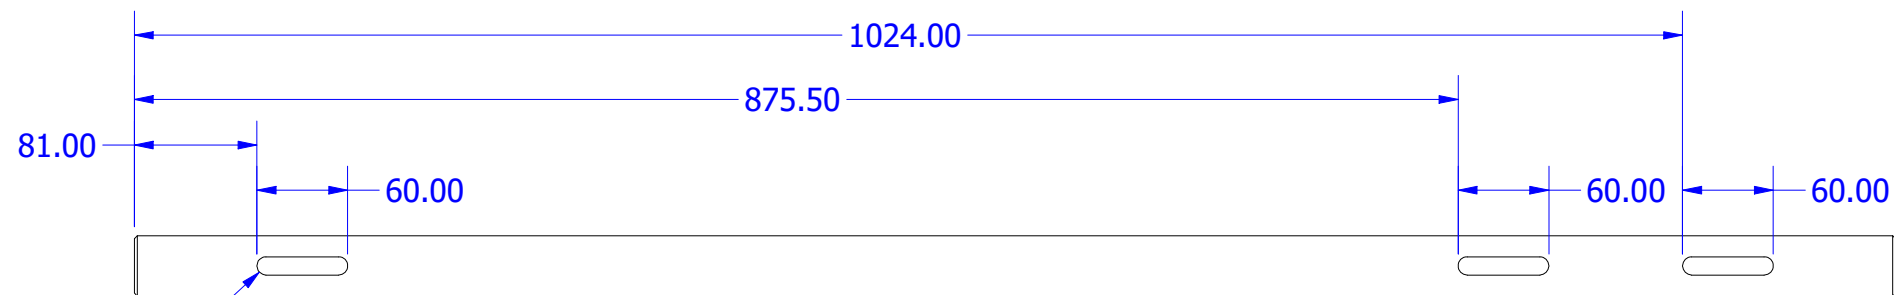


R6.00

2.00 X 45.0° CHAMFER

1165.0

2.00 X 45.0° CHAMFER

Ø40.00

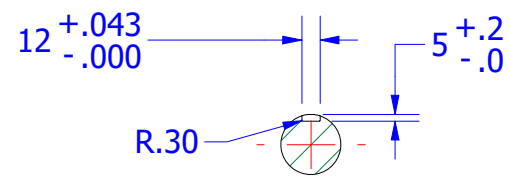


SECTION D-D  
SCALE 1:5

REMOVE ALL BURRS & SHARP EDGES



THESE DRAWINGS ARE THE PROPERTY OF ULTIMATE ENGINEERING AND SHOULD NOT BE REPRODUCED OR COPIED IN ANY WAY WITHOUT WRITTEN PERMISSION FROM ULTIMATE ENGINEERING

PAINT TREATMENT:

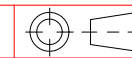

PARENT ASSEMBLY

CUSTOMER:

RAB ENGINEERING

DIMENSION TOLERANCES

DECIMAL	ANGULAR
X.X = ± .5 mm	X = ± 1°
X.XX = ± .25 mm	X.X = ± .5°
X.XXX = ± .125 mm	X.XX = ± .25°

1.6

MAXIMUM FINISHED SURFACE ROUGHNESS U.N.O.

DRAWN: David Bilney

TITLE:

P1948-002-01  
CHAIN CONVEYORS

DESIGNED: David Bilney

DWG NO:

194802

DATE: 18/03/2021

JOB NO:

SCALE:  
Noted

SHEET  
13 OF 33


SHEET SIZE:  
A3

REV:  
1


DO NOT SCALE DRAWING

5mm PLATE @ 1653 X 900	Aluminum 5052	AS1734
DESCRIPTION	MATERIAL	COMMENTS


P1948-003-02 - 1 REQ'D AS DRAWN

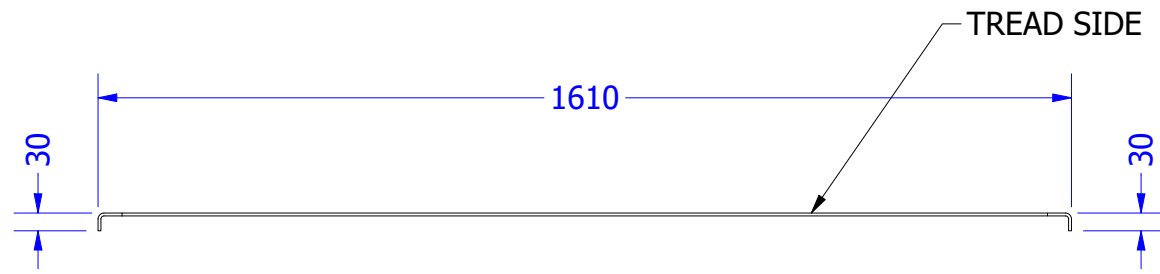


FRONT VIEW - FOLDED  
SCALE 1:12.5

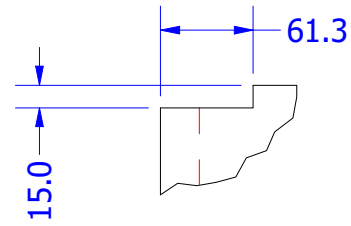

DETAIL E  
TYPICAL CUTOUT  
SCALE 1:5

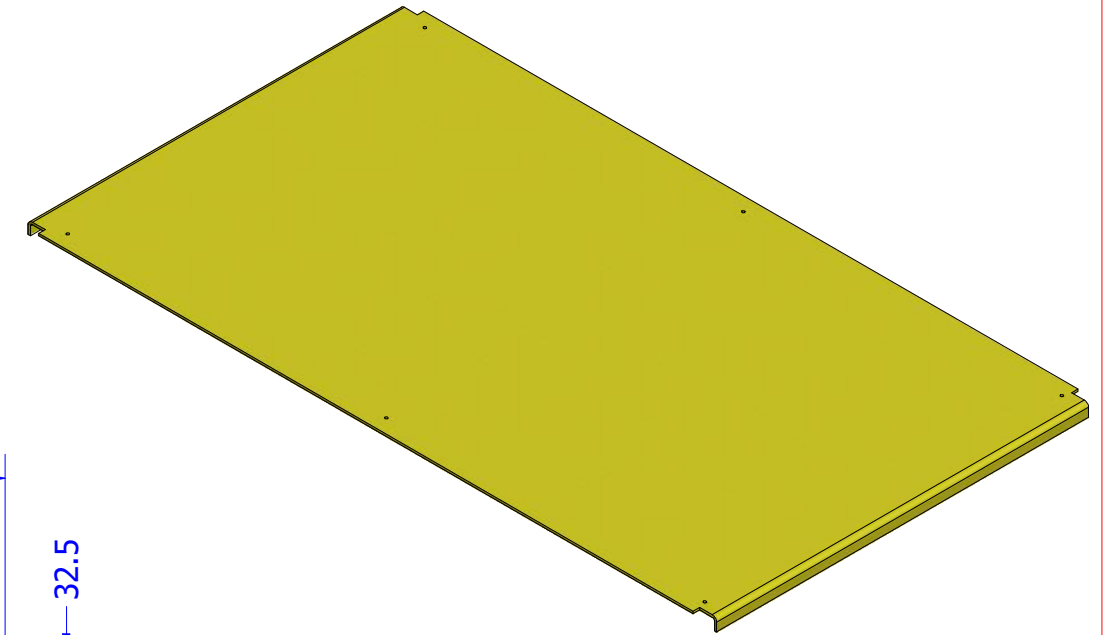

ISO VIEW  
SCALE 1:12.5

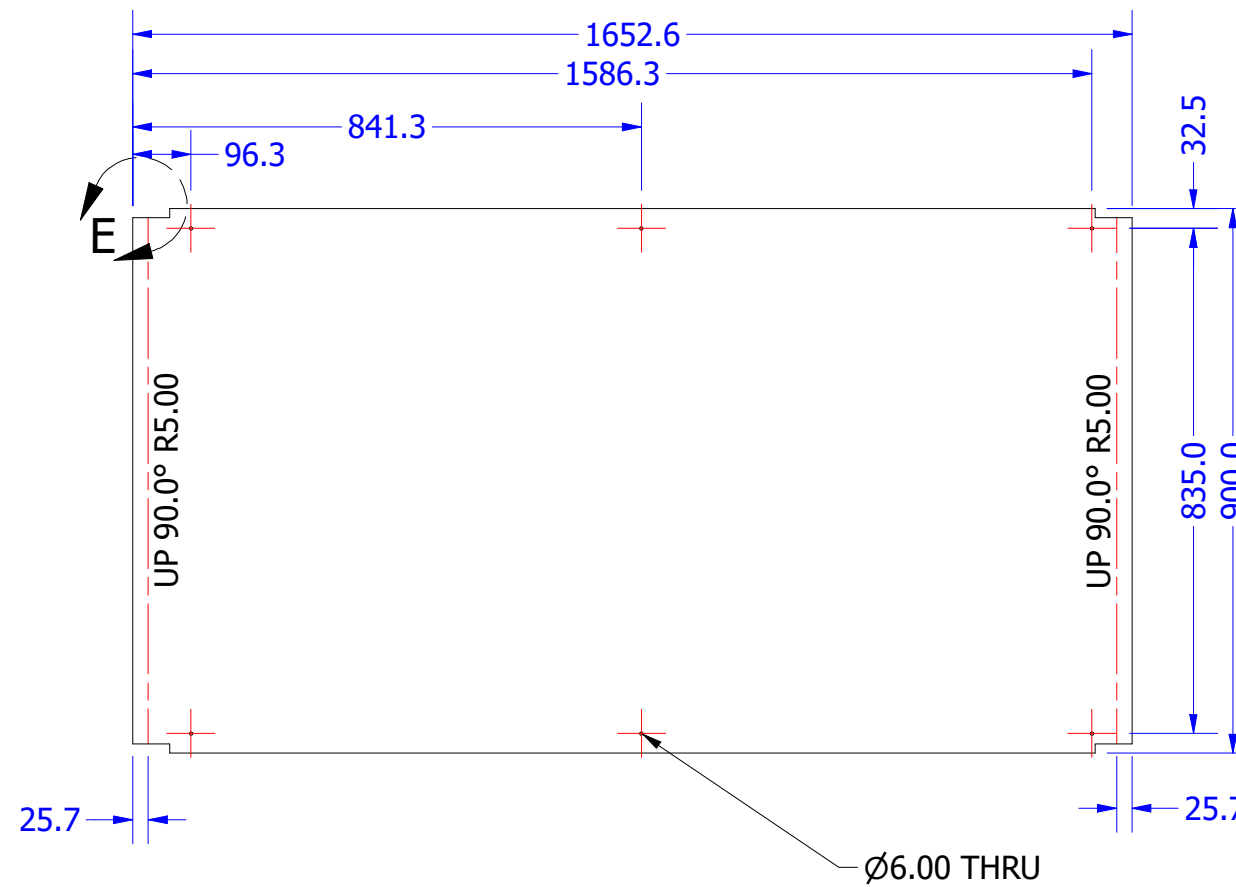

FLAT PATTERN  
TREAD SIDE DOWN  
SCALE 1:12.5

REMOVE ALL BURRS & SHARP EDGES



THESE DRAWINGS ARE THE PROPERTY OF ULTIMATE ENGINEERING AND SHOULD NOT BE REPRODUCED OR COPIED IN ANY WAY WITHOUT WRITTEN PERMISSION FROM ULTIMATE ENGINEERING

PAINT TREATMENT:



DIMENSION TOLERANCES	
DECIMAL	ANGULAR
X.X = ± .5 mm	X = ± 1°
X.XX = ± .25 mm	X.X = ± .5°
X.XXX = ± .125 mm	X.XX = ± .25°

MAXIMUM FINISHED SURFACE ROUGHNESS U.N.O. 1.6

PARENT ASSEMBLY

CUSTOMER:

RAB ENGINEERING

DRAWN: David Bilney

TITLE:

P1948-003-02  
CHAIN CONVEYORS

DESIGNED: David Bilney

DWG NO:

194802

DATE: 18/03/2021

JOB NO:

SCALE:  
Noted

SHEET  
14 OF 33





SHEET SIZE:  
A3

REV:  
1

DO NOT SCALE DRAWING

5mm TREADPLATE @ 1593 X 900	Aluminum 5052	AS1734 - 5052
DESCRIPTION	MATERIAL	COMMENTS

P1948-003-03 - 1 REQ'D AS DRAWN

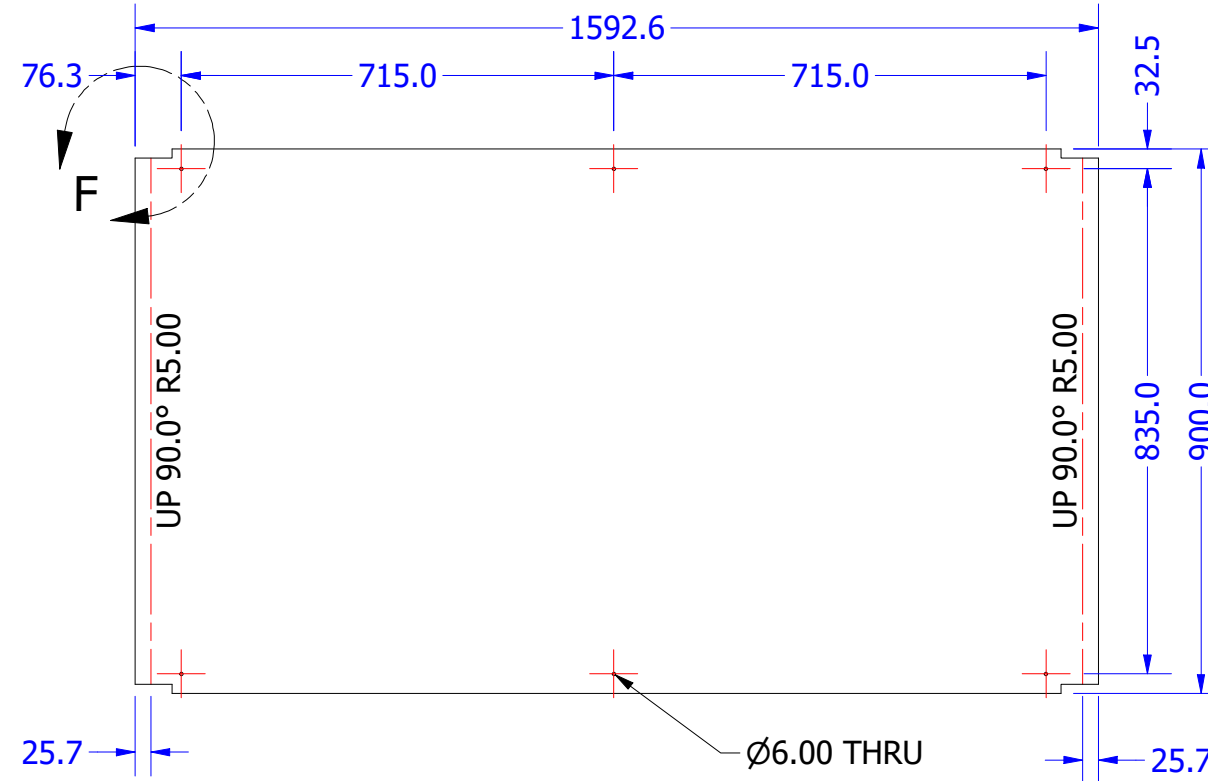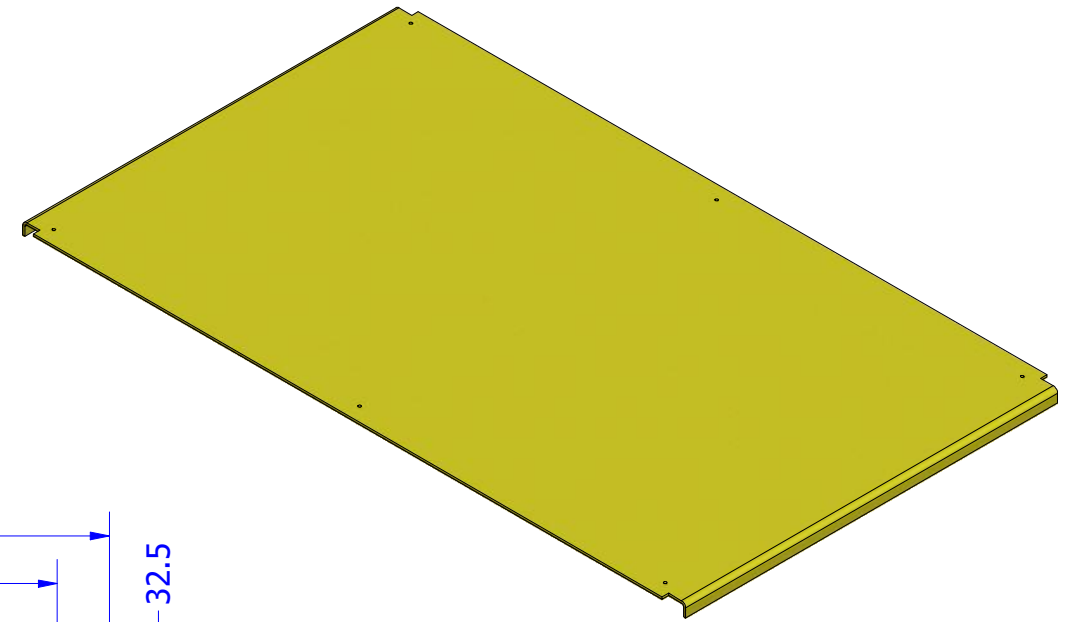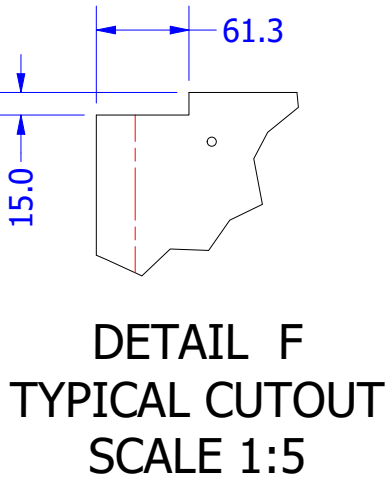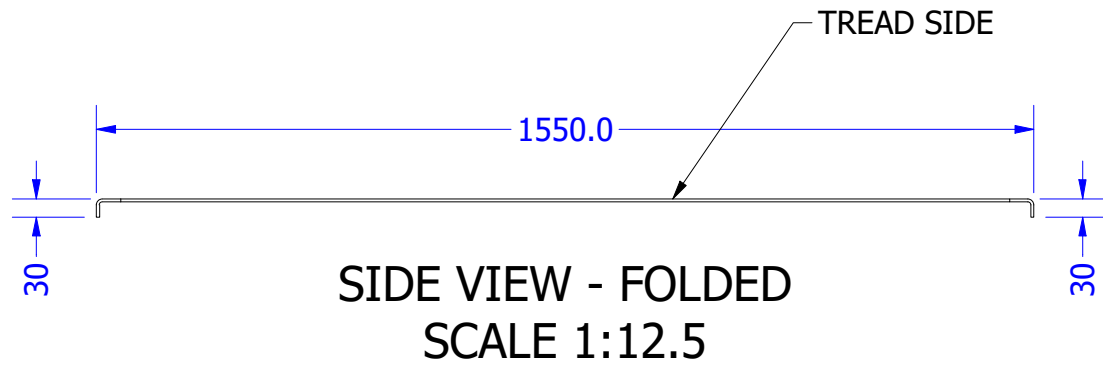


REMOVE ALL BURRS & SHARP EDGES



THESE DRAWINGS ARE THE PROPERTY OF ULTIMATE ENGINEERING AND SHOULD NOT BE REPRODUCED OR COPIED IN ANY WAY WITHOUT WRITTEN PERMISSION FROM ULTIMATE ENGINEERING

PAINT TREATMENT:

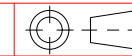

DIMENSION TOLERANCES	
DECIMAL	ANGULAR
X.X = ± .5 mm	X = ± 1°
X.XX = ± .25 mm	X.X = ± .5°
X.XXX = ± .125 mm	X.XX = ± .25°

MAXIMUM FINISHED SURFACE ROUGHNESS U.N.O. 1.6

PARENT ASSEMBLY

CUSTOMER: **RAB ENGINEERING**

DRAWN: David Bilney

TITLE: P1948-003-03  
CHAIN CONVEYORS

DESIGNED: David Bilney

DWG NO: **194803**

DATE: 18/03/2021

JOB NO:


SCALE: Noted	SHEET 15 OF 33	SHEET SIZE: A3	REV: 1
--------------	----------------	----------------	--------



DO NOT SCALE DRAWING

12mm PLATE @ 530 X 225	Steel, Mild	AS3678 - GR250
DESCRIPTION	MATERIAL	COMMENTS

P1948-000-01 - 2 REQ'D AS DRAWN

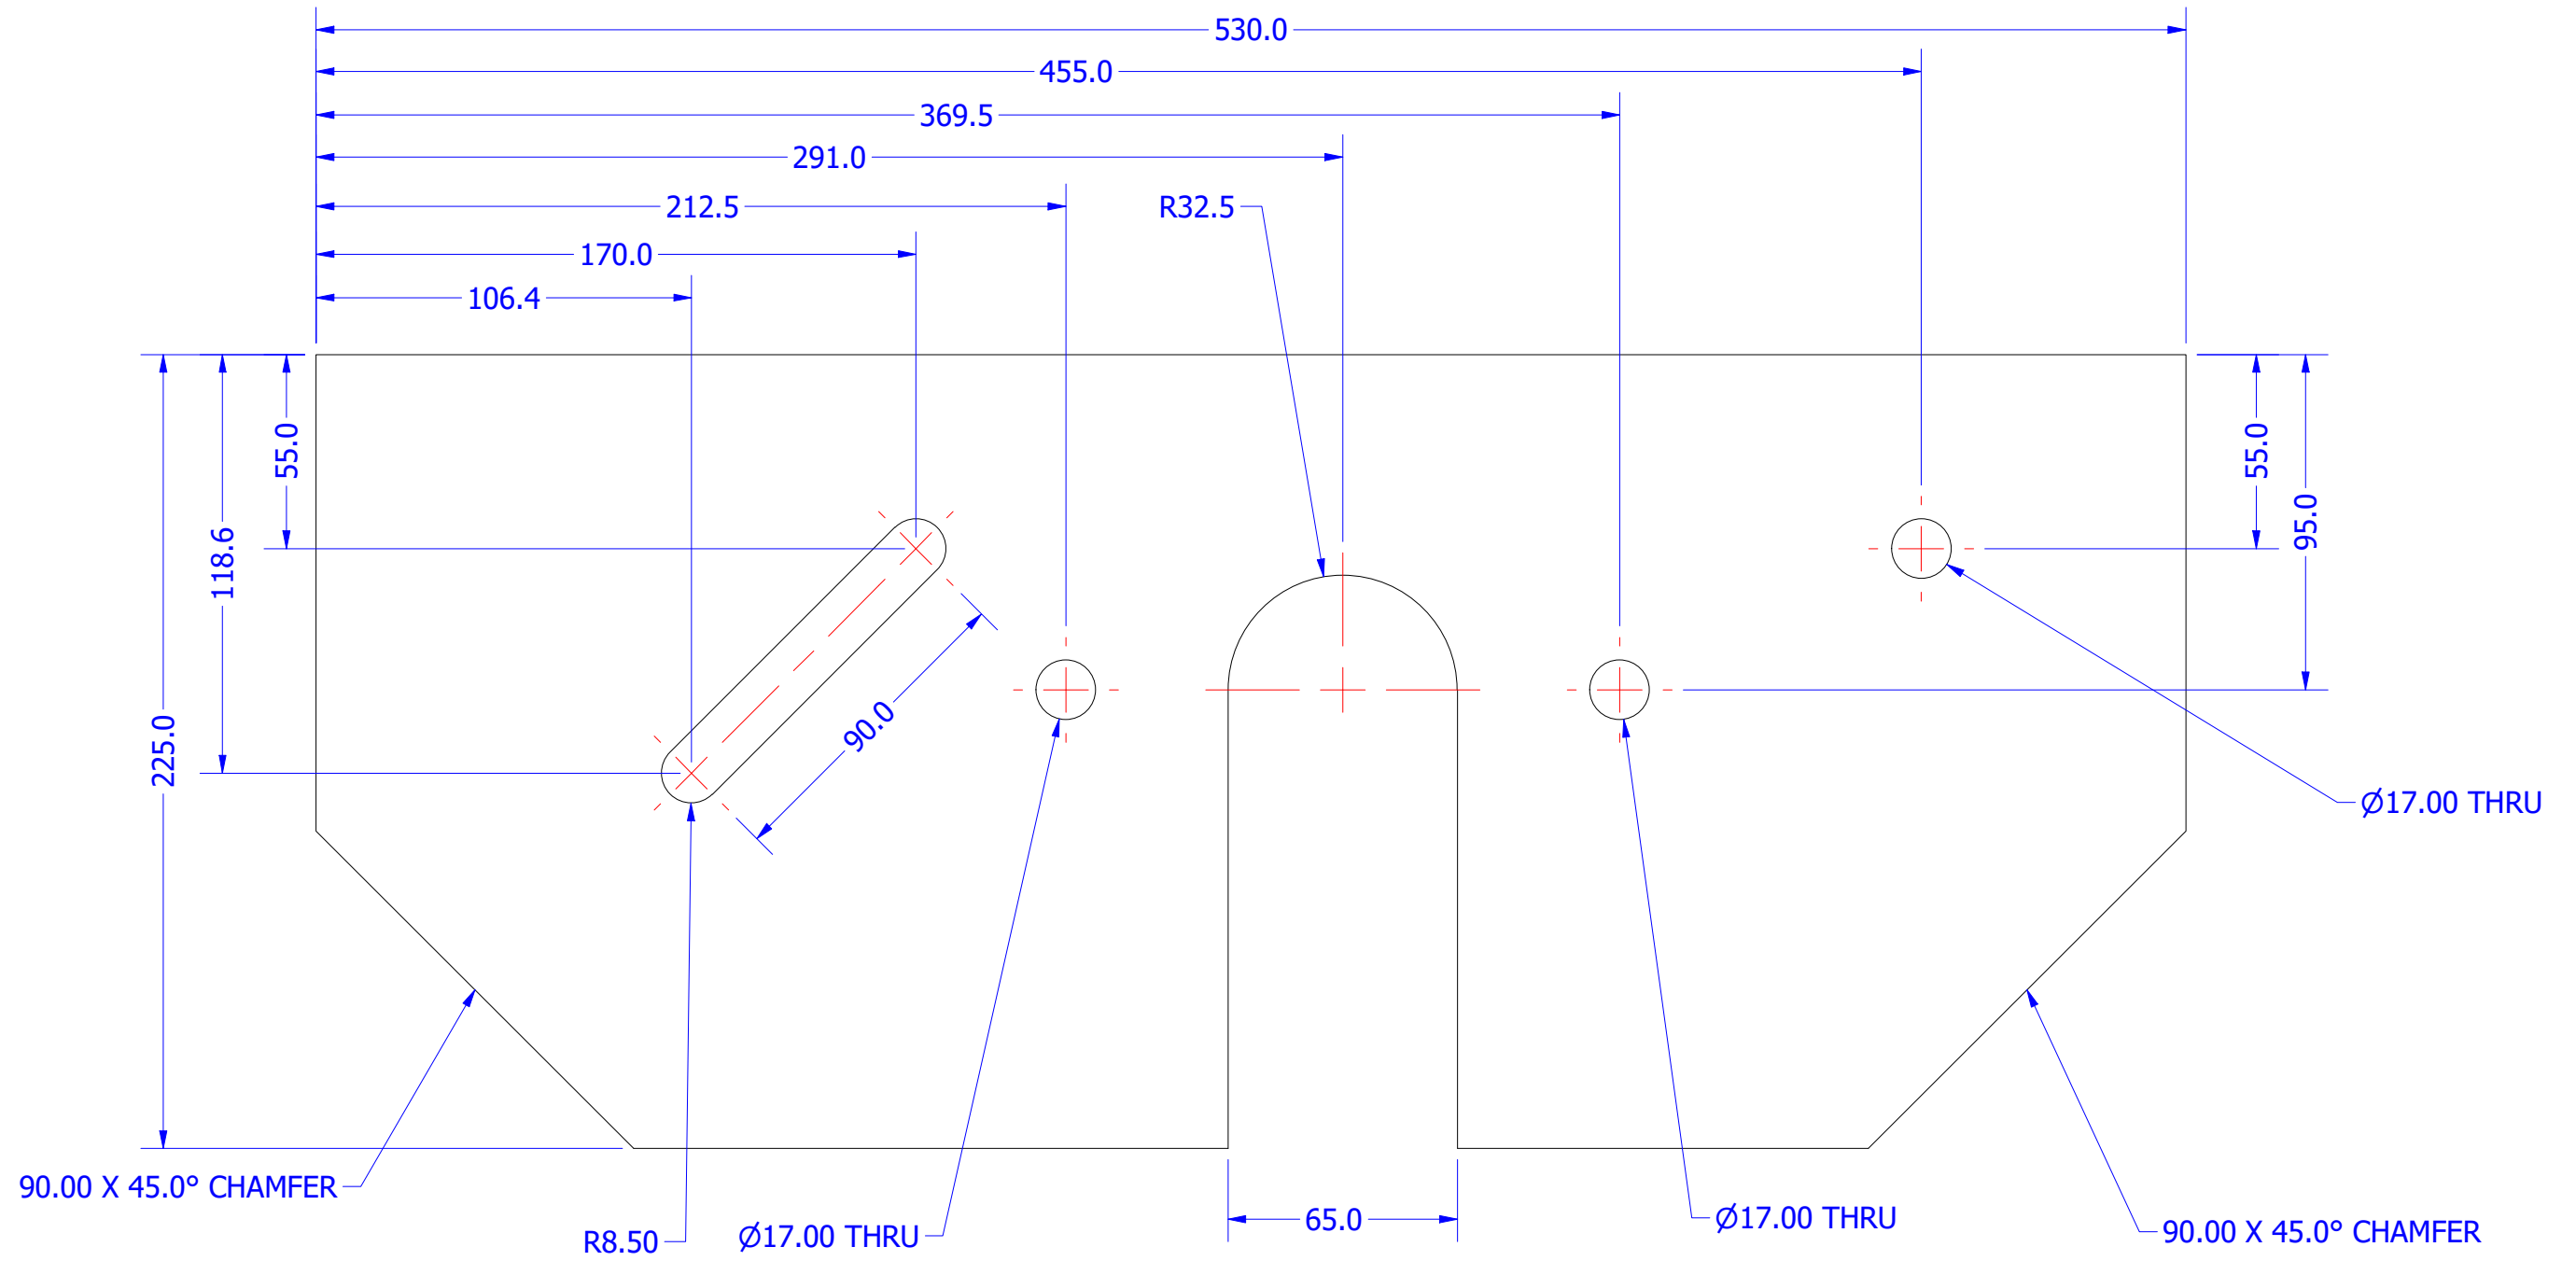

FRONT VIEW  
SCALE 1:2


REMOVE ALL BURRS & SHARP EDGES

DRAWN BY ULTIMATE ENGINEERING PTY LTD Ph 8562 1511



THESE DRAWINGS ARE THE PROPERTY OF ULTIMATE ENGINEERING AND SHOULD NOT BE REPRODUCED OR COPIED IN ANY WAY WITHOUT WRITTEN PERMISSION FROM ULTIMATE ENGINEERING

PAINT TREATMENT:

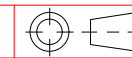

DIMENSION TOLERANCES	
DECIMAL	ANGULAR
X.X = ± .5 mm	X = ± 1'
X.XX = ± .25 mm	X.X = ± .5'
X.XXX = ± .125 mm	X.XX = ± .25'

MAXIMUM FINISHED SURFACE ROUGHNESS U.N.O. 1.6

PARENT ASSEMBLY

CUSTOMER:

RAB ENGINEERING

DRAWN: David Bilney

TITLE:

P1948-000-01  
CHAIN CONVEYORS

DESIGNED: David Bilney

DWG NO:

194801/12

DATE: 18/03/2021

JOB NO:

SCALE:  
Noted

SHEET  
16 OF 33


SHEET SIZE:  
A3

REV:  
1

DO NOT SCALE DRAWING

16mm PLATE @ 140 X 111	Steel, Mild	AS3678 - GR250
DESCRIPTION	MATERIAL	COMMENTS

P1948-000-02 - 8 REQ'D AS DRAWN

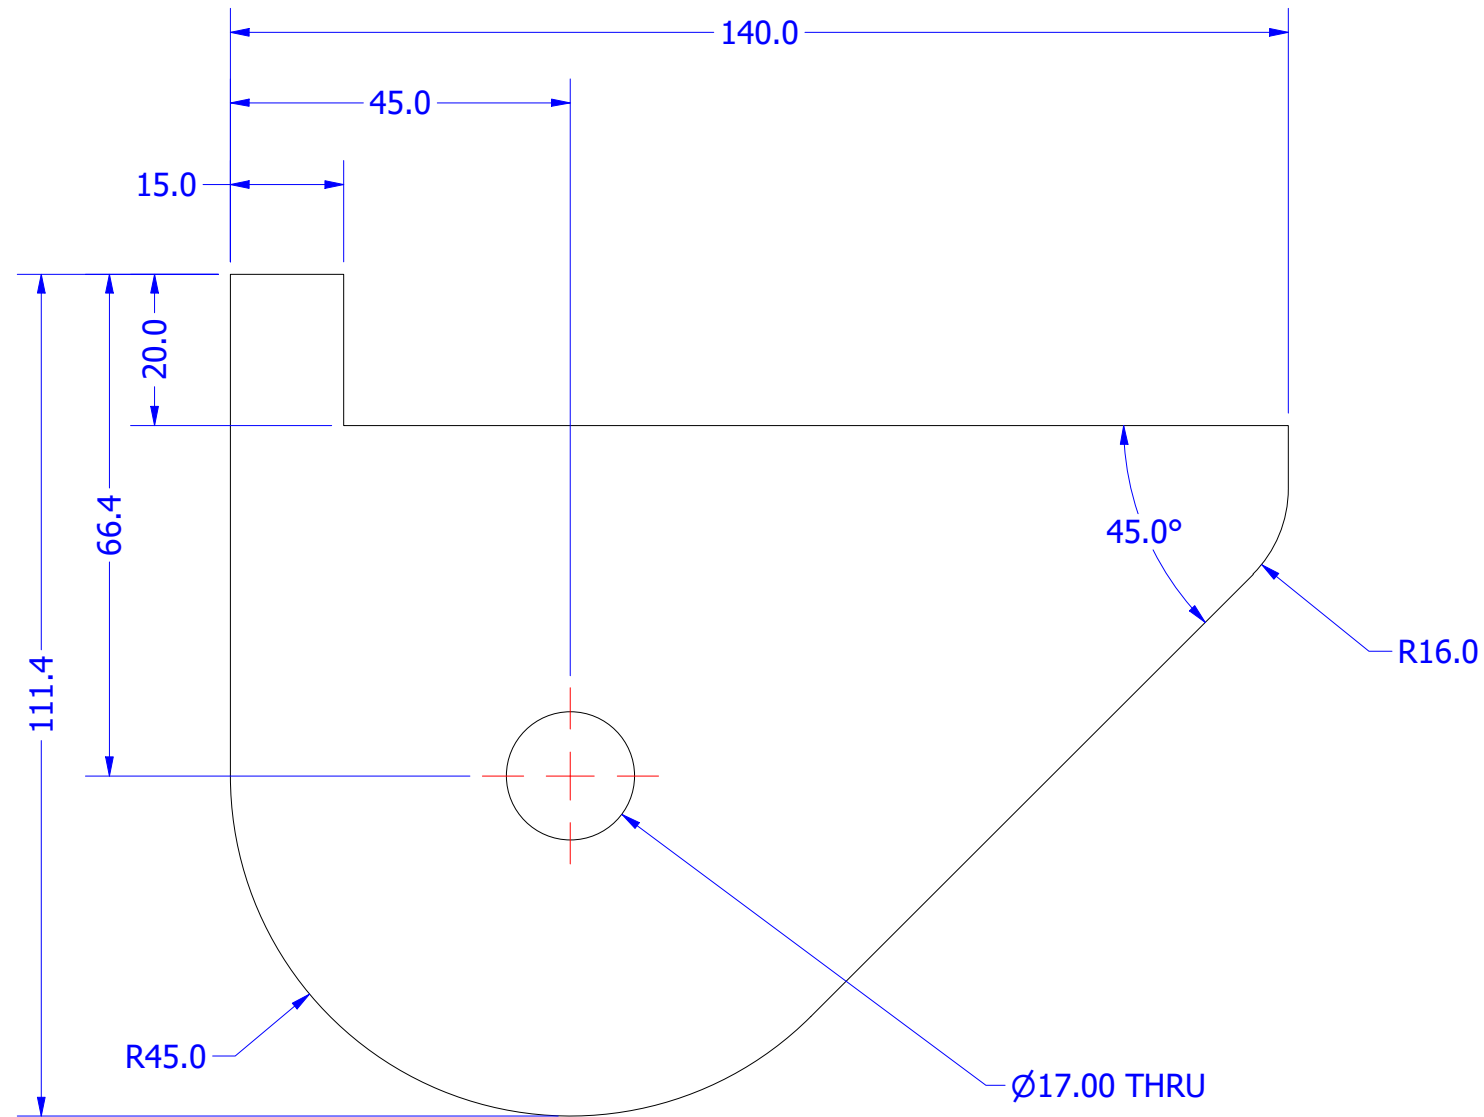


FRONT VIEW  
SCALE 1 : 1

REMOVE ALL BURRS & SHARP EDGES



THESE DRAWINGS ARE THE PROPERTY OF ULTIMATE ENGINEERING AND SHOULD NOT BE REPRODUCED OR COPIED IN ANY WAY WITHOUT WRITTEN PERMISSION FROM ULTIMATE ENGINEERING

PAINT TREATMENT:

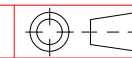

DIMENSION TOLERANCES	
DECIMAL	ANGULAR
X.X = ± .5 mm	X = ± 1°
X.XX = ± .25 mm	X.X = ± .5°
X.XXX = ± .125 mm	X.XX = ± .25°

MAXIMUM FINISHED SURFACE ROUGHNESS U.N.O. 1.6

PARENT ASSEMBLY

DRAWN: David Bilney

DESIGNED: David Bilney

DATE: 18/03/2021

CUSTOMER:

TITLE:

DWG NO:

JOB NO:

RAB ENGINEERING

P1948-000-02  
CHAIN CONVEYORS

194801/13


SCALE: Noted	SHEET 17 OF 33	SHEET SIZE: A3	REV: 1
-----------------	-------------------	-------------------	-----------

DRAWN BY ULTIMATE ENGINEERING PTY LTD Ph 8562 1511

DO NOT SCALE DRAWING

16mm PLATE @ 480 X 139	Steel, Mild	AS3678 - GR250
DESCRIPTION	MATERIAL	COMMENTS

P1948-000-03 - 2 REQ'D AS DRAWN

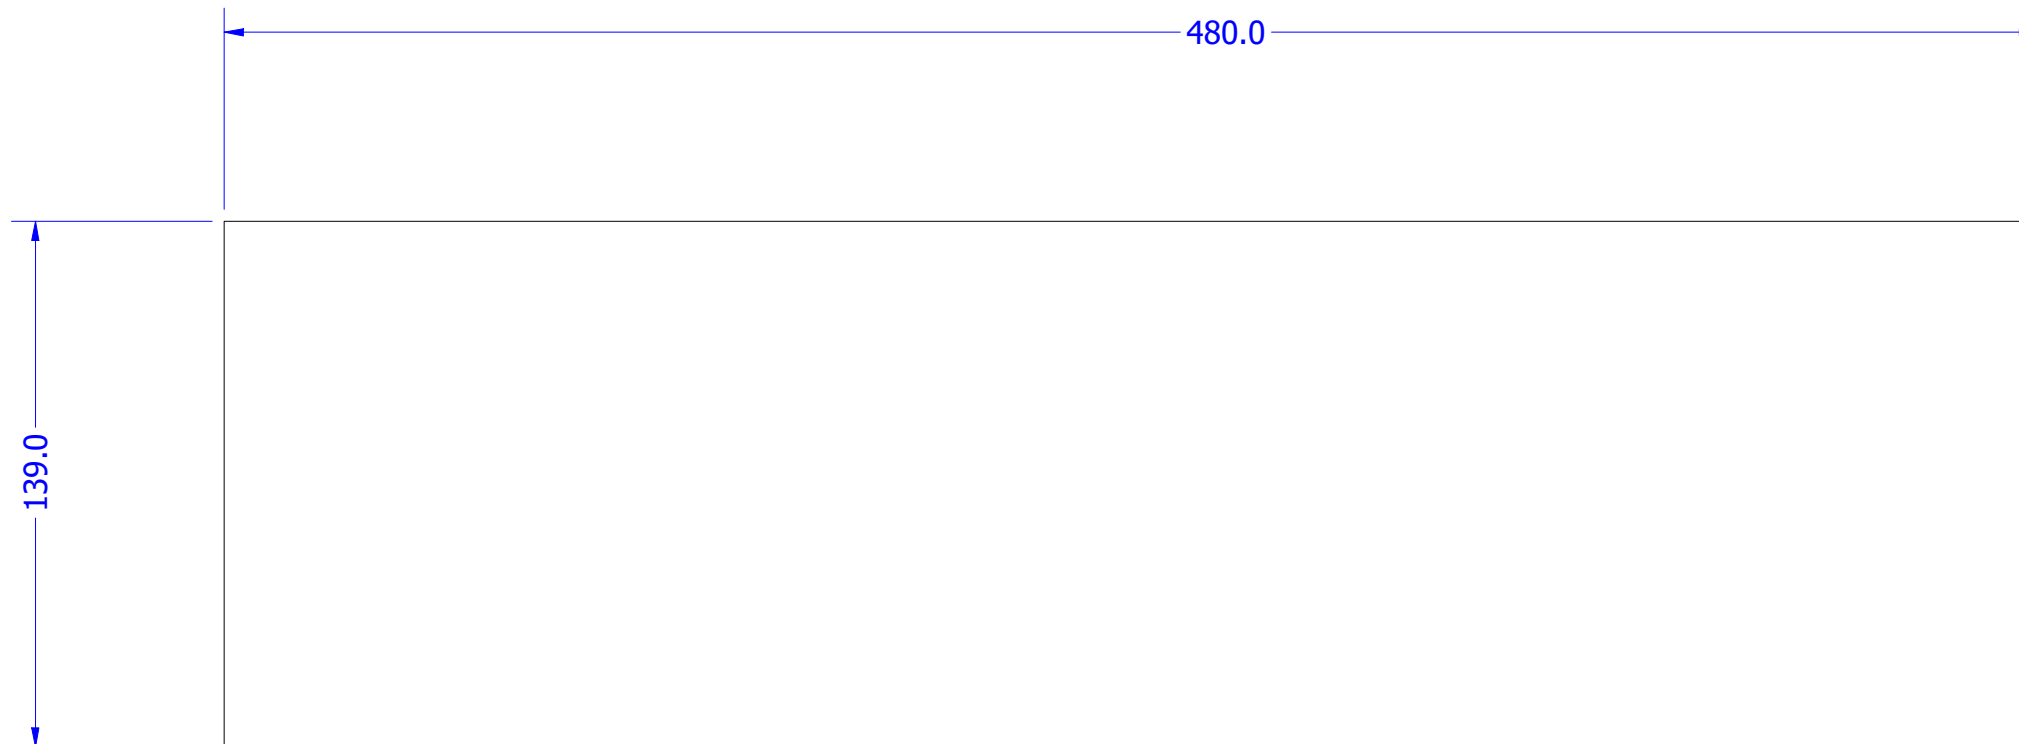


FRONT VIEW  
SCALE 1:2

REMOVE ALL BURRS & SHARP EDGES



THESE DRAWINGS ARE THE PROPERTY OF ULTIMATE ENGINEERING AND SHOULD NOT BE REPRODUCED OR COPIED IN ANY WAY WITHOUT WRITTEN PERMISSION FROM ULTIMATE ENGINEERING

PAINT TREATMENT:

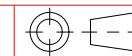

DIMENSION TOLERANCES	
DECIMAL	ANGULAR
X.X = ± .5 mm	X = ± 1°
X.XX = ± .25 mm	X.X = ± .5°
X.XXX = ± .125 mm	X.XX = ± .25°

MAXIMUM FINISHED SURFACE ROUGHNESS U.N.O. 1.6

PARENT ASSEMBLY

DRAWN: David Bilney

DESIGNED: David Bilney

DATE: 18/03/2021

CUSTOMER:

RAB ENGINEERING

TITLE:

P1948-000-03  
CHAIN CONVEYORS

DWG NO:

194801/14

JOB NO:

SCALE:  
Noted

SHEET  
18 OF 33


SHEET SIZE:  
A3

REV:  
1


DO NOT SCALE DRAWING

5mm PLATE @ 140 X 115	Steel, Mild	AS3678 - GR250
DESCRIPTION	MATERIAL	COMMENTS

P1948-000-04 - 2 REQ'D AS DRAWN

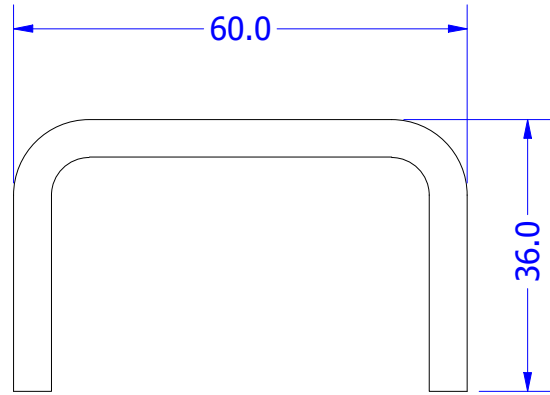

FOLDED VIEW  
SCALE 1 : 1

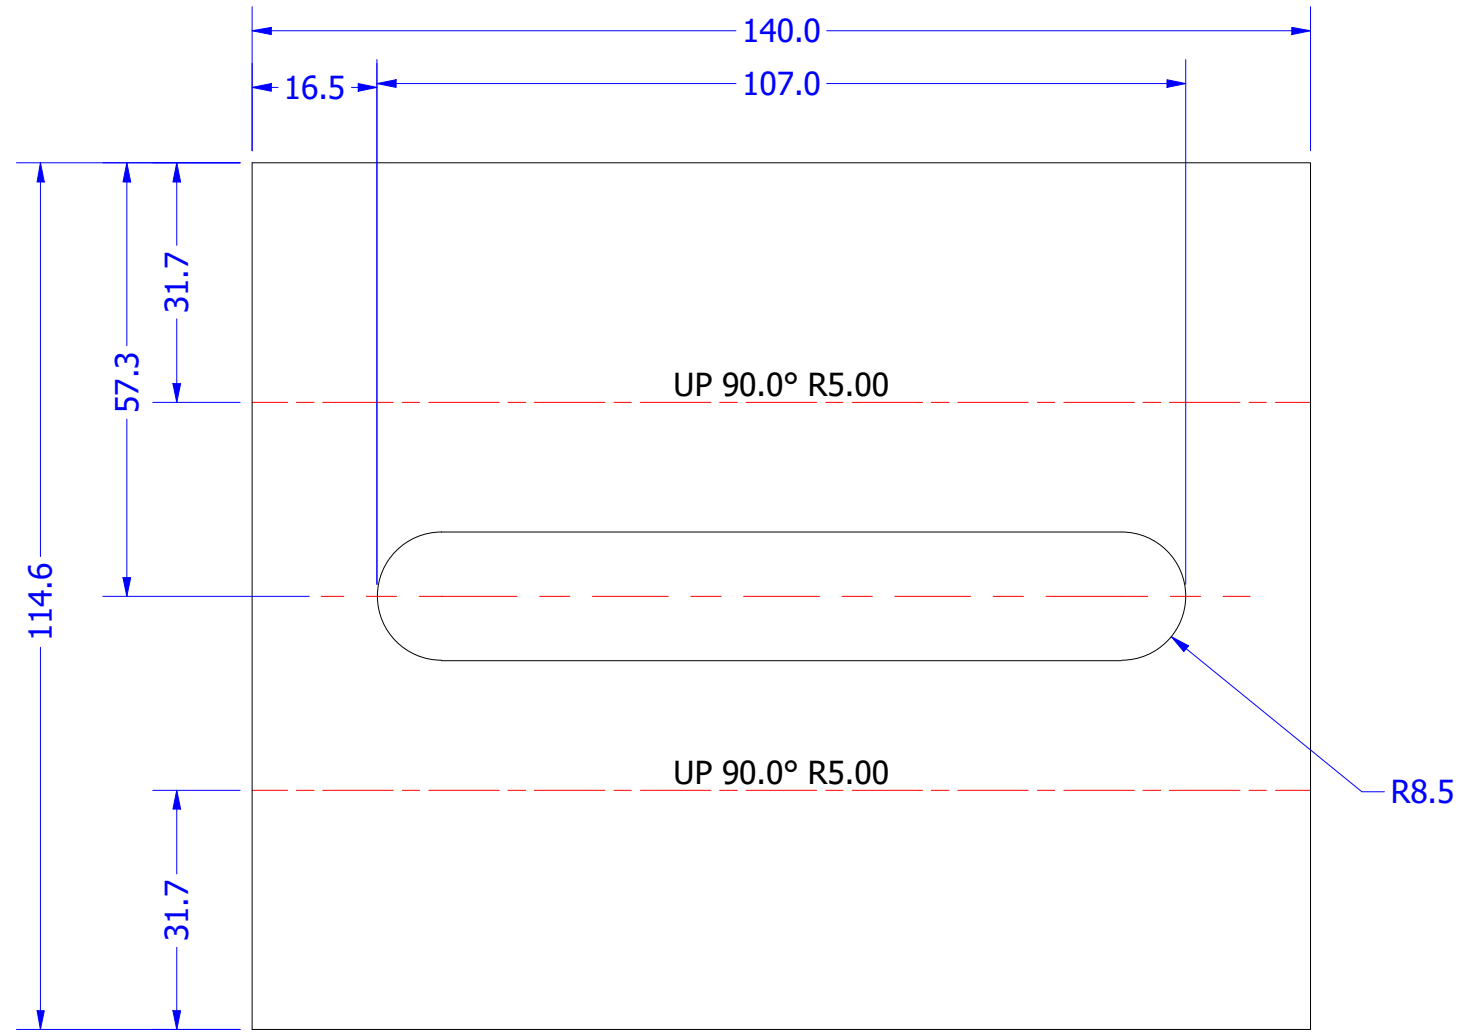


FLAT PATTERN  
SCALE 1 : 1

REMOVE ALL BURRS & SHARP EDGES



THESE DRAWINGS ARE THE PROPERTY OF ULTIMATE ENGINEERING AND SHOULD NOT BE REPRODUCED OR COPIED IN ANY WAY WITHOUT WRITTEN PERMISSION FROM ULTIMATE ENGINEERING

PAINT TREATMENT:

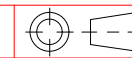

DIMENSION TOLERANCES	
DECIMAL	ANGULAR
X.X = ± .5 mm	X = ± 1°
X.XX = ± .25 mm	X.X = ± .5°
X.XXX = ± .125 mm	X.XX = ± .25°

MAXIMUM FINISHED SURFACE ROUGHNESS U.N.O. 1.6

PARENT ASSEMBLY

DRAWN: David Bilney

DESIGNED: David Bilney

DATE: 18/03/2021

CUSTOMER:

RAB ENGINEERING

TITLE:

P1948-000-04  
CHAIN CONVEYORS

DWG NO:

194801/15

JOB NO:

SCALE:  
Noted

SHEET  
19 OF 33


SHEET SIZE:  
A3

REV:  
1

DO NOT SCALE DRAWING

12mm PLATE @ 35 X 35	Steel, Mild	AS3678 - GR250
DESCRIPTION	MATERIAL	COMMENTS

P1948-000-05 - 4 REQ'D AS DRAWN

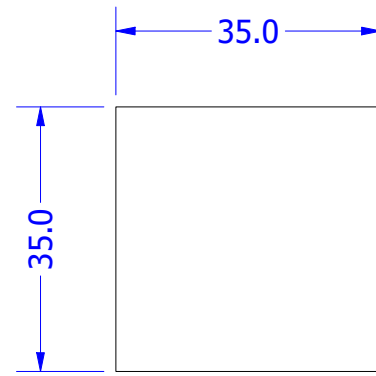


FRONT VIEW  
SCALE 1 : 1

REMOVE ALL BURRS & SHARP EDGES



THESE DRAWINGS ARE THE PROPERTY OF ULTIMATE ENGINEERING AND SHOULD NOT BE REPRODUCED OR COPIED IN ANY WAY WITHOUT WRITTEN PERMISSION FROM ULTIMATE ENGINEERING

PAINT TREATMENT:

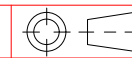

DIMENSION TOLERANCES	
DECIMAL	ANGULAR
X.X = ± .5 mm	X = ± 1°
X.XX = ± .25 mm	X.X = ± .5°
X.XXX = ± .125 mm	X.XX = ± .25°

MAXIMUM FINISHED SURFACE ROUGHNESS U.N.O. 1.6

PARENT ASSEMBLY

DRAWN: David Bilney

DESIGNED: David Bilney

DATE: 18/03/2021

CUSTOMER: RAB ENGINEERING

TITLE: P1948-000-05  
CHAIN CONVEYORS

DWG NO: 194801/16

JOB NO:

SCALE: Noted  
SHEET 20 OF 33


SHEET SIZE: A3

REV: 1

DO NOT SCALE DRAWING

100x10 FMS @ 400mm	Steel, Mild	AS3679 - GR300
DESCRIPTION	MATERIAL	COMMENTS

P1948-000-06 - 6 REQ'D AS DRAWN

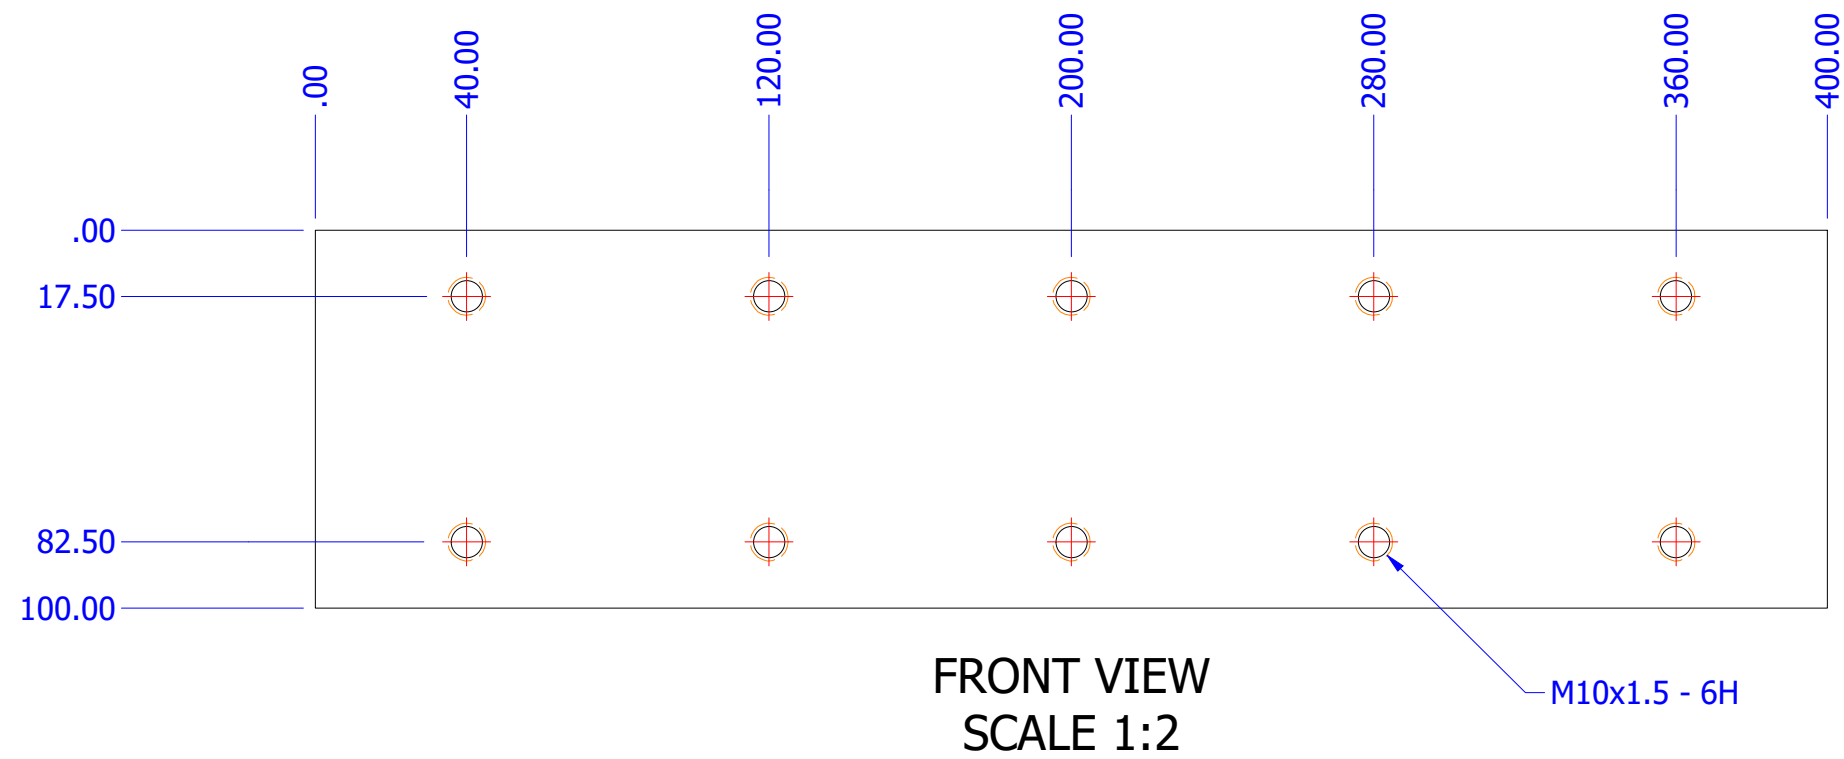


REMOVE ALL BURRS & SHARP EDGES



THESE DRAWINGS ARE THE PROPERTY OF ULTIMATE ENGINEERING AND SHOULD NOT BE REPRODUCED OR COPIED IN ANY WAY WITHOUT WRITTEN PERMISSION FROM ULTIMATE ENGINEERING

PAINT TREATMENT:

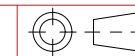

DIMENSION TOLERANCES	
DECIMAL	ANGULAR
X.X = ± .5 mm	X = ± 1°
X.XX = ± .25 mm	X.X = ± .5°
X.XXX = ± .125 mm	X.XX = ± .25°

MAXIMUM FINISHED SURFACE ROUGHNESS U.N.O. 1.6

PARENT ASSEMBLY

DRAWN: David Bilney

DESIGNED: David Bilney

DATE: 18/03/2021

CUSTOMER:

RAB ENGINEERING

TITLE:

P1948-000-06  
CHAIN CONVEYORS

DWG NO:

194801/17

JOB NO:

SCALE:  
Noted

SHEET  
21 OF 33


SHEET SIZE:  
A3

REV:  
1




DO NOT SCALE DRAWING


2mm PLATE @ 3220 X 95	Steel, Mild	AS1594 - GR250
DESCRIPTION	MATERIAL	COMMENTS
P1948-000-07 - 2 REQ'D AS DRAWN		

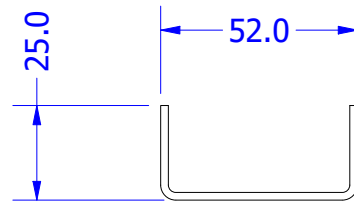

FOLDED VIEW  
SCALE 1:2

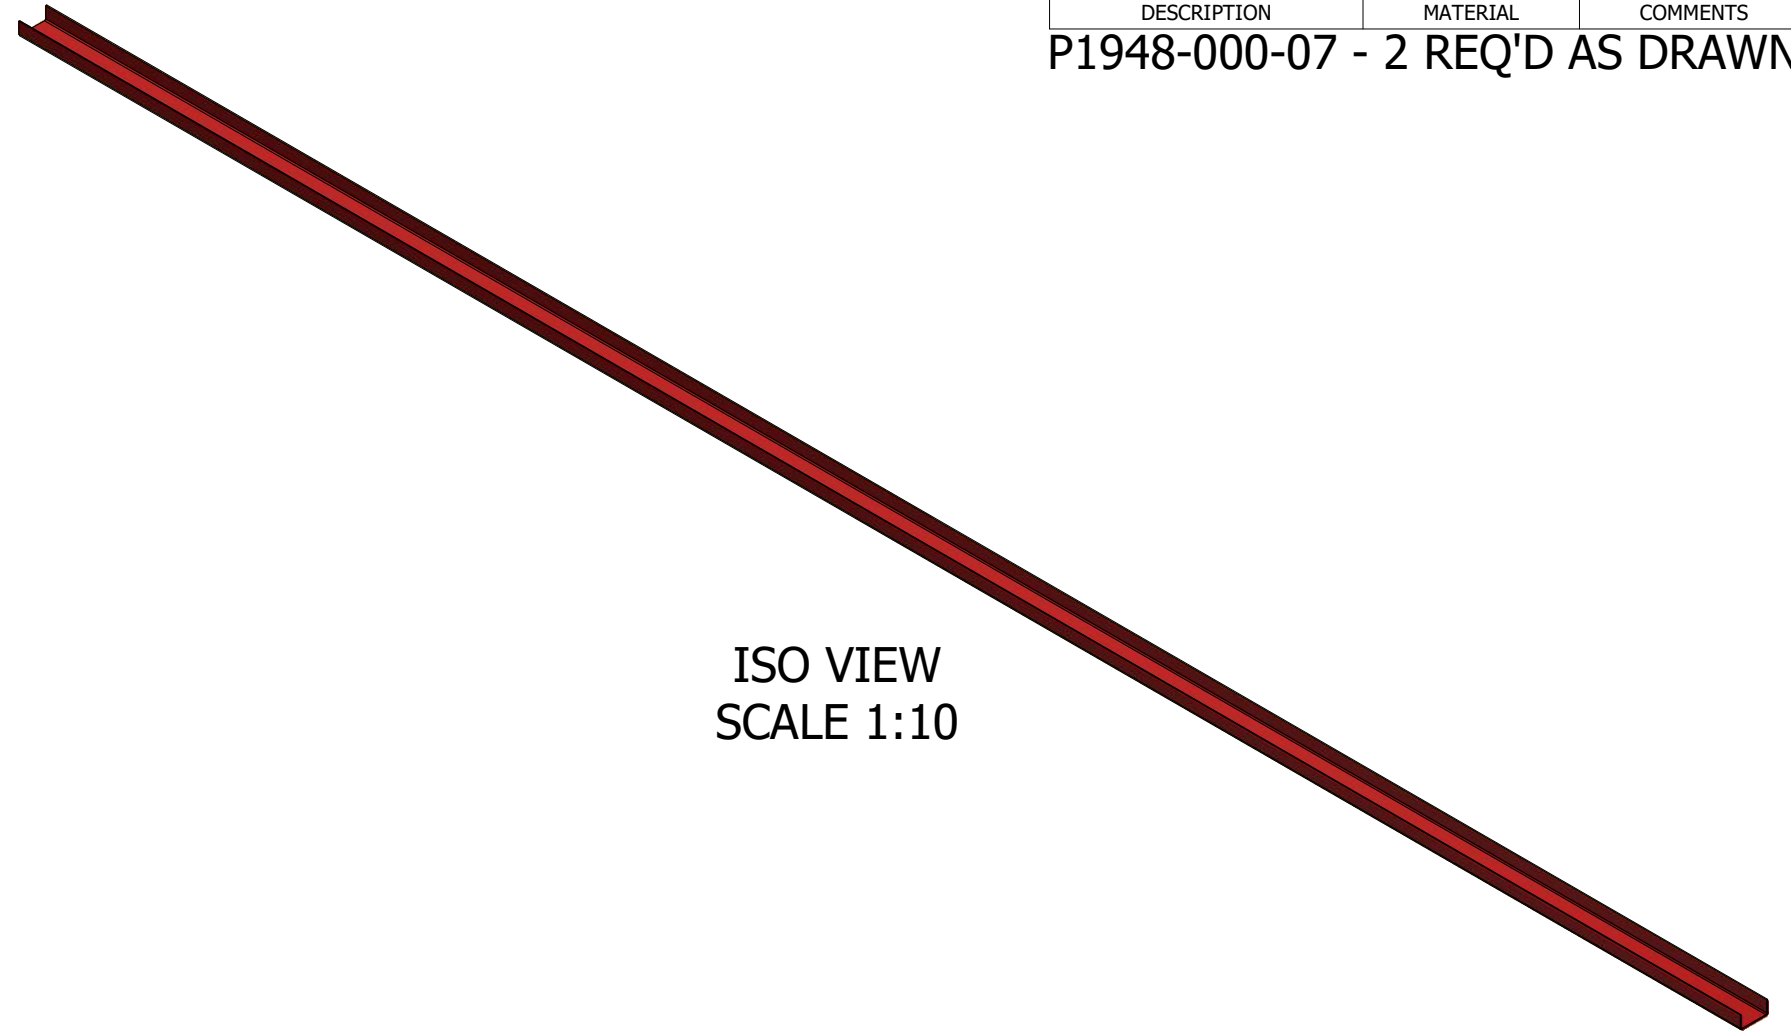

ISO VIEW  
SCALE 1:10

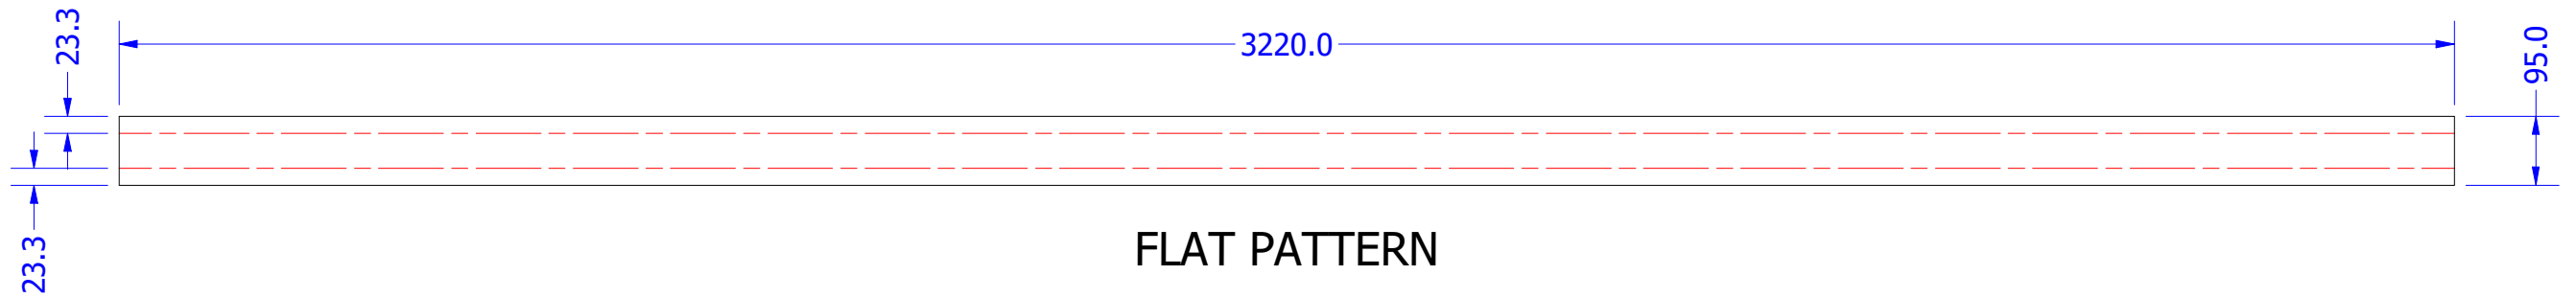


FLAT PATTERN  
ALL FOLDS UP 90°  
SCALE 1:10

REMOVE ALL BURRS & SHARP EDGES



THESE DRAWINGS ARE THE PROPERTY OF ULTIMATE ENGINEERING AND SHOULD NOT BE REPRODUCED OR COPIED IN ANY WAY WITHOUT WRITTEN PERMISSION FROM ULTIMATE ENGINEERING

PAINT TREATMENT:

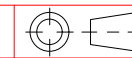

DIMENSION TOLERANCES	
DECIMAL	ANGULAR
X.X = ± .5 mm	X = ± 1°
X.XX = ± .25 mm	X.X = ± .5°
X.XXX = ± .125 mm	X.XX = ± .25°
MAXIMUM FINISHED SURFACE ROUGHNESS U.N.O. 1.6	

PARENT ASSEMBLY

CUSTOMER:

RAB ENGINEERING

DRAWN: David Bilney

TITLE:

P1948-000-07  
CHAIN CONVEYORS

DESIGNED: David Bilney

DWG NO:

194801

DATE: 18/03/2021

JOB NO:

SCALE:  
Noted

SHEET  
22 OF 33


SHEET SIZE:  
A3

REV:  
1

DO NOT SCALE DRAWING

6mm PLATE @ 65 X 65	Steel, Mild	AS3678 - GR250
DESCRIPTION	MATERIAL	COMMENTS

P1948-000-08 - 6 REQ'D AS DRAWN

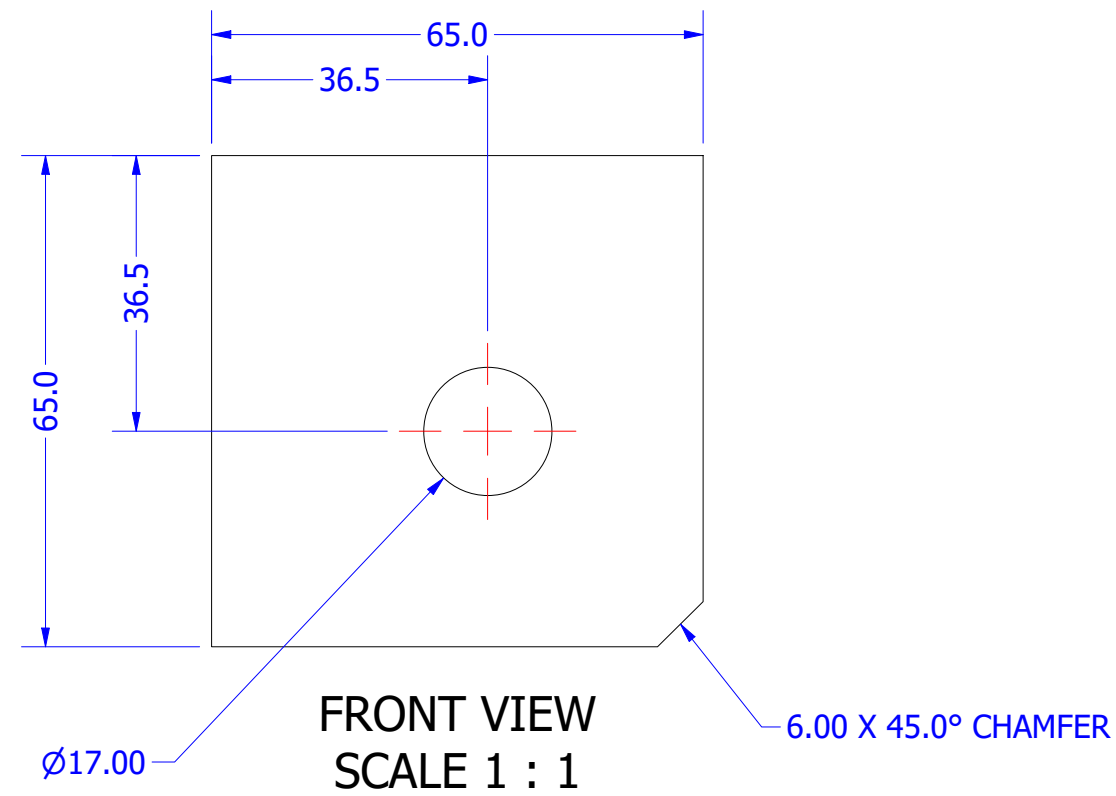


REMOVE ALL BURRS & SHARP EDGES



THESE DRAWINGS ARE THE PROPERTY OF ULTIMATE ENGINEERING AND SHOULD NOT BE REPRODUCED OR COPIED IN ANY WAY WITHOUT WRITTEN PERMISSION FROM ULTIMATE ENGINEERING

PAINT TREATMENT:

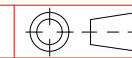

DIMENSION TOLERANCES	
DECIMAL	ANGULAR
X.X = ± .5 mm	X = ± 1°
X.XX = ± .25 mm	X.X = ± .5°
X.XXX = ± .125 mm	X.XX = ± .25°

MAXIMUM FINISHED SURFACE ROUGHNESS U.N.O. 1.6

PARENT ASSEMBLY

DRAWN: David Bilney

DESIGNED: David Bilney

DATE: 18/03/2021

CUSTOMER:

RAB ENGINEERING

TITLE:

P1948-000-08  
CHAIN CONVEYORS

DWG NO:

194801/18

JOB NO:

SCALE:  
Noted

SHEET  
23 OF 33


SHEET SIZE:  
A3

REV:  
1

DO NOT SCALE DRAWING

2mm PLATE @ 81 X 30	Steel, Mild	ASTM A240
DESCRIPTION	MATERIAL	COMMENTS

P1948-000-09 - 4 REQ'D AS DRAWN

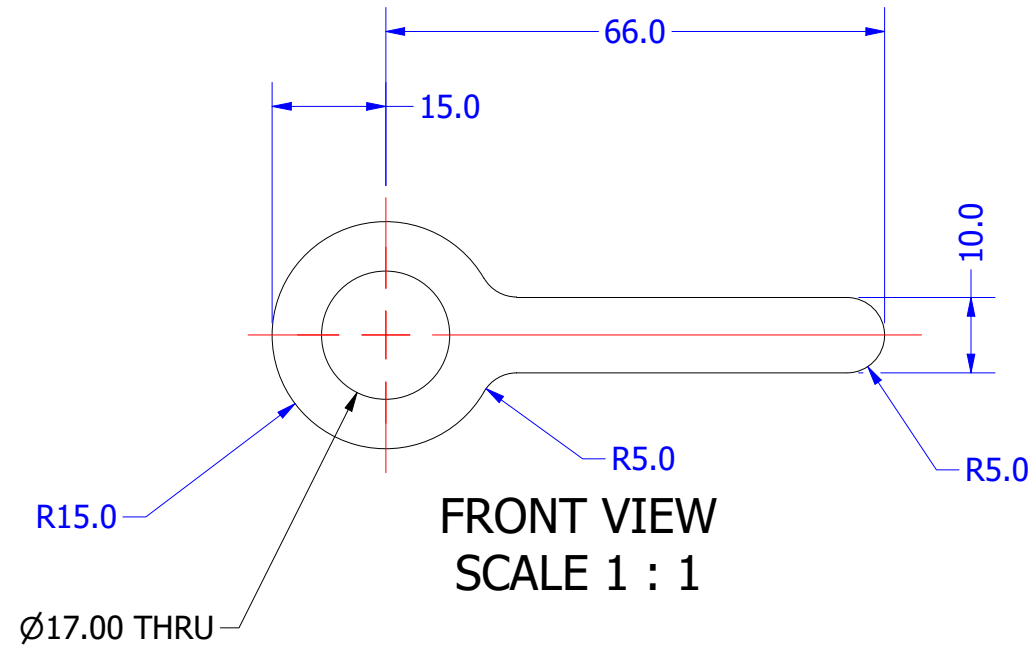


REMOVE ALL BURRS & SHARP EDGES



THESE DRAWINGS ARE THE PROPERTY OF ULTIMATE ENGINEERING AND SHOULD NOT BE REPRODUCED OR COPIED IN ANY WAY WITHOUT WRITTEN PERMISSION FROM ULTIMATE ENGINEERING

PAINT TREATMENT:

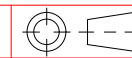

DIMENSION TOLERANCES	
DECIMAL	ANGULAR
X.X = ± .5 mm	X = ± 1°
X.XX = ± .25 mm	X.X = ± .5°
X.XXX = ± .125 mm	X.XX = ± .25°
MAXIMUM FINISHED SURFACE ROUGHNESS U.N.O. 1.6	

PARENT ASSEMBLY

DRAWN: David Bilney

DESIGNED: David Bilney

DATE: 18/03/2021

CUSTOMER:

TITLE: P1948-000-09  
CHAIN CONVEYORS

DWG NO: 194801/19

JOB NO:

SCALE: Noted  
SHEET 24 OF 33

SHEET SIZE: A3

REV: 1

DRAWN BY ULTIMATE ENGINEERING PTY LTD Ph 8562 1511


DO NOT SCALE DRAWING

40 RND BAR @ 12.5mm	Steel, Mild	AS3679 - GR300
DESCRIPTION	MATERIAL	COMMENTS


P1948-000-10 - 4 REQ'D AS DRAWN



ISO VIEW  
SCALE 1 : 1

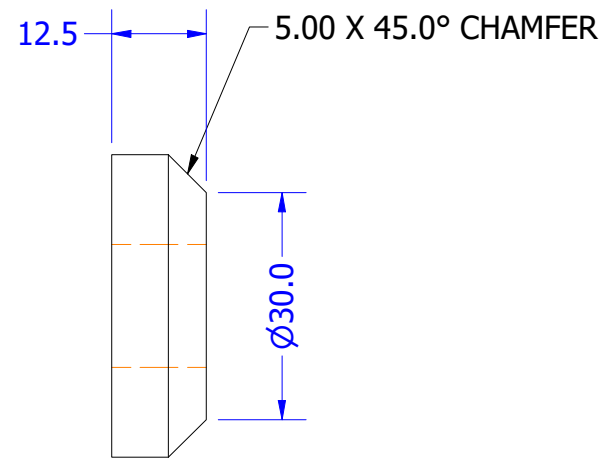

SIDE VIEW  
SCALE 1 : 1

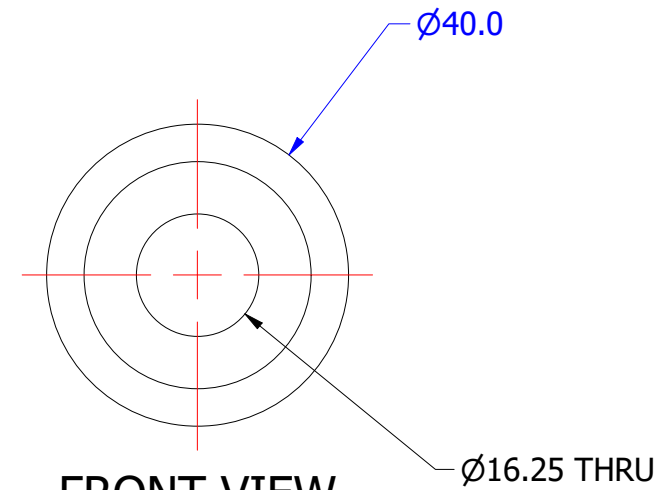


FRONT VIEW  
SCALE 1 : 1

REMOVE ALL BURRS & SHARP EDGES



THESE DRAWINGS ARE THE PROPERTY OF ULTIMATE ENGINEERING AND SHOULD NOT BE REPRODUCED OR COPIED IN ANY WAY WITHOUT WRITTEN PERMISSION FROM ULTIMATE ENGINEERING

PAINT TREATMENT: ZINC PLATE

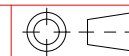

DIMENSION TOLERANCES	
DECIMAL	ANGULAR
X.X = ± .5 mm	X = ± 1°
X.XX = ± .25 mm	X.X = ± .5°
X.XXX = ± .125 mm	X.XX = ± .25°

MAXIMUM FINISHED SURFACE ROUGHNESS U.N.O. 1.6

PARENT ASSEMBLY

DRAWN: David Bilney

DESIGNED: David Bilney

DATE: 18/03/2021

CUSTOMER: **RAB ENGINEERING**

TITLE: P1948-000-10  
CHAIN CONVEYORS

DWG NO: **194801/20**

JOB NO:

SCALE: Noted  
SHEET 25 OF 33



SHEET SIZE: A3

REV: 1


DO NOT SCALE DRAWING

2	M12 ALL THREAD @ 185	Steel, Mild		1
1	32x45 HOLLOW BAR @ 30mm	Steel, Mild	194801/21	1
ITEM	PART NUMBER	MATERIAL	COMMENTS	ITEM QTY

P1948-000-11 - 2 REQ'D AS DRAWN

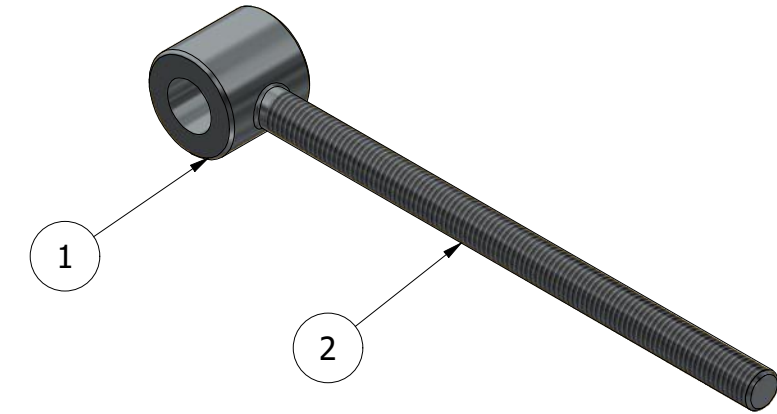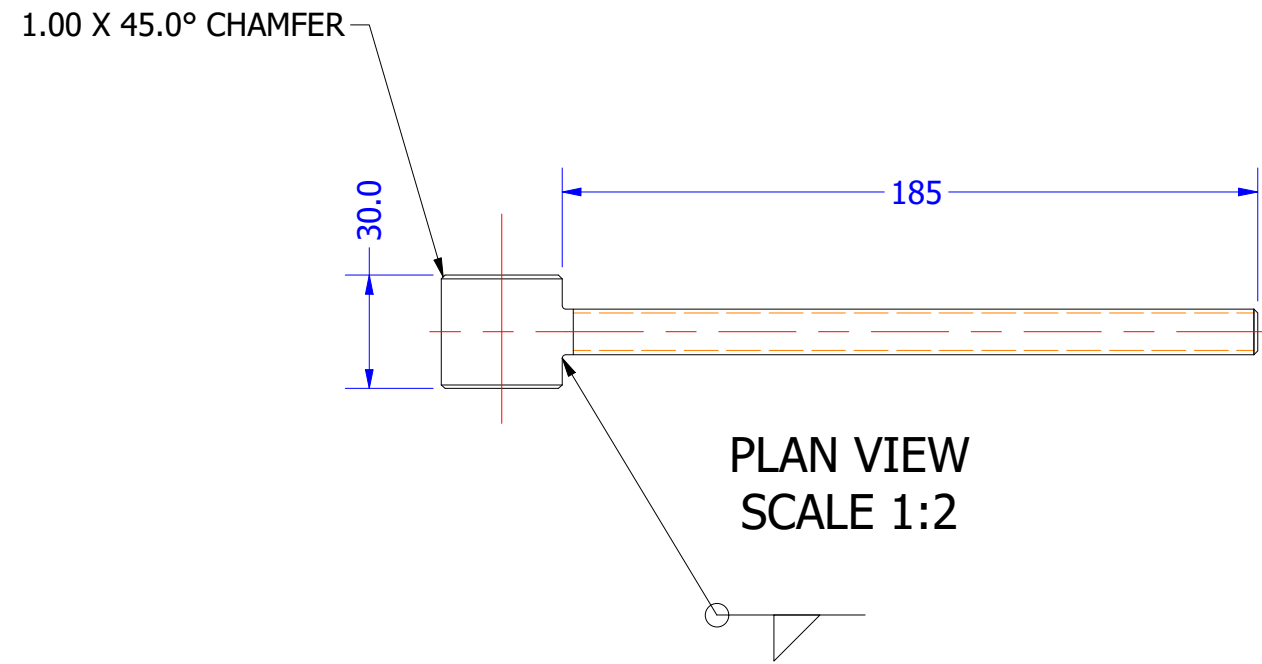

ISO VIEW  
SCALE 1:2

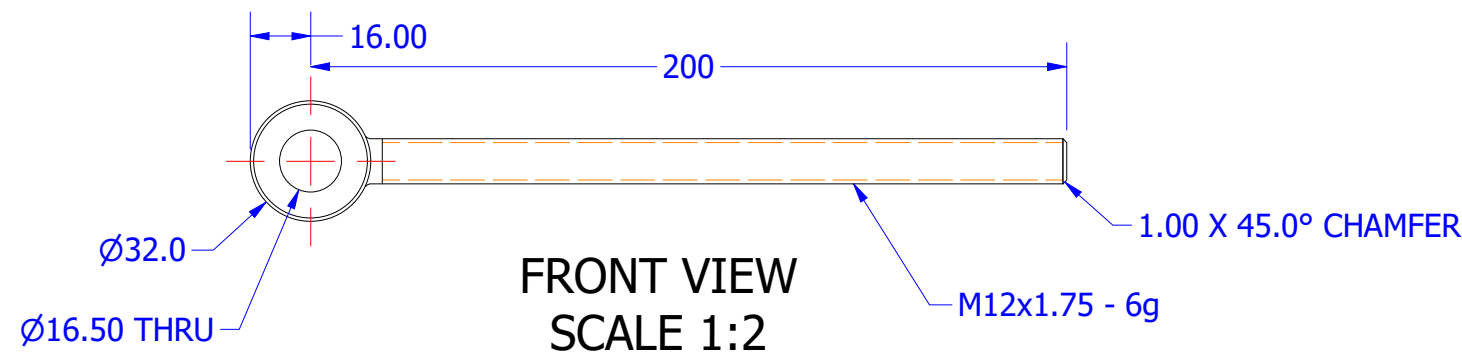

NOTES:


1. ALL WELDING TO CONFORM TO AS1554-GP UNO
2. ALL FILLET WELDS TO BE 6mm CONTINUOUS UNO
3. ALL BUTT WELDS SHALL BE FULL STRENGTH, COMPLETE PENETRATION WELDS
4. ALL FLAME CUT SURFACES SHALL BE UNIFORM & CLEAN BEFORE WELDING
5. REMOVE ALL BURRS & SHARP EDGES
6. NON DESTRUCTIVE TESTING:
  - A) ALL WELDS, 100% VISUAL SCAN TO AS1554 PART 1
7. FINISH:
  - A) ALL STEELWORK TO BE PRIMED OR COLD GALV UNO

DRAWN BY ULTIMATE ENGINEERING PTY LTD Ph 8562 1511



THESE DRAWINGS ARE THE PROPERTY OF ULTIMATE ENGINEERING AND SHOULD NOT BE REPRODUCED OR COPIED IN ANY WAY WITHOUT WRITTEN PERMISSION FROM ULTIMATE ENGINEERING

PAINT TREATMENT: ZINC PLATE

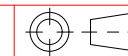

DIMENSION TOLERANCES	
DECIMAL	ANGULAR
X.X = ± .5 mm	X = ± 1°
X.XX = ± .25 mm	X.X = ± .5°
X.XXX = ± .125 mm	X.XX = ± .25°


MAXIMUM FINISHED SURFACE ROUGHNESS U.N.O. 1.6

PARENT ASSEMBLY	CUSTOMER: <b>RAB ENGINEERING</b>
DRAWN: David Bilney	TITLE: P1948-000-11 CHAIN CONVEYORS
DESIGNED: David Bilney	DWG NO: <b>194801/21</b>
DATE: 18/03/2021	JOB NO:
SCALE: Noted	SHEET: 26 OF 33
	SHEET SIZE: A3
	REV: 1

DO NOT SCALE DRAWING

10mm PLATE @ 370 X 170	Mild Steel	AS3678 - GR250
DESCRIPTION	MATERIAL	COMMENTS

P1948-000-12 - 1 REQ'D AS DRAWN

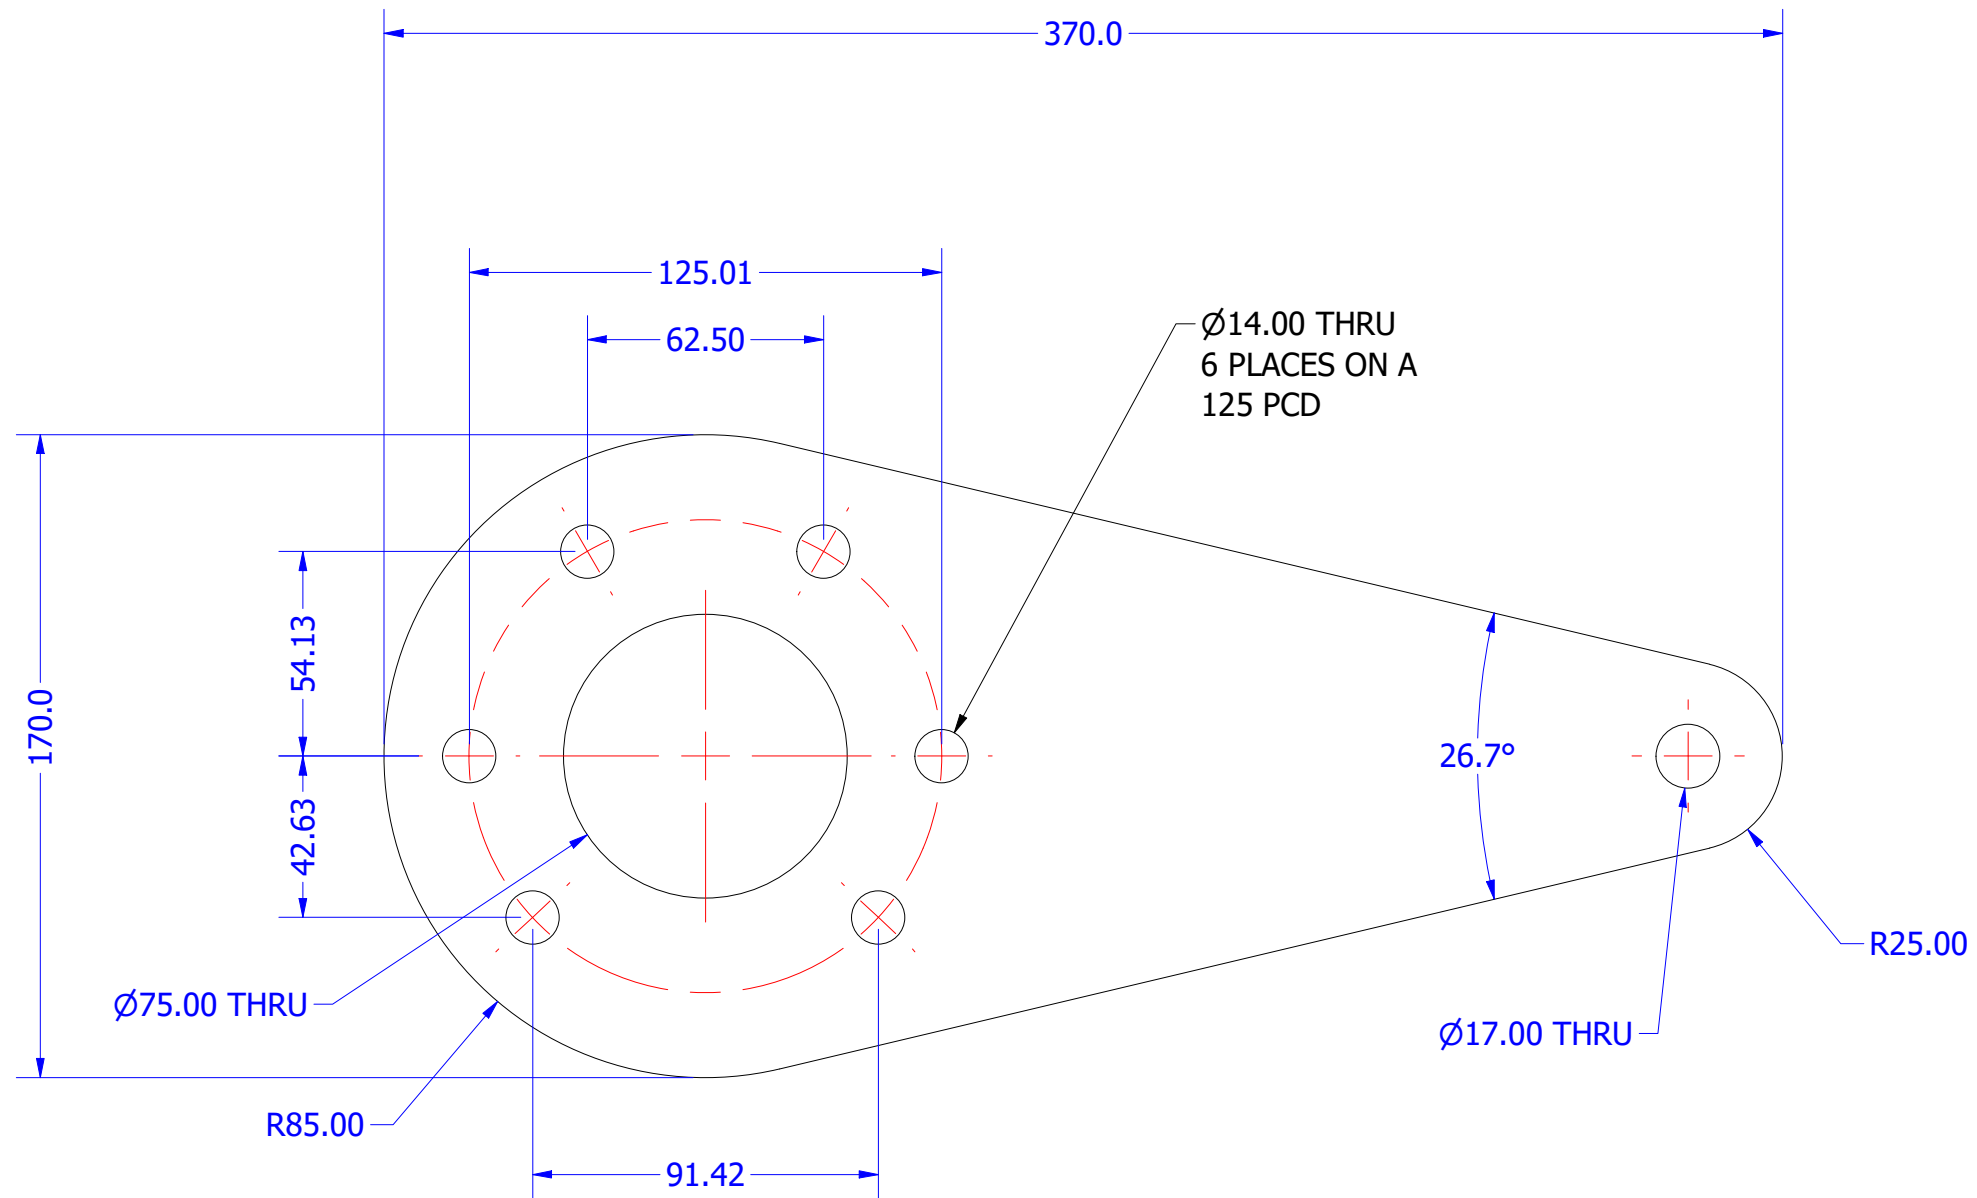


FRONT VIEW  
SCALE 1:2

REMOVE ALL BURRS & SHARP EDGES



THESE DRAWINGS ARE THE PROPERTY OF ULTIMATE ENGINEERING AND SHOULD NOT BE REPRODUCED OR COPIED IN ANY WAY WITHOUT WRITTEN PERMISSION FROM ULTIMATE ENGINEERING

PAINT TREATMENT:

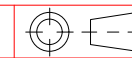

PARENT ASSEMBLY

CUSTOMER:

RAB ENGINEERING

DIMENSION TOLERANCES

DECIMAL	ANGULAR
X.X = ± .5 mm	X = ± 1'
X.XX = ± .25 mm	X.X = ± .5'
X.XXX = ± .125 mm	X.XX = ± .25'

DRAWN: David Bilney

TITLE:

P1948-000-12  
CHAIN CONVEYORS

DESIGNED: David Bilney

DWG NO:

194801/22

DATE: 18/03/2021

JOB NO:

SCALE:  
Noted

SHEET  
27 OF 33

SHEET SIZE:  
A3

REV:  
1


MAXIMUM FINISHED SURFACE ROUGHNESS U.N.O. 1.6



DO NOT SCALE DRAWING

16mm PLATE @ 200 X 50	Steel, Mild	AS3678 - GR250
DESCRIPTION	MATERIAL	COMMENTS

P1948-000-13 - 1 REQ'D AS DRAWN

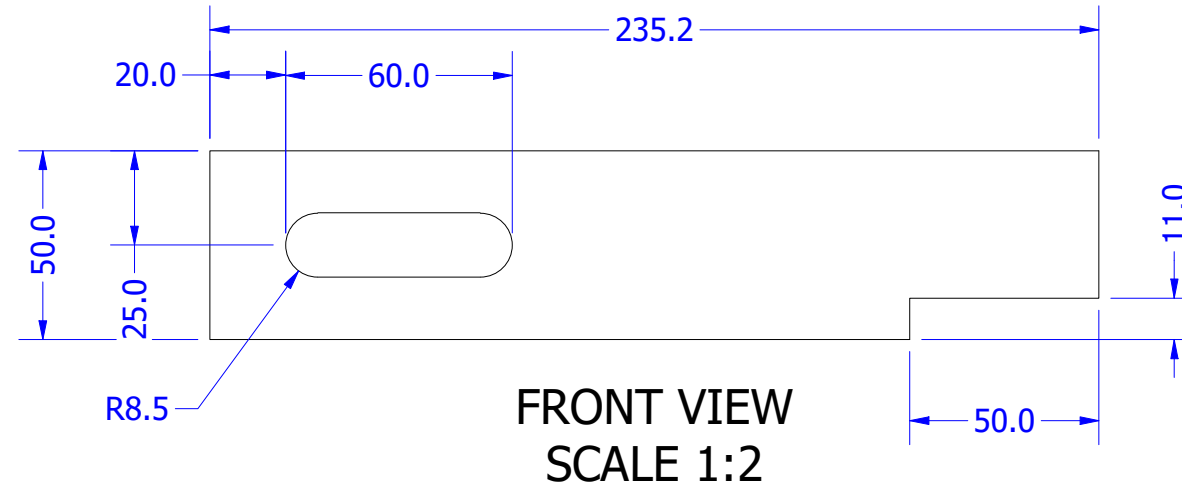


REMOVE ALL BURRS & SHARP EDGES



THESE DRAWINGS ARE THE PROPERTY OF ULTIMATE ENGINEERING AND SHOULD NOT BE REPRODUCED OR COPIED IN ANY WAY WITHOUT WRITTEN PERMISSION FROM ULTIMATE ENGINEERING

PAINT TREATMENT:

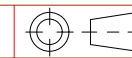

DIMENSION TOLERANCES	
DECIMAL	ANGULAR
X.X = ± .5 mm	X = ± 1°
X.XX = ± .25 mm	X.X = ± .5°
X.XXX = ± .125 mm	X.XX = ± .25°
MAXIMUM FINISHED SURFACE ROUGHNESS U.N.O. 1.6	

PARENT ASSEMBLY

CUSTOMER: **RAB ENGINEERING**

DRAWN: David Bilney

TITLE: P1948-000-13  
CHAIN CONVEYORS

DESIGNED: David Bilney

DWG NO: **194801/23**

DATE: 18/03/2021

JOB NO:

SCALE: Noted

SHEET 28 OF 33

SHEET SIZE: A3

REV: 1




DO NOT SCALE DRAWING

30x13.5 FLAT @ 995	Polyethylene, High Density	POSSIBLY STORE ITEM (ORORA)
DESCRIPTION	MATERIAL	COMMENTS

P1948-000-15 - 8 REQ'D AS DRAWN



ISO VIEW  
SCALE 1:5

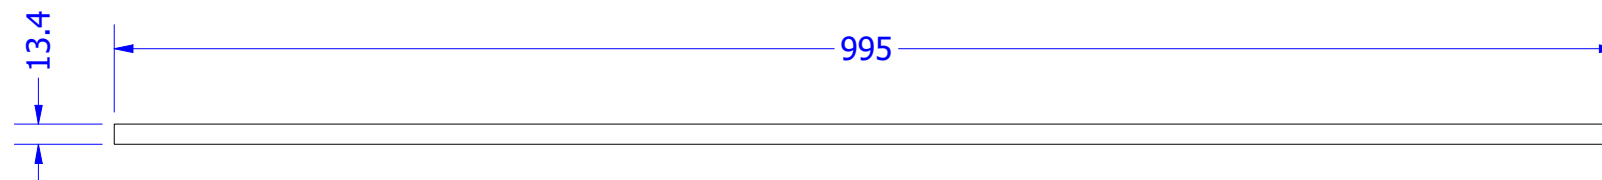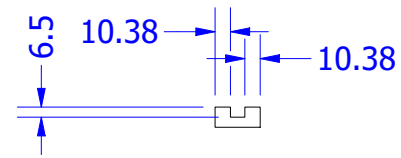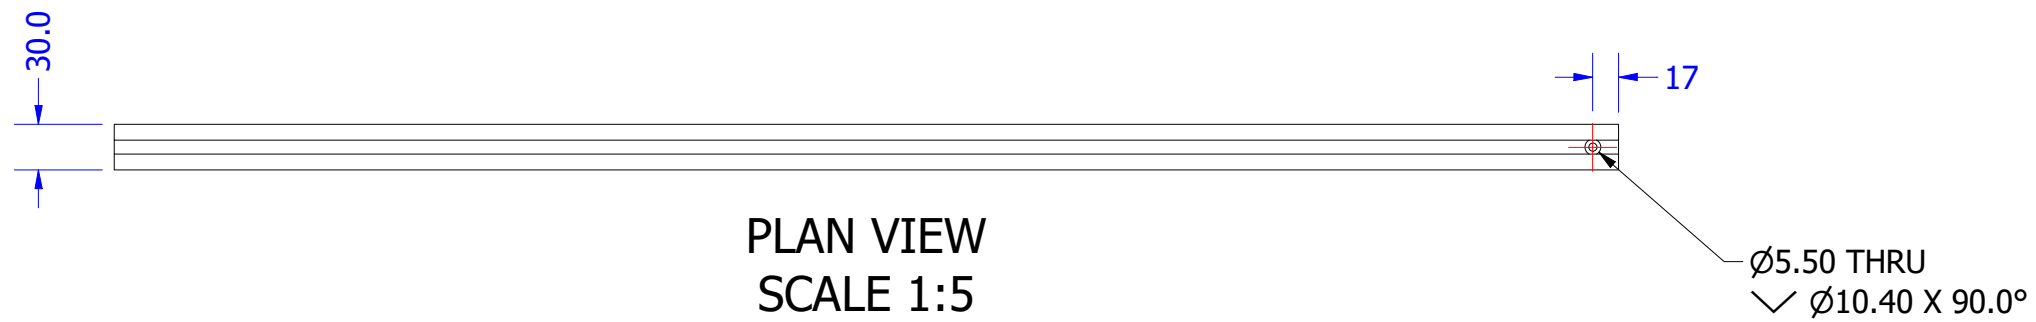


DRAWN BY ULTIMATE ENGINEERING PTY LTD Ph 8562 1511



THESE DRAWINGS ARE THE PROPERTY OF ULTIMATE ENGINEERING AND SHOULD NOT BE REPRODUCED OR COPIED IN ANY WAY WITHOUT WRITTEN PERMISSION FROM ULTIMATE ENGINEERING

PAINT TREATMENT:

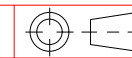

DIMENSION TOLERANCES	
DECIMAL	ANGULAR
X.X = ± .5 mm	X = ± 1°
X.XX = ± .25 mm	X.X = ± .5°
X.XXX = ± .125 mm	X.XX = ± .25°
MAXIMUM FINISHED SURFACE ROUGHNESS U.N.O. 1.6	

PARENT ASSEMBLY

CUSTOMER: **RAB ENGINEERING**

DRAWN: David Bilney

TITLE: P1948-000-15  
CHAIN CONVEYORS

DESIGNED: David Bilney

DWG NO: **194801/25**

DATE: 18/03/2021

JOB NO:


SCALE: Noted  
SHEET 29 OF 33

SHEET SIZE: A3  
REV: 1


DO NOT SCALE DRAWING

2mm PLATE @ 790 X 355	Steel, Mild	AS1594 - GR250
DESCRIPTION	MATERIAL	COMMENTS


P1948-000-16 - 1 REQ'D AS DRAWN  
 P1948-000-17 - 1 REQ'D OPPOSITE  
 (2 BLANKS REQ'D)

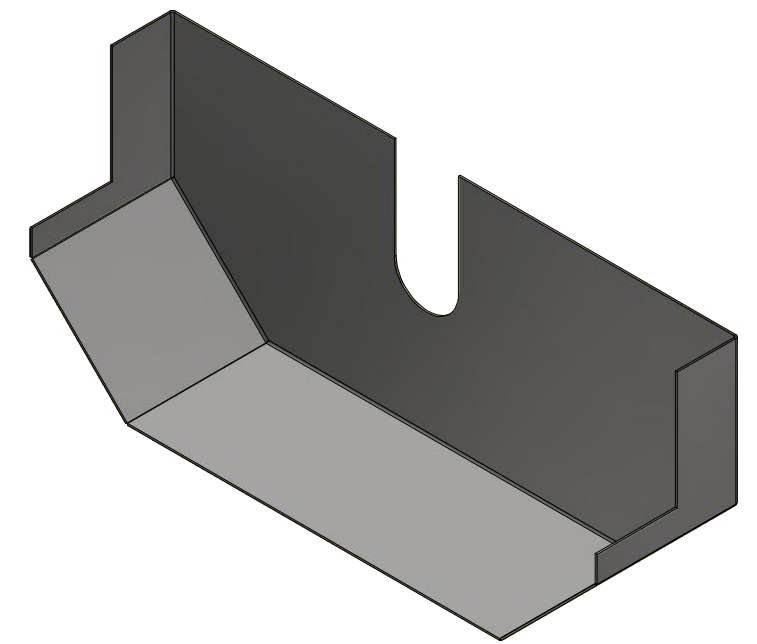


ISO VIEW - FOLDED  
 SCALE 1:5

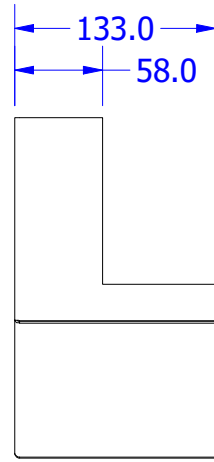

SIDE VIEW - FOLDED  
 SCALE 1:5

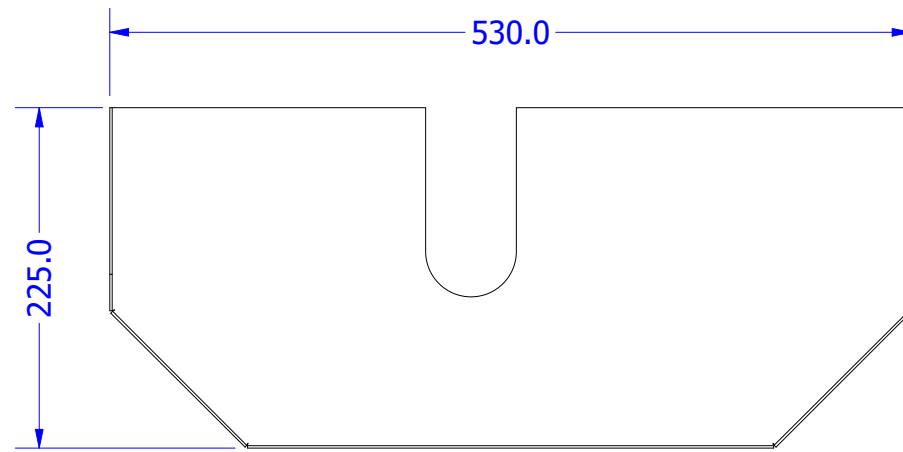

FRONT VIEW - FOLDED  
 SCALE 1:5

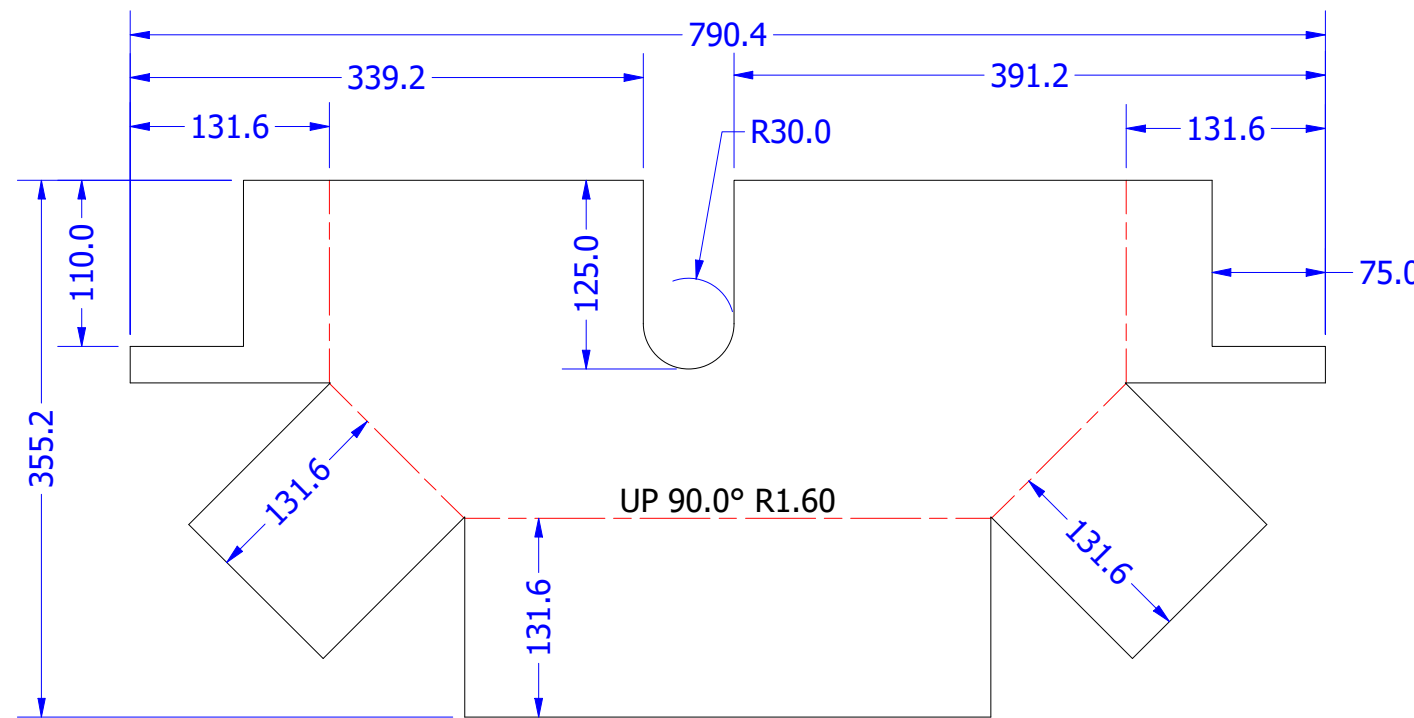


P1948-000-16 - ALL FOLDS UP 90°  
 P1948-000-17 - ALL FOLDS DOWN 90°  
 SCALE 1:5

REMOVE ALL BURRS & SHARP EDGES



THESE DRAWINGS ARE THE PROPERTY OF ULTIMATE ENGINEERING AND SHOULD NOT BE REPRODUCED OR COPIED IN ANY WAY WITHOUT WRITTEN PERMISSION FROM ULTIMATE ENGINEERING

PAINT TREATMENT:

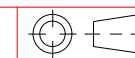


DIMENSION TOLERANCES	
DECIMAL	ANGULAR
X.X = ± .5 mm	X = ± 1°
X.XX = ± .25 mm	X.X = ± .5°
X.XXX = ± .125 mm	X.XX = ± .25°
MAXIMUM FINISHED SURFACE ROUGHNESS U.N.O. 1.6	

PARENT ASSEMBLY	CUSTOMER: <b>RAB ENGINEERING</b>
DRAWN: David Bilney	TITLE: P1948-000-16 CHAIN CONVEYORS
DESIGNED: David Bilney	DWG NO: <b>194801/26</b>
DATE: 18/03/2021	JOB NO:
SCALE: Noted	SHEET: 30 OF 33
SHEET SIZE: A3	REV: 1


DO NOT SCALE DRAWING

30x10 FLAT @ 1795	HDPE	
DESCRIPTION	MATERIAL	COMMENTS


P1948-000-23 - 2 REQ'D AS DRAWN

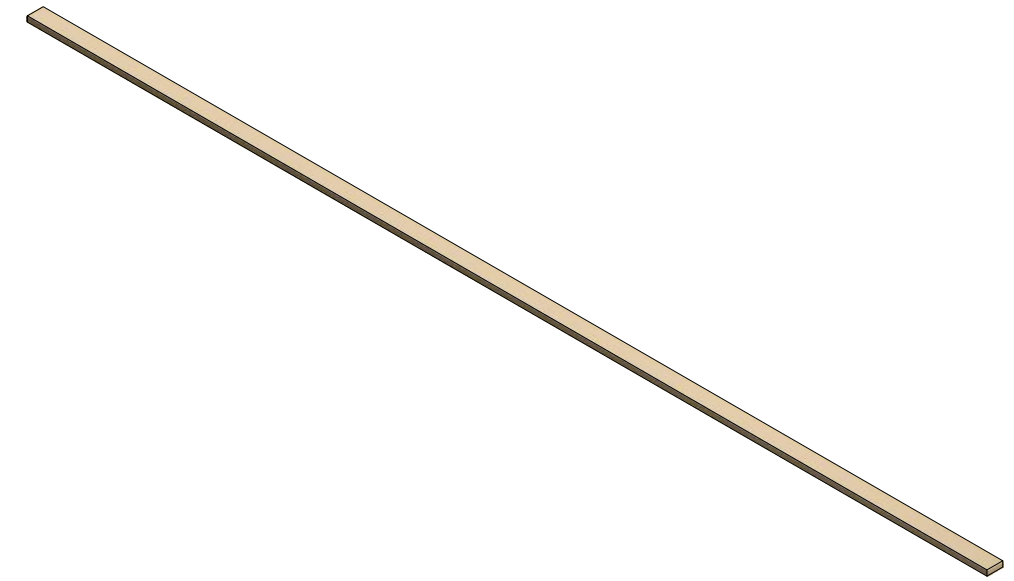

ISO VIEW  
SCALE 1:10

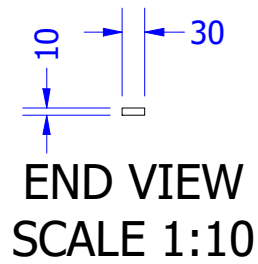

END VIEW  
SCALE 1:10

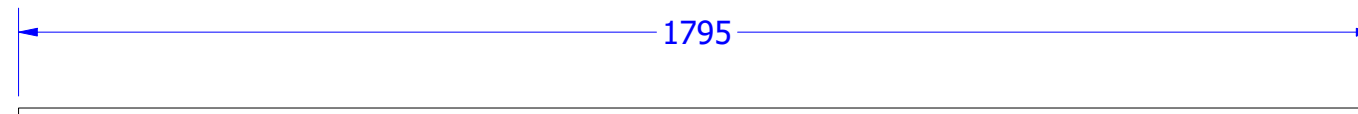


SIDE VIEW  
SCALE 1:10

REMOVE ALL BURRS & SHARP EDGES



THESE DRAWINGS ARE THE PROPERTY OF ULTIMATE ENGINEERING AND SHOULD NOT BE REPRODUCED OR COPIED IN ANY WAY WITHOUT WRITTEN PERMISSION FROM ULTIMATE ENGINEERING

PAINT TREATMENT:

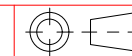

DIMENSION TOLERANCES	
DECIMAL	ANGULAR
X.X = ± .5 mm	X = ± 1°
X.XX = ± .25 mm	X.X = ± .5°
X.XXX = ± .125 mm	X.XX = ± .25°
MAXIMUM FINISHED SURFACE ROUGHNESS U.N.O. 1.6	

PARENT ASSEMBLY

CUSTOMER:

RAB ENGINEERING

DRAWN: David Bilney

TITLE:

P1948-000-23  
CHAIN CONVEYORS

DESIGNED: David Bilney

DWG NO:

194802

DATE: 18/03/2021

JOB NO:

SCALE:  
Noted

SHEET  
31 OF 33


SHEET SIZE:  
A3

REV:  
1

DO NOT SCALE DRAWING

30x10 FLAT @ 895	Polyethylene, High Density	
DESCRIPTION	MATERIAL	COMMENTS


P1948-000-24 - 2 REQ'D AS DRAWN

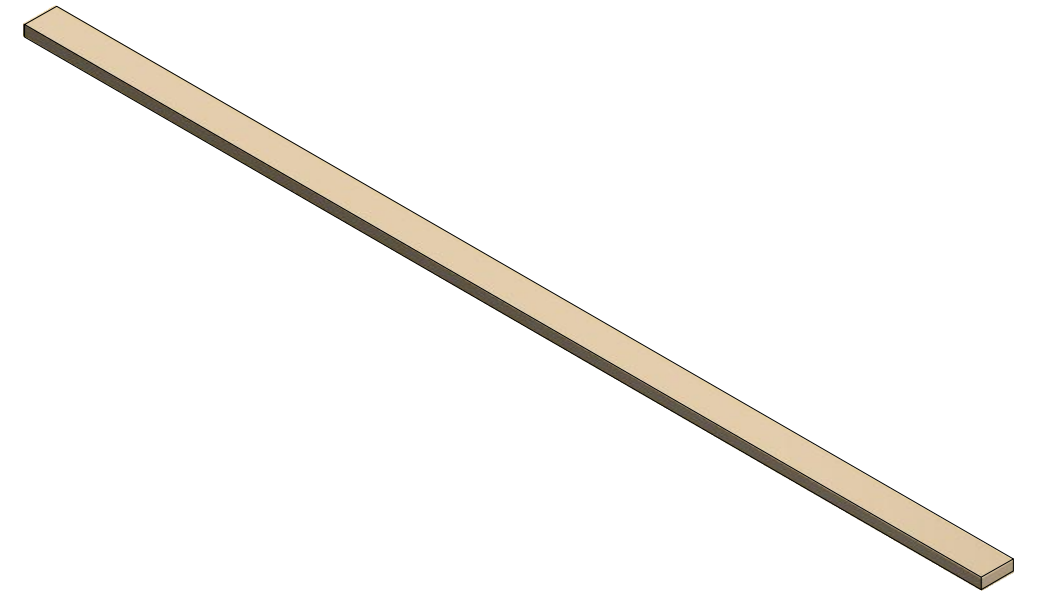


ISO VIEW  
SCALE 1:5



PLAN VIEW  
SCALE 1:5

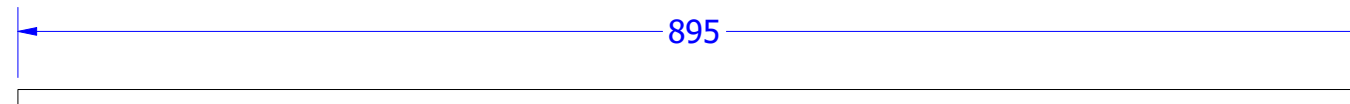

SIDE VIEW  
SCALE 1:5

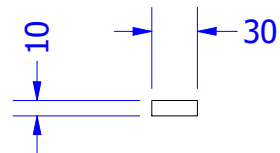

END VIEW  
SCALE 1:5

REMOVE ALL BURRS & SHARP EDGES



THESE DRAWINGS ARE THE PROPERTY OF ULTIMATE ENGINEERING AND SHOULD NOT BE REPRODUCED OR COPIED IN ANY WAY WITHOUT WRITTEN PERMISSION FROM ULTIMATE ENGINEERING

PAINT TREATMENT:



DIMENSION TOLERANCES	
DECIMAL	ANGULAR
X.X = ± .5 mm	X = ± 1°
X.XX = ± .25 mm	X.X = ± .5°
X.XXX = ± .125 mm	X.XX = ± .25°
MAXIMUM FINISHED SURFACE ROUGHNESS U.N.O. 1.6	

PARENT ASSEMBLY

DRAWN: David Bilney

DESIGNED: David Bilney

DATE: 18/03/2021

CUSTOMER: RAB ENGINEERING

TITLE: P1948-000-24  
CHAIN CONVEYORS





DWG NO: 194801/31

JOB NO:	SCALE: Noted	SHEET 32 OF 33	SHEET SIZE: A3	REV: 1
---------	--------------	----------------	----------------	--------

DRAWN BY ULTIMATE ENGINEERING PTY LTD Ph 8562 1511

DO NOT SCALE DRAWING

24RND BAR @ 50mm	Steel, Mild	AS1443 - 1020
DESCRIPTION	MATERIAL	COMMENTS

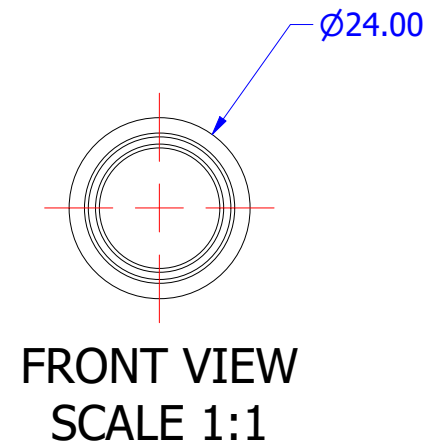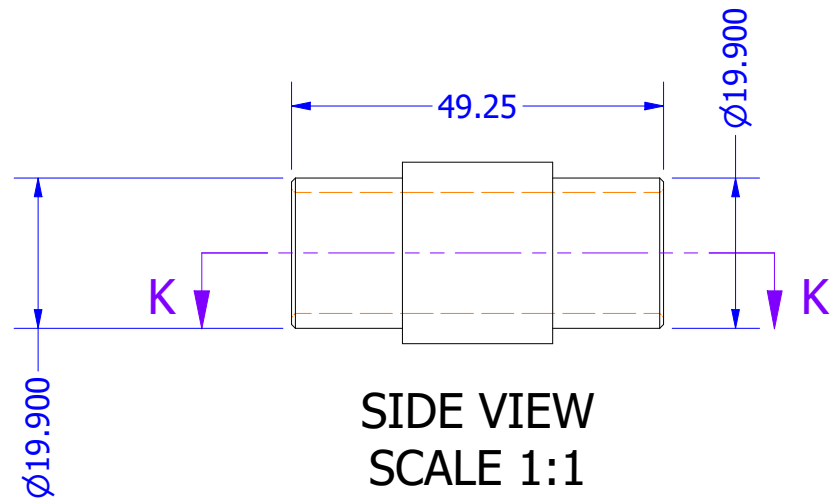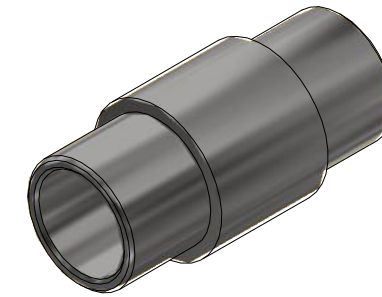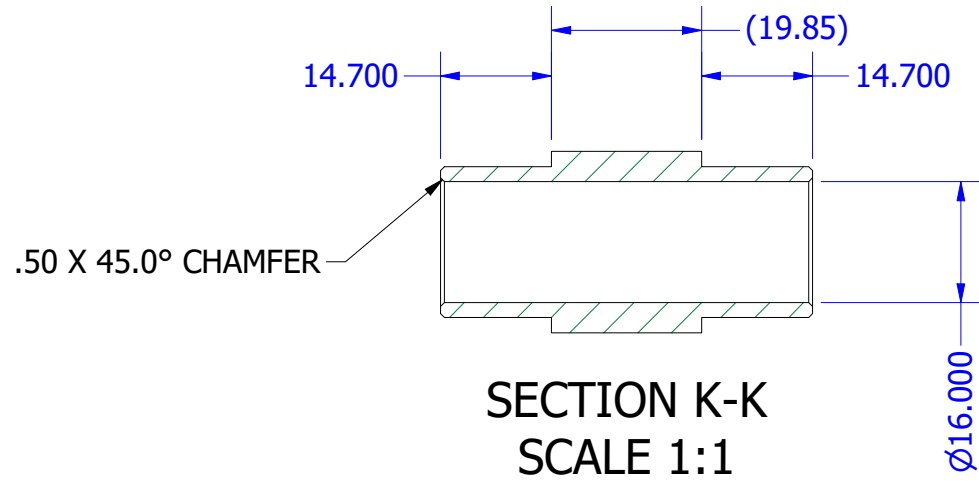


REMOVE ALL BURRS & SHARP EDGES



THESE DRAWINGS ARE THE PROPERTY OF ULTIMATE ENGINEERING AND SHOULD NOT BE REPRODUCED OR COPIED IN ANY WAY WITHOUT WRITTEN PERMISSION FROM ULTIMATE ENGINEERING

PAINT TREATMENT:

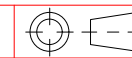

DIMENSION TOLERANCES	
DECIMAL	ANGULAR
X.X = ± .5 mm	X = ± 1°
X.XX = ± .25 mm	X.X = ± .5°
X.XXX = ± .125 mm	X.XX = ± .25°
MAXIMUM FINISHED SURFACE ROUGHNESS U.N.O. 1.6	

PARENT ASSEMBLY

DRAWN: David Bilney

DESIGNED: David Bilney

DATE: 18/03/2021

CUSTOMER:

RAB ENGINEERING

TITLE:

P1948-000-29  
CHAIN CONVEYORS

DWG NO:

194801/34

JOB NO:

SCALE:  
Noted

SHEET  
33 OF 33


SHEET SIZE:  
A3

REV:  
1



DO NOT SCALE DRAWING

12	A1948-008-01		194811	1
11	25NB PIPE	Steel, Mild	19mm	2
10	AS 1112 - M24 FINE	Steel, Mild	HEX NUT	2
9	A1948-004-02	ASSEMBLY	SHEET 4	1
8	RETAINING CLIP 2	Steel, Mild	SHEET 19	1
7	P1948-000-25	Steel, Mild	SHEET 19	1
6	RETAINING CLIP	Steel, Mild	SHEET 20	4
5	P1948-000-26	Steel, Mild	SHEET 20	4
4	MALE ROD END M24	Steel, Mild		1
3	KJ27D_D	SMC	FEMALE ROD END M27	1
2	CP96SD125-200(200_1_0)	SMC	PNEUMATIC CYLINDER	1
1	A1948-001-01	ASSEMBLY	SHEET 5	1
ITEM	PART NUMBER	MATERIAL	COMMENTS	ITEM QTY

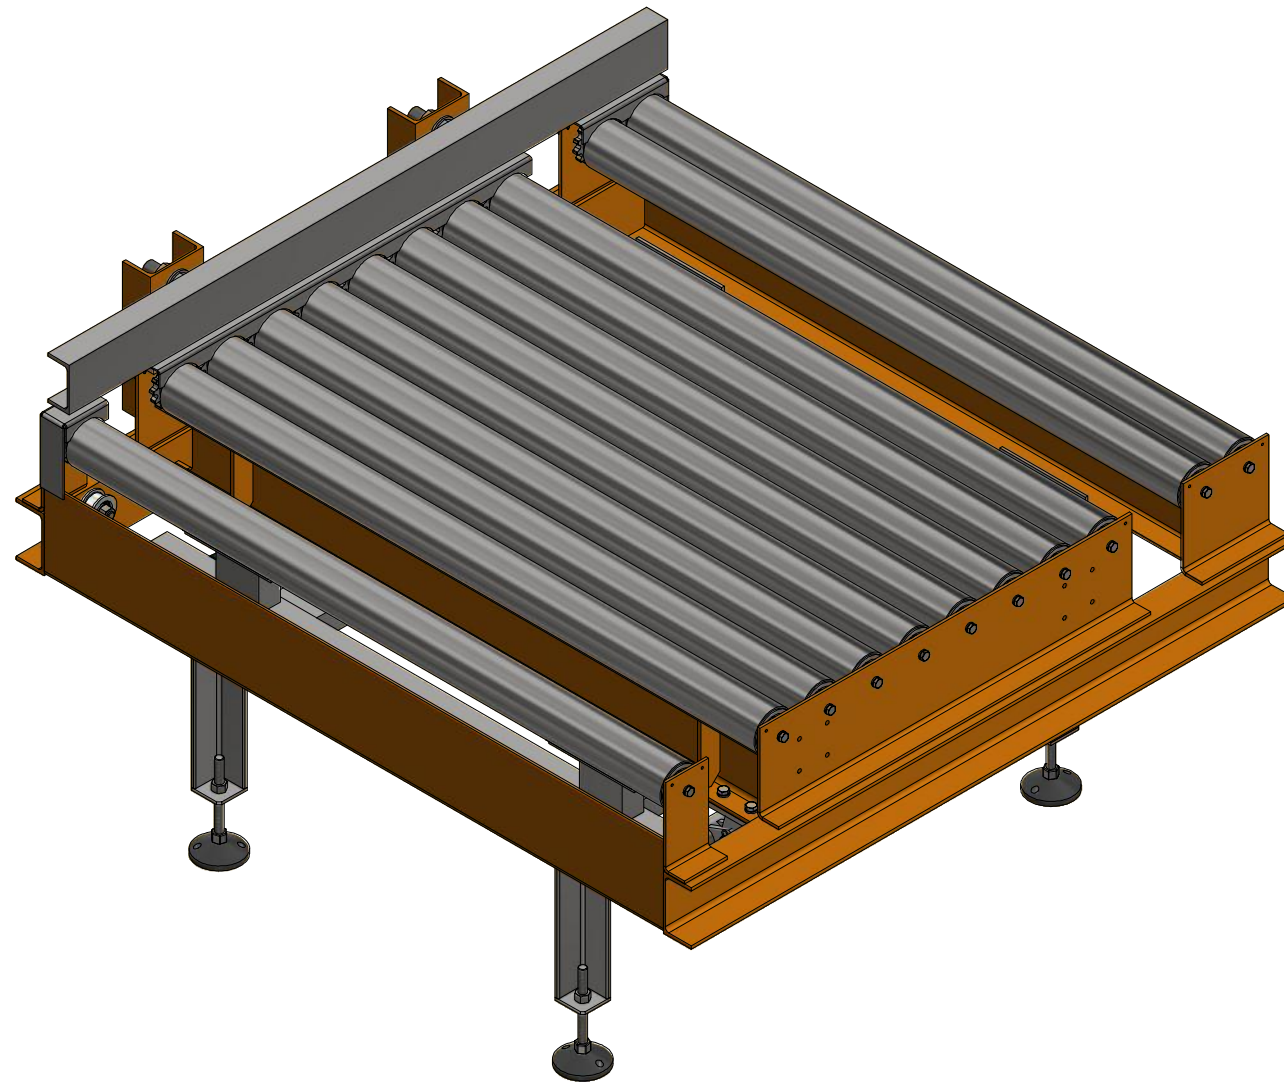

1 ASSEMBLY AS SHOWN REQ'D  
6 ASSEMBLIES WITHOUT STOPS REQ'D

FINAL ASSEMBLY  
SCALE 1:12.5

DRAWN BY ULTIMATE ENGINEERING PTY LTD Ph 8562 1511




2	14/05/2021	CIRCLIP GROOVE & SIZE CHANGE IDLER PULLEY	
1	27/04/2021	AS BUILT	DB
REV	DATE	DESCRIPTION	APPRD
REVISION HISTORY			
THESE DRAWINGS ARE THE PROPERTY OF ULTIMATE ENGINEERING AND SHOULD NOT BE REPRODUCED OR COPIED IN ANY WAY WITHOUT WRITTEN PERMISSION FROM ULTIMATE ENGINEERING			


PAINT TREATMENT:	
DIMENSION TOLERANCES	
DECIMAL                      ANGULAR	
X.X    = ± .5 mm	X        = ± 1'
X.XX   = ± .25 mm	X.X     = ± .5'
X.XXX   = ± .125 mm	X.XX   = ± .25'
MAXIMUM FINISHED SURFACE ROUGHNESS U.N.O. 1.6 ✓	

PARENT ASSEMBLY	CUSTOMER:	<b>RAB ENGINEERING</b>			
DRAWN: David Bilney	TITLE:	A1948-004-01 CHAIN CONVEYORS			
DESIGNED: David Bilney	DWG NO:	<b>194804</b>			
DATE: 22/03/2021	JOB NO:	SCALE: Noted	SHEET 1 OF 48	SHEET SIZE: A3	REV: 2


DO NOT SCALE DRAWING

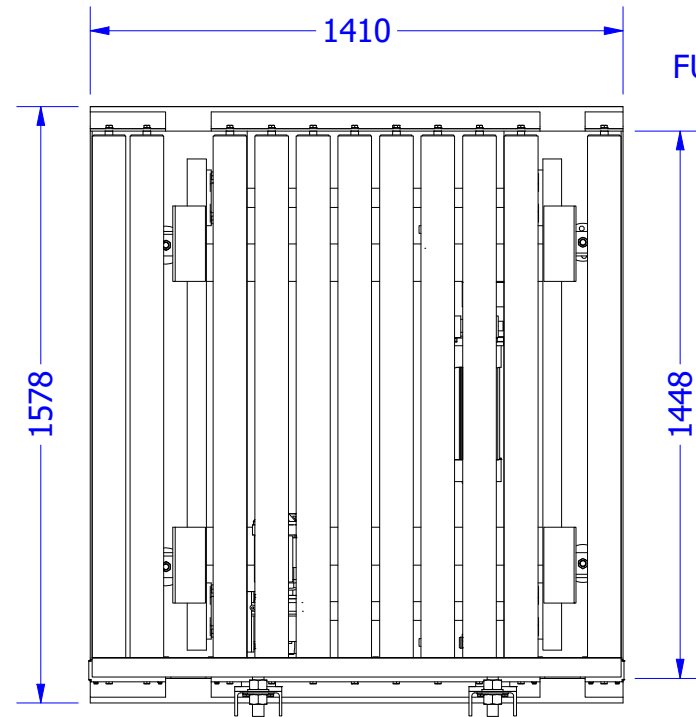


PLAN VIEW  
SCALE 1:20

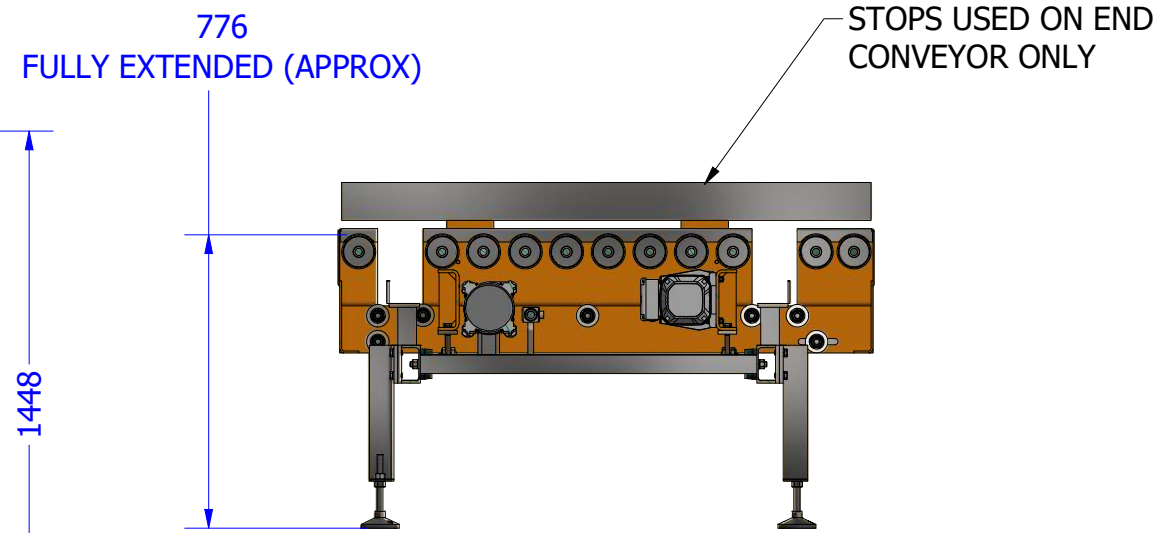


SECTION F-F  
SCALE 1:20

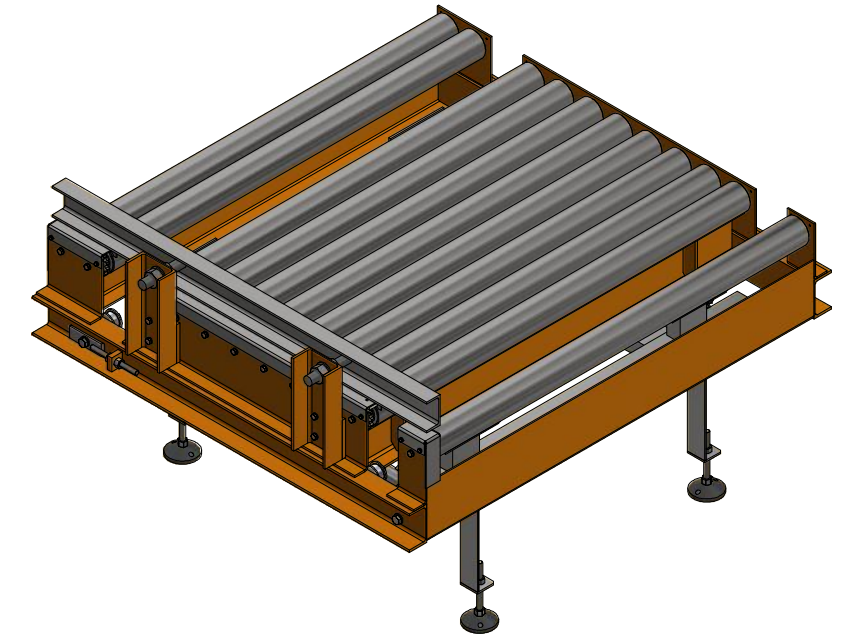

ISO VIEW  
SCALE 1:20

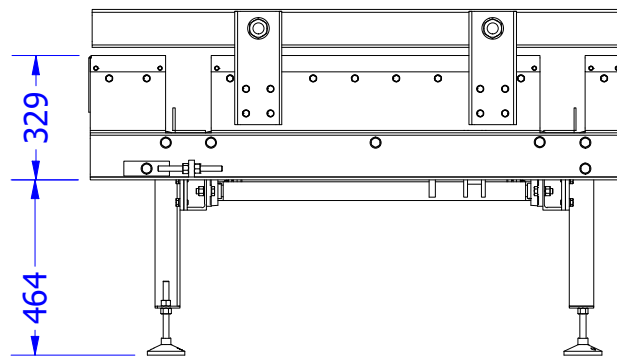

END VIEW  
SCALE 1:20

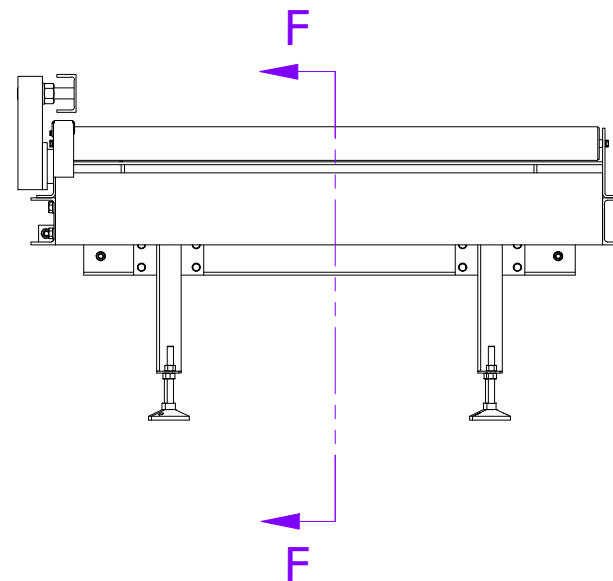


SIDE VIEW  
SCALE 1:20

DRAWN BY ULTIMATE ENGINEERING PTY LTD Ph 8562 1511



THESE DRAWINGS ARE THE PROPERTY OF ULTIMATE ENGINEERING AND SHOULD NOT BE REPRODUCED OR COPIED IN ANY WAY WITHOUT WRITTEN PERMISSION FROM ULTIMATE ENGINEERING

PAINT TREATMENT:

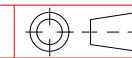

DIMENSION TOLERANCES  
DECIMAL ANGULAR  
X.X = ± .5 mm X = ± 1°  
X.XX = ± .25 mm X.X = ± .5°  
X.XXX = ± .125 mm X.XX = ± .25°  
MAXIMUM FINISHED SURFACE ROUGHNESS U.N.O. 1.6

PARENT ASSEMBLY

CUSTOMER:

RAB ENGINEERING

DRAWN: David Bilney

TITLE:

A1948-004-01  
CHAIN CONVEYORS

DESIGNED: David Bilney

DWG NO:

194804

DATE: 22/03/2021

JOB NO:


SCALE:  
Noted

SHEET  
2 OF 48


SHEET SIZE:  
A3

REV:  
2


DO NOT SCALE DRAWING

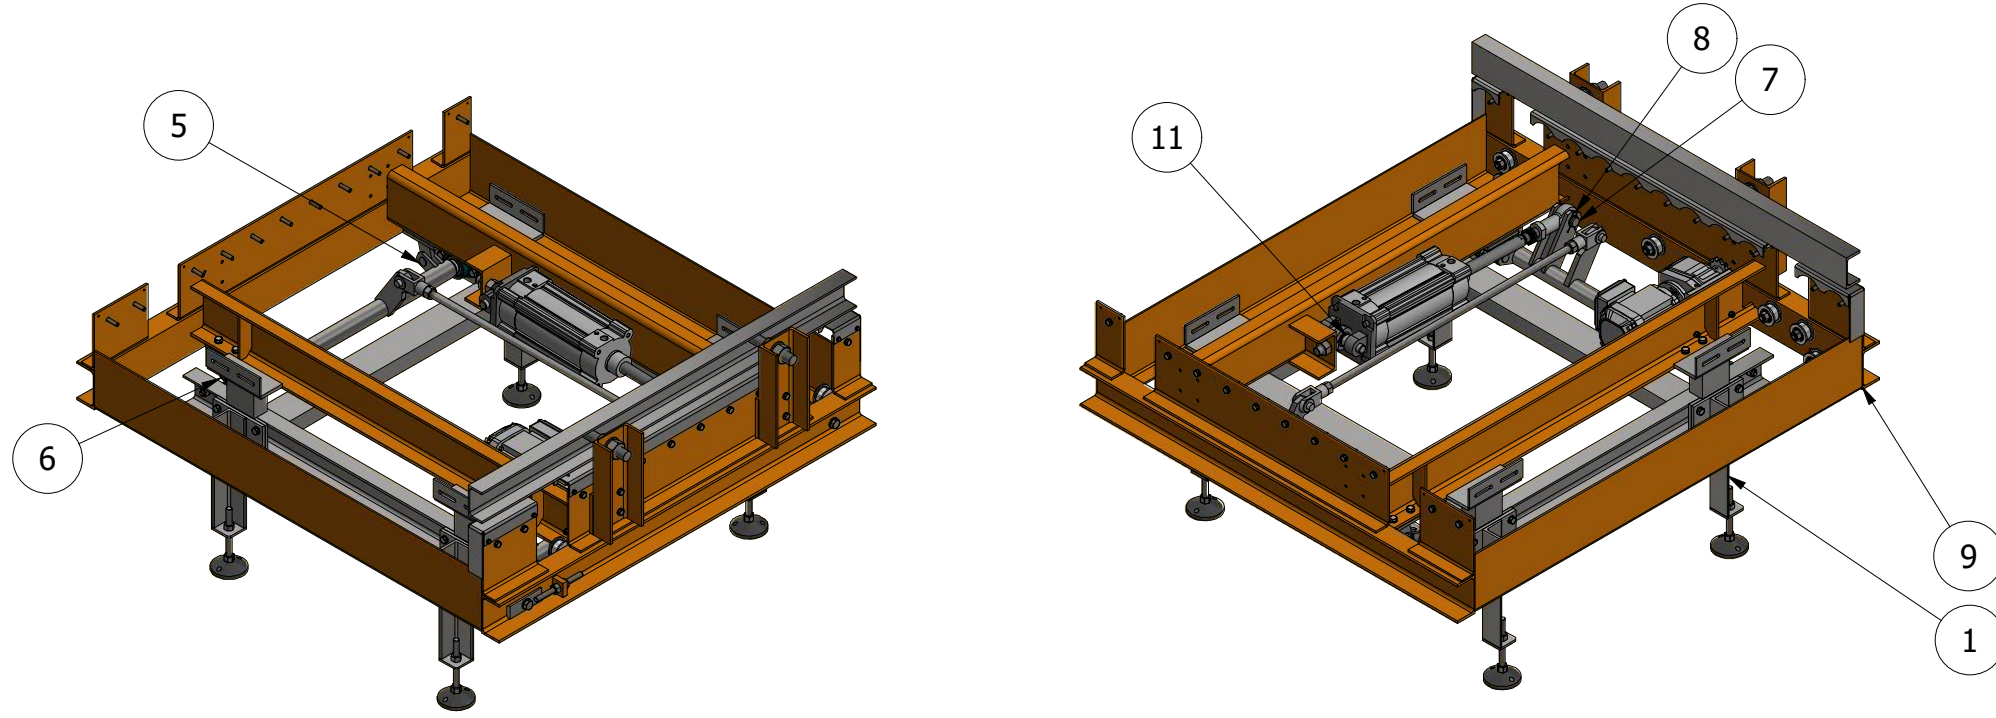

ITEM	PART NUMBER	MATERIAL	COMMENTS	ITEM QTY
12	A1948-008-01		194811	1
11	25NB PIPE	Steel, Mild	19mm	2
10	AS 1112 - M24 FINE	Steel, Mild	HEX NUT	2
9	A1948-004-02	ASSEMBLY	SHEET 4	1
8	RETAINING CLIP 2	Steel, Mild	SSHEET 19	1
7	P1948-000-25	Steel, Mild	SHEET 19	1
6	RETAINING CLIP	Steel, Mild	SHEET 20	4
5	P1948-000-26	Steel, Mild	SHEET 20	4
4	M2445 MALE ROD END		SMC PNEUMATICS	1
3	KJ27D_D		SMC PNEUMATICS	1
2	CP96SD125-200(200_1_0)	CYLINDER	SMC PNEUMATICS	1
1	A1948-001-01	ASSEMBLY	SHEET 5	1

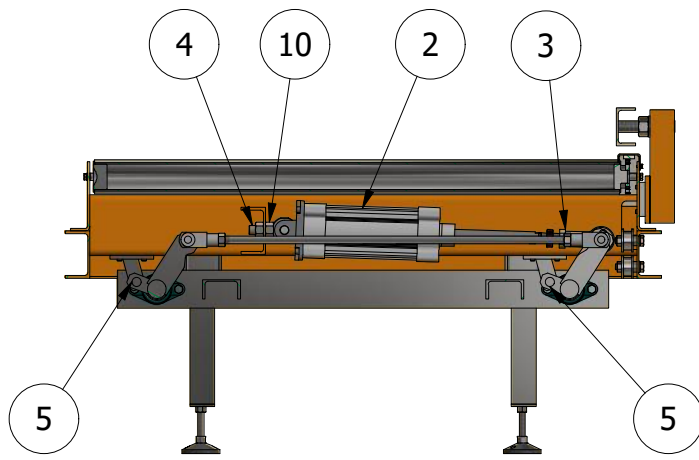

SECTION N-N  
SCALE 1:20

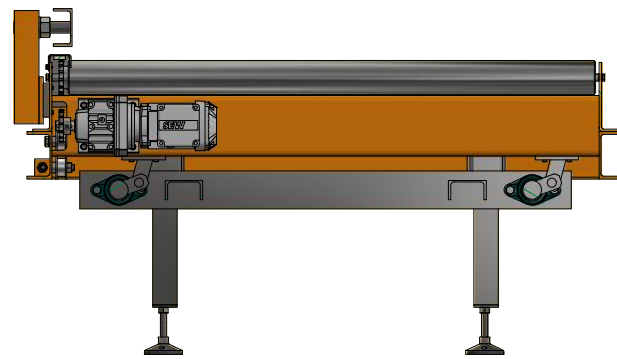


SECTION P-P  
SCALE 1:20

DRAWN BY ULTIMATE ENGINEERING PTY LTD Ph 8562 1511



THESE DRAWINGS ARE THE PROPERTY OF ULTIMATE ENGINEERING AND SHOULD NOT BE REPRODUCED OR COPIED IN ANY WAY WITHOUT WRITTEN PERMISSION FROM ULTIMATE ENGINEERING

PAINT TREATMENT:

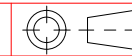

DIMENSION TOLERANCES	
DECIMAL	ANGULAR
X.X = ± .5 mm	X = ± 1'
X.XX = ± .25 mm	X.X = ± .5'
X.XXX = ± .125 mm	X.XX = ± .25'

MAXIMUM FINISHED SURFACE ROUGHNESS U.N.O. 1.6

PARENT ASSEMBLY

CUSTOMER:

**RAB ENGINEERING**

DRAWN: David Bilney

TITLE:

A1948-004-01  
CHAIN CONVEYORS

DESIGNED: David Bilney

DWG NO:

**194804**

DATE: 22/03/2021

JOB NO:

SCALE:  
Noted


SHEET  
3 OF 48

SHEET SIZE:  
A3


REV:  
2




DO NOT SCALE DRAWING

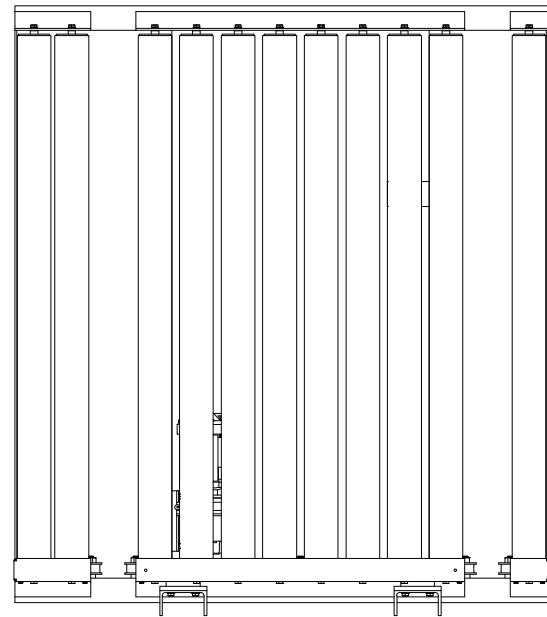


PLAN VIEW  
SCALE 1:20

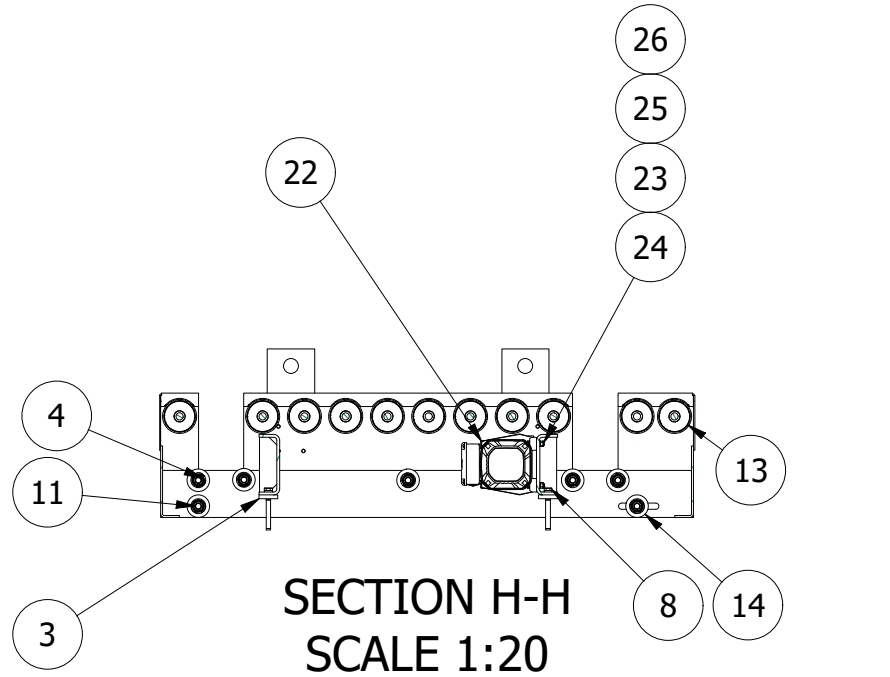


SECTION H-H  
SCALE 1:20

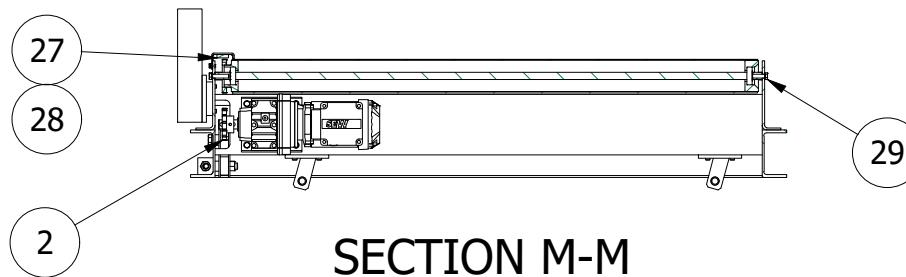


SECTION M-M  
SCALE 1:20

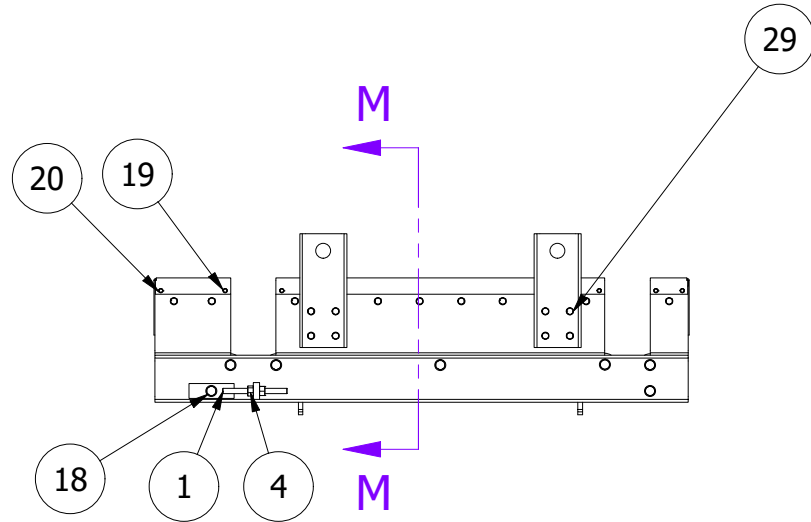

END VIEW  
SCALE 1:20

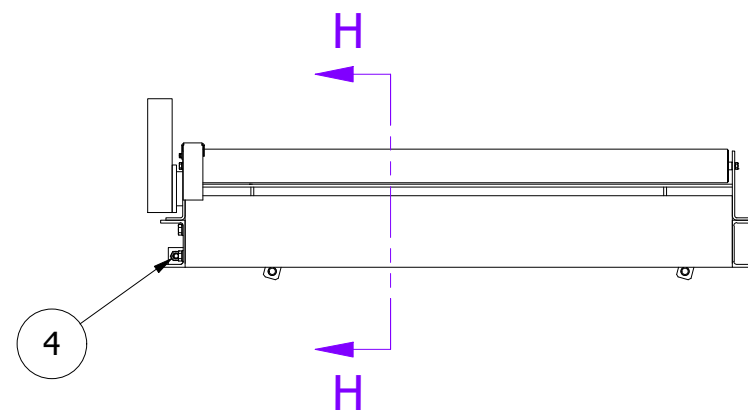

SIDE VIEW  
SCALE 1:20

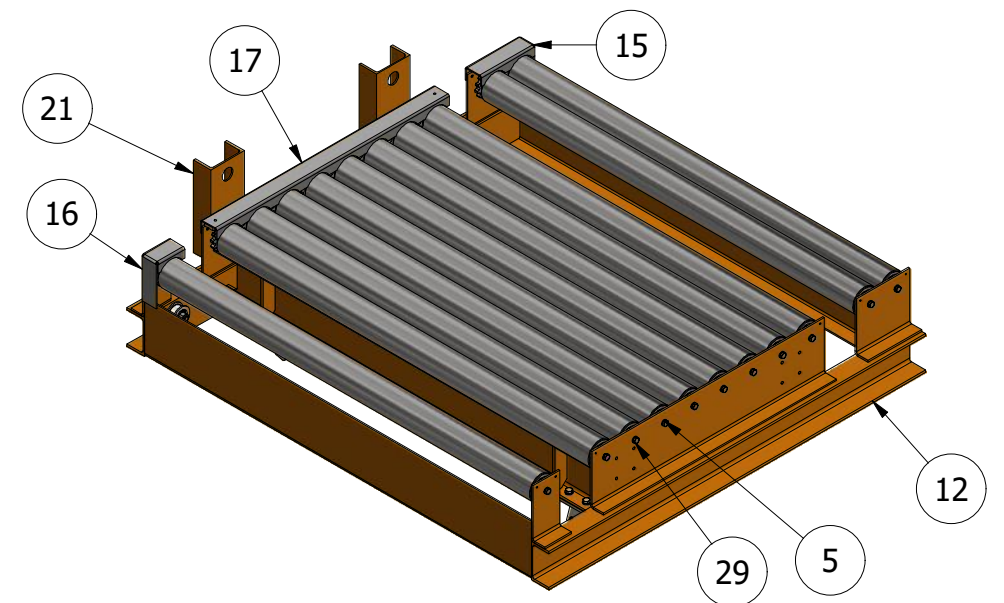

ISO VIEW  
SCALE 1:20

30	P1948-008-01	Steel, Mild	194811	2
29	AS 1110 - M10 x 45	Steel, Mild		31
28	M8x12	Steel, Mild	SOCKET HEAD C/SUNK SCREW	2
27	P1948-004-12	HDPE	SHEET 48	1
26	AS 1112 - M8	Steel, Mild	HEX NUT	4
25	AS 1968 - 1976 - 8	Steel, Mild	SPRING WASHER	4
24	AS 1110 - M8 x 40	Steel, Mild	HEX HEAD BOLT	4
23	AS 1237 - 8 mm	Steel, Mild	FLAT WASHER	4
22	R37_DRN80MK4	SEW	MOTOR & GEARDRIVE 44RPM	1
21	W1948-004-02	Weldment	SHEET 17	2
20	AS 1110 - M6 x 12	Steel, Mild	HEX HEAD BOLT	6
19	AS 1968 - 1976 - 6	Steel, Mild	SPRING WASHER	6
18	AS 1111 - M16 x 80	Steel, Mild	HEX HEAD BOLT	1
17	P1948-004-09	Steel, Mild	SHEET 46	1
16	P1948-004-08	Steel, Mild	SHEET 45	1
15	P1948-004-07	Steel, Mild	SHEET 44	1
14	A1948-004-03	Assembly	SHEET 5	7
13	A1948-005-01	Assembly	194800	11
12	W1948-004-01	Weldment	SHEET 16	1
11	AS 1110 - M16 x 65	Steel, Mild	HEX HEAD BOLT	6
10	AS 1968 - 1976 - 16	Steel, Mild	SPRING WASHER	7
9	AS 1237 - 16 mm	Steel, Mild	FLAT WASHER	14
8	AS 1110 - M12 x 25	Steel, Mild	HEX HEAD BOLT	8
7	AS 1968 - 1976 - 12	Steel, Mild	SPRING WASHER	8
5	AS 1968 - 1976 - 10	Steel, Mild	SPRING WASHER	31
4	AS 1112 - M16	Steel, Mild	HEX NUT	9
3	W1948-001-06	Weldment	SHEET 11	4
2	14T DRIVE SPROCKET	FENNER 12B1-14	SUIT 25MM SHAFT	1
1	W1948-001-10		SHEET 15	1
ITEM	PART NUMBER	MATERIAL	COMMENTS	ITEM QTY


A1948-004-02 - 1 REQ'D AS DRAWN

DRAWN BY ULTIMATE ENGINEERING PTY LTD Ph 8562 1511



THESE DRAWINGS ARE THE PROPERTY OF ULTIMATE ENGINEERING AND SHOULD NOT BE REPRODUCED OR COPIED IN ANY WAY WITHOUT WRITTEN PERMISSION FROM ULTIMATE ENGINEERING

PAINT TREATMENT:

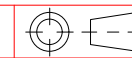

DIMENSION TOLERANCES	
DECIMAL	ANGULAR
X.X = ± .5 mm	X = ± 1°
X.XX = ± .25 mm	X.X = ± .5°
X.XXX = ± .125 mm	X.XX = ± .25°

MAXIMUM FINISHED SURFACE ROUGHNESS U.N.O. 1.6

PARENT ASSEMBLY

DRAWN: David Bilney

DESIGNED: David Bilney

DATE: 22/03/2021

CUSTOMER:

RAB ENGINEERING

TITLE:

A1948-004-02  
CHAIN CONVEYORS

DWG NO:

194804

JOB NO:


SCALE: Noted

SHEET 4 OF 48


SHEET SIZE: A3

REV: 2


DO NOT SCALE DRAWING

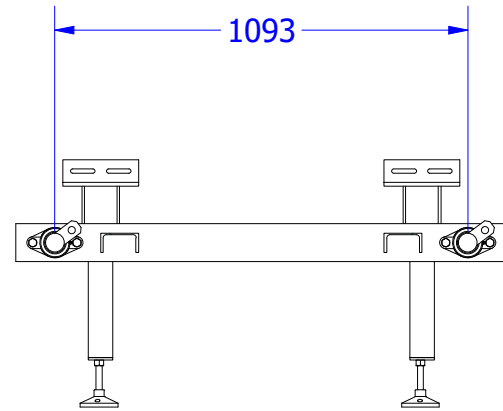


SECTION G-G  
SCALE 1:20

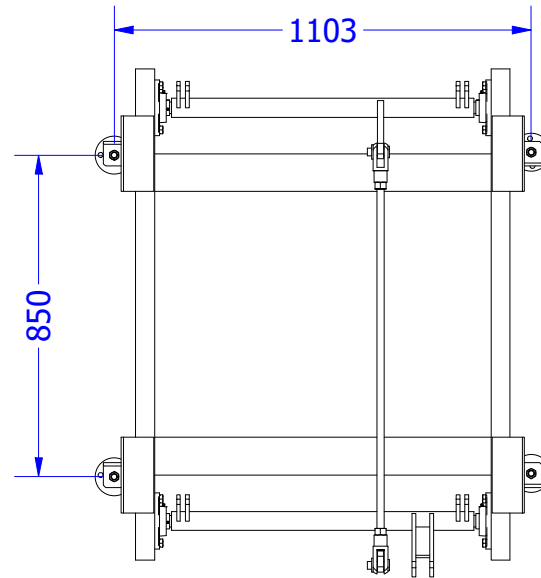

PLAN VIEW  
SCALE 1:20

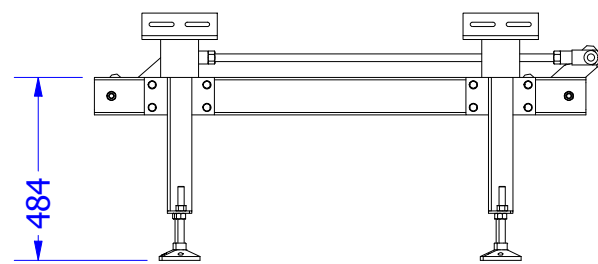


SIDE VIEW  
SCALE 1:20

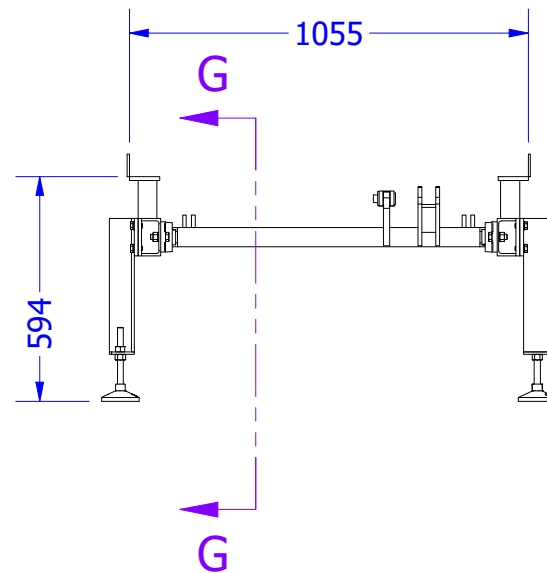

END VIEW  
SCALE 1:20

13	LVR10016140B	Adjustable Foot	Richmond Castors	4
12	AS 1112 - M14	Steel, Mild	HEX NUT	8
11	AS 1968 - 1976 - 14	Steel, Mild	SPRING WASHER	8
10	M14 x 40	Steel, Mild	HEX HEAD BOLT	8
9	AS 1110 - M12 x 25	Steel, Mild	HEX HEAD BOLT	16
8	AS 1968 - 1976 - 12	Steel, Mild	SPRING WASHER	16
7	AS 1112 - M16	Steel, Mild	HEX NUT	4
6	W1948-001-09	Weldment	SHEET 14	1
5	W1948-001-08	Weldment	SHEET 13	1
4	W1948-001-07	Weldment	SHEET 12	1
3	24215-30206	LDK-FL206 UC206D1	BSC: FL206 PILLOW BLOCK	4
2	W1948-001-05	Weldment	SHEET 10	4
1	W1948-001-04	Weldment	SHEET 9	1
ITEM	PART NUMBER	MATERIAL	COMMENTS	ITEM QTY

A1948-001-01 - 1 REQ'D AS DRAWN

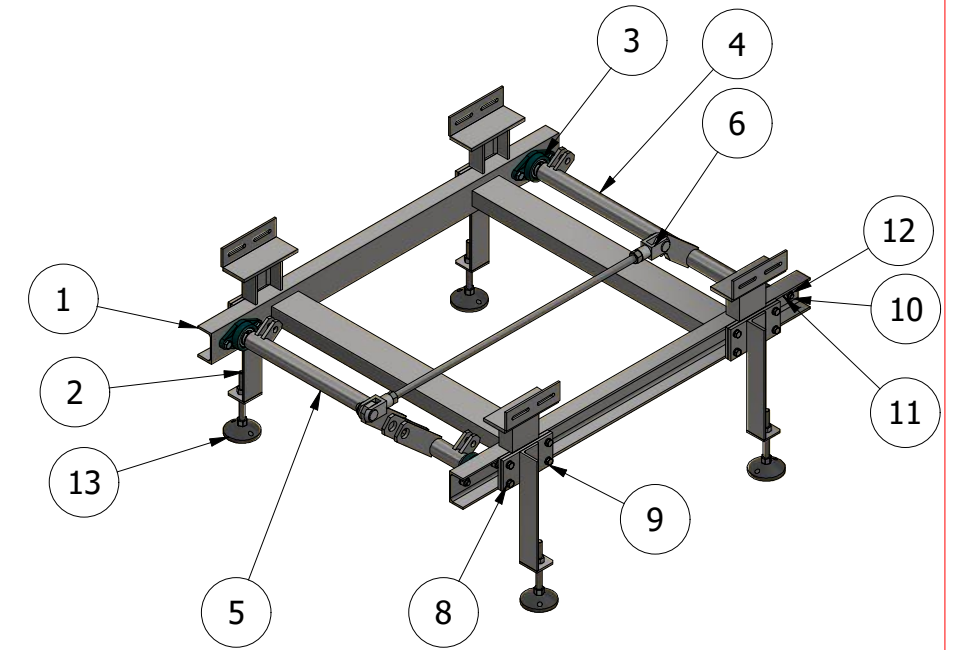


ISO VIEW  
SCALE 1:20

DRAWN BY ULTIMATE ENGINEERING PTY LTD Ph 8562 1511



THESE DRAWINGS ARE THE PROPERTY OF ULTIMATE ENGINEERING AND SHOULD NOT BE REPRODUCED OR COPIED IN ANY WAY WITHOUT WRITTEN PERMISSION FROM ULTIMATE ENGINEERING

PAINT TREATMENT:

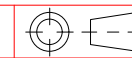

DIMENSION TOLERANCES  
DECIMAL ANGULAR  
X.X = ± .5 mm X = ± 1°  
X.XX = ± .25 mm X.X = ± .5°  
X.XXX = ± .125 mm X.XX = ± .25°  
MAXIMUM FINISHED SURFACE ROUGHNESS U.N.O. 1.6

PARENT ASSEMBLY

CUSTOMER:

RAB ENGINEERING

DRAWN: David Bilney

TITLE:

A1948-001-01  
CHAIN CONVEYORS

DESIGNED: David Bilney

DWG NO:

194804

DATE: 22/03/2021

JOB NO:

SCALE: Noted

SHEET 5 OF 48


SHEET SIZE: A3

REV: 2

DO NOT SCALE DRAWING


4	DIN 472 - 40 x 1.75	Steel, Mild		1
3	SKF 2RS16203-2RS1	Steel, Mild		1
2	P1948-004-06	Steel, Mild	SHEET 43	1
1	P1948-004-05	Steel, Mild	SHEET 42	1
ITEM	PART NUMBER	MATERIAL	COMMENTS	ITEM QTY

A1948-004-03 - 7 REQ'D AS DRAWN

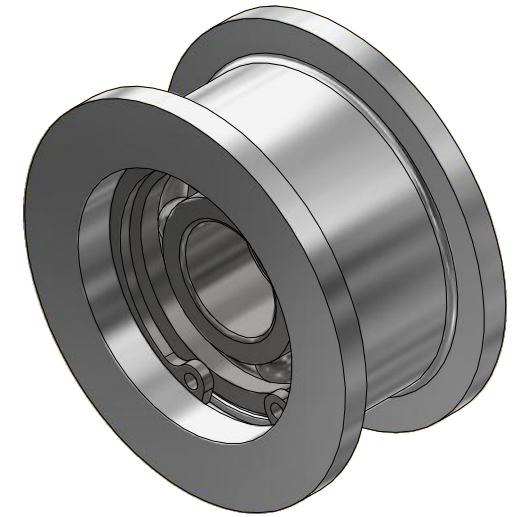


ISO VIEW  
SCALE 1 : 1


HELD IN PLACE  
BY BOLT ON ASSEMBLY

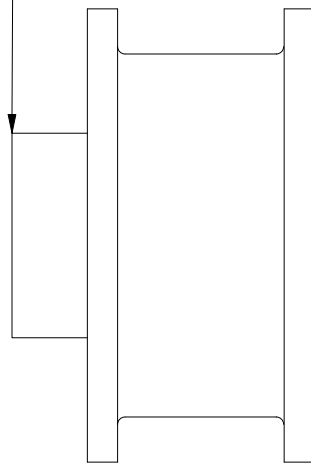

SIDE VIEW  
SCALE 1 : 1

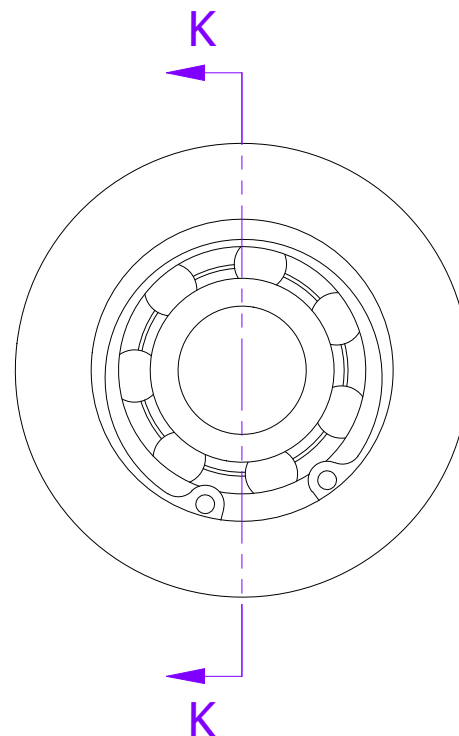

FRONT VIEW  
SCALE 1 : 1

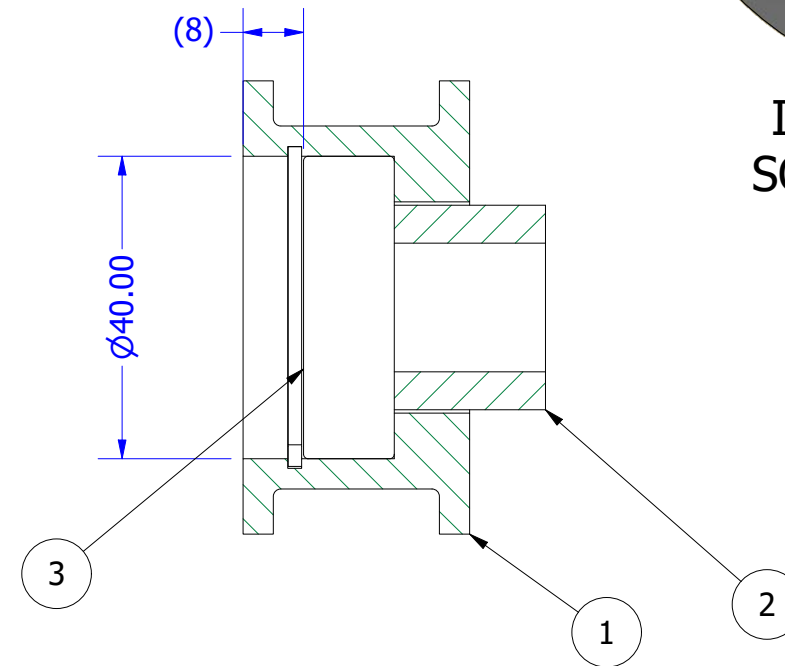


SECTION K-K  
SCALE 1 : 1

DRAWN BY ULTIMATE ENGINEERING PTY LTD Ph 8562 1511



THESE DRAWINGS ARE THE PROPERTY OF ULTIMATE ENGINEERING AND SHOULD NOT BE REPRODUCED OR COPIED IN ANY WAY WITHOUT WRITTEN PERMISSION FROM ULTIMATE ENGINEERING

PAINT TREATMENT:

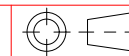

DIMENSION TOLERANCES	
DECIMAL	ANGULAR
X.X = ± .5 mm	X = ± 1°
X.XX = ± .25 mm	X.X = ± .5°
X.XXX = ± .125 mm	X.XX = ± .25°
MAXIMUM FINISHED SURFACE ROUGHNESS U.N.O. 1.6	

PARENT ASSEMBLY

CUSTOMER:

RAB ENGINEERING

DRAWN: David Bilney

TITLE:

A1948-004-03  
CHAIN CONVEYORS

DESIGNED: David Bilney

DWG NO:

194804

DATE: 22/03/2021

JOB NO:

SCALE:  
Noted






SHEET  
6 OF 48

SHEET SIZE:  
A3

REV:  
2



DO NOT SCALE DRAWING

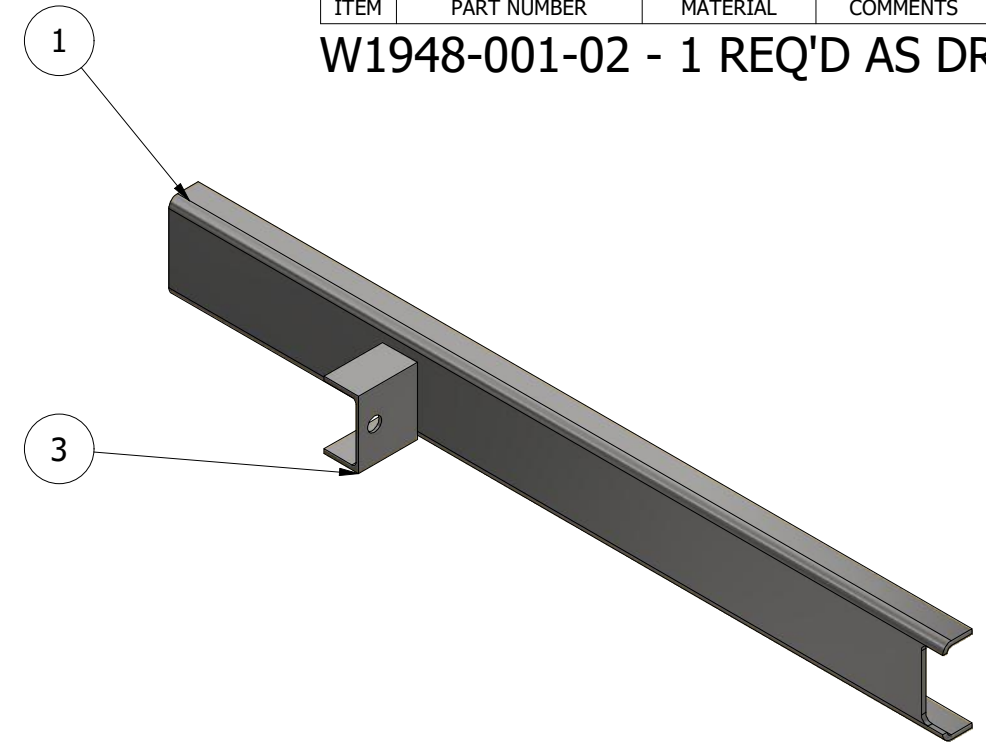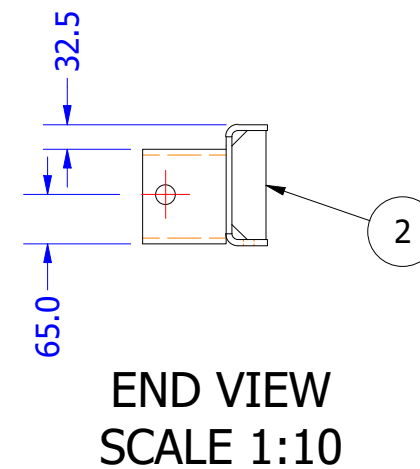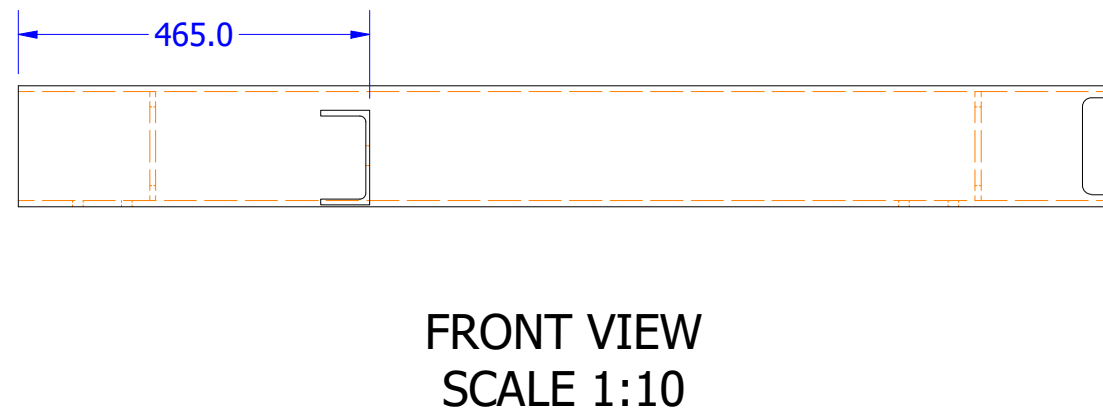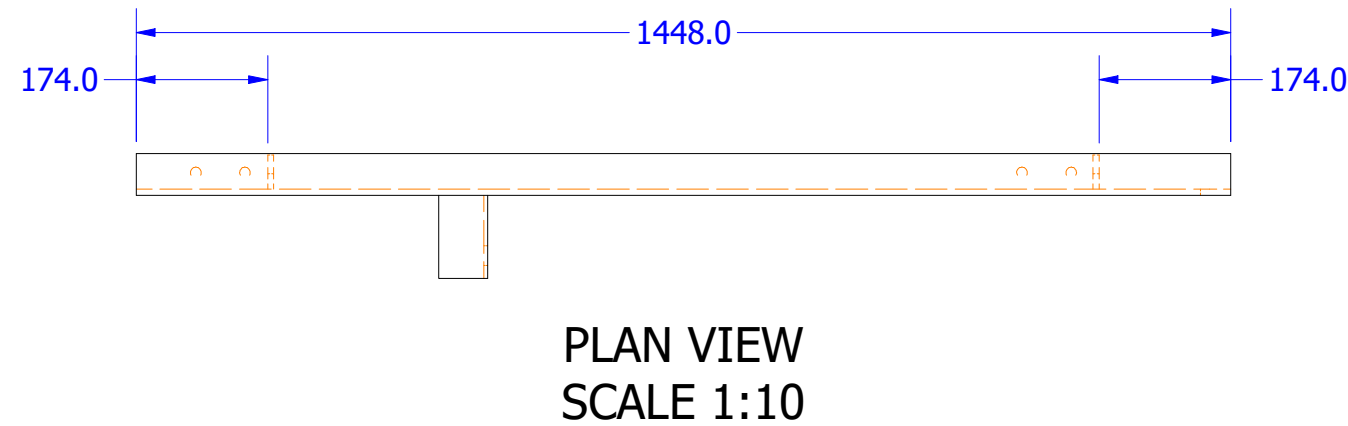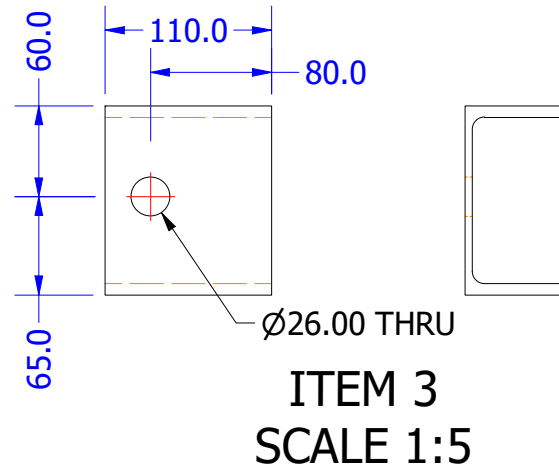

3	125PFC @ 110	Steel, Mild		1
2	P1948-001-06	Steel, Mild	SHEET 24	2
1	P1948-001-04	Steel, Mild	SHEET 22	1
ITEM	PART NUMBER	MATERIAL	COMMENTS	ITEM QTY

W1948-001-02 - 1 REQ'D AS DRAWN


- NOTES:
1. ALL WELDING TO CONFORM TO AS1554-GP UNO
  2. ALL FILLET WELDS TO BE 6mm CONTINUOUS UNO
  3. ALL BUTT WELDS SHALL BE FULL STRENGTH, COMPLETE PENETRATION WELDS
  4. ALL FLAME CUT SURFACES SHALL BE UNIFORM & CLEAN BEFORE WELDING
  5. REMOVE ALL BURRS & SHARP EDGES
  6. NON DESTRUCTIVE TESTING:
    - A) ALL WELDS, 100% VISUAL SCAN TO AS1554 PART 1
  7. FINISH:
    - A) ALL STEELWORK TO BE PRIMED OR COLD GALV UNO

DRAWN BY ULTIMATE ENGINEERING PTY LTD Ph 8562 1511



THESE DRAWINGS ARE THE PROPERTY OF ULTIMATE ENGINEERING AND SHOULD NOT BE REPRODUCED OR COPIED IN ANY WAY WITHOUT WRITTEN PERMISSION FROM ULTIMATE ENGINEERING

PAINT TREATMENT:

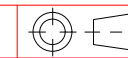

DIMENSION TOLERANCES	
DECIMAL	ANGULAR
X.X = ± .5 mm	X = ± 1'
X.XX = ± .25 mm	X.X = ± .5'
X.XXX = ± .125 mm	X.XX = ± .25'

MAXIMUM FINISHED SURFACE ROUGHNESS U.N.O. 1.6

PARENT ASSEMBLY

CUSTOMER: **RAB ENGINEERING**

DRAWN: David Bilney

TITLE: W1948-001-02  
CHAIN CONVEYORS

DESIGNED: David Bilney

DWG NO: **194804**

DATE: 22/03/2021

JOB NO:

SCALE: Noted

SHEET 7 OF 48

SHEET SIZE: A3

REV: 2

DO NOT SCALE DRAWING

2	P1948-001-06	Steel, Mild	SHEET 24	2
1	P1948-001-05	Steel, Mild	SHEET 23	1
ITEM	PART NUMBER	MATERIAL	COMMENTS	ITEM QTY

W1948-001-03 - 1 REQ'D AS DRAWN




PLAN VIEW  
SCALE 1:10



ISO VIEW  
SCALE 1:10



FRONT VIEW  
SCALE 1:10

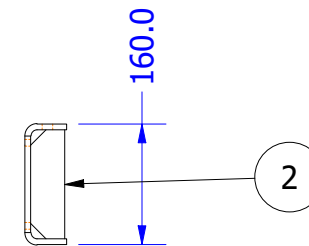

END VIEW  
SCALE 1:10

NOTES:


1. ALL WELDING TO CONFORM TO AS1554-GP UNO
2. ALL FILLET WELDS TO BE 6mm CONTINUOUS UNO
3. ALL BUTT WELDS SHALL BE FULL STRENGTH, COMPLETE PENETRATION WELDS
4. ALL FLAME CUT SURFACES SHALL BE UNIFORM & CLEAN BEFORE WELDING
5. REMOVE ALL BURRS & SHARP EDGES
6. NON DESTRUCTIVE TESTING:
  - A) ALL WELDS, 100% VISUAL SCAN TO AS1554 PART 1
7. FINISH:
  - A) ALL STEELWORK TO BE PRIMED OR COLD GALV UNO

DRAWN BY ULTIMATE ENGINEERING PTY LTD Ph 8562 1511



THESE DRAWINGS ARE THE PROPERTY OF ULTIMATE ENGINEERING AND SHOULD NOT BE REPRODUCED OR COPIED IN ANY WAY WITHOUT WRITTEN PERMISSION FROM ULTIMATE ENGINEERING

PAINT TREATMENT:

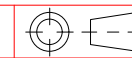

DIMENSION TOLERANCES	
DECIMAL	ANGULAR
X.X = ± .5 mm	X = ± 1°
X.XX = ± .25 mm	X.X = ± .5°
X.XXX = ± .125 mm	X.XX = ± .25°

MAXIMUM FINISHED SURFACE ROUGHNESS U.N.O. 1.6

PARENT ASSEMBLY

CUSTOMER:

**RAB ENGINEERING**

DRAWN: David Bilney

TITLE:

W1948-001-03  
CHAIN CONVEYORS

DESIGNED: David Bilney

DWG NO:

**194804**

DATE: 22/03/2021

JOB NO:

SCALE:  
Noted

SHEET  
8 OF 48


SHEET SIZE:  
A3

REV:  
2


DO NOT SCALE DRAWING

6	P1948-001-28	Steel, Mild	SHEET 38	4
5	P1948-001-08	Steel, Mild	SHEET 26	4
4	P1948-001-07	Steel, Mild	SHEET 25	4
3	100PFC @ 100	Steel, Mild		4
2	100PFC @ 890	Steel, Mild		2
1	100PFC @ 1300	Steel, Mild		2
ITEM	PART NUMBER	MATERIAL	COMMENTS	ITEM QTY


W1948-001-04 - 1 REQ'D AS DRAWN

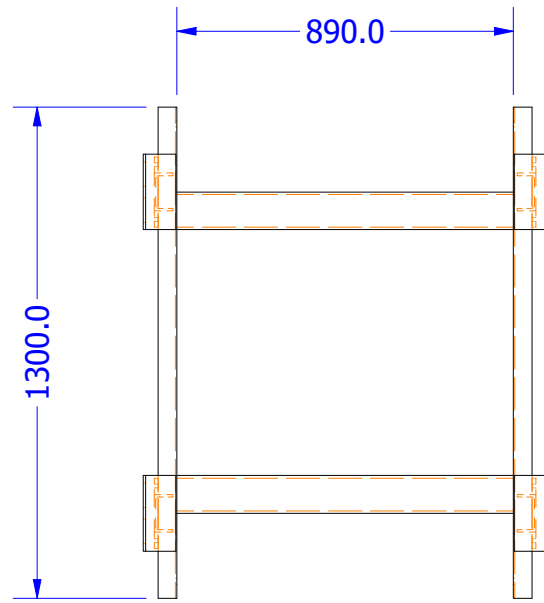


PLAN VIEW  
SCALE 1:20

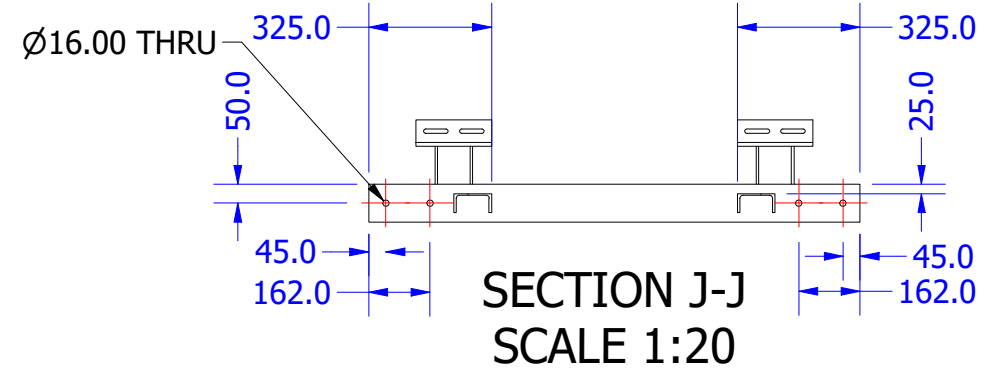


SECTION J-J  
SCALE 1:20

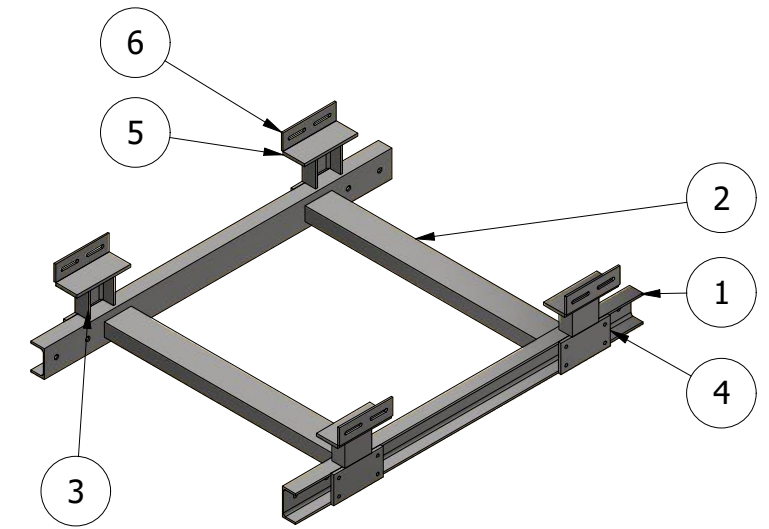

ISO VIEW  
SCALE 1:20

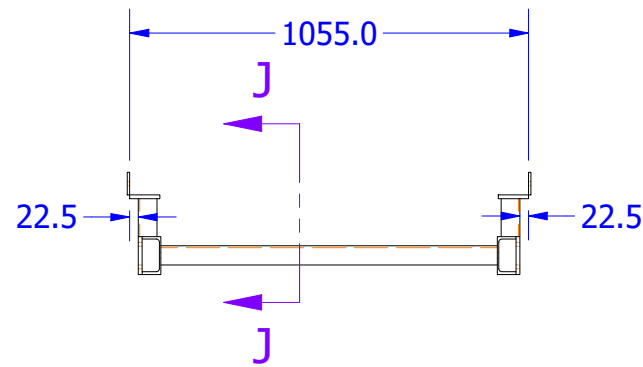

FRONT VIEW  
SCALE 1:20

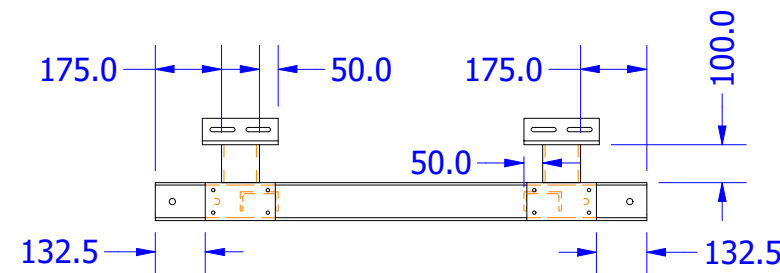


SIDE VIEW  
SCALE 1:20

- NOTES:
- ALL WELDING TO CONFORM TO AS1554-GP UNO
  - ALL FILLET WELDS TO BE 6mm CONTINUOUS UNO
  - ALL BUTT WELDS SHALL BE FULL STRENGTH, COMPLETE PENETRATION WELDS
  - ALL FLAME CUT SURFACES SHALL BE UNIFORM & CLEAN BEFORE WELDING
  - REMOVE ALL BURRS & SHARP EDGES
  - NON DESTRUCTIVE TESTING:
    - A) ALL WELDS, 100% VISUAL SCAN TO AS1554 PART 1
  - FINISH:
    - A) ALL STEELWORK TO BE PRIMED OR COLD GALV UNO



THESE DRAWINGS ARE THE PROPERTY OF ULTIMATE ENGINEERING AND SHOULD NOT BE REPRODUCED OR COPIED IN ANY WAY WITHOUT WRITTEN PERMISSION FROM ULTIMATE ENGINEERING

PAINT TREATMENT: TBA

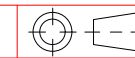


DIMENSION TOLERANCES	
DECIMAL	ANGULAR
X.X = ± .5 mm	X = ± 1°
X.XX = ± .25 mm	X.X = ± .5°
X.XXX = ± .125 mm	X.XX = ± .25°
MAXIMUM FINISHED SURFACE ROUGHNESS U.N.O. 1.6	

PARENT ASSEMBLY	CUSTOMER: <b>RAB ENGINEERING</b>
DRAWN: David Bilney	TITLE: W1948-001-04 CHAIN CONVEYORS
DESIGNED: David Bilney	DWG NO: <b>194804</b>
DATE: 22/03/2021	JOB NO:
SCALE: Noted	SHEET: 9 OF 48
SHEET SIZE: A3	REV: 2


DO NOT SCALE DRAWING

4	AS 1112 - M16	Steel, Mild	HEX NUT	1
3	P1948-000-08	Steel, Mild	SHEET 18	1
2	65x8 EA @ 354	Steel, Mild		1
1	P1948-001-09	Steel, Mild	SHEET 27	1
ITEM	PART NUMBER	MATERIAL	COMMENTS	ITEM QTY


W1948-001-05 - 4 REQ'D AS DRAWN

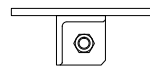


PLAN VIEW  
SCALE 1:10

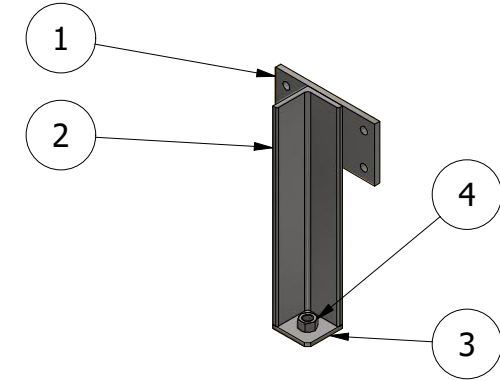

ISO VIEW  
SCALE 1:10

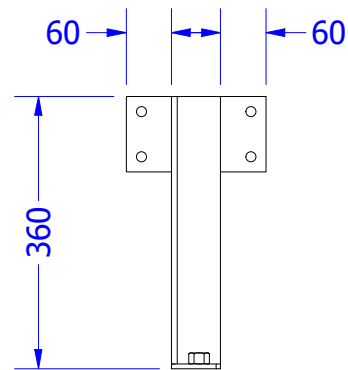

FRONT VIEW  
SCALE 1:10

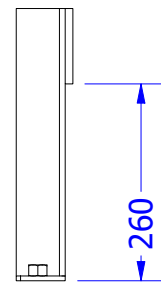

SIDE VIEW  
SCALE 1:10

NOTES:


1. ALL WELDING TO CONFORM TO AS1554-GP UNO
2. ALL FILLET WELDS TO BE 6mm CONTINUOUS UNO
3. ALL BUTT WELDS SHALL BE FULL STRENGTH, COMPLETE PENETRATION WELDS
4. ALL FLAME CUT SURFACES SHALL BE UNIFORM & CLEAN BEFORE WELDING
5. REMOVE ALL BURRS & SHARP EDGES
6. NON DESTRUCTIVE TESTING:
  - A) ALL WELDS, 100% VISUAL SCAN TO AS1554 PART 1
7. FINISH:
  - A) ALL STEELWORK TO BE PRIMED OR COLD GALV UNO

DRAWN BY ULTIMATE ENGINEERING PTY LTD Ph 8562 1511



THESE DRAWINGS ARE THE PROPERTY OF ULTIMATE ENGINEERING AND SHOULD NOT BE REPRODUCED OR COPIED IN ANY WAY WITHOUT WRITTEN PERMISSION FROM ULTIMATE ENGINEERING

PAINT TREATMENT: TBA

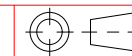


DIMENSION TOLERANCES	
DECIMAL	ANGULAR
X.X = ± .5 mm	X = ± 1°
X.XX = ± .25 mm	X.X = ± .5°
X.XXX = ± .125 mm	X.XX = ± .25°
MAXIMUM FINISHED SURFACE ROUGHNESS U.N.O. 1.6	

PARENT ASSEMBLY	CUSTOMER: <b>RAB ENGINEERING</b>
DRAWN: David Bilney	TITLE: W1948-001-05 CHAIN CONVEYORS
DESIGNED: David Bilney	DWG NO: <b>194804</b>
DATE: 22/03/2021	JOB NO:
SCALE: Noted	SHEET: 10 OF 48
SHEET SIZE: A3	REV: 2


DO NOT SCALE DRAWING

3	FB406	Bronze, Cast	FRASER BRONZE BEARINGS	1
2	P1948-001-11	Steel, Mild	SHEET 29	1
1	P1948-001-10	Steel, Mild	SHEET 28	1
ITEM	PART NUMBER	MATERIAL	COMMENTS	ITEM QTY


W1948-001-06 - 4 REQ'D AS DRAWN

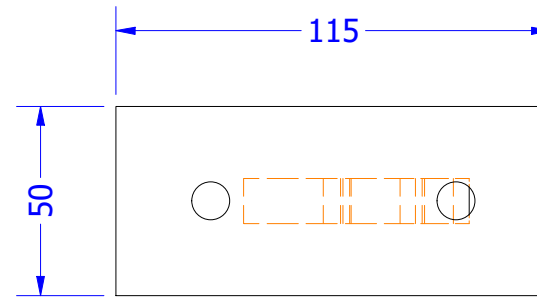


PLAN VIEW  
SCALE 1:2

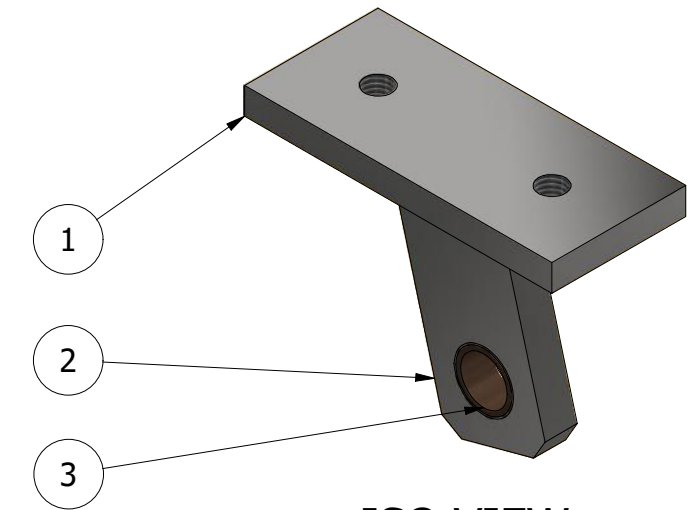

ISO VIEW  
SCALE 1:2

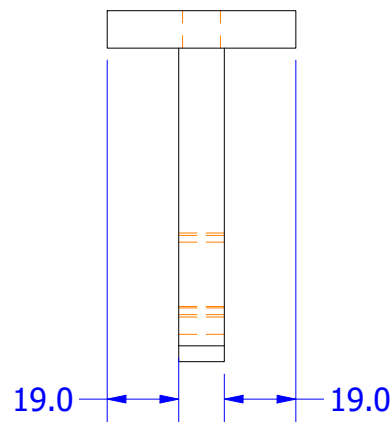

END VIEW  
SCALE 1:2

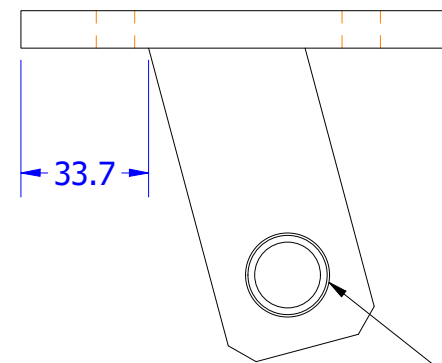

SIDE VIEW  
SCALE 1:2

DRILL OUT TO SUIT BUSH

NOTES:

1. ALL WELDING TO CONFORM TO AS1554-GP UNO
2. ALL FILLET WELDS TO BE 6mm CONTINUOUS UNO
3. ALL BUTT WELDS SHALL BE FULL STRENGTH, COMPLETE PENETRATION WELDS
4. ALL FLAME CUT SURFACES SHALL BE UNIFORM & CLEAN BEFORE WELDING
5. REMOVE ALL BURRS & SHARP EDGES
6. NON DESTRUCTIVE TESTING:
  - A) ALL WELDS, 100% VISUAL SCAN TO AS1554 PART 1
7. FINISH:
  - A) ALL STEELWORK TO BE PRIMED OR COLD GALV UNO

DRAWN BY ULTIMATE ENGINEERING PTY LTD Ph 8562 1511



THESE DRAWINGS ARE THE PROPERTY OF ULTIMATE ENGINEERING AND SHOULD NOT BE REPRODUCED OR COPIED IN ANY WAY WITHOUT WRITTEN PERMISSION FROM ULTIMATE ENGINEERING

PAINT TREATMENT: TBA



DIMENSION TOLERANCES	
DECIMAL	ANGULAR
X.X = ± .5 mm	X = ± 1°
X.XX = ± .25 mm	X.X = ± .5°
X.XXX = ± .125 mm	X.XX = ± .25°


MAXIMUM FINISHED SURFACE ROUGHNESS U.N.O. 1.6

PARENT ASSEMBLY	CUSTOMER: <b>RAB ENGINEERING</b>
DRAWN: David Bilney	TITLE: W1948-001-06 CHAIN CONVEYORS
DESIGNED: David Bilney	DWG NO: <b>194804</b>
DATE: 22/03/2021	JOB NO:
SCALE: Noted	SHEET: 11 OF 48
	SHEET SIZE: A3
	REV: 2


DO NOT SCALE DRAWING

4	MB 2015 DU		GLACIER BEARING	1
3	P1948-001-16	Steel, Mild	SHEET 34	1
2	P1948-001-13	Steel, Mild	SHEET 31	4
1	P1948-001-12	Steel, Mild	SHEET 30	1
ITEM	PART NUMBER	MATERIAL	COMMENTS	ITEM QTY


W1948-001-07 - 1 REQ'D AS DRAWN

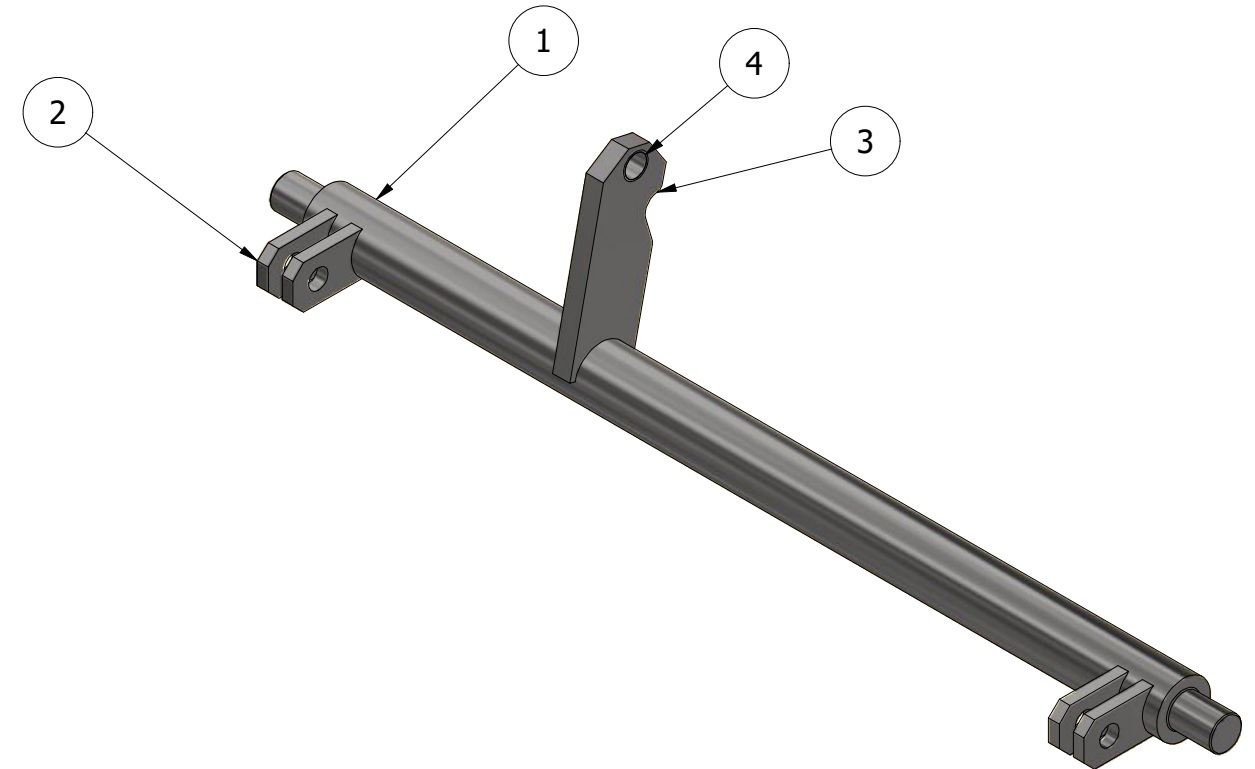

ISO VIEW  
SCALE 1:5

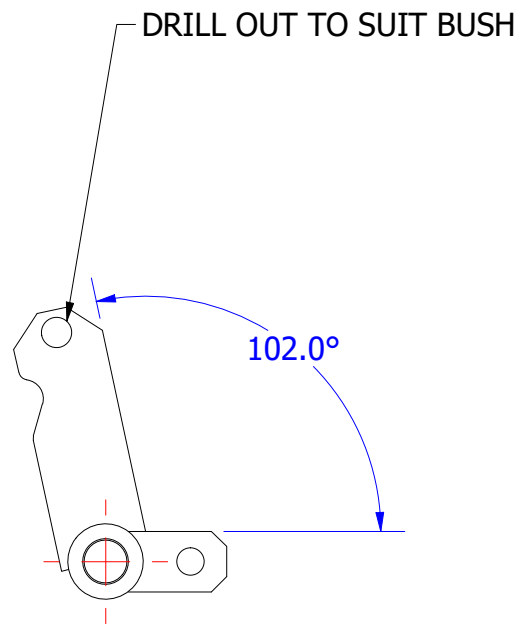

SIDE VIEW  
SCALE 1:5

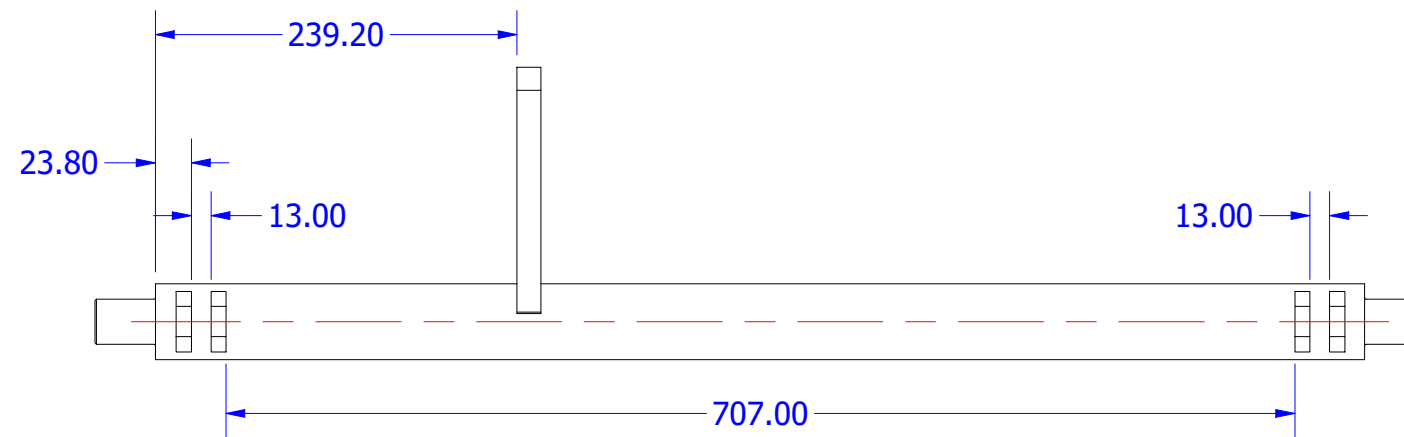

FRONT VIEW  
SCALE 1:5

NOTES:


- ALL WELDING TO CONFORM TO AS1554-GP UNO
- ALL FILLET WELDS TO BE 6mm CONTINUOUS UNO
- ALL BUTT WELDS SHALL BE FULL STRENGTH, COMPLETE PENETRATION WELDS
- ALL FLAME CUT SURFACES SHALL BE UNIFORM & CLEAN BEFORE WELDING
- REMOVE ALL BURRS & SHARP EDGES
- NON DESTRUCTIVE TESTING:
  - A) ALL WELDS, 100% VISUAL SCAN TO AS1554 PART 1
- FINISH:
  - A) ALL STEELWORK TO BE PRIMED OR COLD GALV UNO

DRAWN BY ULTIMATE ENGINEERING PTY LTD Ph 8562 1511



THESE DRAWINGS ARE THE PROPERTY OF ULTIMATE ENGINEERING AND SHOULD NOT BE REPRODUCED OR COPIED IN ANY WAY WITHOUT WRITTEN PERMISSION FROM ULTIMATE ENGINEERING

PAINT TREATMENT: TBA

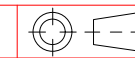

DIMENSION TOLERANCES	
DECIMAL	ANGULAR
X.X = ± .5 mm	X = ± 1°
X.XX = ± .25 mm	X.X = ± .5°
X.XXX = ± .125 mm	X.XX = ± .25°

MAXIMUM FINISHED SURFACE ROUGHNESS U.N.O. 1.6

PARENT ASSEMBLY

CUSTOMER:

**RAB ENGINEERING**

DRAWN: David Bilney

TITLE:

W1948-001-07  
CHAIN CONVEYORS

DESIGNED: David Bilney

DWG NO:

**194804**

DATE: 22/03/2021

JOB NO:

SCALE:  
Noted

SHEET  
12 OF 48

SHEET SIZE:  
A3


REV:  
2




DO NOT SCALE DRAWING

6	MB 2015 DU		GLACIER BUSH	1
5	P1948-001-16	Steel, Mild	SHEET 34	1
4	P1948-001-15	Steel, Mild	SHEET 33	1
3	P1948-001-14	Steel, Mild	SHEET 32	2
2	P1948-001-13	Steel, Mild	SHEET 31	4
1	P1948-001-12	Steel, Mild	SHEET 30	1
ITEM	PART NUMBER	MATERIAL	COMMENTS	ITEM QTY


W1948-001-08 - 1 REQ'D AS DRAWN

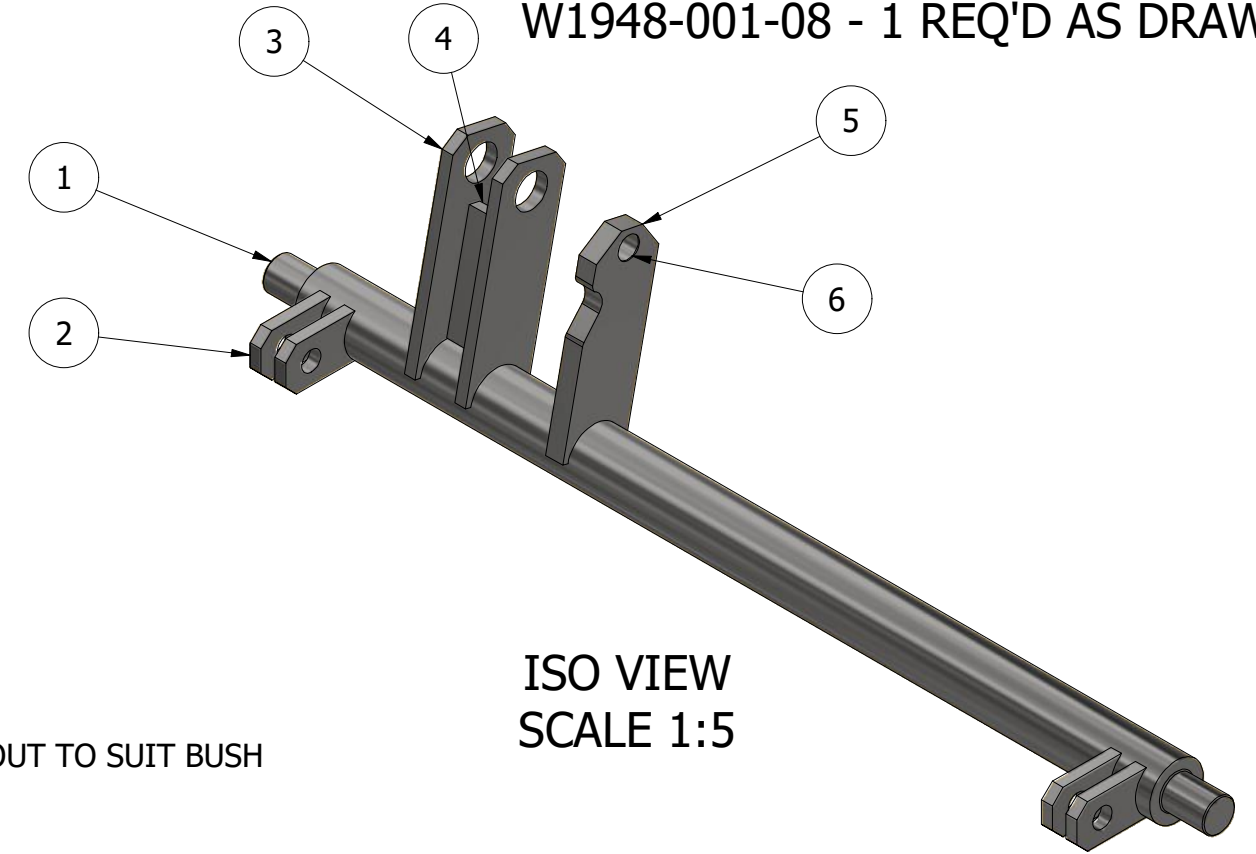

ISO VIEW  
SCALE 1:5

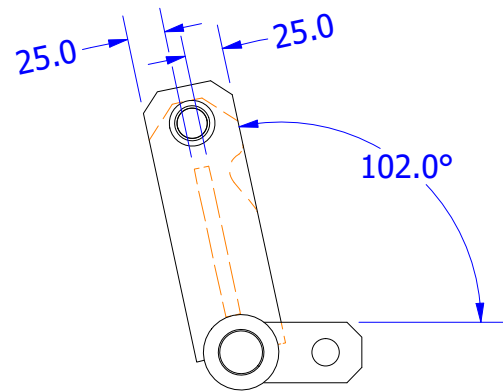

SIDE VIEW  
SCALE 1:5

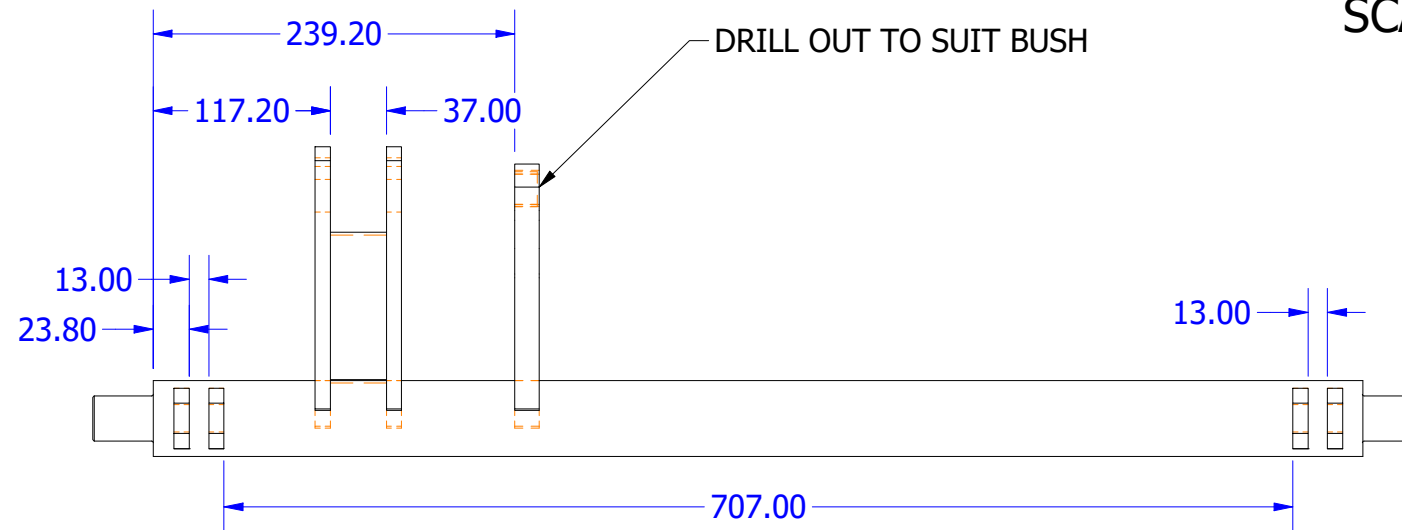

FRONT VIEW  
SCALE 1:5


- NOTES:
- ALL WELDING TO CONFORM TO AS1554-GP UNO
  - ALL FILLET WELDS TO BE 6mm CONTINUOUS UNO
  - ALL BUTT WELDS SHALL BE FULL STRENGTH, COMPLETE PENETRATION WELDS
  - ALL FLAME CUT SURFACES SHALL BE UNIFORM & CLEAN BEFORE WELDING
  - REMOVE ALL BURRS & SHARP EDGES
  - NON DESTRUCTIVE TESTING:
    - A) ALL WELDS, 100% VISUAL SCAN TO AS1554 PART 1
  - FINISH:
    - A) ALL STEELWORK TO BE PRIMED OR COLD GALV UNO

DRAWN BY ULTIMATE ENGINEERING PTY LTD Ph 8562 1511



THESE DRAWINGS ARE THE PROPERTY OF ULTIMATE ENGINEERING AND SHOULD NOT BE REPRODUCED OR COPIED IN ANY WAY WITHOUT WRITTEN PERMISSION FROM ULTIMATE ENGINEERING

PAINT TREATMENT: TBA

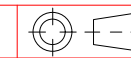


DIMENSION TOLERANCES	
DECIMAL	ANGULAR
X.X = ± .5 mm	X = ± 1°
X.XX = ± .25 mm	X.X = ± .5°
X.XXX = ± .125 mm	X.XX = ± .25°
MAXIMUM FINISHED SURFACE ROUGHNESS U.N.O. 1.6	

PARENT ASSEMBLY	CUSTOMER: <b>RAB ENGINEERING</b>
DRAWN: David Bilney	TITLE: W1948-001-08 CHAIN CONVEYORS
DESIGNED: David Bilney	DWG NO: <b>194804</b>
DATE: 22/03/2021	JOB NO:
SCALE: Noted	SHEET: 13 OF 48
SHEET SIZE: A3	REV: 2


DO NOT SCALE DRAWING

3	AS 1112 - M20 FINE	Steel, Mild	HEX NUT	2
2	P1948-001-17	Steel, Mild	SHEET 35	1
1	GKM20-40	Steel, Mild	SMC ROD CLEVIS	2
ITEM	PART NUMBER	MATERIAL	COMMENTS	ITEM QTY

W1948-001-09 - 1 REQ'D AS DRAWN

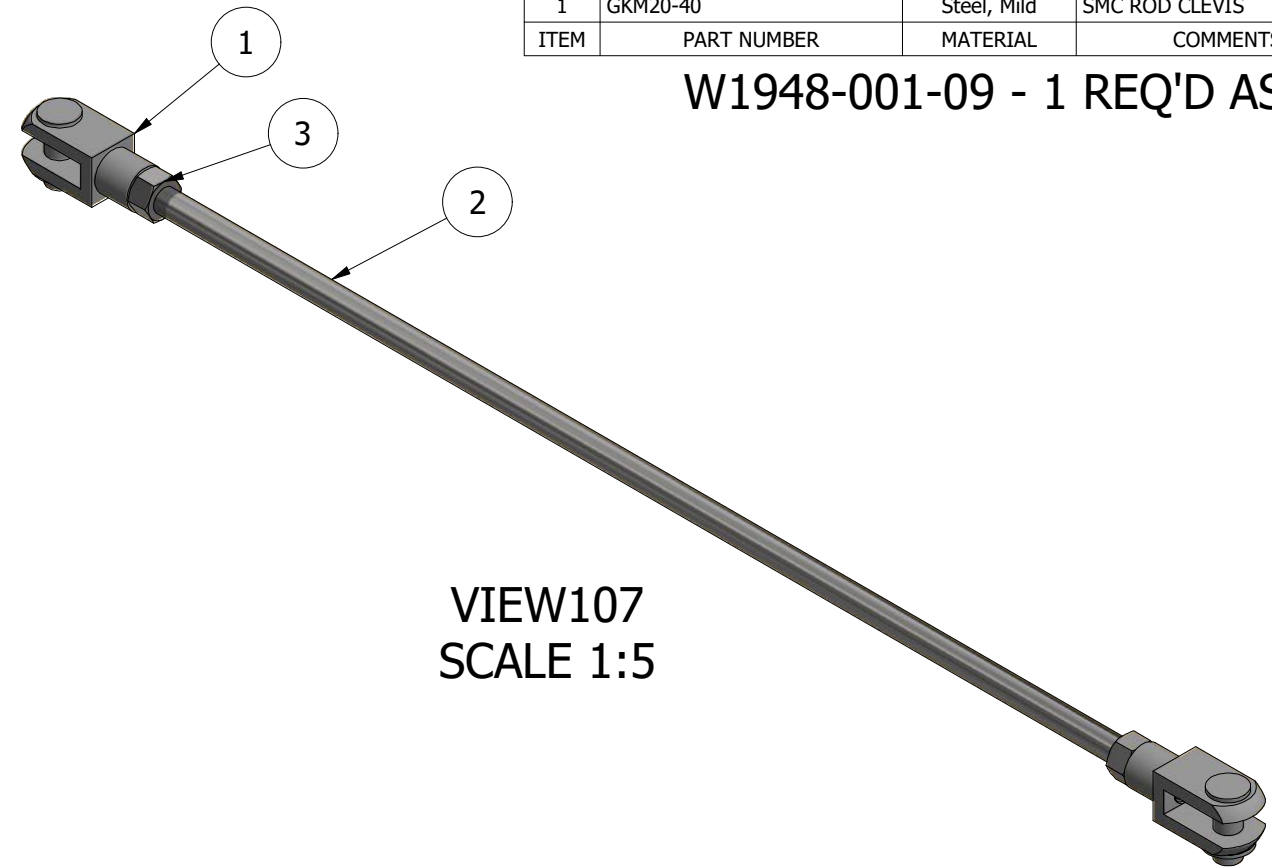

VIEW107  
SCALE 1:5

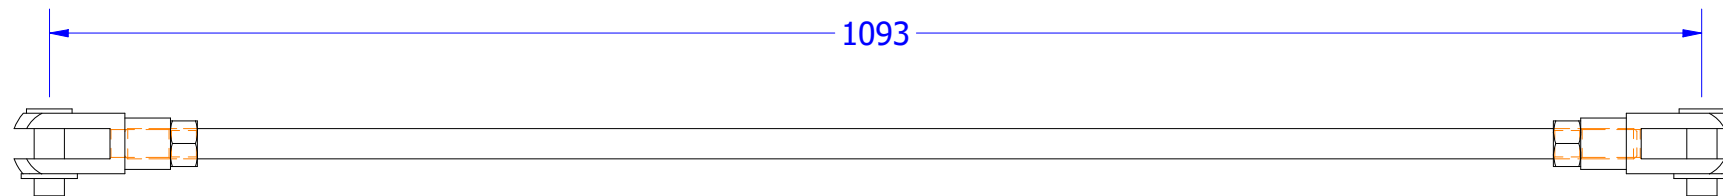


PLAN VIEW  
SCALE 1:5

DRAWN BY ULTIMATE ENGINEERING PTY LTD Ph 8562 1511



THESE DRAWINGS ARE THE PROPERTY OF ULTIMATE ENGINEERING AND SHOULD NOT BE REPRODUCED OR COPIED IN ANY WAY WITHOUT WRITTEN PERMISSION FROM ULTIMATE ENGINEERING

PAINT TREATMENT: TBA

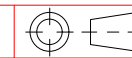

DIMENSION TOLERANCES	
DECIMAL	ANGULAR
X.X = ± .5 mm	X = ± 1°
X.XX = ± .25 mm	X.X = ± .5°
X.XXX = ± .125 mm	X.XX = ± .25°
MAXIMUM FINISHED SURFACE ROUGHNESS U.N.O. 1.6	

PARENT ASSEMBLY

CUSTOMER: **RAB ENGINEERING**

DRAWN: David Bilney

TITLE: W1948-001-09  
CHAIN CONVEYORS

DESIGNED: David Bilney

DWG NO: **194804**

DATE: 22/03/2021


JOB NO:

SCALE: Noted	SHEET 14 OF 48	SHEET SIZE: A3	REV: 2
-----------------	-------------------	-------------------	-----------


DO NOT SCALE DRAWING

2	M16 ALL THREAD	Steel, Mild	170 LONG	1
1	P1948-001-27	Steel, Mild	SHEET 37	1
ITEM	PART NUMBER	MATERIAL	COMMENTS	ITEM QTY


W1948-001-10 - 1 REQ'D AS DRAWN

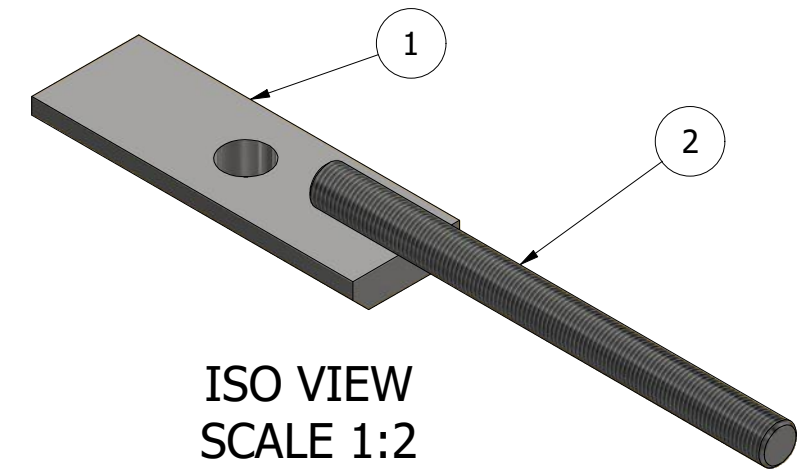


ISO VIEW  
SCALE 1:2

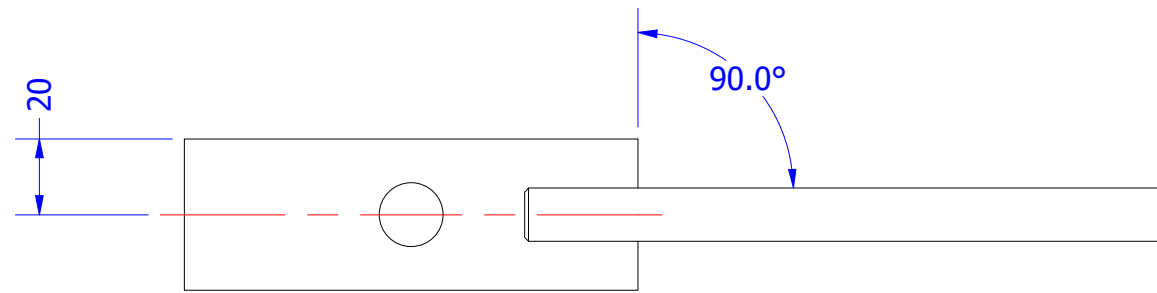

PLAN VIEW  
SCALE 1:2

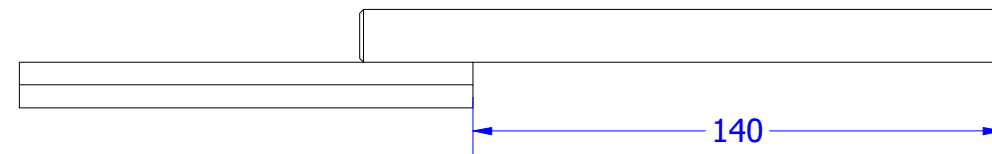

SIDE VIEW  
SCALE 1:2

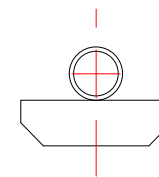

END VIEW  
SCALE 1:2

NOTES:


1. ALL WELDING TO CONFORM TO AS1554-GP UNO
2. ALL FILLET WELDS TO BE 6mm CONTINUOUS UNO
3. ALL BUTT WELDS SHALL BE FULL STRENGTH, COMPLETE PENETRATION WELDS
4. ALL FLAME CUT SURFACES SHALL BE UNIFORM & CLEAN BEFORE WELDING
5. REMOVE ALL BURRS & SHARP EDGES
6. NON DESTRUCTIVE TESTING:
  - A) ALL WELDS, 100% VISUAL SCAN TO AS1554 PART 1
7. FINISH:
  - A) ALL STEELWORK TO BE PRIMED OR COLD GALV UNO

DRAWN BY ULTIMATE ENGINEERING PTY LTD Ph 8562 1511



THESE DRAWINGS ARE THE PROPERTY OF ULTIMATE ENGINEERING AND SHOULD NOT BE REPRODUCED OR COPIED IN ANY WAY WITHOUT WRITTEN PERMISSION FROM ULTIMATE ENGINEERING

PAINT TREATMENT: ZINC PLATE

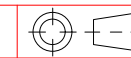


DIMENSION TOLERANCES	
DECIMAL	ANGULAR
X.X = ± .5 mm	X = ± 1°
X.XX = ± .25 mm	X.X = ± .5°
X.XXX = ± .125 mm	X.XX = ± .25°


MAXIMUM FINISHED SURFACE ROUGHNESS U.N.O. 1.6

PARENT ASSEMBLY	CUSTOMER: <b>RAB ENGINEERING</b>
DRAWN: David Bilney	TITLE: W1948-001-10 CHAIN CONVEYORS
DESIGNED: David Bilney	DWG NO: <b>194804</b>
DATE: 22/03/2021	JOB NO:
SCALE: Noted	SHEET: 15 OF 48
SHEET SIZE: A3	REV: 2


DO NOT SCALE DRAWING

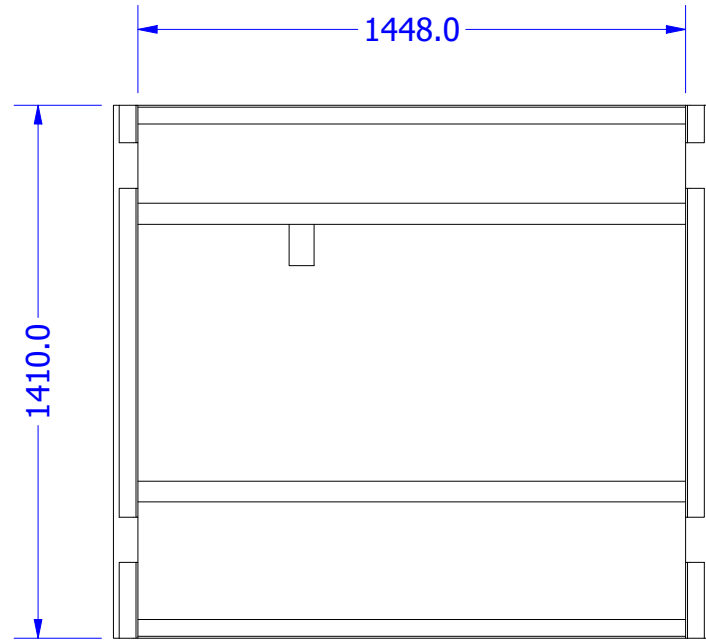


PLAN VIEW  
SCALE 1:20

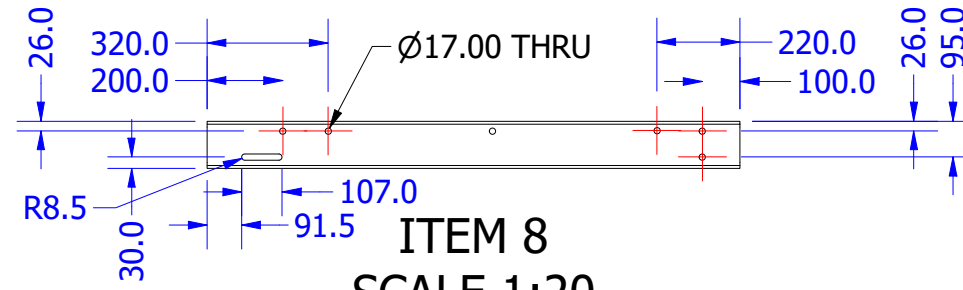


ITEM 8  
SCALE 1:20

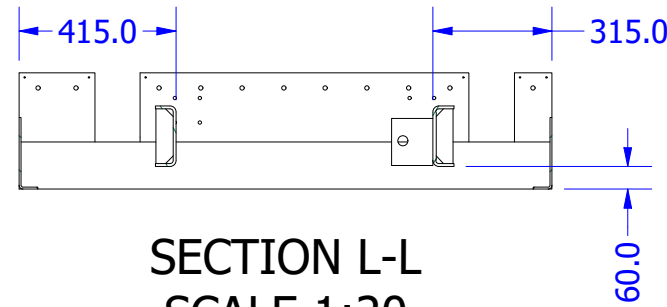


SECTION L-L  
SCALE 1:20

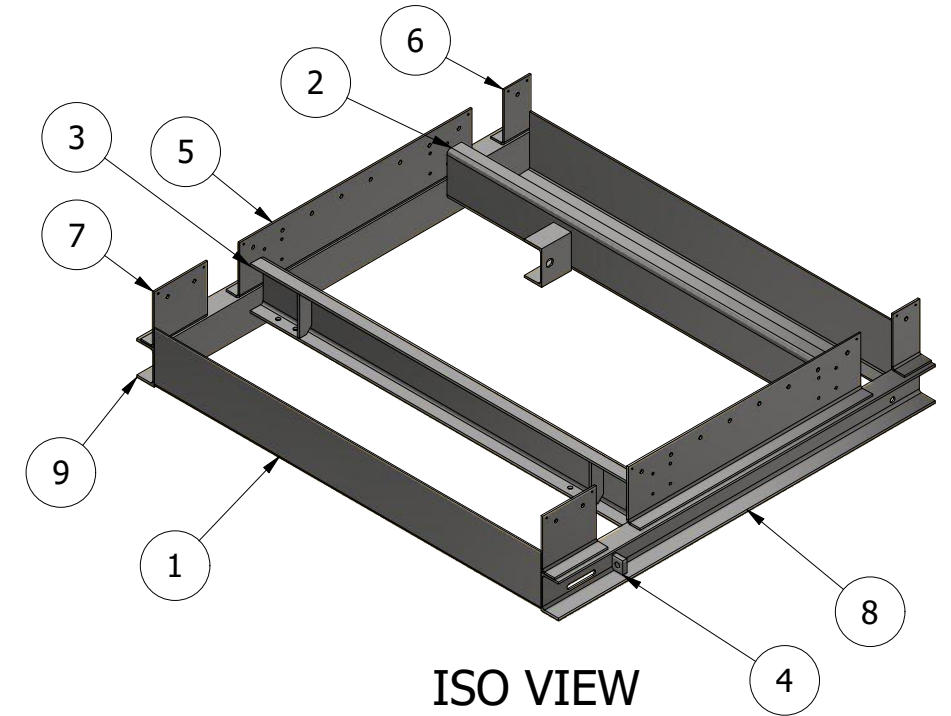

ISO VIEW  
SCALE 1:20

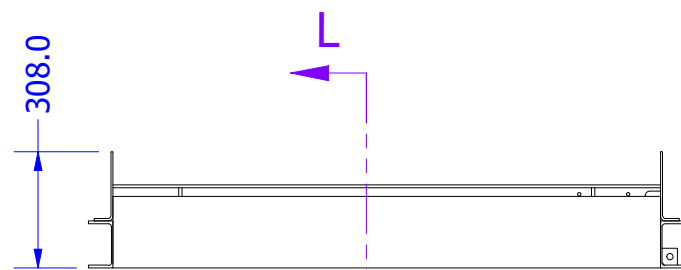

SIDE VIEW  
SCALE 1:20

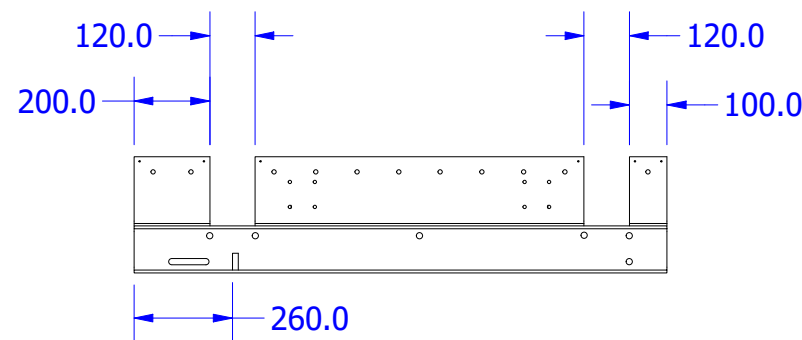

FRONT VIEW  
SCALE 1:20

ITEM	PART NUMBER	MATERIAL	COMMENTS	ITEM QTY
9	125PFC @ 1410	Steel, Mild		1
8	125PFC @ 1410	Steel, Mild		1
7	P1948-004-03	Steel, Mild	SHEET 41	2
6	P1948-004-02	Steel, Mild	SHEET 40	2
5	P1948-004-01	Steel, Mild	SHEET 39	2
4	P1948-001-26	Steel, Mild	SHEET 36	1
3	W1948-001-03	Weldment	SHEET 8	1
2	W1948-001-02	Weldment	SHEET 7	1
1	P1948-001-01	Steel, Mild	SHEET 21	2

W1948-004-01 - 1 REQ'D AS DRAWN


- NOTES:
- ALL WELDING TO CONFORM TO AS1554-GP UNO
  - ALL FILLET WELDS TO BE 6mm CONTINUOUS UNO
  - ALL BUTT WELDS SHALL BE FULL STRENGTH, COMPLETE PENETRATION WELDS
  - ALL FLAME CUT SURFACES SHALL BE UNIFORM & CLEAN BEFORE WELDING
  - REMOVE ALL BURRS & SHARP EDGES
  - NON DESTRUCTIVE TESTING:
    - ALL WELDS, 100% VISUAL SCAN TO AS1554 PART 1
  - FINISH:
    - ALL STEELWORK TO BE PRIMED OR COLD GALV UNO

DRAWN BY ULTIMATE ENGINEERING PTY LTD Ph 8562 1511



THESE DRAWINGS ARE THE PROPERTY OF ULTIMATE ENGINEERING AND SHOULD NOT BE REPRODUCED OR COPIED IN ANY WAY WITHOUT WRITTEN PERMISSION FROM ULTIMATE ENGINEERING

PAINT TREATMENT: TBA

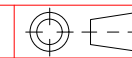

DIMENSION TOLERANCES  
 DECIMAL                      ANGULAR  
 X.X     = ± .5 mm            X     = ± 1°  
 X.XX    = ± .25 mm          X.X    = ± .5°  
 X.XXX   = ± .125 mm        X.XX   = ± .25°  
 MAXIMUM FINISHED SURFACE ROUGHNESS U.N.O. 1.6

PARENT ASSEMBLY

CUSTOMER:

**RAB ENGINEERING**

DRAWN: David Bilney

TITLE:

W1948-004-01  
CHAIN CONVEYORS

DESIGNED: David Bilney

DWG NO:

**194804**

DATE: 22/03/2021

JOB NO:

SCALE: Noted

SHEET 16 OF 48


SHEET SIZE: A3

REV: 2


DO NOT SCALE DRAWING

2	P1948-004-10	Steel, Mild	SHEET 47	1
1	125PFC @ 300	Steel, Mild		1
ITEM	PART NUMBER	MATERIAL	COMMENTS	ITEM QTY


W1948-004-02 - 2 REQ'D AS DRAWN

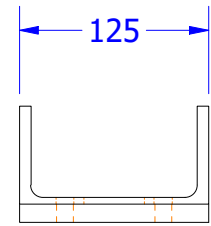


PLAN VIEW  
SCALE 1:5

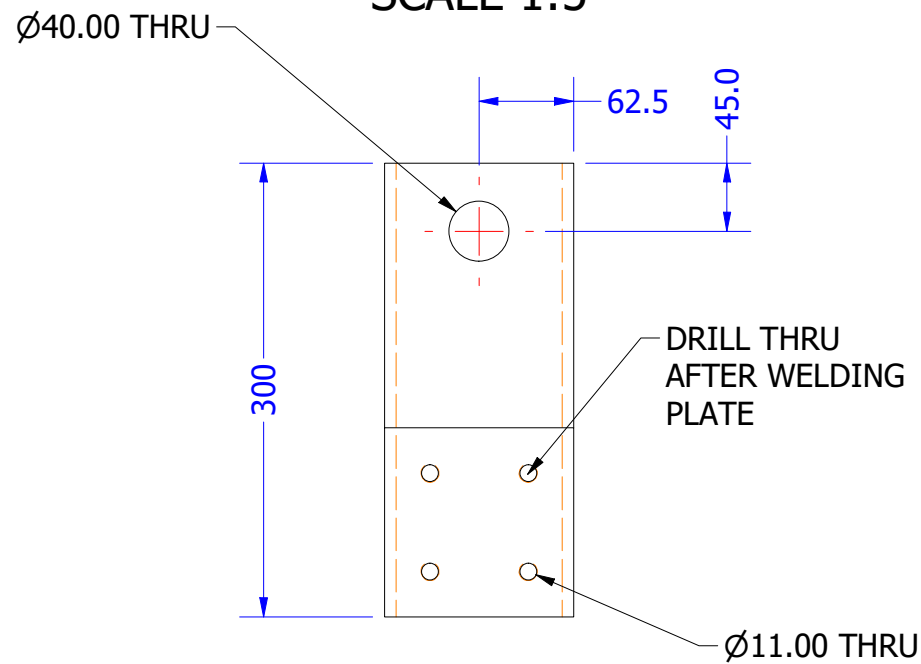

FRONT VIEW  
SCALE 1:5

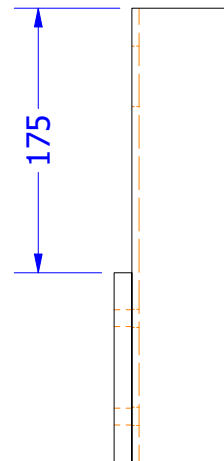

SIDE VIEW  
SCALE 1:5

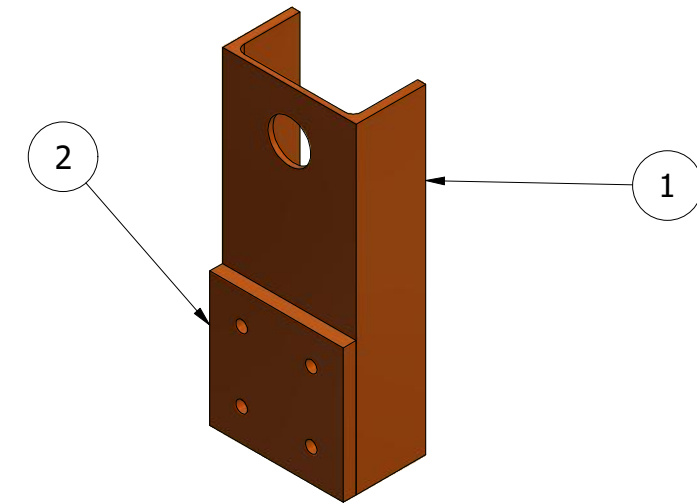

ISO VIEW  
SCALE 1:5

NOTES:


- ALL WELDING TO CONFORM TO AS1554-GP UNO
- ALL FILLET WELDS TO BE 6mm CONTINUOUS UNO
- ALL BUTT WELDS SHALL BE FULL STRENGTH, COMPLETE PENETRATION WELDS
- ALL FLAME CUT SURFACES SHALL BE UNIFORM & CLEAN BEFORE WELDING
- REMOVE ALL BURRS & SHARP EDGES
- NON DESTRUCTIVE TESTING:
  - A) ALL WELDS, 100% VISUAL SCAN TO AS1554 PART 1
- FINISH:
  - A) ALL STEELWORK TO BE PRIMED OR COLD GALV UNO

DRAWN BY ULTIMATE ENGINEERING PTY LTD Ph 8562 1511



THESE DRAWINGS ARE THE PROPERTY OF ULTIMATE ENGINEERING AND SHOULD NOT BE REPRODUCED OR COPIED IN ANY WAY WITHOUT WRITTEN PERMISSION FROM ULTIMATE ENGINEERING

PAINT TREATMENT: TBA

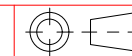

DIMENSION TOLERANCES	
DECIMAL	ANGULAR
X.X = ± .5 mm	X = ± 1°
X.XX = ± .25 mm	X.X = ± .5°
X.XXX = ± .125 mm	X.XX = ± .25°


MAXIMUM FINISHED SURFACE ROUGHNESS U.N.O. 1.6

PARENT ASSEMBLY	CUSTOMER: <b>RAB ENGINEERING</b>
DRAWN: David Bilney	TITLE: W1948-004-02 CHAIN CONVEYORS
DESIGNED: David Bilney	DWG NO: <b>194804</b>
DATE: 22/03/2021	JOB NO:
SCALE: Noted	SHEET 17 OF 48
SHEET SIZE: A3	REV: 2

DO NOT SCALE DRAWING

6mm PLATE @ 65 X 65	Steel, Mild	AS3678 - GR250
DESCRIPTION	MATERIAL	COMMENTS

P1948-000-08 - 4 REQ'D AS DRAWN

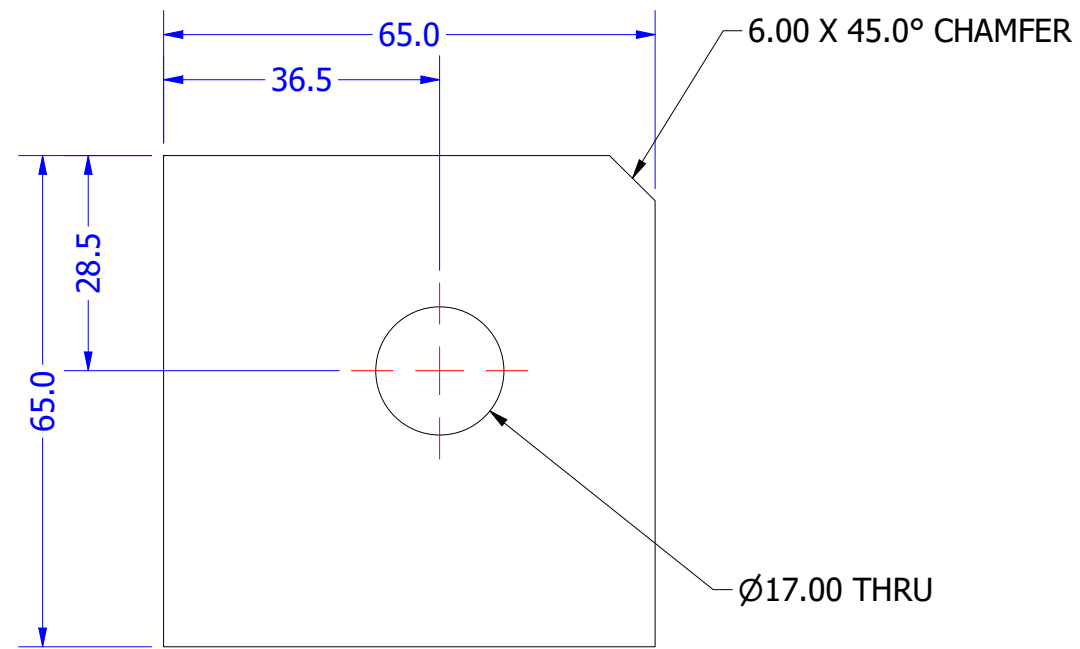


FRONT VIEW  
SCALE 1 : 1

REMOVE ALL BURRS & SHARP EDGES



THESE DRAWINGS ARE THE PROPERTY OF ULTIMATE ENGINEERING AND SHOULD NOT BE REPRODUCED OR COPIED IN ANY WAY WITHOUT WRITTEN PERMISSION FROM ULTIMATE ENGINEERING

PAINT TREATMENT:

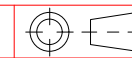

DIMENSION TOLERANCES	
DECIMAL	ANGULAR
X.X = ± .5 mm	X = ± 1°
X.XX = ± .25 mm	X.X = ± .5°
X.XXX = ± .125 mm	X.XX = ± .25°
MAXIMUM FINISHED SURFACE ROUGHNESS U.N.O. 1.6	

PARENT ASSEMBLY

DRAWN: David Bilney

DESIGNED: David Bilney

DATE: 22/03/2021

CUSTOMER:

TITLE: P1948-000-08  
CHAIN CONVEYORS

DWG NO: 194801/18

JOB NO:

SCALE: Noted	SHEET 18 OF 48	SHEET SIZE: A3	REV: 2
-----------------	-------------------	-------------------	-----------




DO NOT SCALE DRAWING


40 RND BAR @ 75	Steel, Mild	AS1444-1996-4140
DESCRIPTION	MATERIAL	COMMENTS

P1948-000-25 - 1 REQ'D AS DRAWN

\* CHECK AVAILABILITY OF OFF THE SHELF COMPONENT

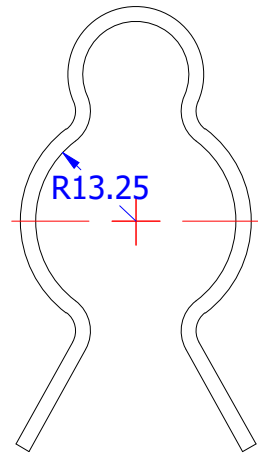


RETAINING CLIP TO SUIT PIN  
SCALE 1 : 1

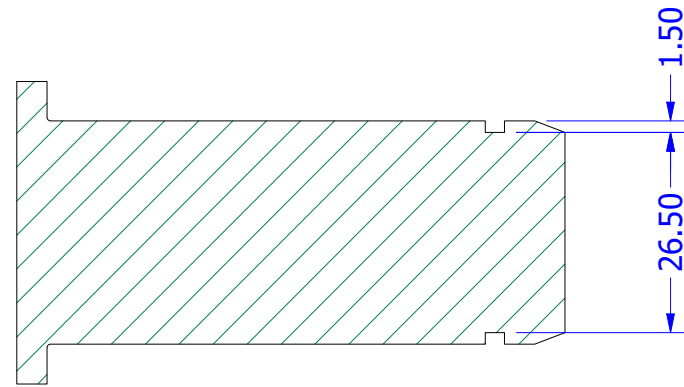


SECTION A-A  
SCALE 1 : 1



ISO VIEW  
SCALE 1 : 1

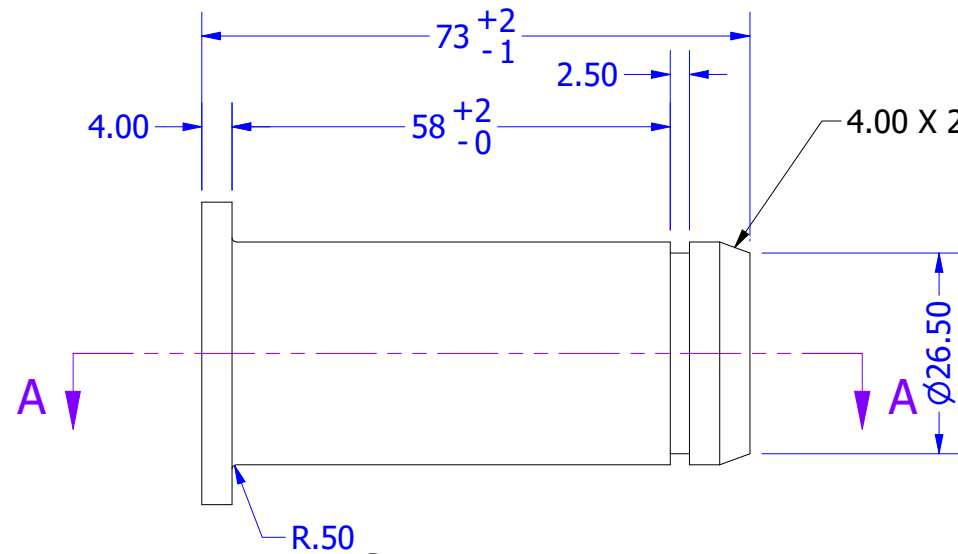

SIDE VIEW  
SCALE 1 : 1

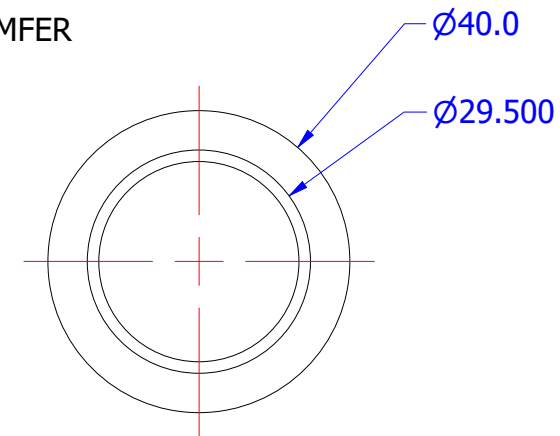


END VIEW  
SCALE 1 : 1

REMOVE ALL BURRS & SHARP EDGES



THESE DRAWINGS ARE THE PROPERTY OF ULTIMATE ENGINEERING AND SHOULD NOT BE REPRODUCED OR COPIED IN ANY WAY WITHOUT WRITTEN PERMISSION FROM ULTIMATE ENGINEERING

PAINT TREATMENT: ZINC PLATE

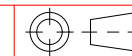

PARENT ASSEMBLY

CUSTOMER:

RAB ENGINEERING

DIMENSION TOLERANCES	
DECIMAL	ANGULAR
X.X = ± .5 mm	X = ± 1°
X.XX = ± .25 mm	X.X = ± .5°
X.XXX = ± .125 mm	X.XX = ± .25°

DRAWN: David Bilney

TITLE:

P1948-000-25  
CHAIN CONVEYORS

DESIGNED: David Bilney

DWG NO:

194804

MAXIMUM FINISHED SURFACE ROUGHNESS U.N.O. 1.6

DATE: 22/03/2021

JOB NO:

SCALE: Noted

SHEET 19 OF 48

SHEET SIZE: A3


REV: 2

DO NOT SCALE DRAWING


25 RND BAR @ 40mm	Steel, Mild	AS1444-1996-4140
DESCRIPTION	MATERIAL	COMMENTS

P1948-000-26 - 4 REQ'D AS DRAWN


\*CHECK AVAILABILITY OF OFF THE SHELF ITEM

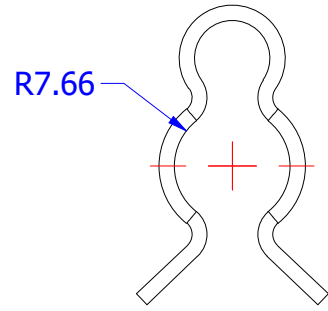


RETAINING CLIP TO SUIT PIN  
SCALE 1 : 1

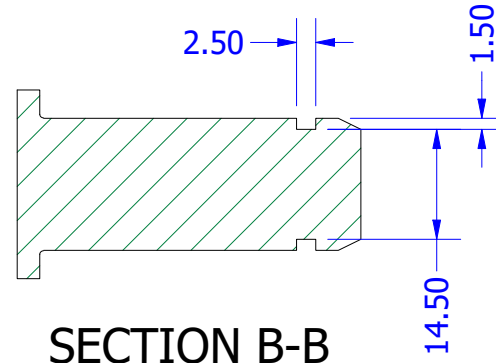


SECTION B-B  
SCALE 1 : 1

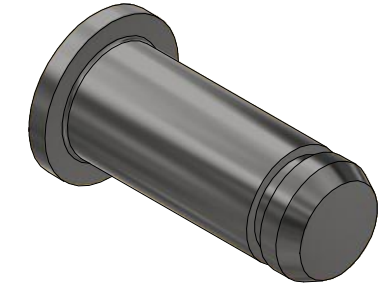

ISO VIEW  
SCALE 1 : 1

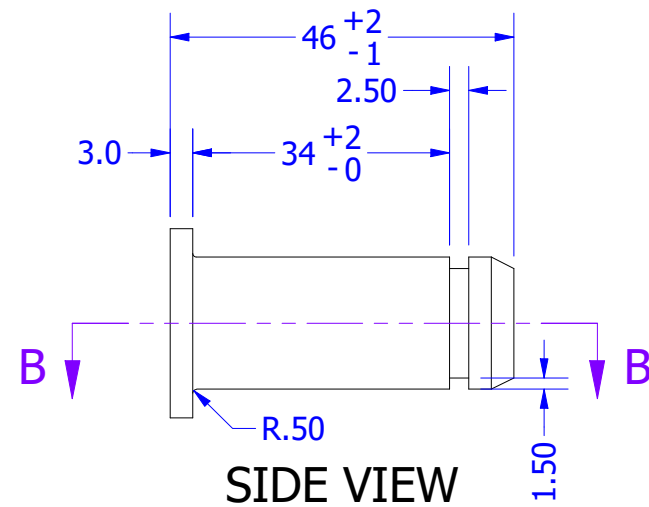

SIDE VIEW  
SCALE 1 : 1

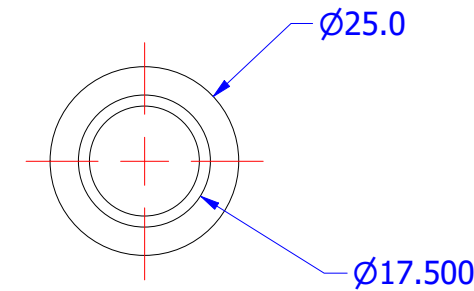


END VIEW  
SCALE 1 : 1

REMOVE ALL BURRS & SHARP EDGES



THESE DRAWINGS ARE THE PROPERTY OF ULTIMATE ENGINEERING AND SHOULD NOT BE REPRODUCED OR COPIED IN ANY WAY WITHOUT WRITTEN PERMISSION FROM ULTIMATE ENGINEERING

PAINT TREATMENT: ZINC PLATE

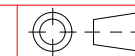

PARENT ASSEMBLY

CUSTOMER:

RAB ENGINEERING

DIMENSION TOLERANCES	
DECIMAL	ANGULAR
X.X = ± .5 mm	X = ± 1°
X.XX = ± .25 mm	X.X = ± .5°
X.XXX = ± .125 mm	X.XX = ± .25°

DRAWN: David Bilney

TITLE:

P1948-000-26  
CHAIN CONVEYORS

DESIGNED: David Bilney

DWG NO:

194804

MAXIMUM FINISHED SURFACE ROUGHNESS U.N.O. 1.6

DATE: 22/03/2021


JOB NO:

SCALE: Noted	SHEET 20 OF 48	SHEET SIZE: A3	REV: 2
-----------------	-------------------	-------------------	-----------


DO NOT SCALE DRAWING

5mm PLATE @ 1448 X 232	Steel, Mild	AS3678 - GR250
DESCRIPTION	MATERIAL	COMMENTS


P1948-001-01 - 2 REQ'D AS DRAWN

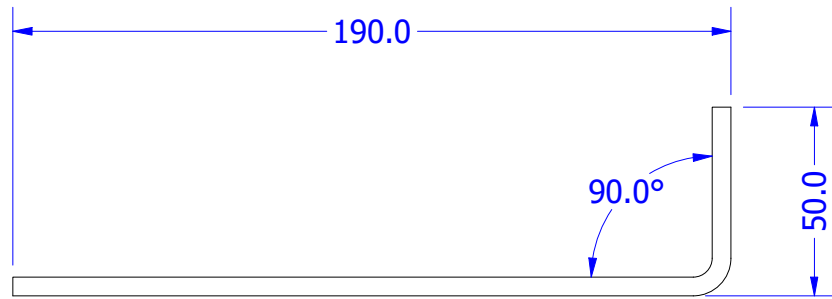

END VIEW - FOLDED  
SCALE 1:2

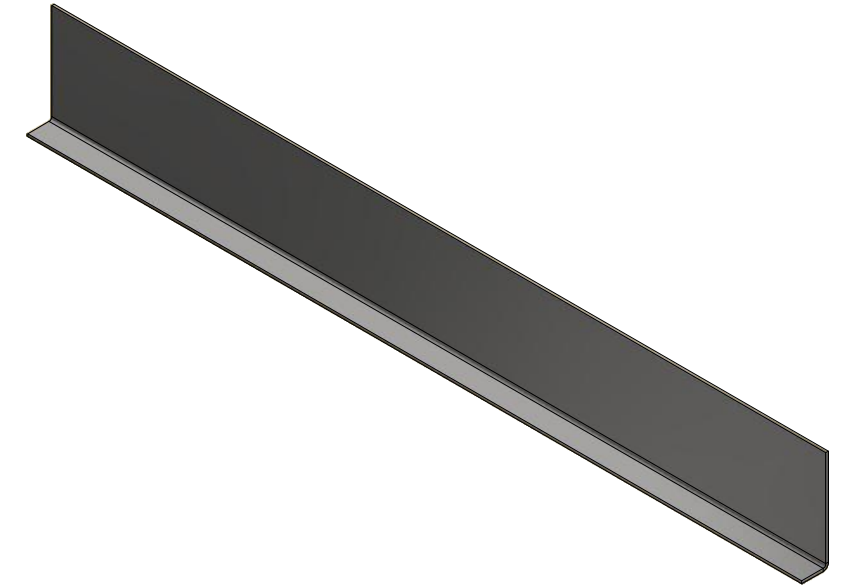

ISO VIEW  
SCALE 1:10

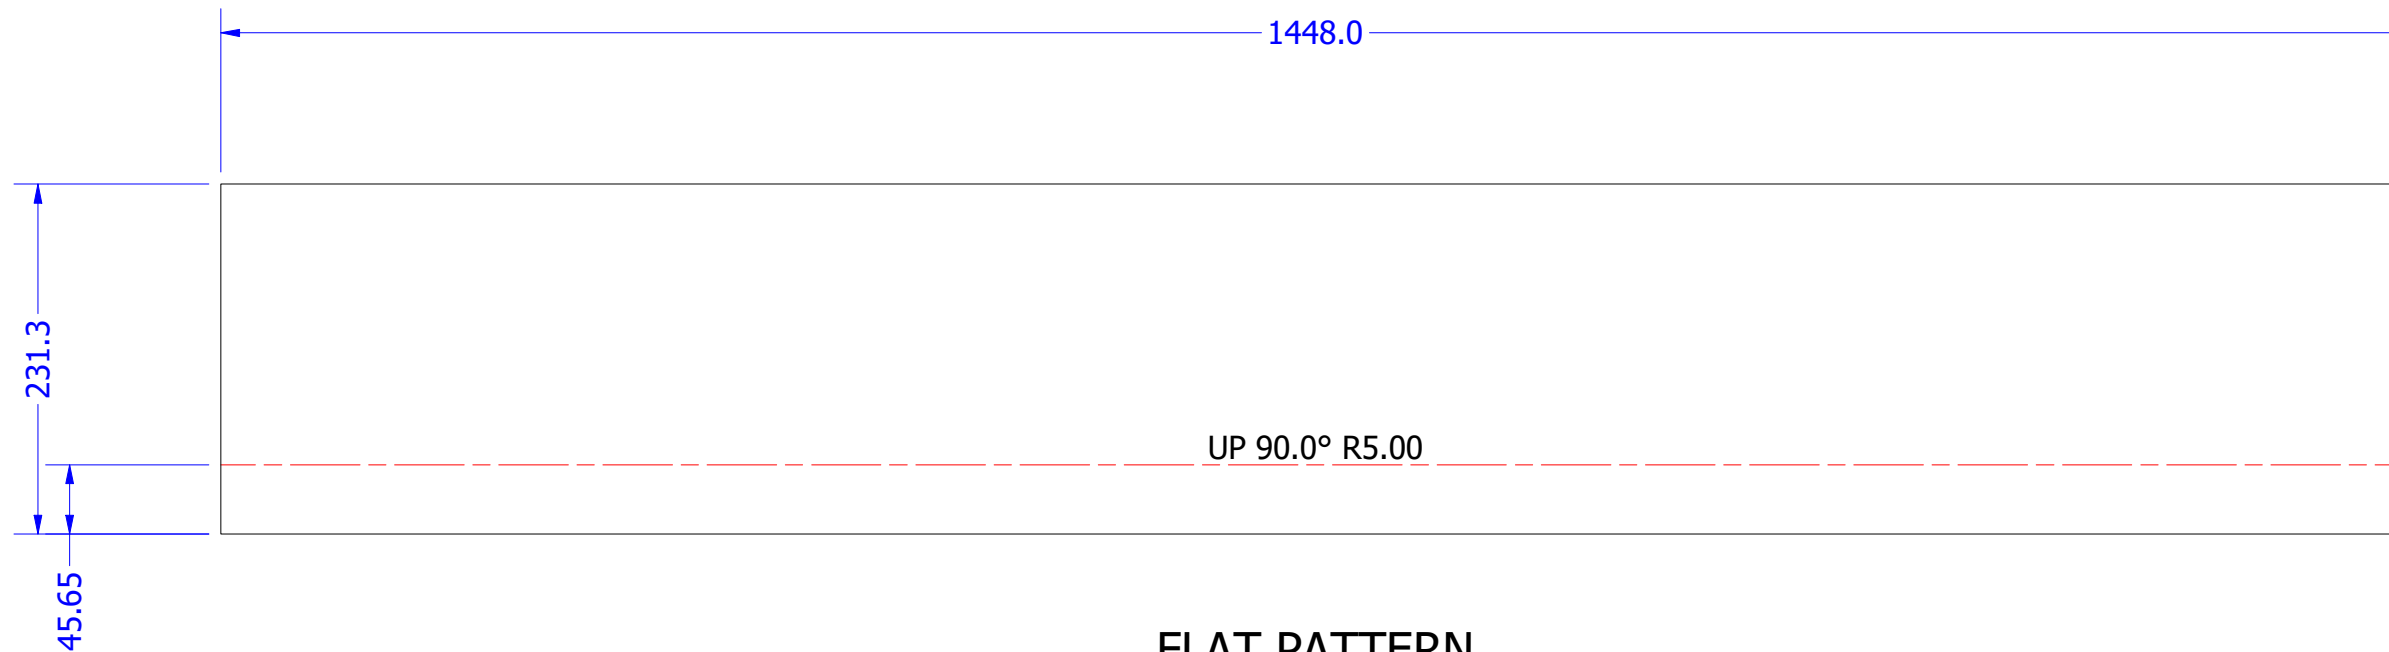

FLAT PATTERN  
SCALE 1:5

REMOVE ALL BURRS & SHARP EDGES



THESE DRAWINGS ARE THE PROPERTY OF ULTIMATE ENGINEERING AND SHOULD NOT BE REPRODUCED OR COPIED IN ANY WAY WITHOUT WRITTEN PERMISSION FROM ULTIMATE ENGINEERING

PAINT TREATMENT:



DIMENSION TOLERANCES	
DECIMAL	ANGULAR
X.X = ± .5 mm	X = ± 1°
X.XX = ± .25 mm	X.X = ± .5°
X.XXX = ± .125 mm	X.XX = ± .25°

MAXIMUM FINISHED SURFACE ROUGHNESS U.N.O. 1.6 ✓

PARENT ASSEMBLY

CUSTOMER:

RAB ENGINEERING

DRAWN: David Bilney

TITLE:

P1948-001-01  
CHAIN CONVEYORS

DESIGNED: David Bilney

DWG NO:

194804

DATE: 22/03/2021

JOB NO:

SCALE:  
Noted

SHEET  
21 OF 48


SHEET SIZE:  
A3

REV:  
2

DO NOT SCALE DRAWING

8mm PLATE @ 1448 X 272	Steel, Mild	AS3678 - GR250
DESCRIPTION	MATERIAL	COMMENTS


P1948-001-04 - 1 REQ'D AS DRAWN

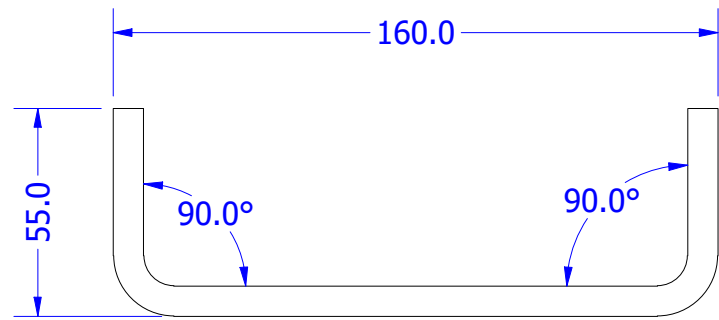

FOLDED SECTION  
SCALE 1:2



ISO VIEW  
SCALE 1:10

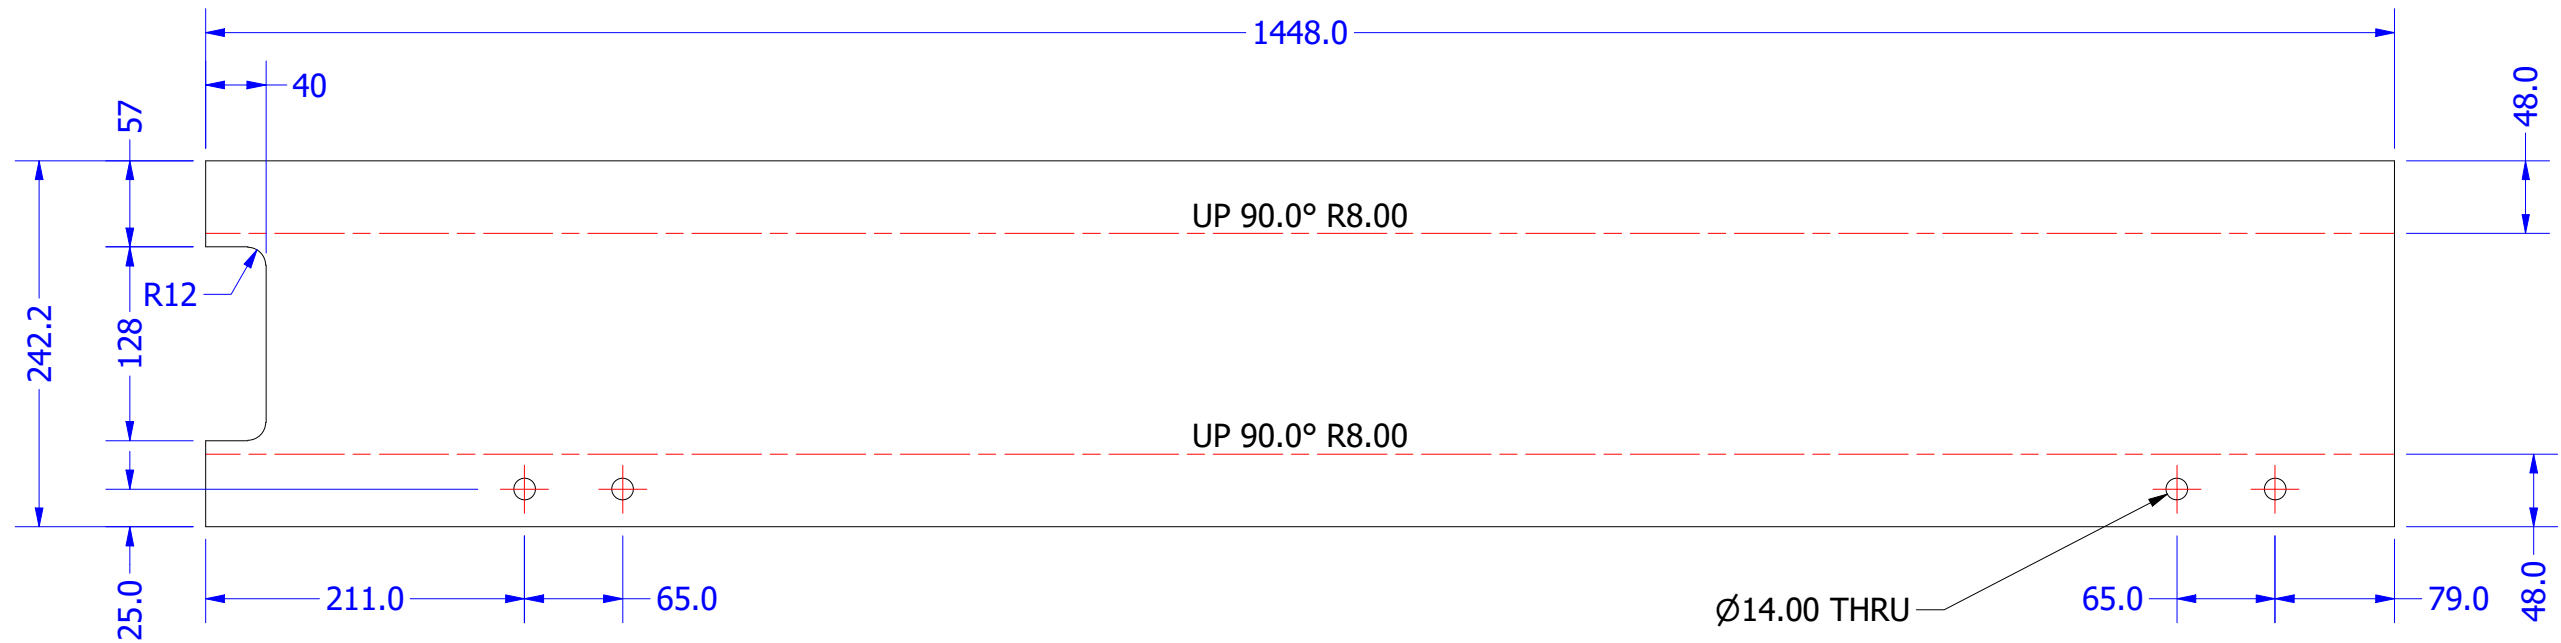


FLAT PATTERN  
SCALE 1:5

REMOVE ALL BURRS & SHARP EDGES



THESE DRAWINGS ARE THE PROPERTY OF ULTIMATE ENGINEERING AND SHOULD NOT BE REPRODUCED OR COPIED IN ANY WAY WITHOUT WRITTEN PERMISSION FROM ULTIMATE ENGINEERING

PAINT TREATMENT:

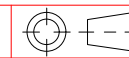

DIMENSION TOLERANCES  
DECIMAL ANGULAR  
X.X = ± .5 mm X = ± 1°  
X.XX = ± .25 mm X.X = ± .5°  
X.XXX = ± .125 mm X.XX = ± .25°  
MAXIMUM FINISHED SURFACE ROUGHNESS U.N.O. 1.6

PARENT ASSEMBLY

CUSTOMER:

RAB ENGINEERING

DRAWN: David Bilney

TITLE:

P1948-001-04  
CHAIN CONVEYORS

DESIGNED: David Bilney

DWG NO:

194804

DATE: 22/03/2021

JOB NO:

SCALE: Noted

SHEET 22 OF 48


SHEET SIZE: A3

REV: 2

DO NOT SCALE DRAWING

8mm PLATE @ 1448 X 242	Steel, Mild	AS3678 - GR250
DESCRIPTION	MATERIAL	COMMENTS


P1948-001-05 - 1 REQ'D AS DRAWN

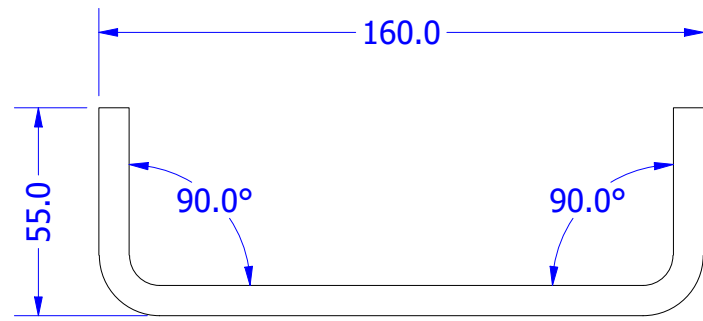

FOLDED SECTION  
SCALE 1:2



ISO VIEW  
SCALE 1:10

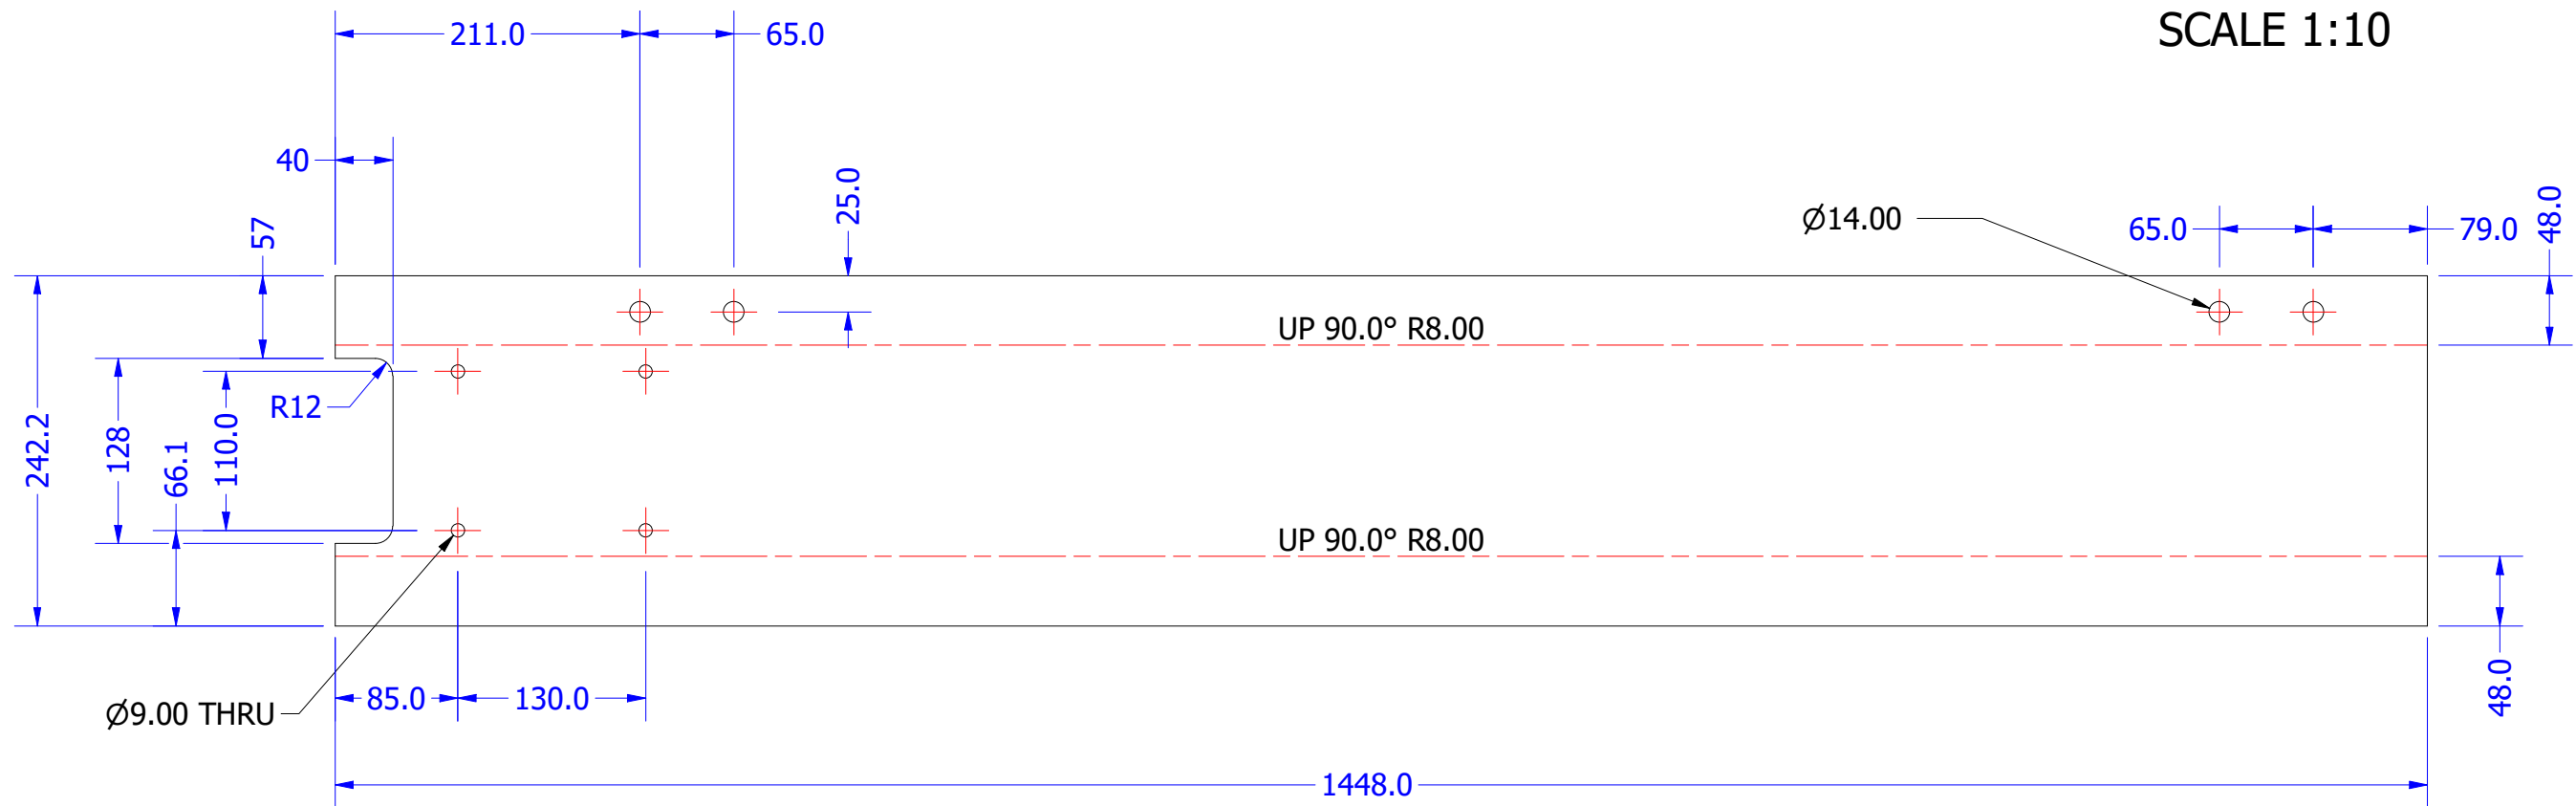


FLAT PATTERN  
SCALE 1:5

REMOVE ALL BURRS & SHARP EDGES



THESE DRAWINGS ARE THE PROPERTY OF ULTIMATE ENGINEERING AND SHOULD NOT BE REPRODUCED OR COPIED IN ANY WAY WITHOUT WRITTEN PERMISSION FROM ULTIMATE ENGINEERING

PAINT TREATMENT:

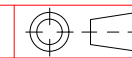

DIMENSION TOLERANCES	
DECIMAL	ANGULAR
X.X = ± .5 mm	X = ± 1°
X.XX = ± .25 mm	X.X = ± .5°
X.XXX = ± .125 mm	X.XX = ± .25°

MAXIMUM FINISHED SURFACE ROUGHNESS U.N.O. 1.6

PARENT ASSEMBLY

CUSTOMER:

RAB ENGINEERING

DRAWN: David Bilney

TITLE:

P1948-001-05  
CHAIN CONVEYORS

DESIGNED: David Bilney

DWG NO:

194804

DATE: 22/03/2021

JOB NO:

SCALE: Noted

SHEET 23 OF 48


SHEET SIZE: A3

REV: 2

DO NOT SCALE DRAWING

8mm PLATE @ 144 X 45	Steel, Mild	AS3678 - GR250
DESCRIPTION	MATERIAL	COMMENTS

P1948-001-06 - 4 REQ'D AS DRAWN

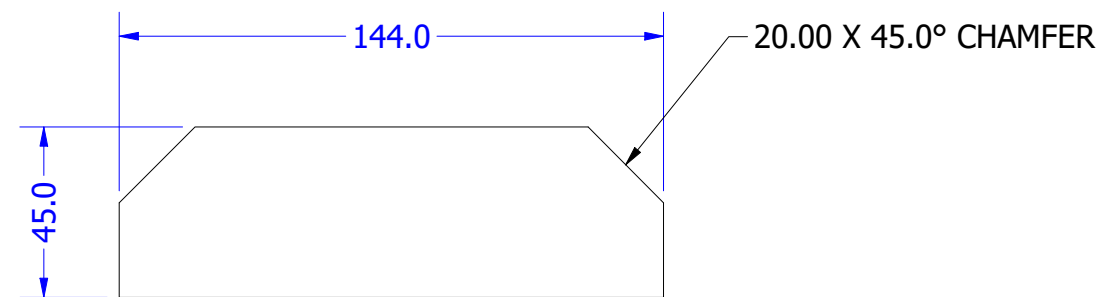


FRONT VIEW  
SCALE 1:2

REMOVE ALL BURRS & SHARP EDGES



THESE DRAWINGS ARE THE PROPERTY OF ULTIMATE ENGINEERING AND SHOULD NOT BE REPRODUCED OR COPIED IN ANY WAY WITHOUT WRITTEN PERMISSION FROM ULTIMATE ENGINEERING

PAINT TREATMENT:

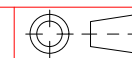

DIMENSION TOLERANCES	
DECIMAL	ANGULAR
X.X = ± .5 mm	X = ± 1°
X.XX = ± .25 mm	X.X = ± .5°
X.XXX = ± .125 mm	X.XX = ± .25°
MAXIMUM FINISHED SURFACE ROUGHNESS U.N.O. 1.6	

PARENT ASSEMBLY

CUSTOMER: **RAB ENGINEERING**

DRAWN: David Bilney

TITLE: P1948-001-06  
CHAIN CONVEYORS

DESIGNED: David Bilney

DWG NO: **194804**

DATE: 22/03/2021

JOB NO:

SCALE: Noted	SHEET 24 OF 48	SHEET SIZE: A3	REV: 2
--------------	----------------	----------------	--------


DRAWN BY ULTIMATE ENGINEERING PTY LTD Ph 8562 1511



DO NOT SCALE DRAWING

100x10 FMS @ 185	Steel, Mild	AS3679 - GR300
DESCRIPTION	MATERIAL	COMMENTS

P1948-001-07 - 4 REQ'D AS DRAWN

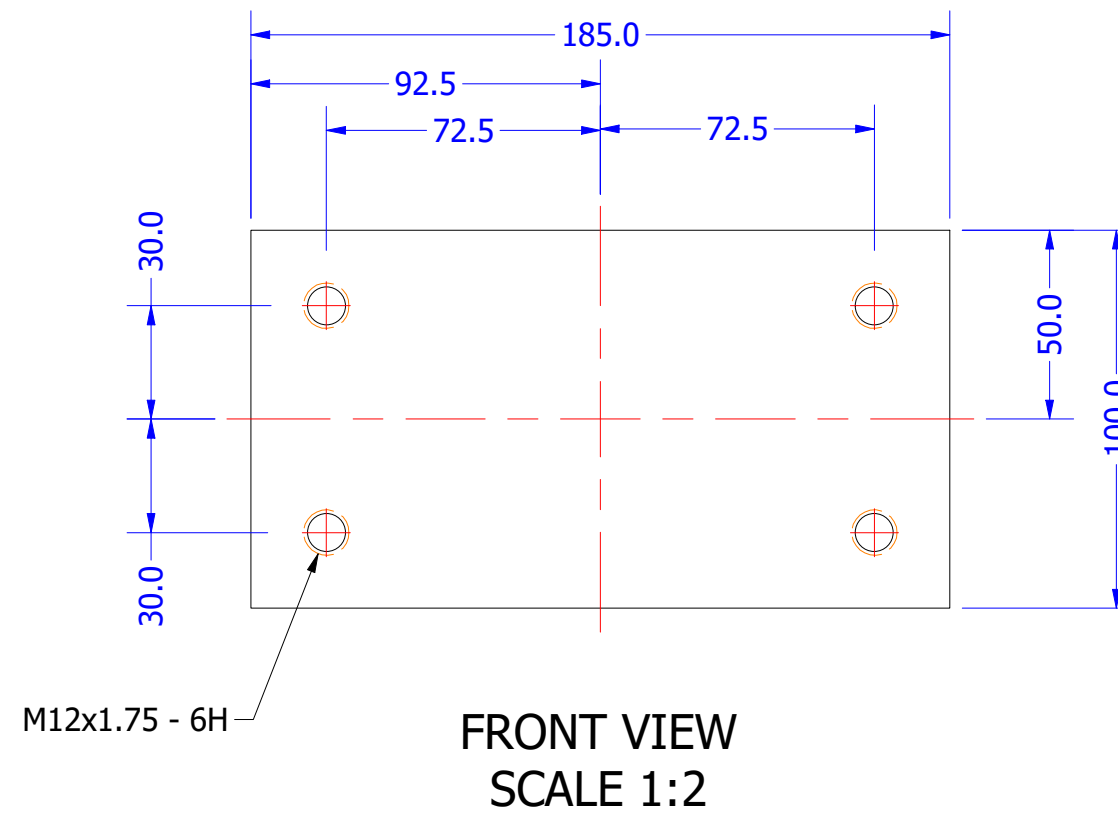

DRAWN BY ULTIMATE ENGINEERING PTY LTD Ph 8562 1511



THESE DRAWINGS ARE THE PROPERTY OF ULTIMATE ENGINEERING AND SHOULD NOT BE REPRODUCED OR COPIED IN ANY WAY WITHOUT WRITTEN PERMISSION FROM ULTIMATE ENGINEERING

PAINT TREATMENT:



DIMENSION TOLERANCES	
DECIMAL	ANGULAR
X.X = ± .5 mm	X = ± 1°
X.XX = ± .25 mm	X.X = ± .5°
X.XXX = ± .125 mm	X.XX = ± .25°

MAXIMUM FINISHED SURFACE ROUGHNESS U.N.O. 1.6

PARENT ASSEMBLY

DRAWN: David Bilney

DESIGNED: David Bilney

DATE: 22/03/2021

CUSTOMER:

TITLE:

DWG NO:

JOB NO:

REMOVE ALL BURRS & SHARP EDGES

RAB ENGINEERING

P1948-001-07  
CHAIN CONVEYORS


194804

SCALE: Noted	SHEET 25 OF 48	SHEET SIZE: A3	REV: 2
-----------------	-------------------	-------------------	-----------

DO NOT SCALE DRAWING

10mm PLATE @ 200 X 80	Steel, Mild	AS3678 - GR250
DESCRIPTION	MATERIAL	COMMENTS

P1948-001-08 - 4 REQ'D AS DRAWN

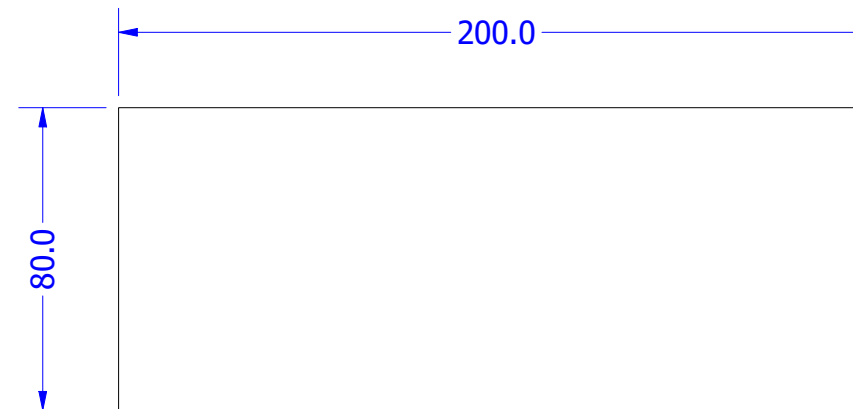

FRONT VIEW  
SCALE 1:2

REMOVE ALL BURRS & SHARP EDGES



THESE DRAWINGS ARE THE PROPERTY OF ULTIMATE ENGINEERING AND SHOULD NOT BE REPRODUCED OR COPIED IN ANY WAY WITHOUT WRITTEN PERMISSION FROM ULTIMATE ENGINEERING


PAINT TREATMENT:		PARENT ASSEMBLY	CUSTOMER:	<b>RAB ENGINEERING</b>			
DIMENSION TOLERANCES DECIMAL                      ANGULAR X.X     = ± .5 mm     X     = ± 1° X.XX    = ± .25 mm    X.X    = ± .5° X.XXX   = ± .125 mm   X.XX   = ± .25°		DRAWN: David Bilney	TITLE:	P1948-001-08 CHAIN CONVEYORS			
MAXIMUM FINISHED SURFACE ROUGHNESS U.N.O. 1.6 ✓		DESIGNED: David Bilney	DWG NO:	<b>194804</b>			
		DATE: 22/03/2021	JOB NO:	SCALE: Noted	SHEET 26 OF 48	SHEET SIZE: A3	REV: 2

DRAWN BY ULTIMATE ENGINEERING PTY LTD Ph 8562 1511

DO NOT SCALE DRAWING

100 x 10 FMS @ 185	Steel, Mild	AS3679 - GR300
DESCRIPTION	MATERIAL	COMMENTS

P1948-001-09 - 4 REQ'D AS DRAWN

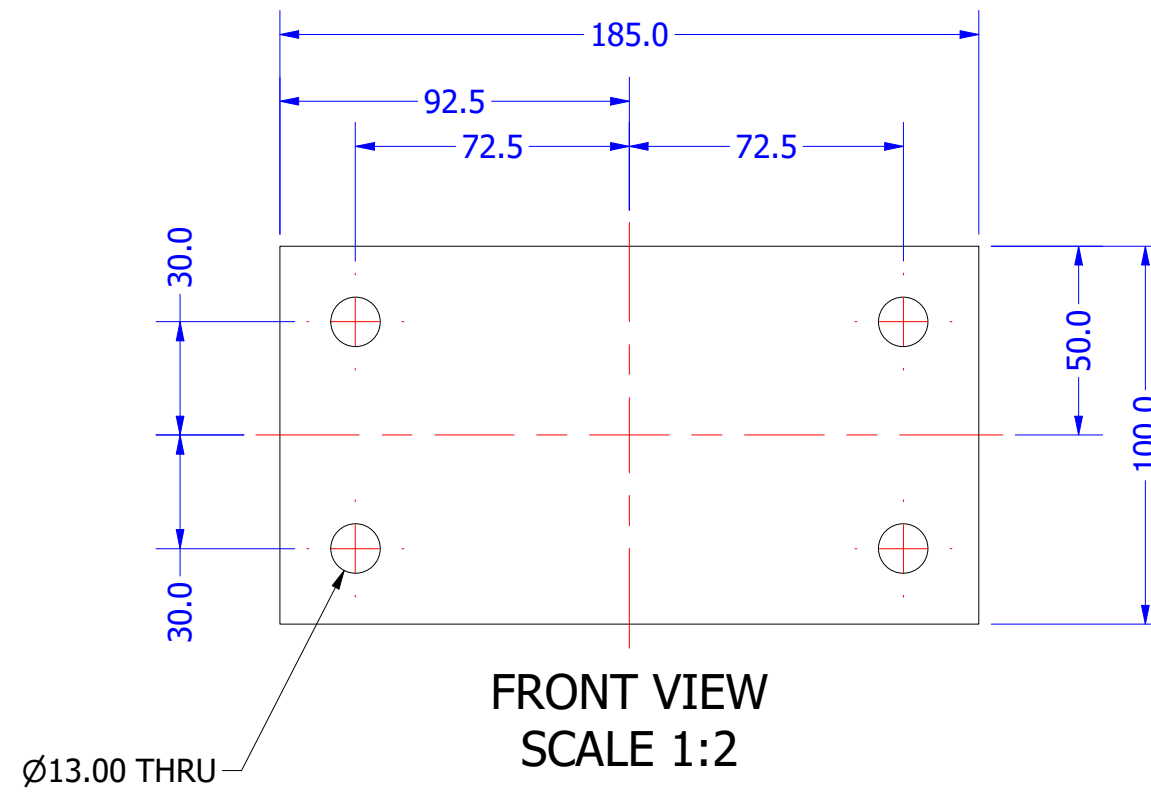


REMOVE ALL BURRS & SHARP EDGES



THESE DRAWINGS ARE THE PROPERTY OF ULTIMATE ENGINEERING AND SHOULD NOT BE REPRODUCED OR COPIED IN ANY WAY WITHOUT WRITTEN PERMISSION FROM ULTIMATE ENGINEERING

PAINT TREATMENT:

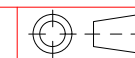

DIMENSION TOLERANCES	
DECIMAL	ANGULAR
X.X = ± .5 mm	X = ± 1°
X.XX = ± .25 mm	X.X = ± .5°
X.XXX = ± .125 mm	X.XX = ± .25°
MAXIMUM FINISHED SURFACE ROUGHNESS U.N.O. 1.6	

PARENT ASSEMBLY

CUSTOMER: **RAB ENGINEERING**

DRAWN: David Bilney

TITLE: P1948-001-09  
CHAIN CONVEYORS

DESIGNED: David Bilney

DWG NO: **194804**

DATE: 22/03/2021


JOB NO:	SCALE: Noted	SHEET 27 OF 48	SHEET SIZE: A3	REV: 2
---------	--------------	----------------	----------------	--------

DRAWN BY ULTIMATE ENGINEERING PTY LTD Ph 8562 1511

DO NOT SCALE DRAWING

50 x 10 FMS @ 115	Steel, Mild	AS3679 - GR300
DESCRIPTION	MATERIAL	COMMENTS

P1948-001-10 - 4 REQ'D AS DRAWN

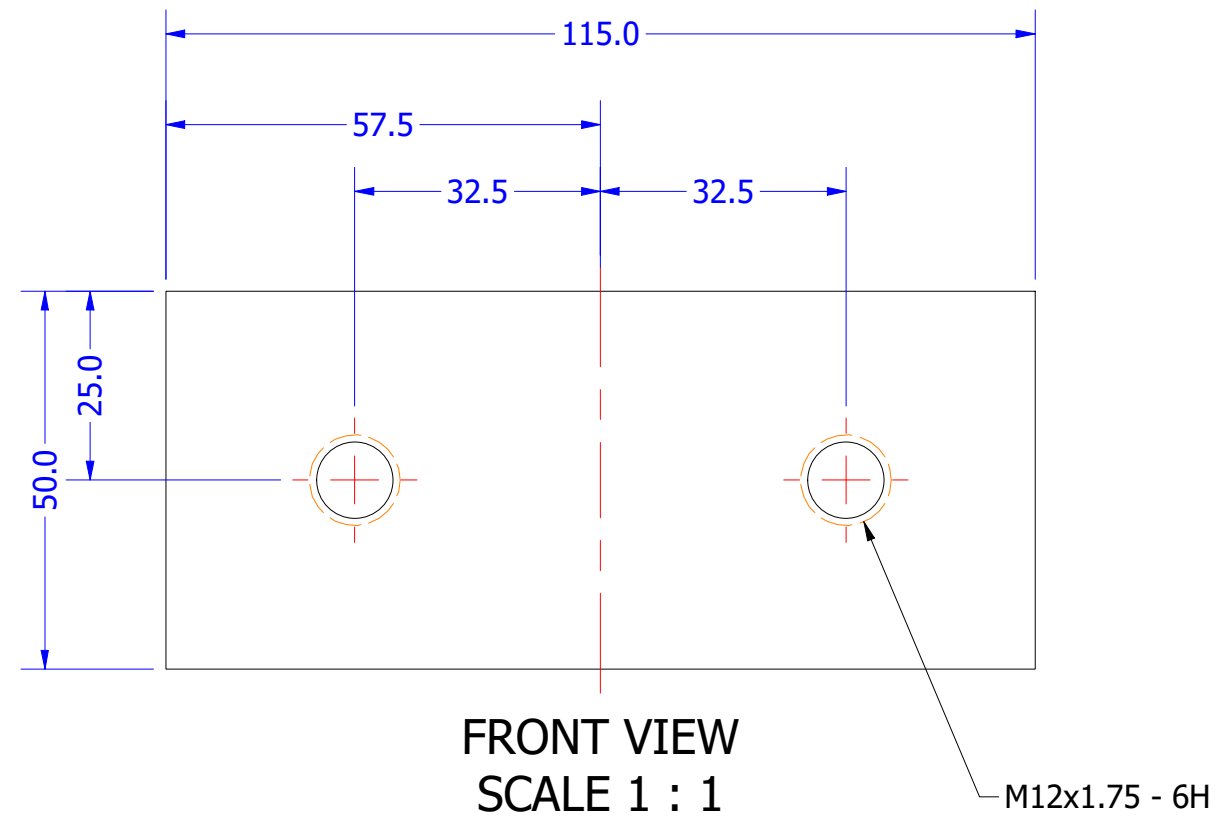


REMOVE ALL BURRS & SHARP EDGES



THESE DRAWINGS ARE THE PROPERTY OF ULTIMATE ENGINEERING AND SHOULD NOT BE REPRODUCED OR COPIED IN ANY WAY WITHOUT WRITTEN PERMISSION FROM ULTIMATE ENGINEERING

PAINT TREATMENT:

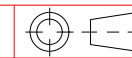

DIMENSION TOLERANCES	
DECIMAL	ANGULAR
X.X = ± .5 mm	X = ± 1'
X.XX = ± .25 mm	X.X = ± .5'
X.XXX = ± .125 mm	X.XX = ± .25'

MAXIMUM FINISHED SURFACE ROUGHNESS U.N.O. 1.6

PARENT ASSEMBLY

DRAWN: David Bilney

DESIGNED: David Bilney

DATE: 22/03/2021

CUSTOMER:

TITLE:

DWG NO:

JOB NO:

RAB ENGINEERING

P1948-001-10  
CHAIN CONVEYORS


194804

SCALE: Noted	SHEET 28 OF 48	SHEET SIZE: A3	REV: 2
-----------------	-------------------	-------------------	-----------

DO NOT SCALE DRAWING

12mm PLATE @ 87 X 40	Steel, Mild	AS3678 - GR250
DESCRIPTION	MATERIAL	COMMENTS

P1948-001-11 - 4 REQ'D AS DRAWN

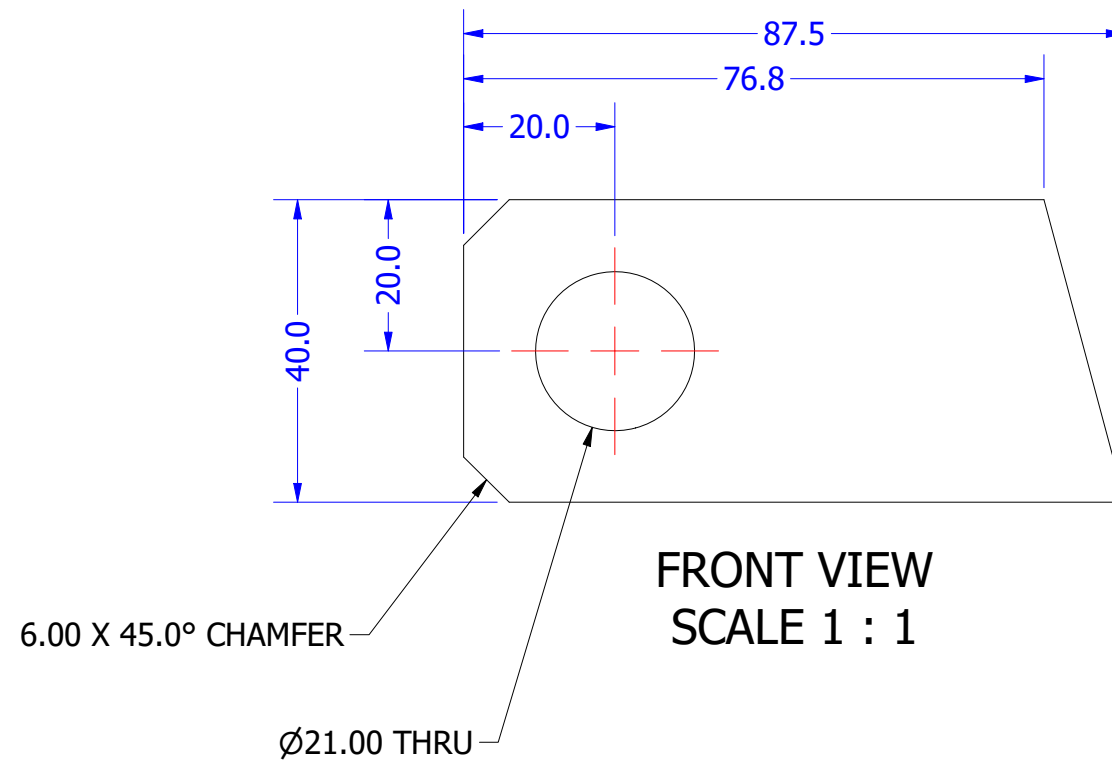


REMOVE ALL BURRS & SHARP EDGES



THESE DRAWINGS ARE THE PROPERTY OF ULTIMATE ENGINEERING AND SHOULD NOT BE REPRODUCED OR COPIED IN ANY WAY WITHOUT WRITTEN PERMISSION FROM ULTIMATE ENGINEERING

PAINT TREATMENT:

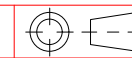

DIMENSION TOLERANCES	
DECIMAL	ANGULAR
X.X = ± .5 mm	X = ± 1°
X.XX = ± .25 mm	X.X = ± .5°
X.XXX = ± .125 mm	X.XX = ± .25°

MAXIMUM FINISHED SURFACE ROUGHNESS U.N.O. 1.6

PARENT ASSEMBLY

DRAWN: David Bilney

DESIGNED: David Bilney

DATE: 22/03/2021

CUSTOMER:

TITLE:

DWG NO:

JOB NO:

RAB ENGINEERING

P1948-001-11  
CHAIN CONVEYORS


194804

SCALE: Noted	SHEET 29 OF 48	SHEET SIZE: A3	REV: 2
-----------------	-------------------	-------------------	-----------

DO NOT SCALE DRAWING

50 RND BAR @ 880mm	Steel, Mild	AS1443 1040
DESCRIPTION	MATERIAL	COMMENTS

P1948-001-12 - 2 REQ'D AS DRAWN

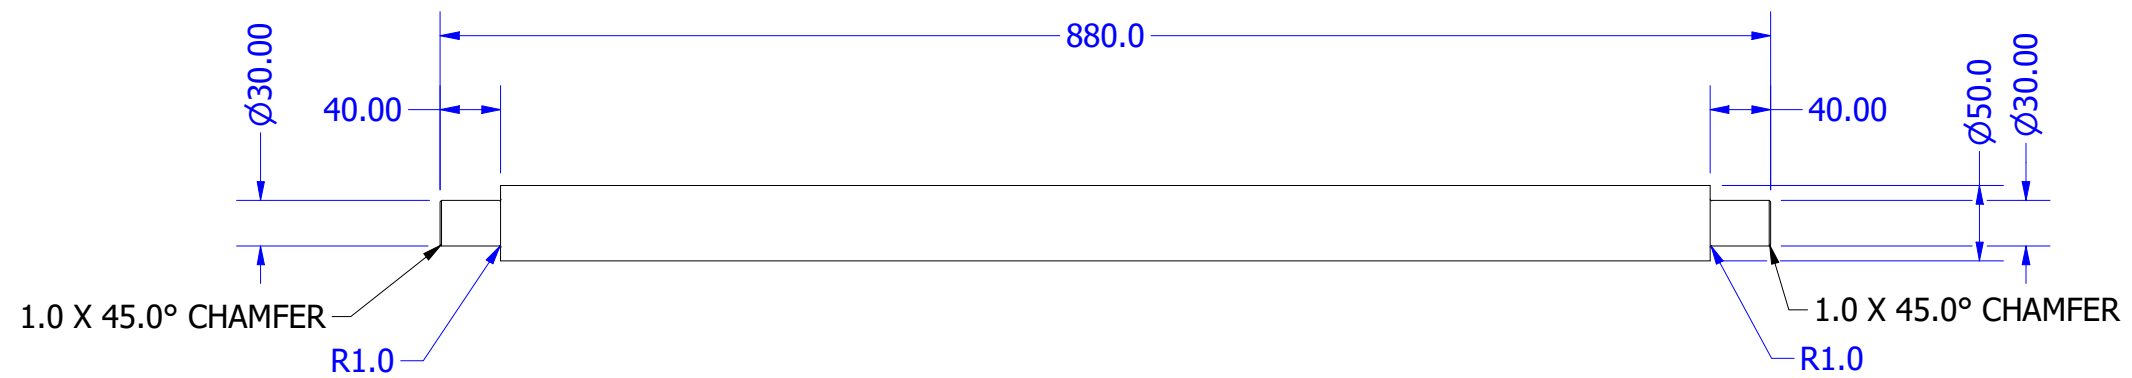


FRONT VIEW  
SCALE 1:5

REMOVE ALL BURRS & SHARP EDGES



THESE DRAWINGS ARE THE PROPERTY OF ULTIMATE ENGINEERING AND SHOULD NOT BE REPRODUCED OR COPIED IN ANY WAY WITHOUT WRITTEN PERMISSION FROM ULTIMATE ENGINEERING

PAINT TREATMENT:

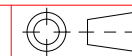

DIMENSION TOLERANCES	
DECIMAL	ANGULAR
X.X = ± .5 mm	X = ± 1°
X.XX = ± .25 mm	X.X = ± .5°
X.XXX = ± .125 mm	X.XX = ± .25°
MAXIMUM FINISHED SURFACE ROUGHNESS U.N.O. 1.6	

PARENT ASSEMBLY

CUSTOMER:

RAB ENGINEERING

DRAWN: David Bilney

TITLE:

P1948-001-12  
CHAIN CONVEYORS

DESIGNED: David Bilney

DWG NO:

194804

DATE: 22/03/2021

JOB NO:

SCALE:  
Noted

SHEET  
30 OF 48

SHEET SIZE:  
A3


REV:  
2



DO NOT SCALE DRAWING

10mm PLATE @ 65 X 40	Steel, Mild	AS3678 - GR250
DESCRIPTION	MATERIAL	COMMENTS

P1948-001-13 - 8 REQ'D AS DRAWN

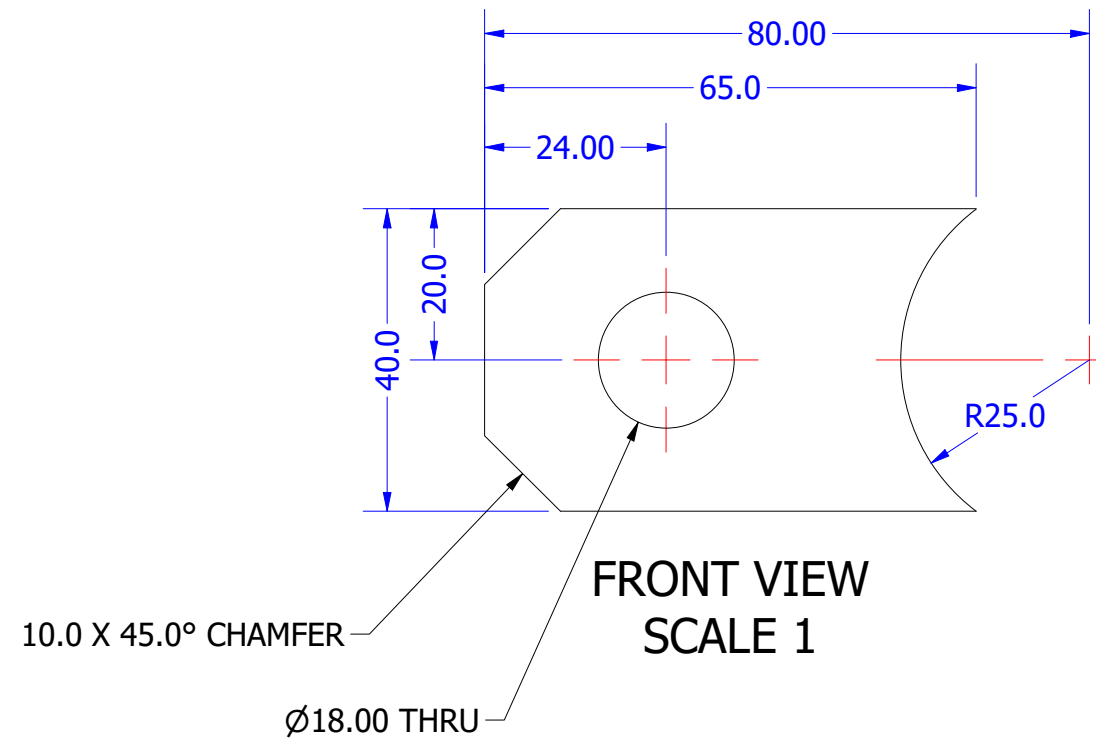


REMOVE ALL BURRS & SHARP EDGES



THESE DRAWINGS ARE THE PROPERTY OF ULTIMATE ENGINEERING AND SHOULD NOT BE REPRODUCED OR COPIED IN ANY WAY WITHOUT WRITTEN PERMISSION FROM ULTIMATE ENGINEERING

PAINT TREATMENT:

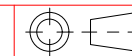

DIMENSION TOLERANCES	
DECIMAL	ANGULAR
X.X = ± .5 mm	X = ± 1°
X.XX = ± .25 mm	X.X = ± .5°
X.XXX = ± .125 mm	X.XX = ± .25°

MAXIMUM FINISHED SURFACE ROUGHNESS U.N.O. 1.6

PARENT ASSEMBLY

CUSTOMER:

RAB ENGINEERING

DRAWN: David Bilney

TITLE:

P1948-001-13  
CHAIN CONVEYORS

DESIGNED: David Bilney

DWG NO:

194804

DATE: 22/03/2021

JOB NO:

SCALE:  
Noted

SHEET  
31 OF 48


SHEET SIZE:  
A3

REV:  
2

DO NOT SCALE DRAWING

10mm PLATE @ 180 X 60	Steel, Mild	AS3678 - GR250
DESCRIPTION	MATERIAL	COMMENTS

P1948-001-14 - 2 REQ'D AS DRAWN

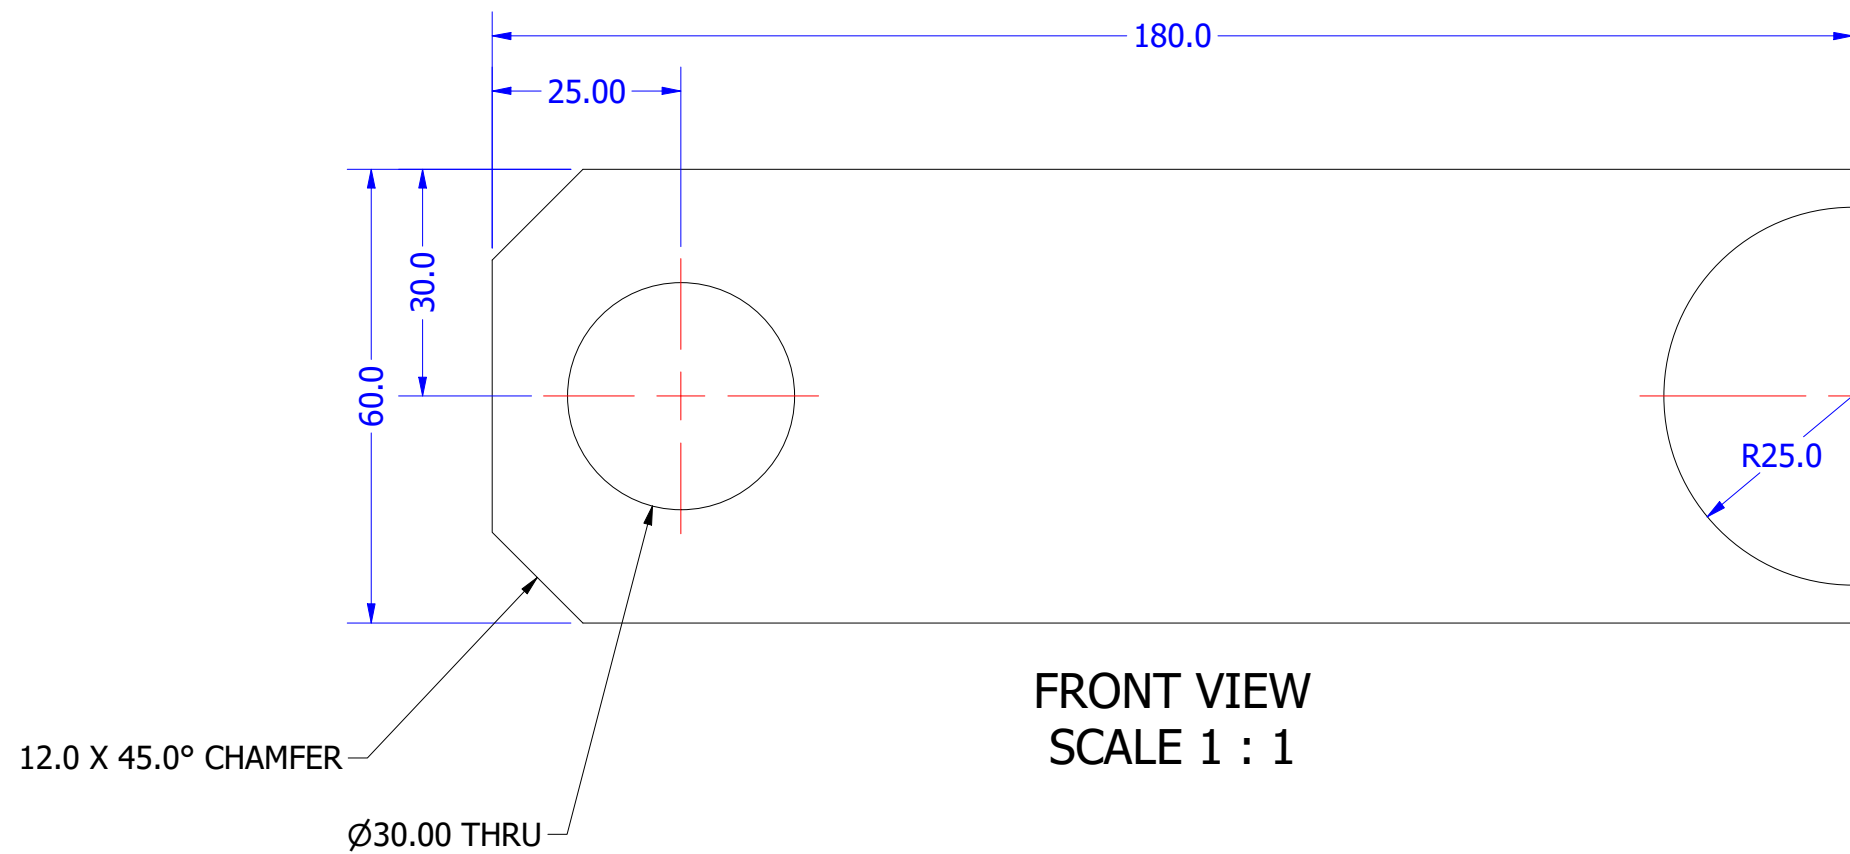


REMOVE ALL BURRS & SHARP EDGES



THESE DRAWINGS ARE THE PROPERTY OF ULTIMATE ENGINEERING AND SHOULD NOT BE REPRODUCED OR COPIED IN ANY WAY WITHOUT WRITTEN PERMISSION FROM ULTIMATE ENGINEERING

PAINT TREATMENT:

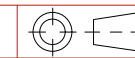

DIMENSION TOLERANCES	
DECIMAL	ANGULAR
X.X = ± .5 mm	X = ± 1°
X.XX = ± .25 mm	X.X = ± .5°
X.XXX = ± .125 mm	X.XX = ± .25°

MAXIMUM FINISHED SURFACE ROUGHNESS U.N.O. 1.6

PARENT ASSEMBLY

DRAWN: David Bilney

DESIGNED: David Bilney

DATE: 22/03/2021

CUSTOMER:

TITLE:

DWG NO:

JOB NO:

RAB ENGINEERING

P1948-001-14  
CHAIN CONVEYORS


194804

SCALE: Noted	SHEET 32 OF 48	SHEET SIZE: A3	REV: 2
-----------------	-------------------	-------------------	-----------

DO NOT SCALE DRAWING

10mm PLATE @ 100 X 37	Steel, Mild	AS3678 - GR250
DESCRIPTION	MATERIAL	COMMENTS

P1948-001-15 - 1 REQ'D AS DRAWN

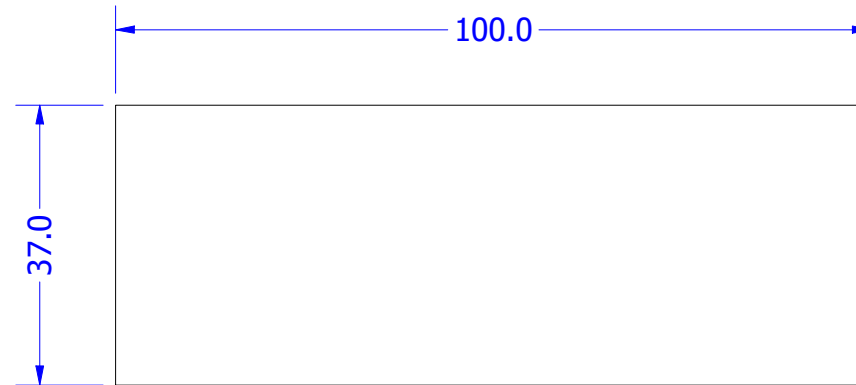


FRONT VIEW  
SCALE 1 : 1

REMOVE ALL BURRS & SHARP EDGES



THESE DRAWINGS ARE THE PROPERTY OF ULTIMATE ENGINEERING AND SHOULD NOT BE REPRODUCED OR COPIED IN ANY WAY WITHOUT WRITTEN PERMISSION FROM ULTIMATE ENGINEERING

PAINT TREATMENT:

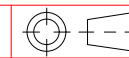

DIMENSION TOLERANCES	
DECIMAL	ANGULAR
X.X = ± .5 mm	X = ± 1°
X.XX = ± .25 mm	X.X = ± .5°
X.XXX = ± .125 mm	X.XX = ± .25°

MAXIMUM FINISHED SURFACE ROUGHNESS U.N.O. 1.6

PARENT ASSEMBLY

DRAWN: David Bilney

DESIGNED: David Bilney

DATE: 22/03/2021

CUSTOMER:

TITLE: P1948-001-15  
CHAIN CONVEYORS

DWG NO: 194804

JOB NO:

SCALE: Noted  
SHEET 33 OF 48


SHEET SIZE: A3  
REV: 2

DRAWN BY ULTIMATE ENGINEERING PTY LTD Ph 8562 1511

DO NOT SCALE DRAWING

16mm PLATE @ 170 X 60	Steel, Mild	AS3678 - GR250
DESCRIPTION	MATERIAL	COMMENTS

P1948-001-16 - 2 REQ'D AS DRAWN

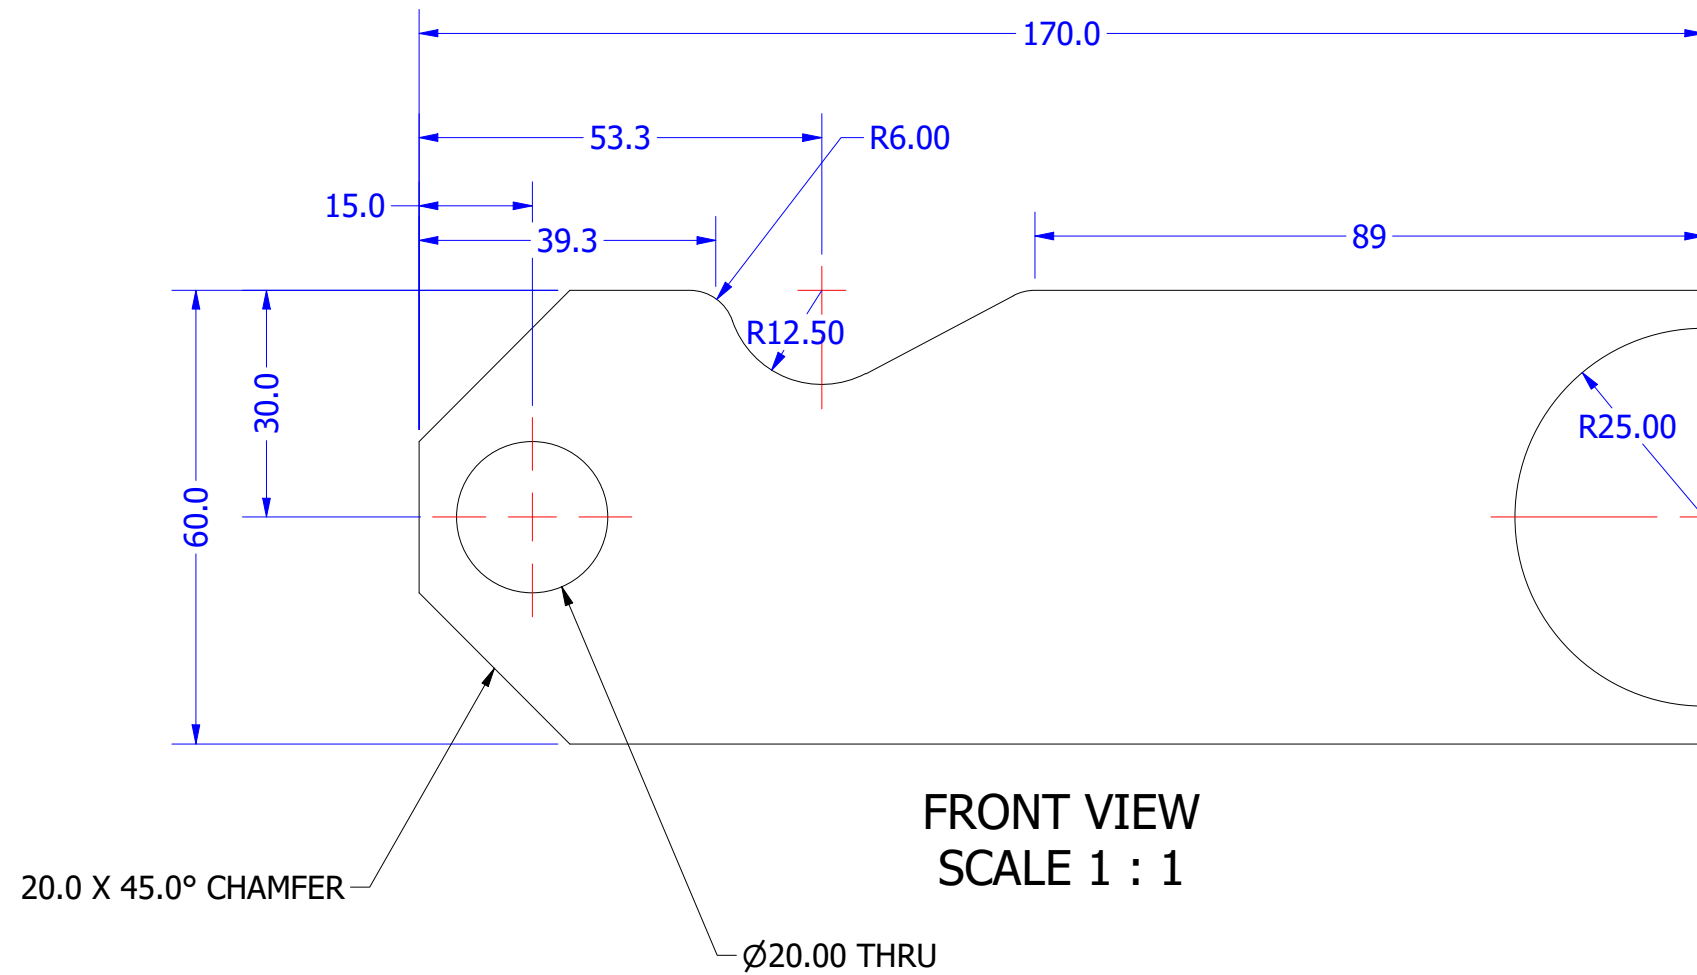


REMOVE ALL BURRS & SHARP EDGES



THESE DRAWINGS ARE THE PROPERTY OF ULTIMATE ENGINEERING AND SHOULD NOT BE REPRODUCED OR COPIED IN ANY WAY WITHOUT WRITTEN PERMISSION FROM ULTIMATE ENGINEERING

PAINT TREATMENT:

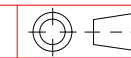

DIMENSION TOLERANCES	
DECIMAL	ANGULAR
X.X = ± .5 mm	X = ± 1°
X.XX = ± .25 mm	X.X = ± .5°
X.XXX = ± .125 mm	X.XX = ± .25°

MAXIMUM FINISHED SURFACE ROUGHNESS U.N.O. 1.6

PARENT ASSEMBLY

DRAWN: David Bilney

DESIGNED: David Bilney

DATE: 22/03/2021

CUSTOMER:

TITLE: P1948-001-16  
CHAIN CONVEYORS

DWG NO: 194804

JOB NO:

SCALE: Noted	SHEET 34 OF 48	SHEET SIZE: A3	REV: 2
--------------	----------------	----------------	--------


DO NOT SCALE DRAWING

20 RND BAR @ 1000mm	Steel, Mild	AS1443 - GR1040
DESCRIPTION	MATERIAL	COMMENTS

P1948-001-17 - 1 REQ'D AS DRAWN



ISO VIEW  
SCALE 1:5

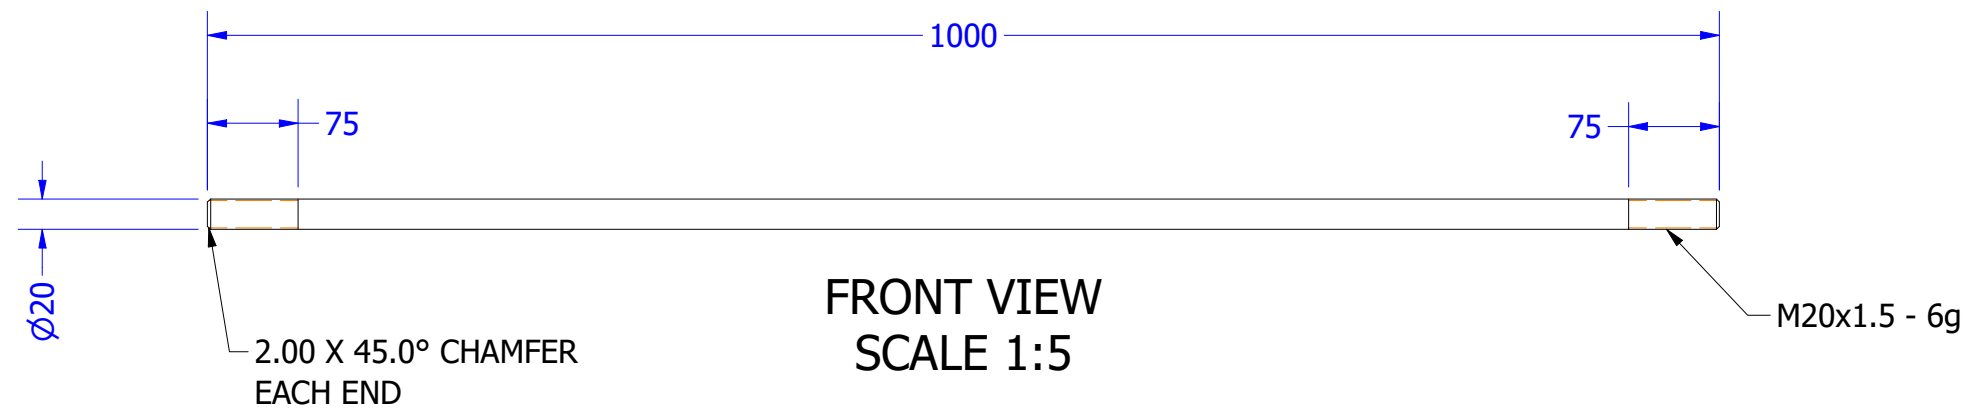


REMOVE ALL BURRS & SHARP EDGES



THESE DRAWINGS ARE THE PROPERTY OF ULTIMATE ENGINEERING AND SHOULD NOT BE REPRODUCED OR COPIED IN ANY WAY WITHOUT WRITTEN PERMISSION FROM ULTIMATE ENGINEERING

PAINT TREATMENT:

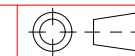

DIMENSION TOLERANCES	
DECIMAL	ANGULAR
X.X = ± .5 mm	X = ± 1°
X.XX = ± .25 mm	X.X = ± .5°
X.XXX = ± .125 mm	X.XX = ± .25°

MAXIMUM FINISHED SURFACE ROUGHNESS U.N.O. 1.6

PARENT ASSEMBLY

CUSTOMER: **RAB ENGINEERING**

DRAWN: David Bilney

TITLE: P1948-001-17  
CHAIN CONVEYORS

DESIGNED: David Bilney

DWG NO: **194804**

DATE: 22/03/2021


JOB NO:

SCALE: Noted	SHEET 35 OF 48	SHEET SIZE: A3	REV: 2
-----------------	-------------------	-------------------	-----------

DO NOT SCALE DRAWING

16mm PLATE @ 45 X 40	Steel, Mild	AS3678 - GR250
DESCRIPTION	MATERIAL	COMMENTS

P1948-001-26 - 1 REQ'D AS DRAWN

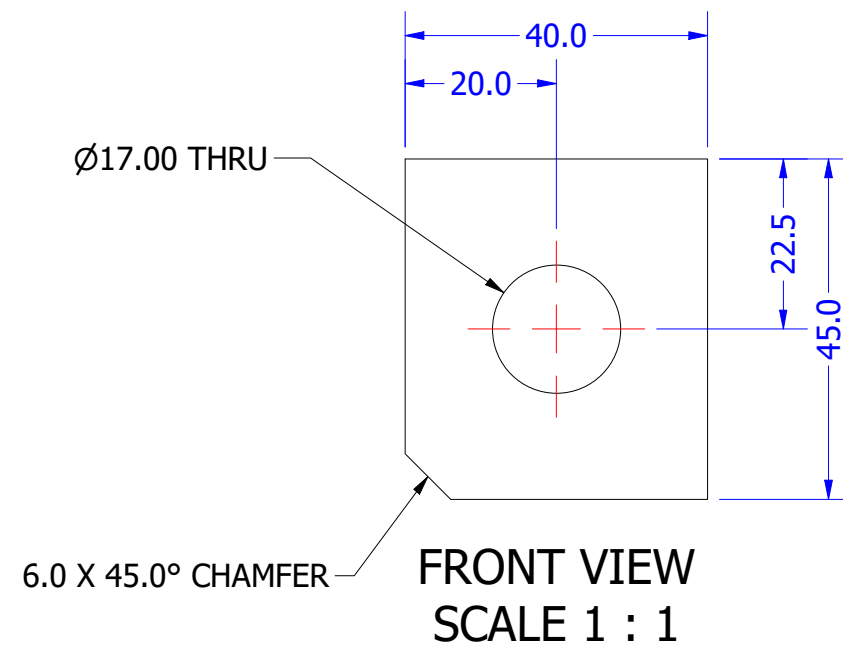


DRAWN BY ULTIMATE ENGINEERING PTY LTD Ph 8562 1511



THESE DRAWINGS ARE THE PROPERTY OF ULTIMATE ENGINEERING AND SHOULD NOT BE REPRODUCED OR COPIED IN ANY WAY WITHOUT WRITTEN PERMISSION FROM ULTIMATE ENGINEERING

PAINT TREATMENT:

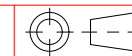

DIMENSION TOLERANCES	
DECIMAL	ANGULAR
X.X = ± .5 mm	X = ± 1°
X.XX = ± .25 mm	X.X = ± .5°
X.XXX = ± .125 mm	X.XX = ± .25°

MAXIMUM FINISHED SURFACE ROUGHNESS U.N.O. 1.6

PARENT ASSEMBLY

DRAWN: David Bilney

DESIGNED: David Bilney

DATE: 22/03/2021

CUSTOMER:

TITLE:

DWG NO:

JOB NO:

REMOVE ALL BURRS & SHARP EDGES

**RAB ENGINEERING**

P1948-001-26  
CHAIN CONVEYORS

**194804**


SCALE: Noted	SHEET 36 OF 48	SHEET SIZE: A3	REV: 2
-----------------	-------------------	-------------------	-----------




DO NOT SCALE DRAWING

12mm PLATE @ 120 X 40	Steel, Mild	AS3678 - GR250
DESCRIPTION	MATERIAL	COMMENTS

P1948-001-27 - 1 REQ'D AS DRAWN

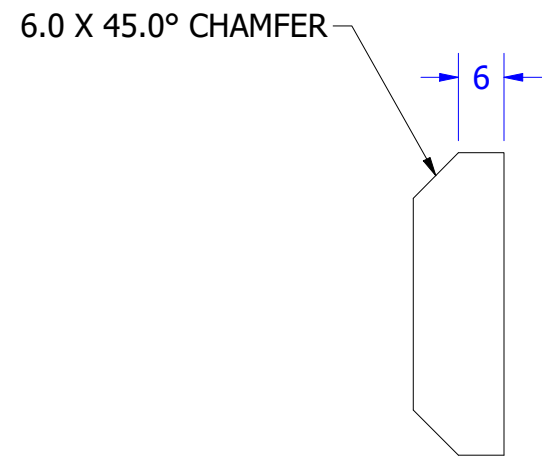

SIDE VIEW  
SCALE 1 : 1

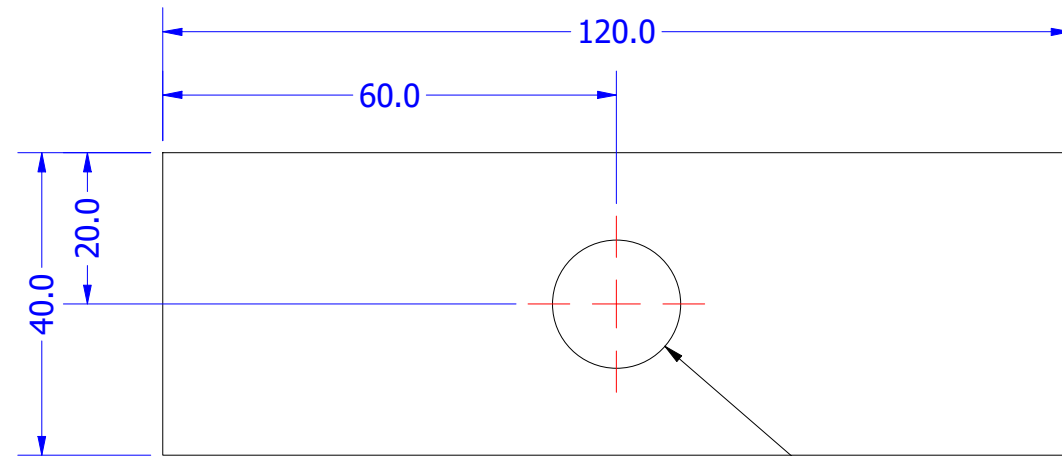

FRONT VIEW  
SCALE 1 : 1

DRAWN BY ULTIMATE ENGINEERING PTY LTD Ph 8562 1511



THESE DRAWINGS ARE THE PROPERTY OF ULTIMATE ENGINEERING AND SHOULD NOT BE REPRODUCED OR COPIED IN ANY WAY WITHOUT WRITTEN PERMISSION FROM ULTIMATE ENGINEERING

PAINT TREATMENT:



DIMENSION TOLERANCES	
DECIMAL	ANGULAR
X.X = ± .5 mm	X = ± 1°
X.XX = ± .25 mm	X.X = ± .5°
X.XXX = ± .125 mm	X.XX = ± .25°

MAXIMUM FINISHED SURFACE ROUGHNESS U.N.O. 1.6

PARENT ASSEMBLY

CUSTOMER: **RAB ENGINEERING**

DRAWN: David Bilney

TITLE: P1948-001-27  
CHAIN CONVEYORS

DESIGNED: David Bilney

DWG NO: **194804**

DATE: 22/03/2021


JOB NO:	SCALE: Noted	SHEET 37 OF 48	SHEET SIZE: A3	REV: 2
---------	--------------	----------------	----------------	--------

REMOVE ALL BURRS & SHARP EDGES

DO NOT SCALE DRAWING

6mm PLATE @ 200 X 60	Steel, Mild	AS3678 - GR250
DESCRIPTION	MATERIAL	COMMENTS

P1948-001-28 - 4 REQ'D AS DRAWN

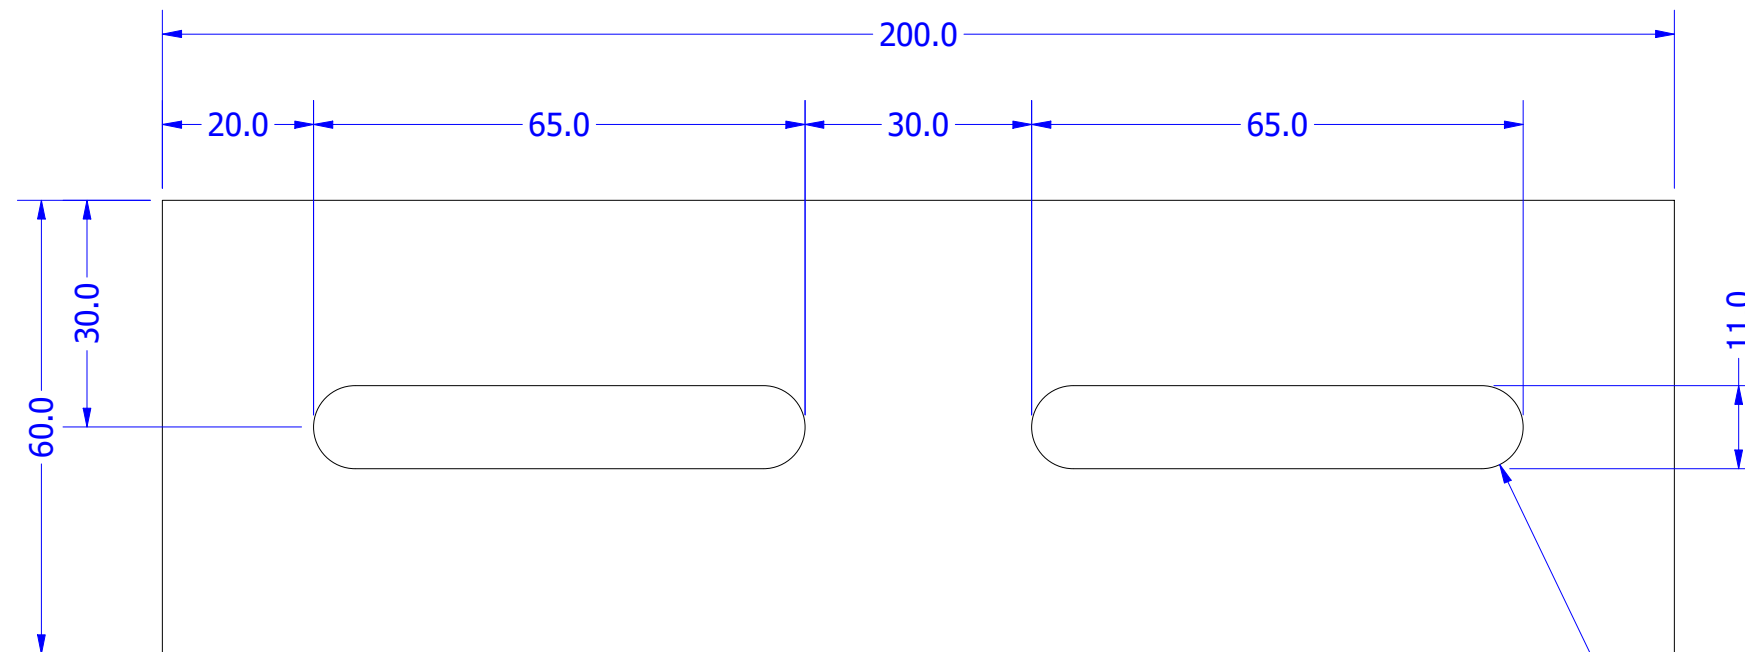

FRONT VIEW  
SCALE 1


R5.5

REMOVE ALL BURRS & SHARP EDGES



THESE DRAWINGS ARE THE PROPERTY OF ULTIMATE ENGINEERING AND SHOULD NOT BE REPRODUCED OR COPIED IN ANY WAY WITHOUT WRITTEN PERMISSION FROM ULTIMATE ENGINEERING

PAINT TREATMENT:

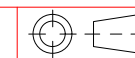

DIMENSION TOLERANCES	
DECIMAL	ANGULAR
X.X = ± .5 mm	X = ± 1°
X.XX = ± .25 mm	X.X = ± .5°
X.XXX = ± .125 mm	X.XX = ± .25°

MAXIMUM FINISHED SURFACE ROUGHNESS U.N.O. 1.6

PARENT ASSEMBLY

CUSTOMER:

RAB ENGINEERING

DRAWN: David Bilney

TITLE:

P1948-001-28  
CHAIN CONVEYORS

DESIGNED: David Bilney

DWG NO:

194804

DATE: 22/03/2021

JOB NO:

SCALE:  
Noted

SHEET  
38 OF 48

SHEET SIZE:  
A3


REV:  
2

DRAWN BY ULTIMATE ENGINEERING PTY LTD Ph 8562 1511


DO NOT SCALE DRAWING

6mm PLATE @ 400 X 283	Steel, Mild	AS3678 - GR250
DESCRIPTION	MATERIAL	COMMENTS

P1948-004-01 - 2 REQ'D AS DRAWN

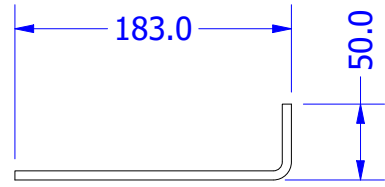

FOLDED SECTION  
SCALE 1:5

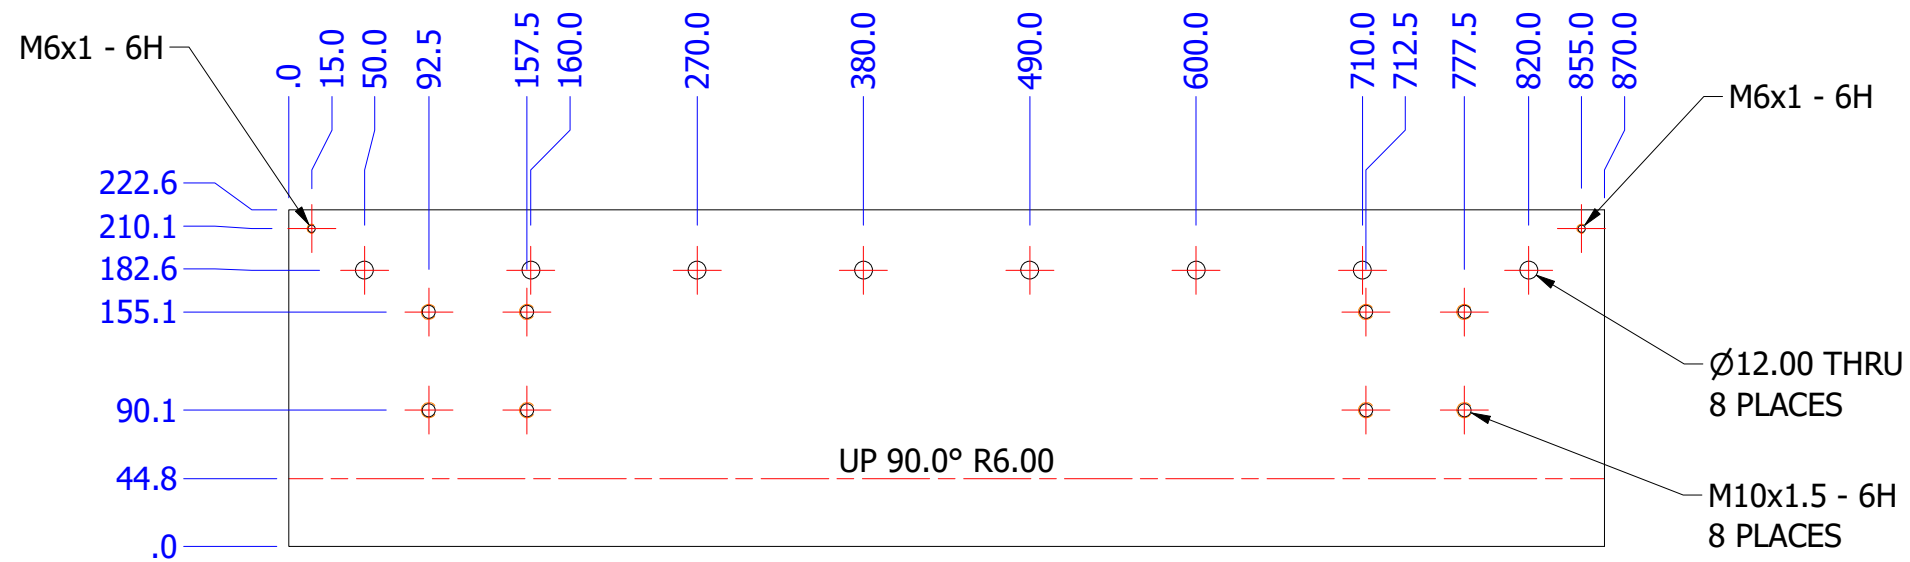


FLAT PATTERN  
SCALE 1:5

REMOVE ALL BURRS & SHARP EDGES



THESE DRAWINGS ARE THE PROPERTY OF ULTIMATE ENGINEERING AND SHOULD NOT BE REPRODUCED OR COPIED IN ANY WAY WITHOUT WRITTEN PERMISSION FROM ULTIMATE ENGINEERING

PAINT TREATMENT:

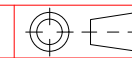

DIMENSION TOLERANCES	
DECIMAL	ANGULAR
X.X = ± .5 mm	X = ± 1°
X.XX = ± .25 mm	X.X = ± .5°
X.XXX = ± .125 mm	X.XX = ± .25°
MAXIMUM FINISHED SURFACE ROUGHNESS U.N.O. 1.6	

PARENT ASSEMBLY

DRAWN: David Bilney

DESIGNED: David Bilney

DATE: 22/03/2021

CUSTOMER:

TITLE:

DWG NO:

JOB NO:

RAB ENGINEERING

P1948-004-01  
CHAIN CONVEYORS


194804

SCALE: Noted	SHEET 39 OF 48	SHEET SIZE: A3	REV: 2
-----------------	-------------------	-------------------	-----------


DO NOT SCALE DRAWING

6mm PLATE @ 300 X 283	Steel, Mild	AS3678 - GR250
DESCRIPTION	MATERIAL	COMMENTS

P1948-004-02 - 2 REQ'D AS DRAWN

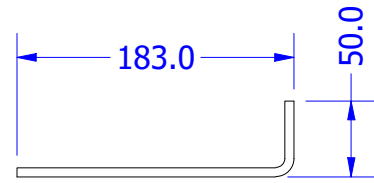

FOLDED SECTION  
SCALE 1:5

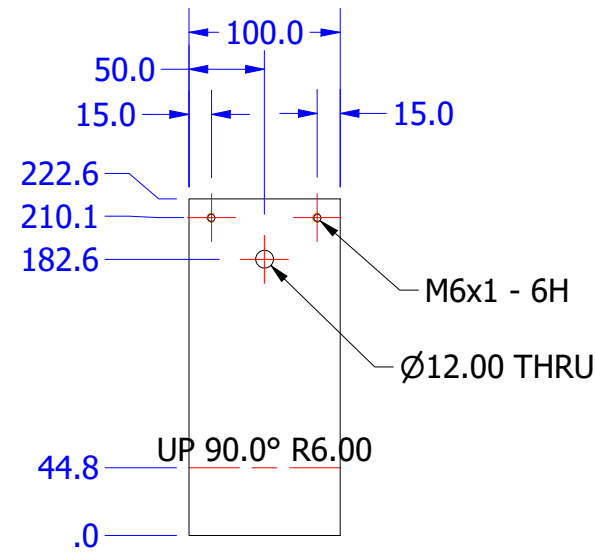


FLAT PATTERN  
SCALE 1:5

REMOVE ALL BURRS & SHARP EDGES



THESE DRAWINGS ARE THE PROPERTY OF ULTIMATE ENGINEERING AND SHOULD NOT BE REPRODUCED OR COPIED IN ANY WAY WITHOUT WRITTEN PERMISSION FROM ULTIMATE ENGINEERING

PAINT TREATMENT:

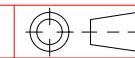

DIMENSION TOLERANCES  
DECIMAL ANGULAR  
X.X = ± .5 mm X = ± 1°  
X.XX = ± .25 mm X.X = ± .5°  
X.XXX = ± .125 mm X.XX = ± .25°  
MAXIMUM FINISHED SURFACE ROUGHNESS U.N.O. 1.6

PARENT ASSEMBLY

DRAWN: David Bilney

DESIGNED: David Bilney

DATE: 22/03/2021

CUSTOMER:

TITLE:

DWG NO:

JOB NO:

RAB ENGINEERING

P1948-004-02  
CHAIN CONVEYORS


194804

SCALE: Noted	SHEET 40 OF 48	SHEET SIZE: A3	REV: 2
-----------------	-------------------	-------------------	-----------


DO NOT SCALE DRAWING

6mm PLATE @ 300 X 283	Steel, Mild	AS3678 - GR250
DESCRIPTION	MATERIAL	COMMENTS

P1948-004-03 - 2 REQ'D AS DRAWN

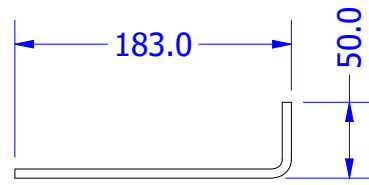

FOLDED SECTION  
SCALE 1:5

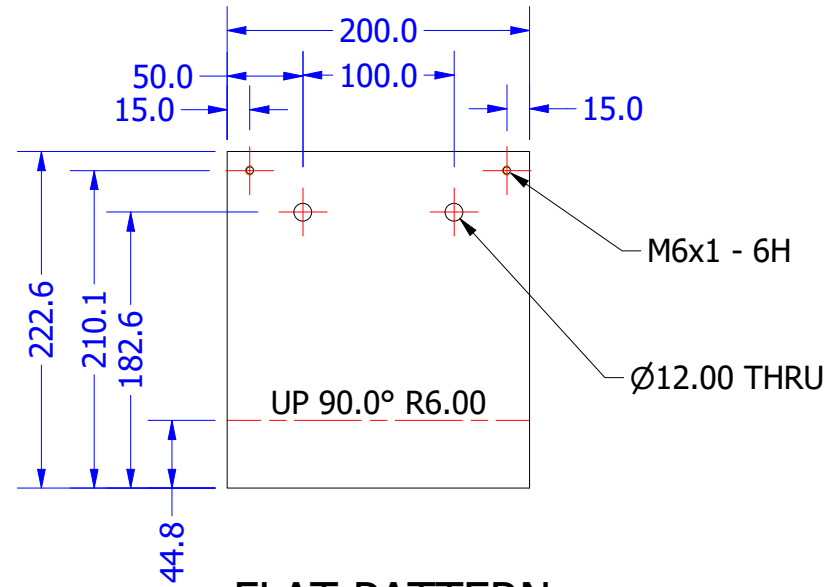

FLAT PATTERN  
SCALE 1:5

REMOVE ALL BURRS & SHARP EDGES



THESE DRAWINGS ARE THE PROPERTY OF ULTIMATE ENGINEERING AND SHOULD NOT BE REPRODUCED OR COPIED IN ANY WAY WITHOUT WRITTEN PERMISSION FROM ULTIMATE ENGINEERING

PAINT TREATMENT:



DIMENSION TOLERANCES	
DECIMAL	ANGULAR
X.X = ± .5 mm	X = ± 1°
X.XX = ± .25 mm	X.X = ± .5°
X.XXX = ± .125 mm	X.XX = ± .25°

MAXIMUM FINISHED SURFACE ROUGHNESS U.N.O. 1.6

PARENT ASSEMBLY

CUSTOMER:

RAB ENGINEERING

DRAWN: David Bilney

TITLE:

P1948-004-03  
CHAIN CONVEYORS

DESIGNED: David Bilney

DWG NO:

194804

DATE: 22/03/2021

JOB NO:

SCALE:  
Noted

SHEET  
41 OF 48


SHEET SIZE:  
A3

REV:  
2

DO NOT SCALE DRAWING

60 RND BAR @ 30mm	Steel, Mild	AS1444-1996 - 4140
DESCRIPTION	MATERIAL	COMMENTS


P1948-004-05 - 7 REQ'D AS DRAWN

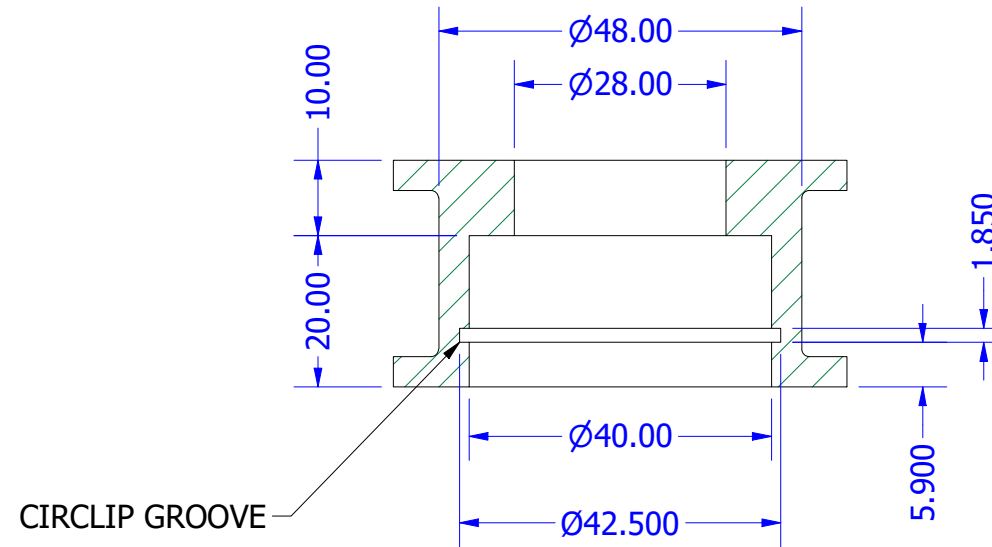


SECTION C-C  
SCALE 1 : 1



ISO VIEW  
SCALE 1 : 1

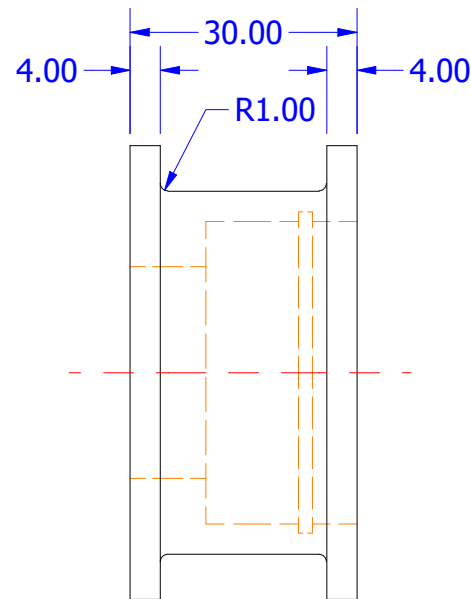

SIDE VIEW  
SCALE 1 : 1

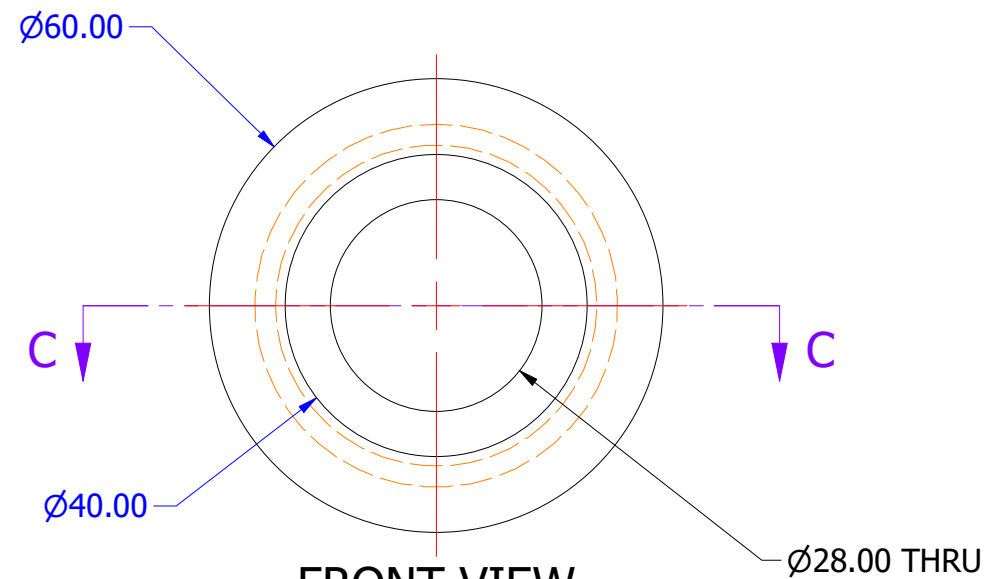


FRONT VIEW  
SCALE 1 : 1

REMOVE ALL BURRS & SHARP EDGES



THESE DRAWINGS ARE THE PROPERTY OF ULTIMATE ENGINEERING AND SHOULD NOT BE REPRODUCED OR COPIED IN ANY WAY WITHOUT WRITTEN PERMISSION FROM ULTIMATE ENGINEERING

PAINT TREATMENT:

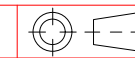

DIMENSION TOLERANCES	
DECIMAL	ANGULAR
X.X = ± .5 mm	X = ± 1°
X.XX = ± .25 mm	X.X = ± .5°
X.XXX = ± .125 mm	X.XX = ± .25°

MAXIMUM FINISHED SURFACE ROUGHNESS U.N.O. 1.6

PARENT ASSEMBLY

CUSTOMER:

RAB ENGINEERING

DRAWN: David Bilney

TITLE:

P1948-004-05  
CHAIN CONVEYORS

DESIGNED: David Bilney

DWG NO:

194804

DATE: 22/03/2021

JOB NO:

SCALE:  
Noted

SHEET  
42 OF 48

SHEET SIZE:  
A3

REV:  
2




DO NOT SCALE DRAWING

27 RND BAR @ 20	Steel, Mild	AS1443 - 1040
DESCRIPTION	MATERIAL	COMMENTS


P1948-004-06 - 7 REQ'D AS DRAWN



ISO VIEW  
SCALE 1 : 1

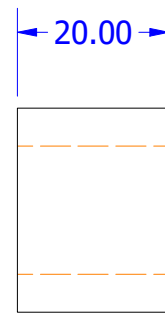

SIDE VIEW  
SCALE 1 : 1

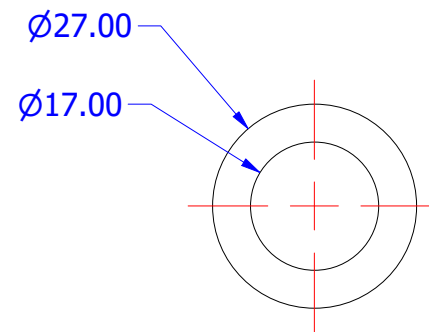


FRONT VIEW  
SCALE 1 : 1

REMOVE ALL BURRS & SHARP EDGES



THESE DRAWINGS ARE THE PROPERTY OF ULTIMATE ENGINEERING AND SHOULD NOT BE REPRODUCED OR COPIED IN ANY WAY WITHOUT WRITTEN PERMISSION FROM ULTIMATE ENGINEERING

PAINT TREATMENT: ZINC PLATE

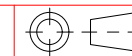

DIMENSION TOLERANCES	
DECIMAL	ANGULAR
X.X = ± .5 mm	X = ± 1°
X.XX = ± .25 mm	X.X = ± .5°
X.XXX = ± .125 mm	X.XX = ± .25°
MAXIMUM FINISHED SURFACE ROUGHNESS U.N.O. 1.6	

PARENT ASSEMBLY

DRAWN: David Bilney

DESIGNED: David Bilney

DATE: 22/03/2021

CUSTOMER: **RAB ENGINEERING**

TITLE: P1948-004-06  
CHAIN CONVEYORS

DWG NO: **194804**

JOB NO:	SCALE: Noted	SHEET 43 OF 48	SHEET SIZE: A3	REV: 2
---------	--------------	----------------	----------------	--------


DRAWN BY ULTIMATE ENGINEERING PTY LTD Ph 8562 1511




DO NOT SCALE DRAWING

3mm PLATE @ 248 X 128	Steel, Mild	AS1594 - GR250
DESCRIPTION	MATERIAL	COMMENTS


P1948-004-08 - 1 REQ'D AS DRAWN

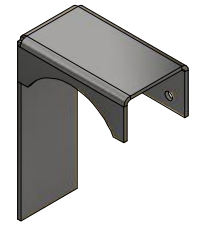


ISO VIEW  
SCALE 1:5

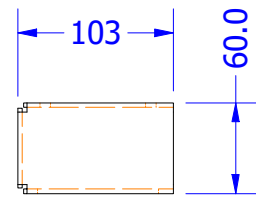


PLAN VIEW  
SCALE 1:5

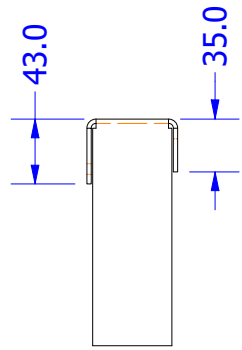


SIDE VIEW  
SCALE 1:5

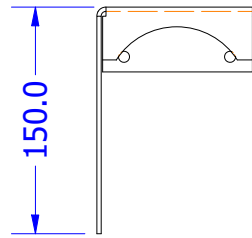

FRONT VIEW  
SCALE 1:5

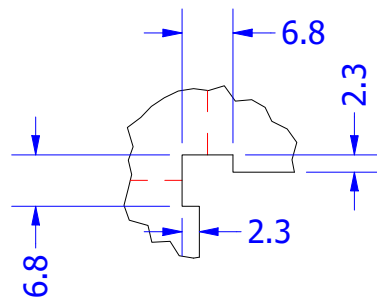

DETAIL E  
SCALE 1 : 1

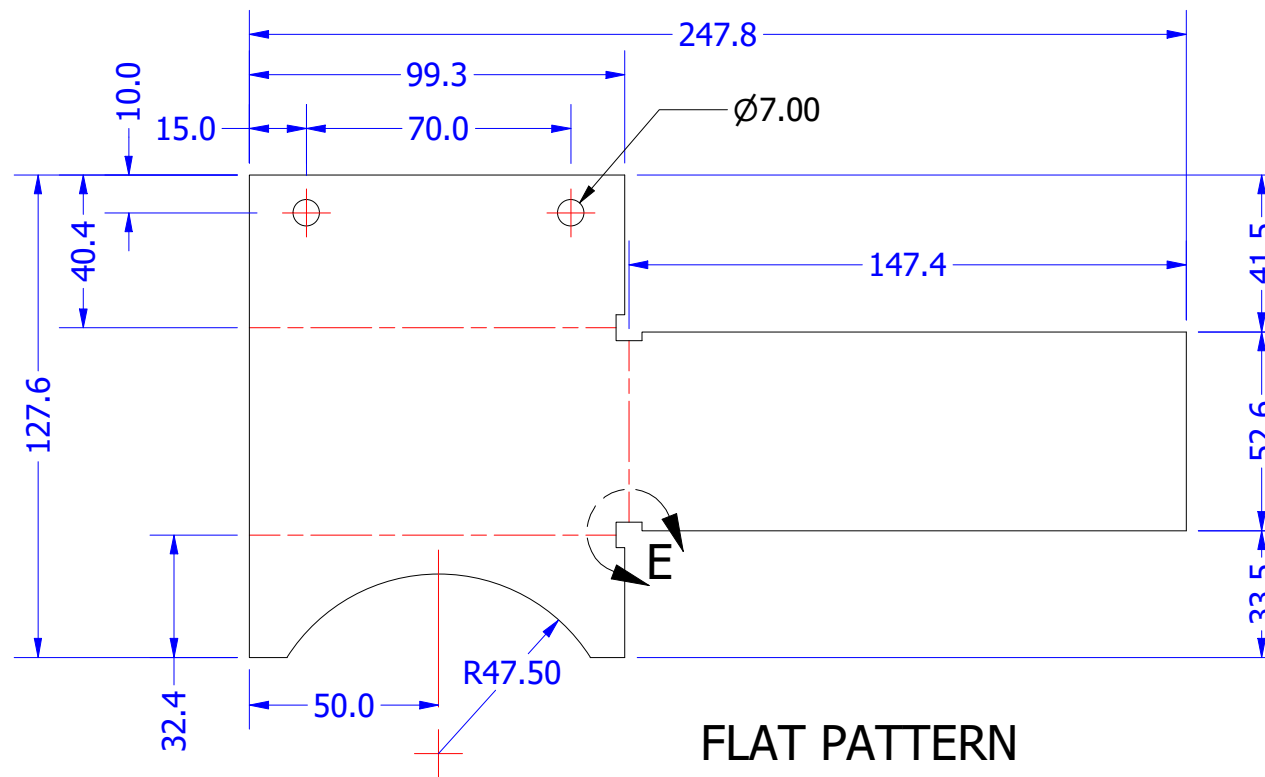


FLAT PATTERN  
ALL BENDS UP 90°  
SCALE 1:2

REMOVE ALL BURRS & SHARP EDGES



THESE DRAWINGS ARE THE PROPERTY OF ULTIMATE ENGINEERING AND SHOULD NOT BE REPRODUCED OR COPIED IN ANY WAY WITHOUT WRITTEN PERMISSION FROM ULTIMATE ENGINEERING

PAINT TREATMENT: TBA

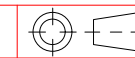

DIMENSION TOLERANCES	
DECIMAL	ANGULAR
X.X = ± .5 mm	X = ± 1°
X.XX = ± .25 mm	X.X = ± .5°
X.XXX = ± .125 mm	X.XX = ± .25°


MAXIMUM FINISHED SURFACE ROUGHNESS U.N.O. 1.6

PARENT ASSEMBLY	CUSTOMER:	<b>RAB ENGINEERING</b>			
DRAWN: David Bilney	TITLE:	P1948-004-08 CHAIN CONVEYORS			
DESIGNED: David Bilney	DWG NO:	<b>194804</b>			
DATE: 22/03/2021	JOB NO:	SCALE: Noted	SHEET 45 OF 48	SHEET SIZE: A3	REV: 2

DO NOT SCALE DRAWING

3mm PLATE @ 870 X 128	Steel, Mild	AS1594 - GR250
DESCRIPTION	MATERIAL	COMMENTS


P1948-004-09 - 1 REQ'D AS DRAWN

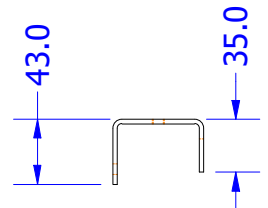


END VIEW  
SCALE 1:5




PLAN VIEW  
SCALE 1:5

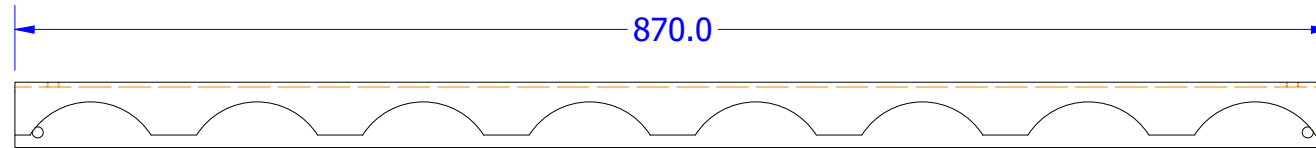

FRONT VIEW  
SCALE 1:5

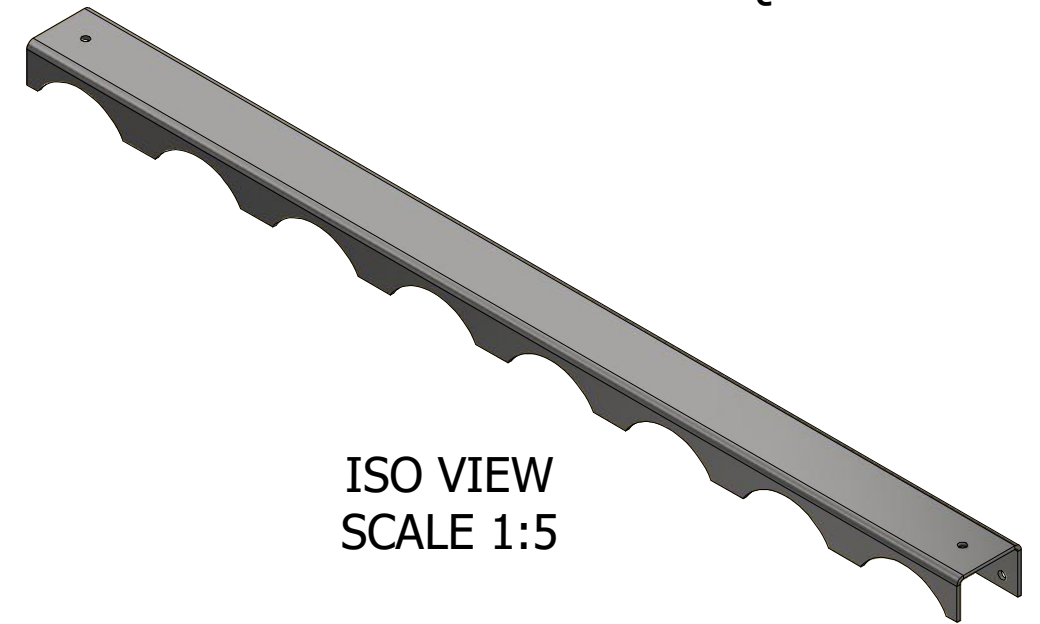

ISO VIEW  
SCALE 1:5

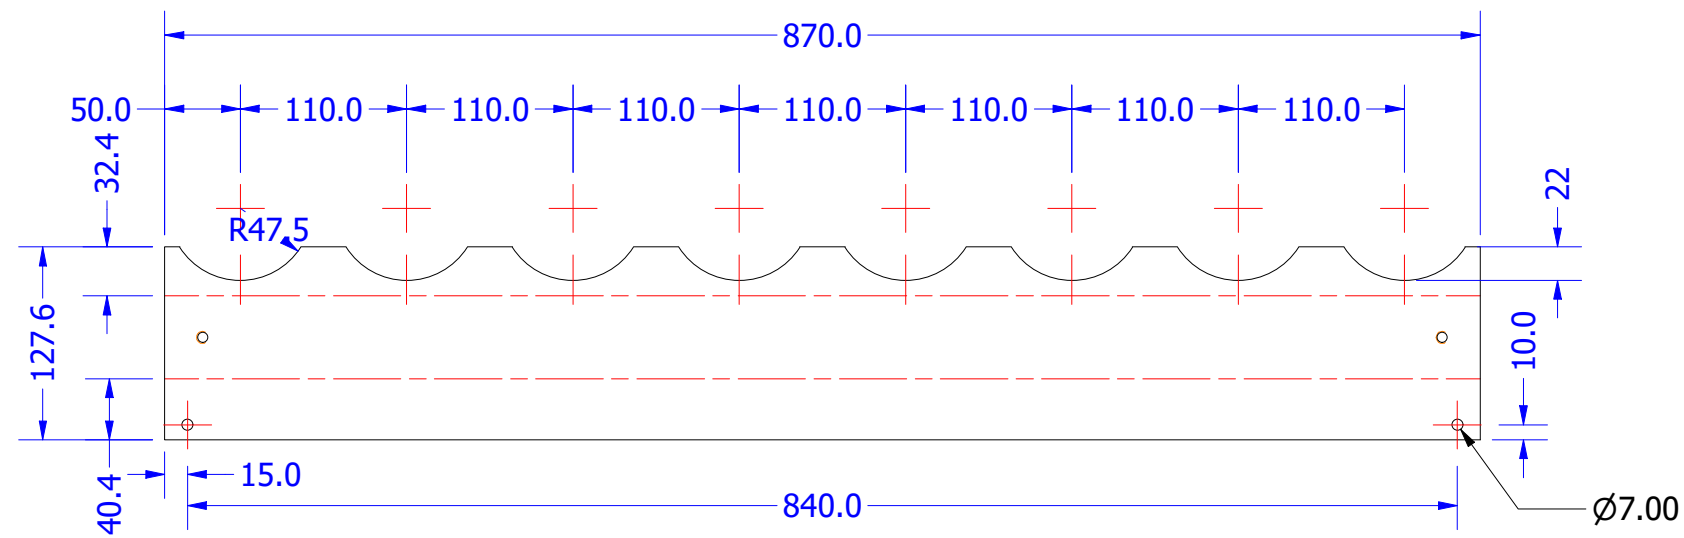

FLAT PATTERN  
ALL BENDS UP 90°  
SCALE 1:5

REMOVE ALL BURRS & SHARP EDGES



THESE DRAWINGS ARE THE PROPERTY OF ULTIMATE ENGINEERING AND SHOULD NOT BE REPRODUCED OR COPIED IN ANY WAY WITHOUT WRITTEN PERMISSION FROM ULTIMATE ENGINEERING

PAINT TREATMENT: TBA



DIMENSION TOLERANCES	
DECIMAL	ANGULAR
X.X = ± .5 mm	X = ± 1°
X.XX = ± .25 mm	X.X = ± .5°
X.XXX = ± .125 mm	X.XX = ± .25°

MAXIMUM FINISHED SURFACE ROUGHNESS U.N.O. 1.6

PARENT ASSEMBLY

CUSTOMER: RAB ENGINEERING

DRAWN: David Bilney

TITLE: P1948-004-09  
CHAIN CONVEYORS

DESIGNED: David Bilney

DWG NO: 194804


DATE: 22/03/2021

JOB NO:	SCALE: Noted	SHEET 46 OF 48	SHEET SIZE: A3	REV: 2
---------	--------------	----------------	----------------	--------

DO NOT SCALE DRAWING

12mm PLATE @ 125 X 125	Steel, Mild	AS3678 - GR250
DESCRIPTION	MATERIAL	COMMENTS

P1948-004-10 - 2 REQ'D AS DRAWN

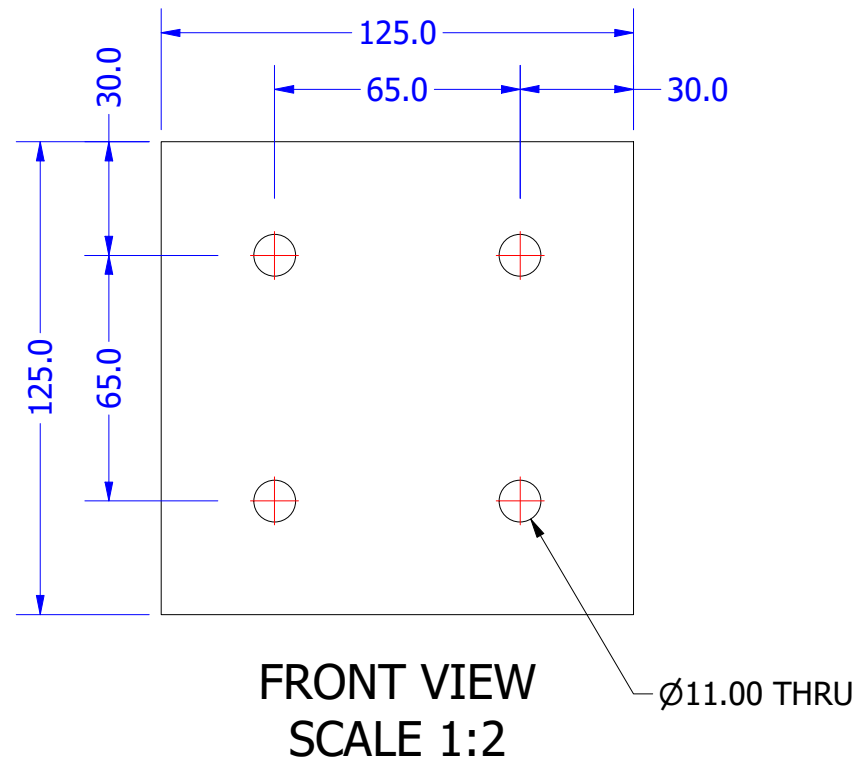


REMOVE ALL BURRS & SHARP EDGES



THESE DRAWINGS ARE THE PROPERTY OF ULTIMATE ENGINEERING AND SHOULD NOT BE REPRODUCED OR COPIED IN ANY WAY WITHOUT WRITTEN PERMISSION FROM ULTIMATE ENGINEERING

PAINT TREATMENT:

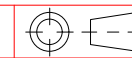

DIMENSION TOLERANCES	
DECIMAL	ANGULAR
X.X = ± .5 mm	X = ± 1°
X.XX = ± .25 mm	X.X = ± .5°
X.XXX = ± .125 mm	X.XX = ± .25°

MAXIMUM FINISHED SURFACE ROUGHNESS U.N.O. 1.6

PARENT ASSEMBLY

DRAWN: David Bilney

DESIGNED: David Bilney

DATE: 22/03/2021

CUSTOMER:

TITLE: P1948-004-10  
CHAIN CONVEYORS

DWG NO: 194804


JOB NO:

SCALE: Noted	SHEET 47 OF 48	SHEET SIZE: A3	REV: 2
-----------------	-------------------	-------------------	-----------

DO NOT SCALE DRAWING

30x10 FLAT @ 870mm	HDPE	
DESCRIPTION	MATERIAL	COMMENTS

P1948-004-12 - 1 REQ'D AS DRAWN

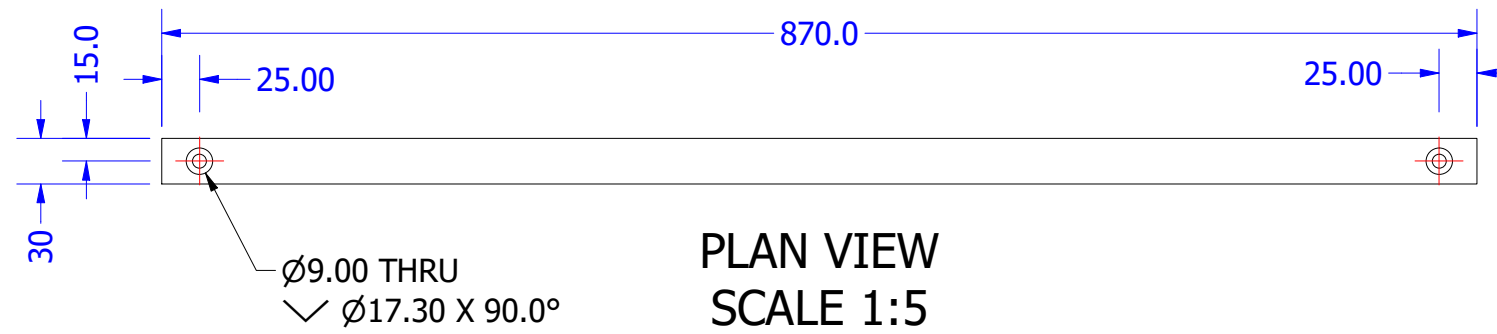


REMOVE ALL BURRS & SHARP EDGES



THESE DRAWINGS ARE THE PROPERTY OF ULTIMATE ENGINEERING AND SHOULD NOT BE REPRODUCED OR COPIED IN ANY WAY WITHOUT WRITTEN PERMISSION FROM ULTIMATE ENGINEERING

PAINT TREATMENT:

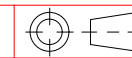

DIMENSION TOLERANCES	
DECIMAL	ANGULAR
X.X = $\pm .5$ mm	X = $\pm 1'$
X.XX = $\pm .25$ mm	X.X = $\pm .5'$
X.XXX = $\pm .125$ mm	X.XX = $\pm .25'$
MAXIMUM FINISHED SURFACE ROUGHNESS U.N.O. $\surd 1.6$	

PARENT ASSEMBLY

DRAWN: David Bilney

DESIGNED: David Bilney

DATE: 22/03/2021

CUSTOMER: **RAB ENGINEERING**

TITLE: P1948-004-12  
CHAIN CONVEYORS

DWG NO: **194804**

JOB NO:

SCALE: Noted	SHEET 48 OF 48	SHEET SIZE: A3	REV: 2
-----------------	-------------------	-------------------	-----------


DRAWN BY ULTIMATE ENGINEERING PTY LTD Ph 8562 1511



DO NOT SCALE DRAWING

5	AS 1110 - M10 x 35	Steel, Mild	HEX HEAD BOLT	4
4	AS 1968 - 1976 - 10	Steel, Mild	SPRING WASHER	4
3	A1948-005-01	ASSEMBLY	194800	2
2	W1948-006-02	WELDMENT	SHEET 3	1
1	W1948-006-01	WELDMENT	SHEET 2	1
ITEM	PART NUMBER	MATERIAL	COMMENTS	ITEM QTY

A1948-006-01 - 3 REQ'D AS DRAWN

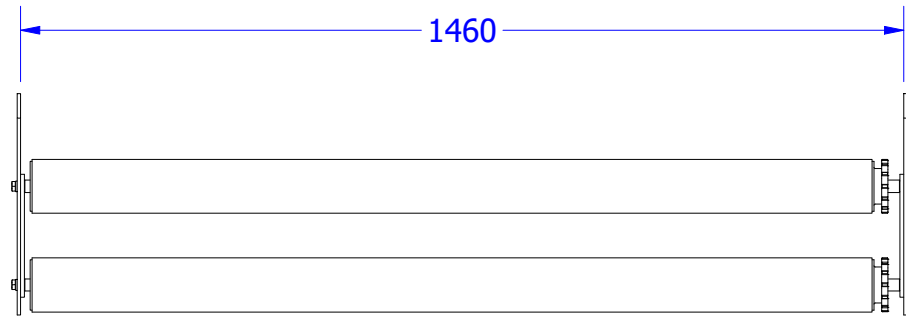


PLAN VIEW  
SCALE 1:12.5



ISO VIEW  
SCALE 1:12.5



FRONT VIEW  
SCALE 1:12.5

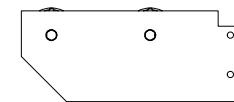

SIDE VIEW  
SCALE 1:12.5


DRAWN BY ULTIMATE ENGINEERING PTY LTD Ph 8562 1511



REV	DATE	DESCRIPTION	APPRD
1	27/04/2021	AS BUILT	DB
0	31/03/2021	APPROVED FOR MANUFACTURE	PB

THESE DRAWINGS ARE THE PROPERTY OF ULTIMATE ENGINEERING AND SHOULD NOT BE REPRODUCED OR COPIED IN ANY WAY WITHOUT WRITTEN PERMISSION FROM ULTIMATE ENGINEERING

PAINT TREATMENT:

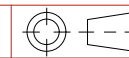

DIMENSION TOLERANCES	
DECIMAL	ANGULAR
X.X = ± .5 mm	X = ± 1°
X.XX = ± .25 mm	X.X = ± .5°
X.XXX = ± .125 mm	X.XX = ± .25°

MAXIMUM FINISHED SURFACE ROUGHNESS U.N.O. 1.6

PARENT ASSEMBLY

CUSTOMER:

RAB ENGINEERING

DRAWN: David Bilney

TITLE:

A1948-006-01  
CHAIN CONVEYORS

DESIGNED: David Bilney

DWG NO:

194806

DATE: 30/03/2021

JOB NO:

SCALE:  
Scale

SHEET  
1 OF 5


SHEET SIZE:  
A3

REV:  
1


DO NOT SCALE DRAWING

2	P1948-006-02	Steel, Mild	SHEET 5	1
1	P1948-006-01	Steel, Mild	SHEET 4	1
ITEM	PART NUMBER	MATERIAL	COMMENTS	ITEM QTY


W1948-006-01 - 1 REQ'D AS DRAWN

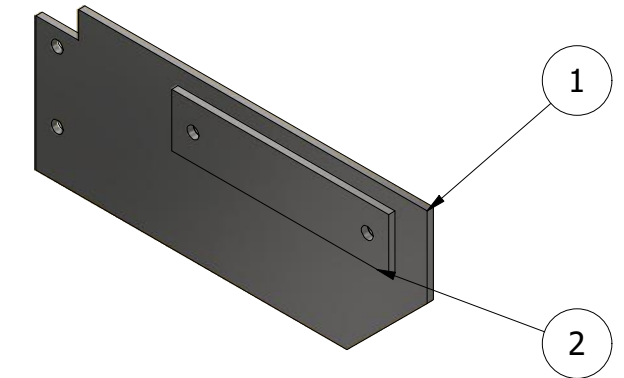

ISO VIEW  
SCALE 1:5

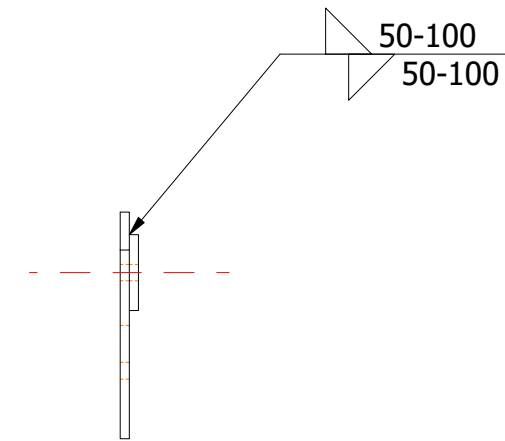

SIDE VIEW  
SCALE 1:5

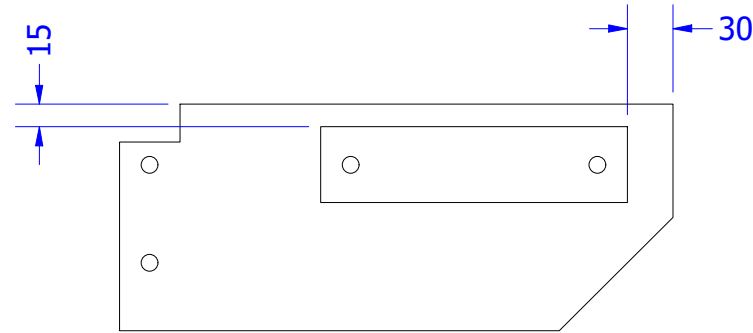

FRONT VIEW  
SCALE 1:5

NOTES:


1. ALL WELDING TO CONFORM TO AS1554-GP UNO
2. ALL FILLET WELDS TO BE 6mm CONTINUOUS UNO
3. ALL BUTT WELDS SHALL BE FULL STRENGTH, COMPLETE PENETRATION WELDS
4. ALL FLAME CUT SURFACES SHALL BE UNIFORM & CLEAN BEFORE WELDING
5. REMOVE ALL BURRS & SHARP EDGES
6. NON DESTRUCTIVE TESTING:
  - A) ALL WELDS, 100% VISUAL SCAN TO AS1554 PART 1
7. FINISH:
  - A) ALL STEELWORK TO BE PRIMED OR COLD GALV UNO

DRAWN BY ULTIMATE ENGINEERING PTY LTD Ph 8562 1511



THESE DRAWINGS ARE THE PROPERTY OF ULTIMATE ENGINEERING AND SHOULD NOT BE REPRODUCED OR COPIED IN ANY WAY WITHOUT WRITTEN PERMISSION FROM ULTIMATE ENGINEERING

PAINT TREATMENT: TBA

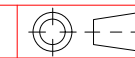

DIMENSION TOLERANCES	
DECIMAL	ANGULAR
X.X = ± .5 mm	X = ± 1°
X.XX = ± .25 mm	X.X = ± .5°
X.XXX = ± .125 mm	X.XX = ± .25°

MAXIMUM FINISHED SURFACE ROUGHNESS U.N.O. 1.6

PARENT ASSEMBLY

CUSTOMER: **RAB ENGINEERING**

DRAWN: David Bilney

TITLE: W1948-006-01  
CHAIN CONVEYORS

DESIGNED: David Bilney

DWG NO: **194806**

DATE: 30/03/2021


JOB NO:

SCALE: Scale	SHEET 2 OF 5	SHEET SIZE: A3	REV: 1
-----------------	-----------------	-------------------	-----------


DO NOT SCALE DRAWING

2	P1948-006-01	Steel, Mild	SHEET 4	1
1	P1948-006-02	Steel, Mild	SHEET 5	1
ITEM	PART NUMBER	MATERIAL	COMMENTS	ITEM QTY


W1948-006-02 - 1 REQ'D AS DRAWN

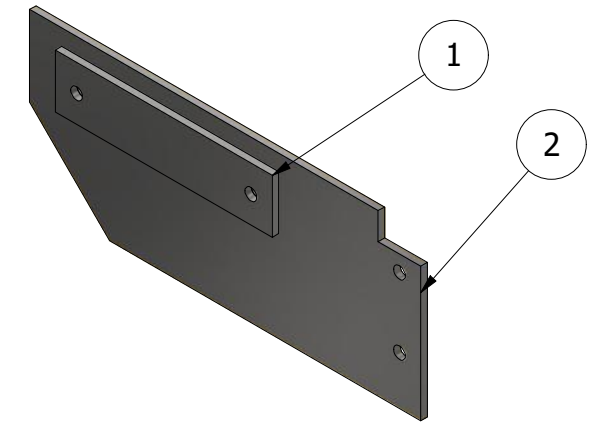

ISO VIEW  
SCALE 1:5

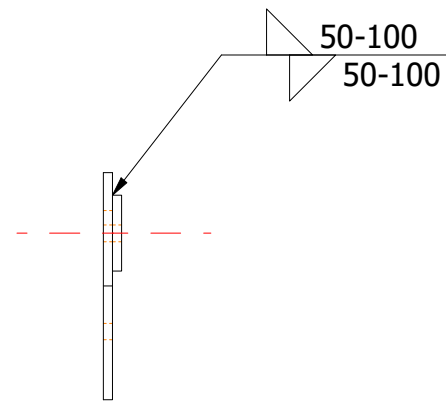

SIDE VIEW  
SCALE 1:5

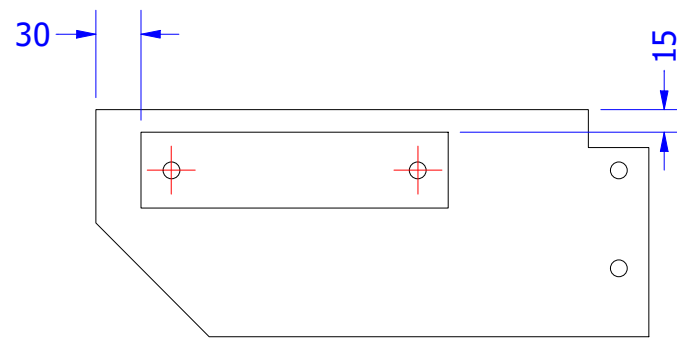

FRONT VIEW  
SCALE 1:5

- NOTES:
- ALL WELDING TO CONFORM TO AS1554-GP UNO
  - ALL FILLET WELDS TO BE 6mm CONTINUOUS UNO
  - ALL BUTT WELDS SHALL BE FULL STRENGTH, COMPLETE PENETRATION WELDS
  - ALL FLAME CUT SURFACES SHALL BE UNIFORM & CLEAN BEFORE WELDING
  - REMOVE ALL BURRS & SHARP EDGES
  - NON DESTRUCTIVE TESTING:
    - A) ALL WELDS, 100% VISUAL SCAN TO AS1554 PART 1
  - FINISH:
    - A) ALL STEELWORK TO BE PRIMED OR COLD GALV UNO

DRAWN BY ULTIMATE ENGINEERING PTY LTD Ph 8562 1511



THESE DRAWINGS ARE THE PROPERTY OF ULTIMATE ENGINEERING AND SHOULD NOT BE REPRODUCED OR COPIED IN ANY WAY WITHOUT WRITTEN PERMISSION FROM ULTIMATE ENGINEERING

PAINT TREATMENT: TBA



DIMENSION TOLERANCES	
DECIMAL	ANGULAR
X.X = ± .5 mm	X = ± 1°
X.XX = ± .25 mm	X.X = ± .5°
X.XXX = ± .125 mm	X.XX = ± .25°


MAXIMUM FINISHED SURFACE ROUGHNESS U.N.O. 1.6

PARENT ASSEMBLY	CUSTOMER: <b>RAB ENGINEERING</b>
DRAWN: David Bilney	TITLE: W1948-006-02 CHAIN CONVEYORS
DESIGNED: David Bilney	DWG NO: <b>194806</b>
DATE: 30/03/2021	JOB NO:
SCALE: Scale	SHEET 3 OF 5
SHEET SIZE: A3	REV: 1

DO NOT SCALE DRAWING

6mm PLATE @ 366 X 150	Steel, Mild	AS3678 - GR250
DESCRIPTION	MATERIAL	COMMENTS

P1948-006-01 - 1 REQ'D AS DRAWN

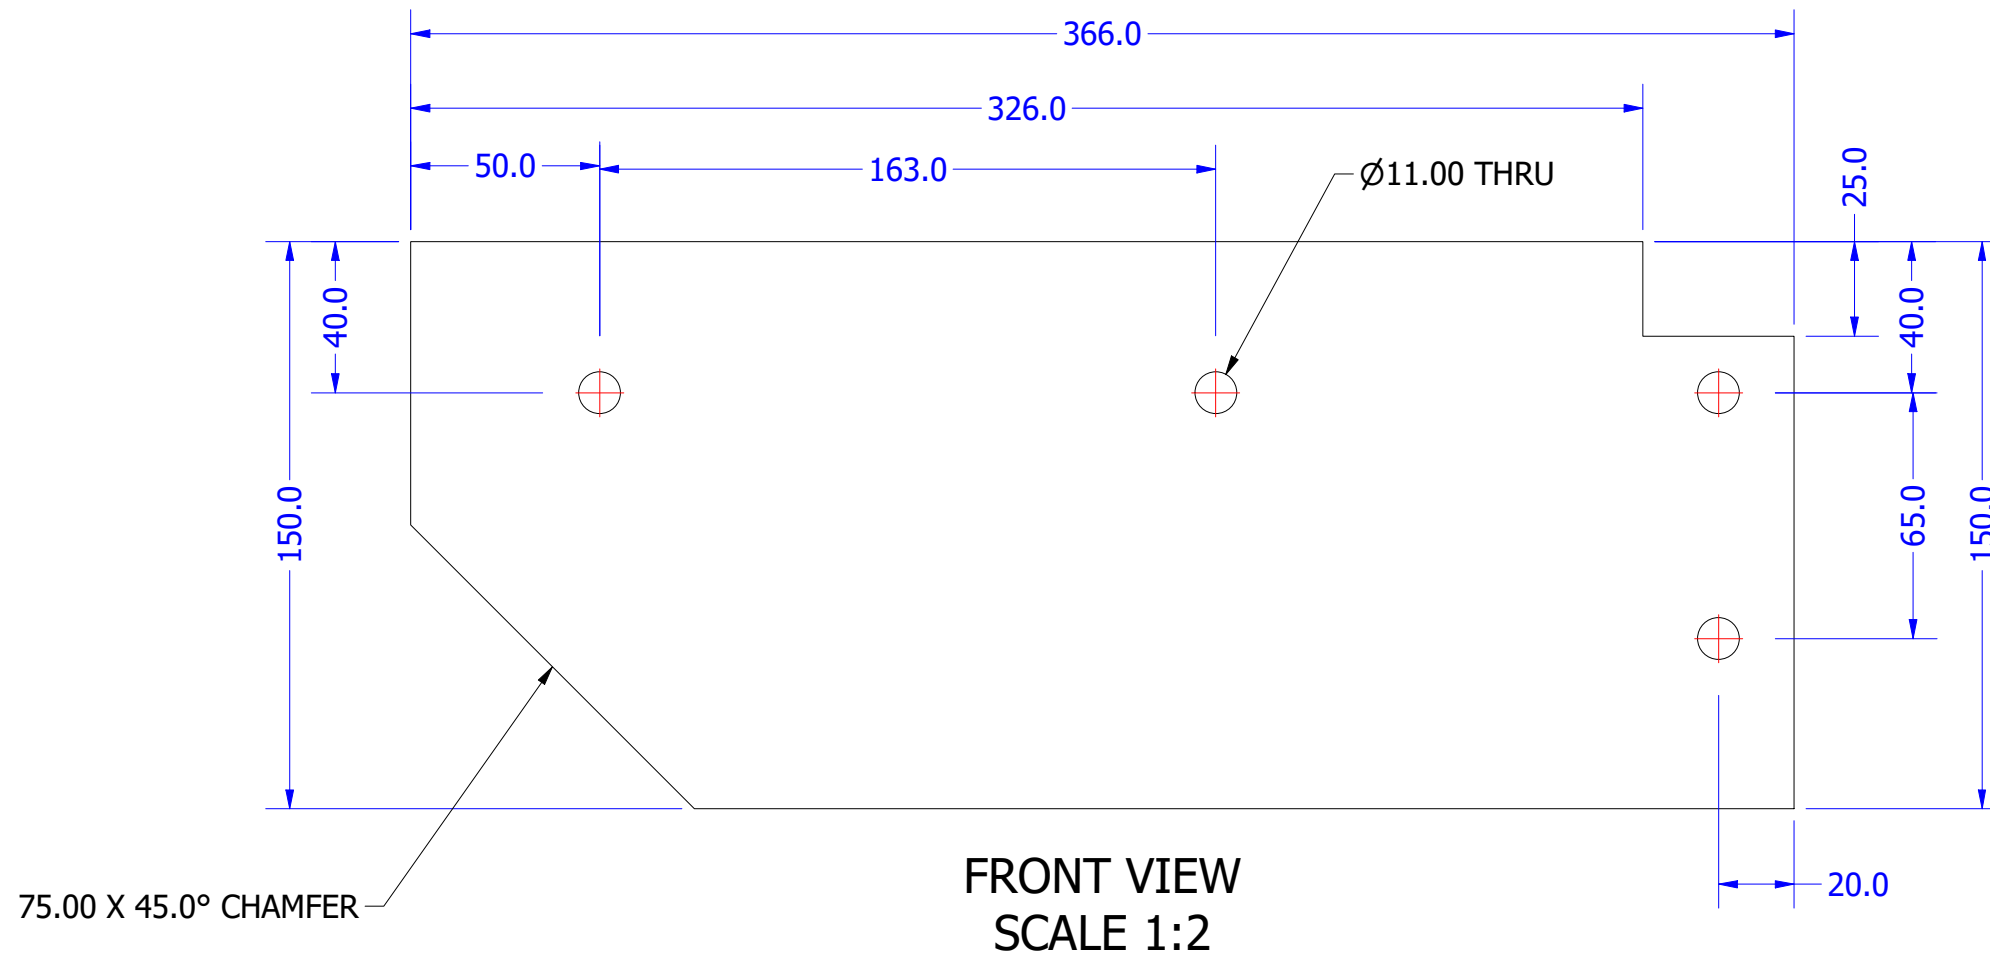


REMOVE ALL BURRS & SHARP EDGES



THESE DRAWINGS ARE THE PROPERTY OF ULTIMATE ENGINEERING AND SHOULD NOT BE REPRODUCED OR COPIED IN ANY WAY WITHOUT WRITTEN PERMISSION FROM ULTIMATE ENGINEERING

PAINT TREATMENT:

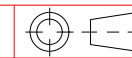

DIMENSION TOLERANCES	
DECIMAL	ANGULAR
X.X = ± .5 mm	X = ± 1°
X.XX = ± .25 mm	X.X = ± .5°
X.XXX = ± .125 mm	X.XX = ± .25°

MAXIMUM FINISHED SURFACE ROUGHNESS U.N.O. 1.6

PARENT ASSEMBLY

DRAWN: David Bilney

DESIGNED: David Bilney

DATE: 30/03/2021

CUSTOMER:

RAB ENGINEERING

TITLE:

P1948-006-01  
CHAIN CONVEYORS

DWG NO:

194806

JOB NO:

SCALE:  
Scale

SHEET  
4 OF 5


SHEET SIZE:  
A3

REV:  
1

DO NOT SCALE DRAWING

50x6 FMS @ 203	Steel, Mild	AS3679 - GR300
DESCRIPTION	MATERIAL	COMMENTS

P1948-006-02 - 1 REQ'D AS DRAWN

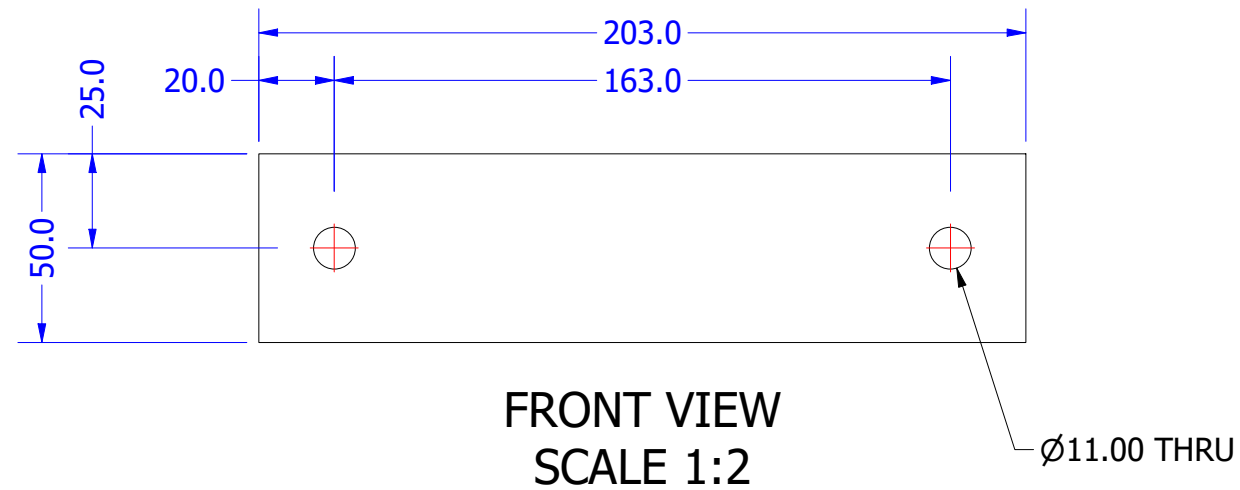


REMOVE ALL BURRS & SHARP EDGES

DRAWN BY ULTIMATE ENGINEERING PTY LTD Ph 8562 1511



THESE DRAWINGS ARE THE PROPERTY OF ULTIMATE ENGINEERING AND SHOULD NOT BE REPRODUCED OR COPIED IN ANY WAY WITHOUT WRITTEN PERMISSION FROM ULTIMATE ENGINEERING

PAINT TREATMENT:

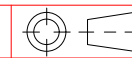

DIMENSION TOLERANCES	
DECIMAL	ANGULAR
X.X = ± .5 mm	X = ± 1'
X.XX = ± .25 mm	X.X = ± .5'
X.XXX = ± .125 mm	X.XX = ± .25'

MAXIMUM FINISHED SURFACE ROUGHNESS U.N.O. 1.6

PARENT ASSEMBLY

DRAWN: David Bilney

DESIGNED: David Bilney

DATE: 30/03/2021

CUSTOMER: **RAB ENGINEERING**

TITLE: P1948-006-02  
CHAIN CONVEYORS

DWG NO: **194806**

JOB NO:

SCALE: Scale	SHEET 5 OF 5	SHEET SIZE: A3	REV: 1
-----------------	-----------------	-------------------	-----------